



● Indicates Concrete Right-of-Way Posts

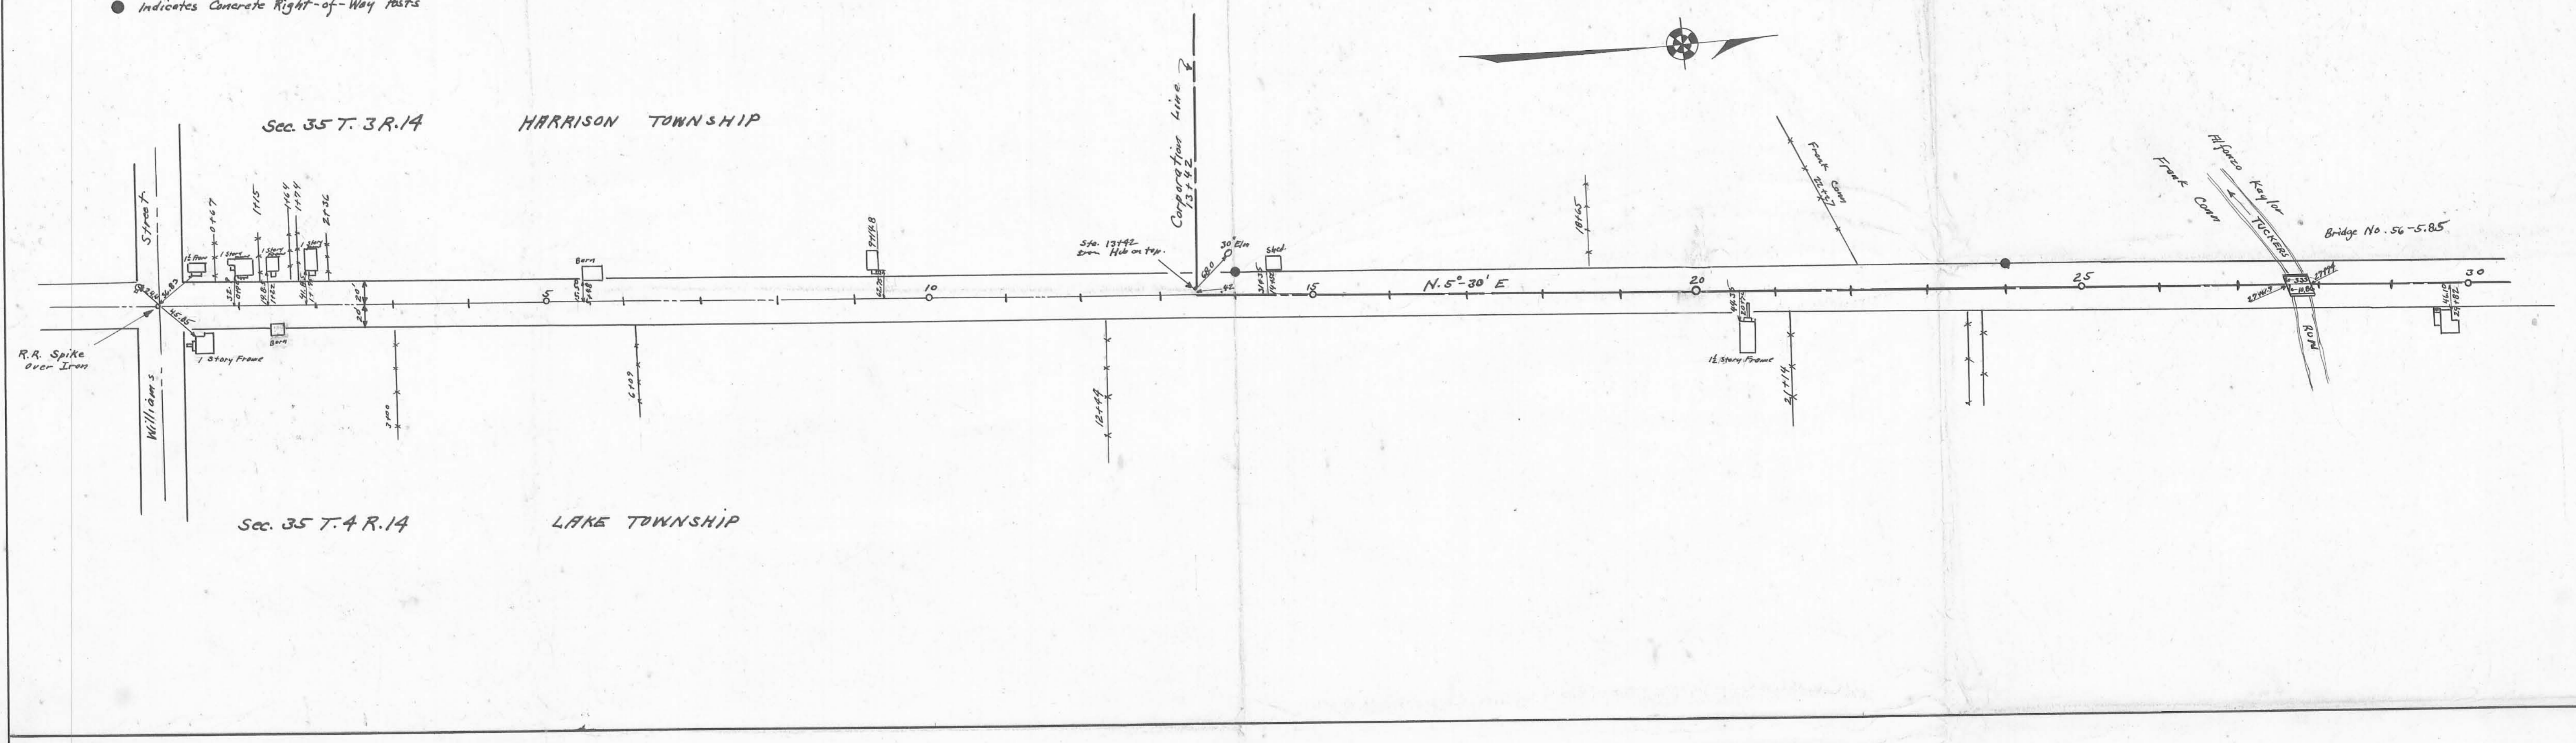

ROAD 56

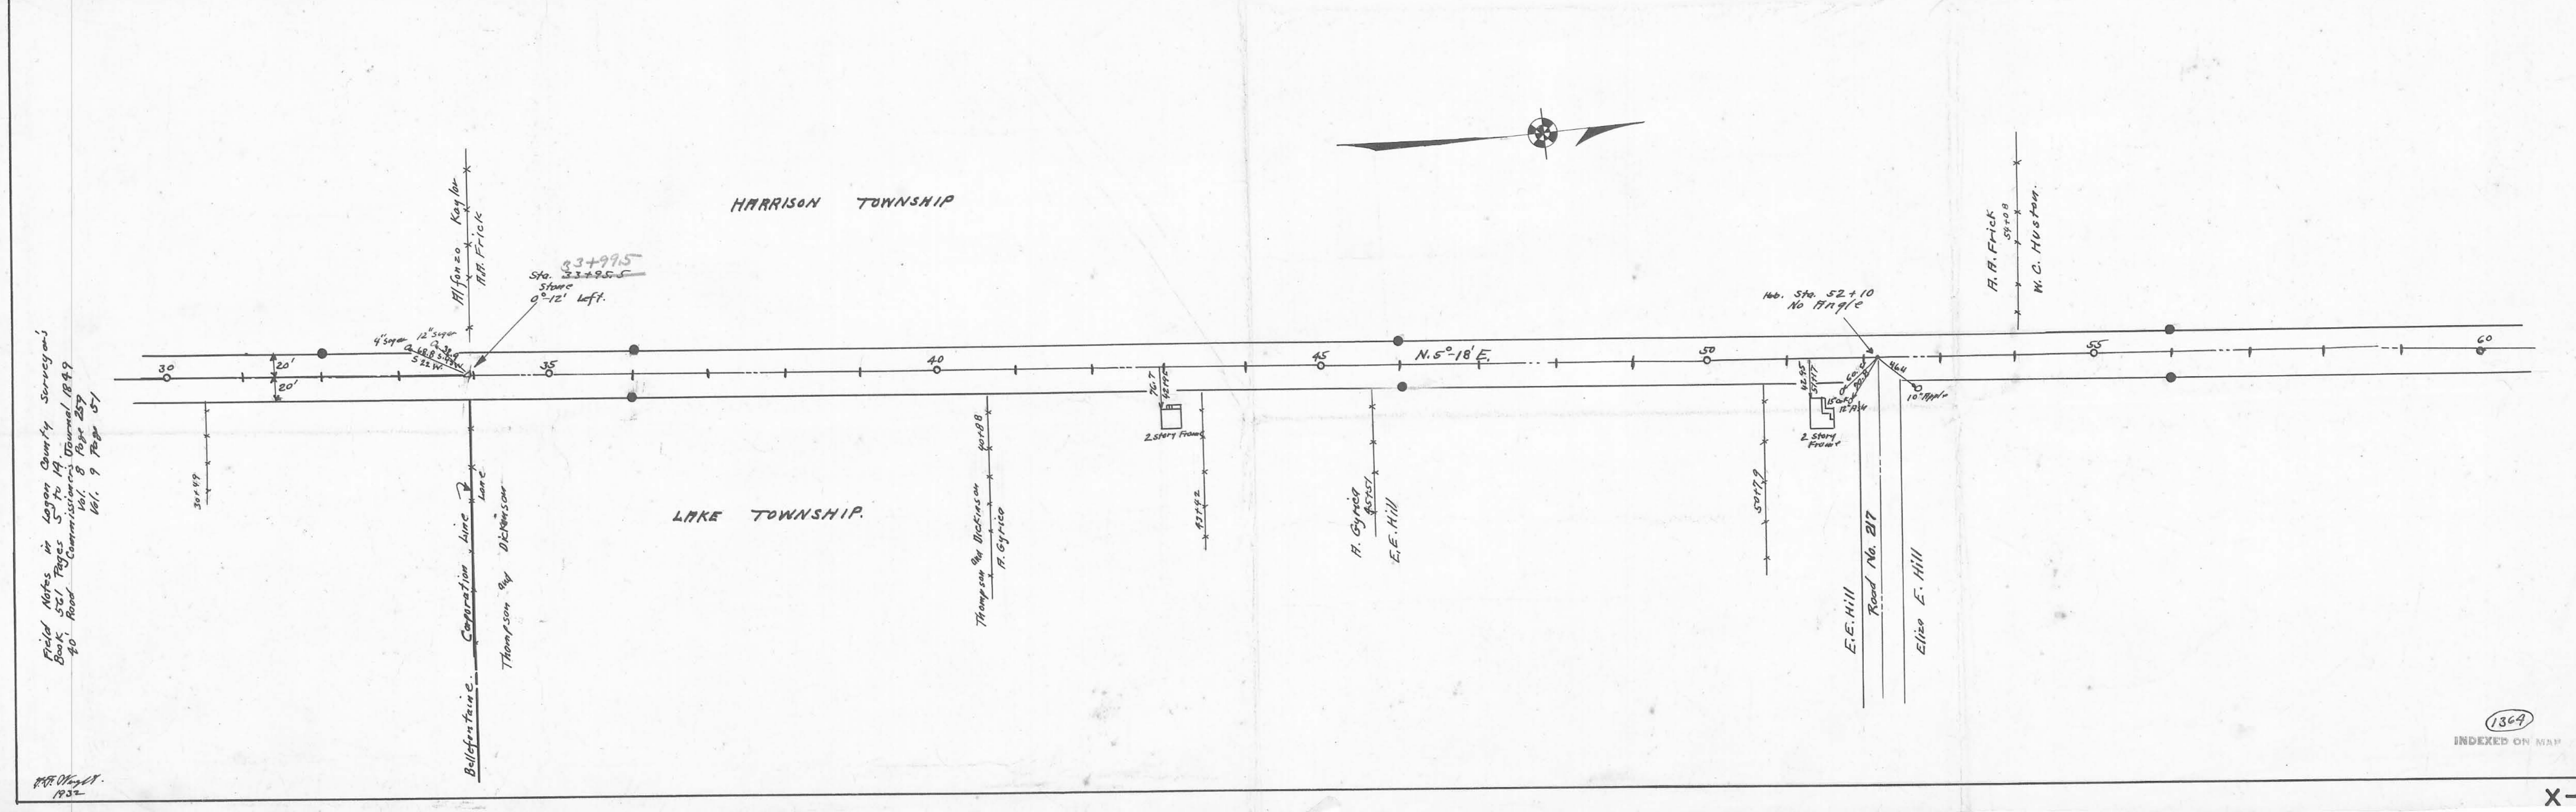

Field Notes in Logan County Surveyors' Book 501 Pages 17 Journal 1899 40 Road Commissioners 191, 8 Page 257 191, 9 Page 37


X-56

X-56


ROAD NO 56
LAKE & HARRISON TOWNSHIP
LOGAN COUNTY
1932

2
3

● Indicates Concrete Right-of-Way Posts

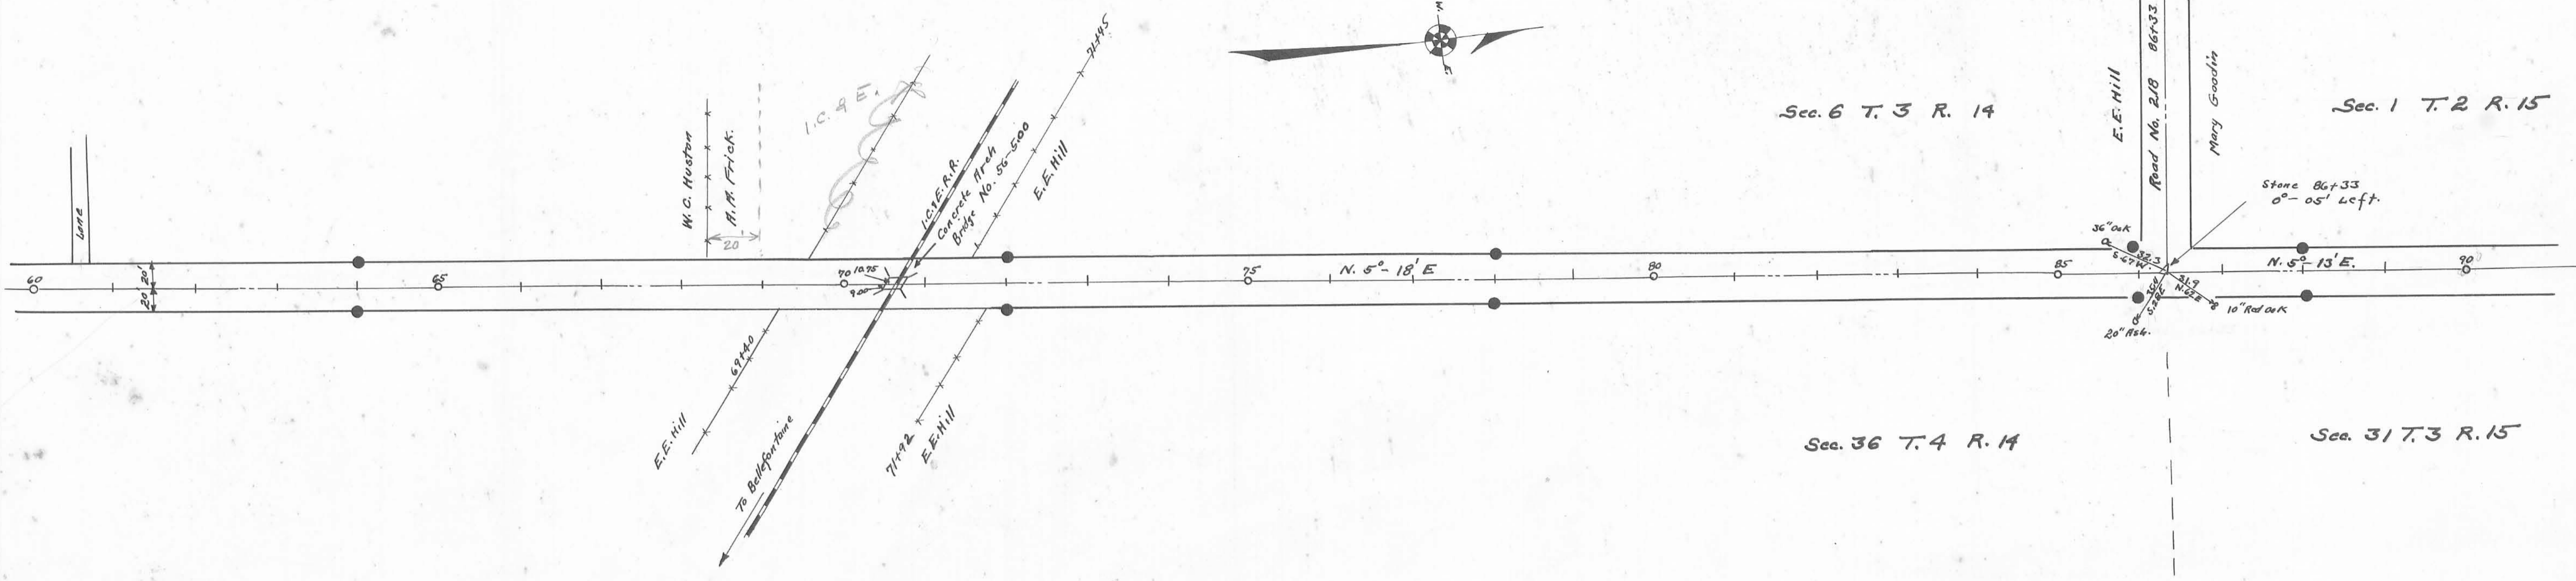


Field Notes in Logan County
Surveyors Book No. 561

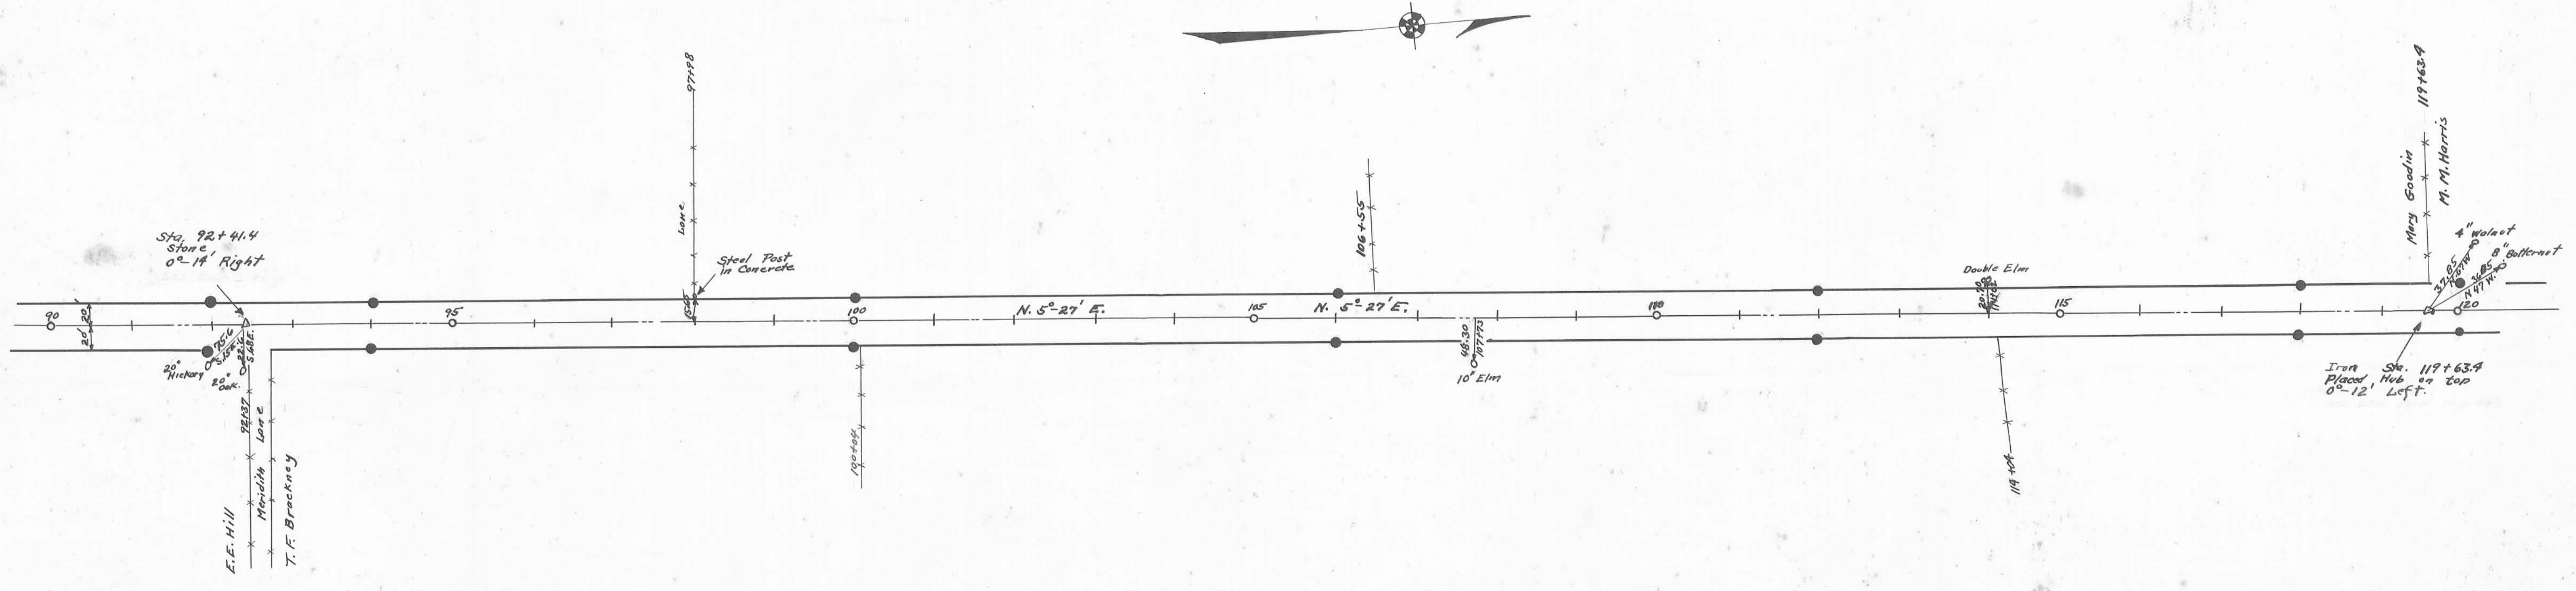

1932

1364
INDICED ON MAP

Indicates Concrete Right-of-Way Posts

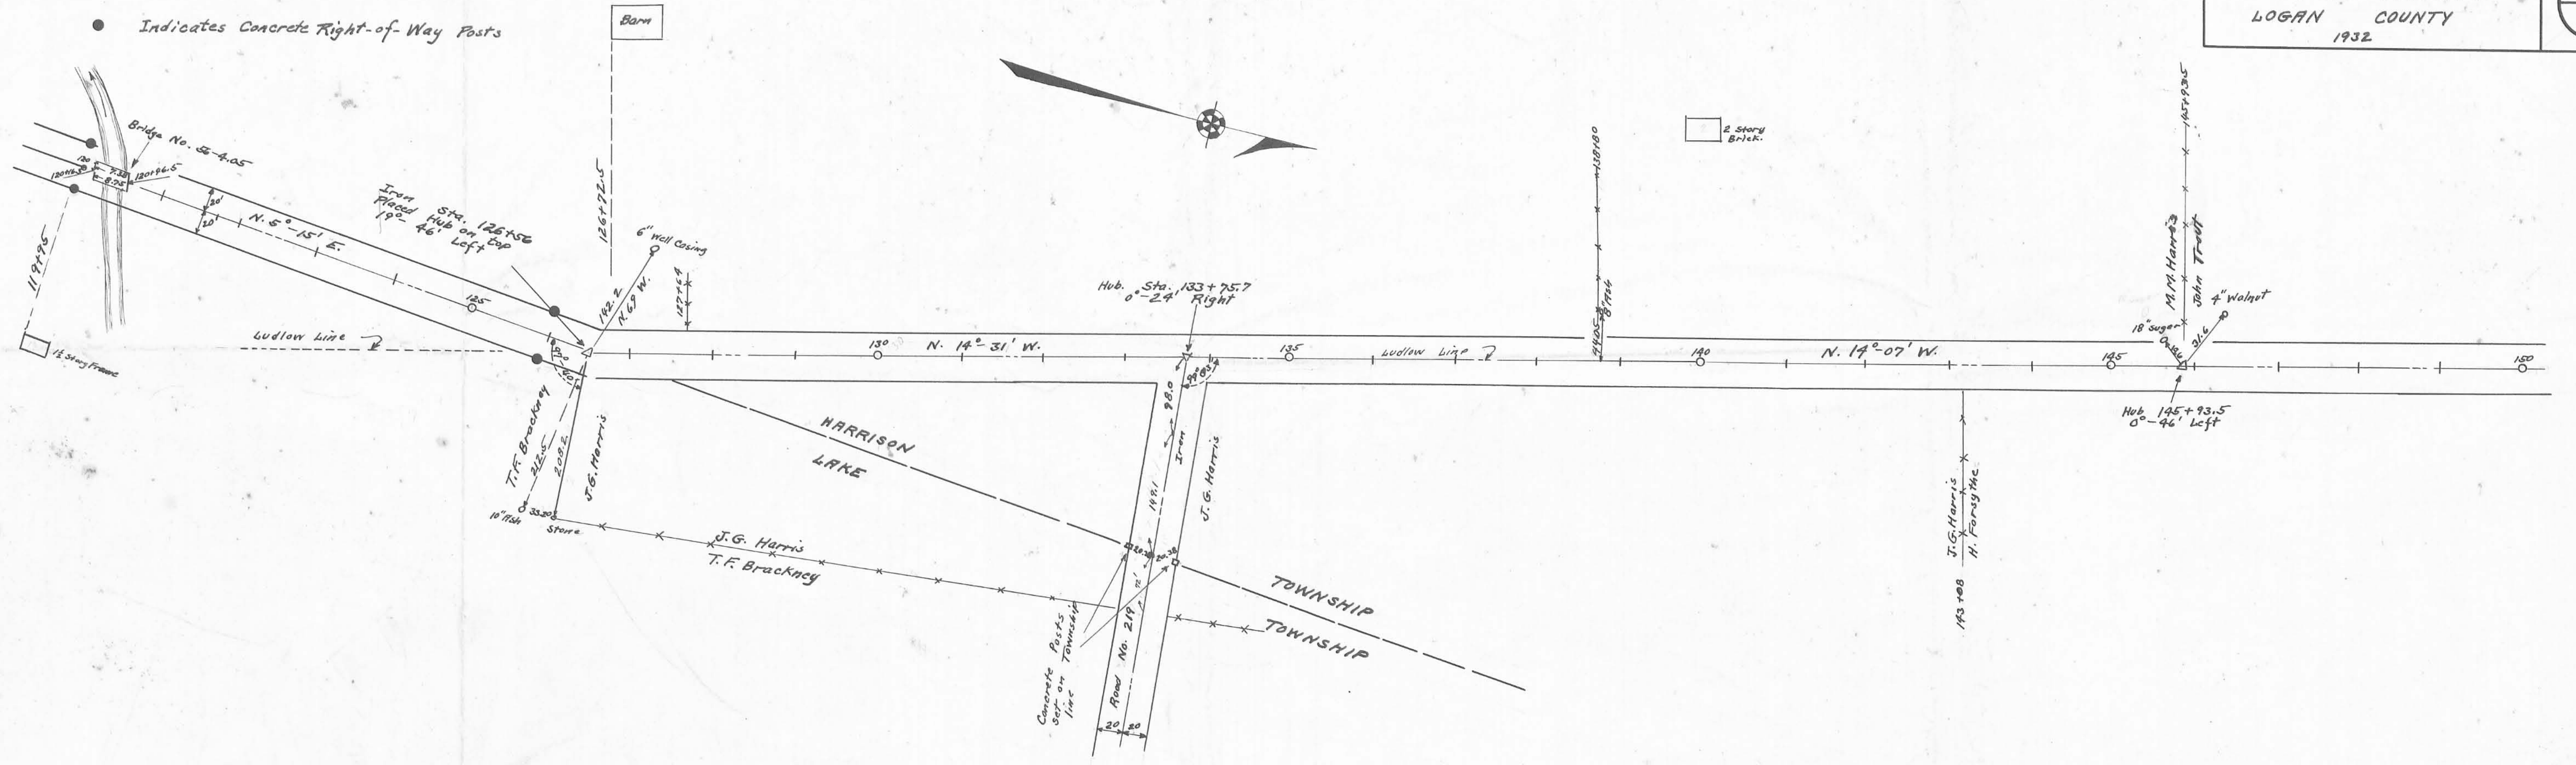

Length 18122 Feet
Length 3.432 Miles

Field Notes Logan County
Surveyors Book No. 561

