


40' Road Sec. Commissioners Journal No. 10 Pages 61 and 121  
 Staked for 40'  
 Field Notes in Logan County Surveyors Book 511 Pages 57 to 59

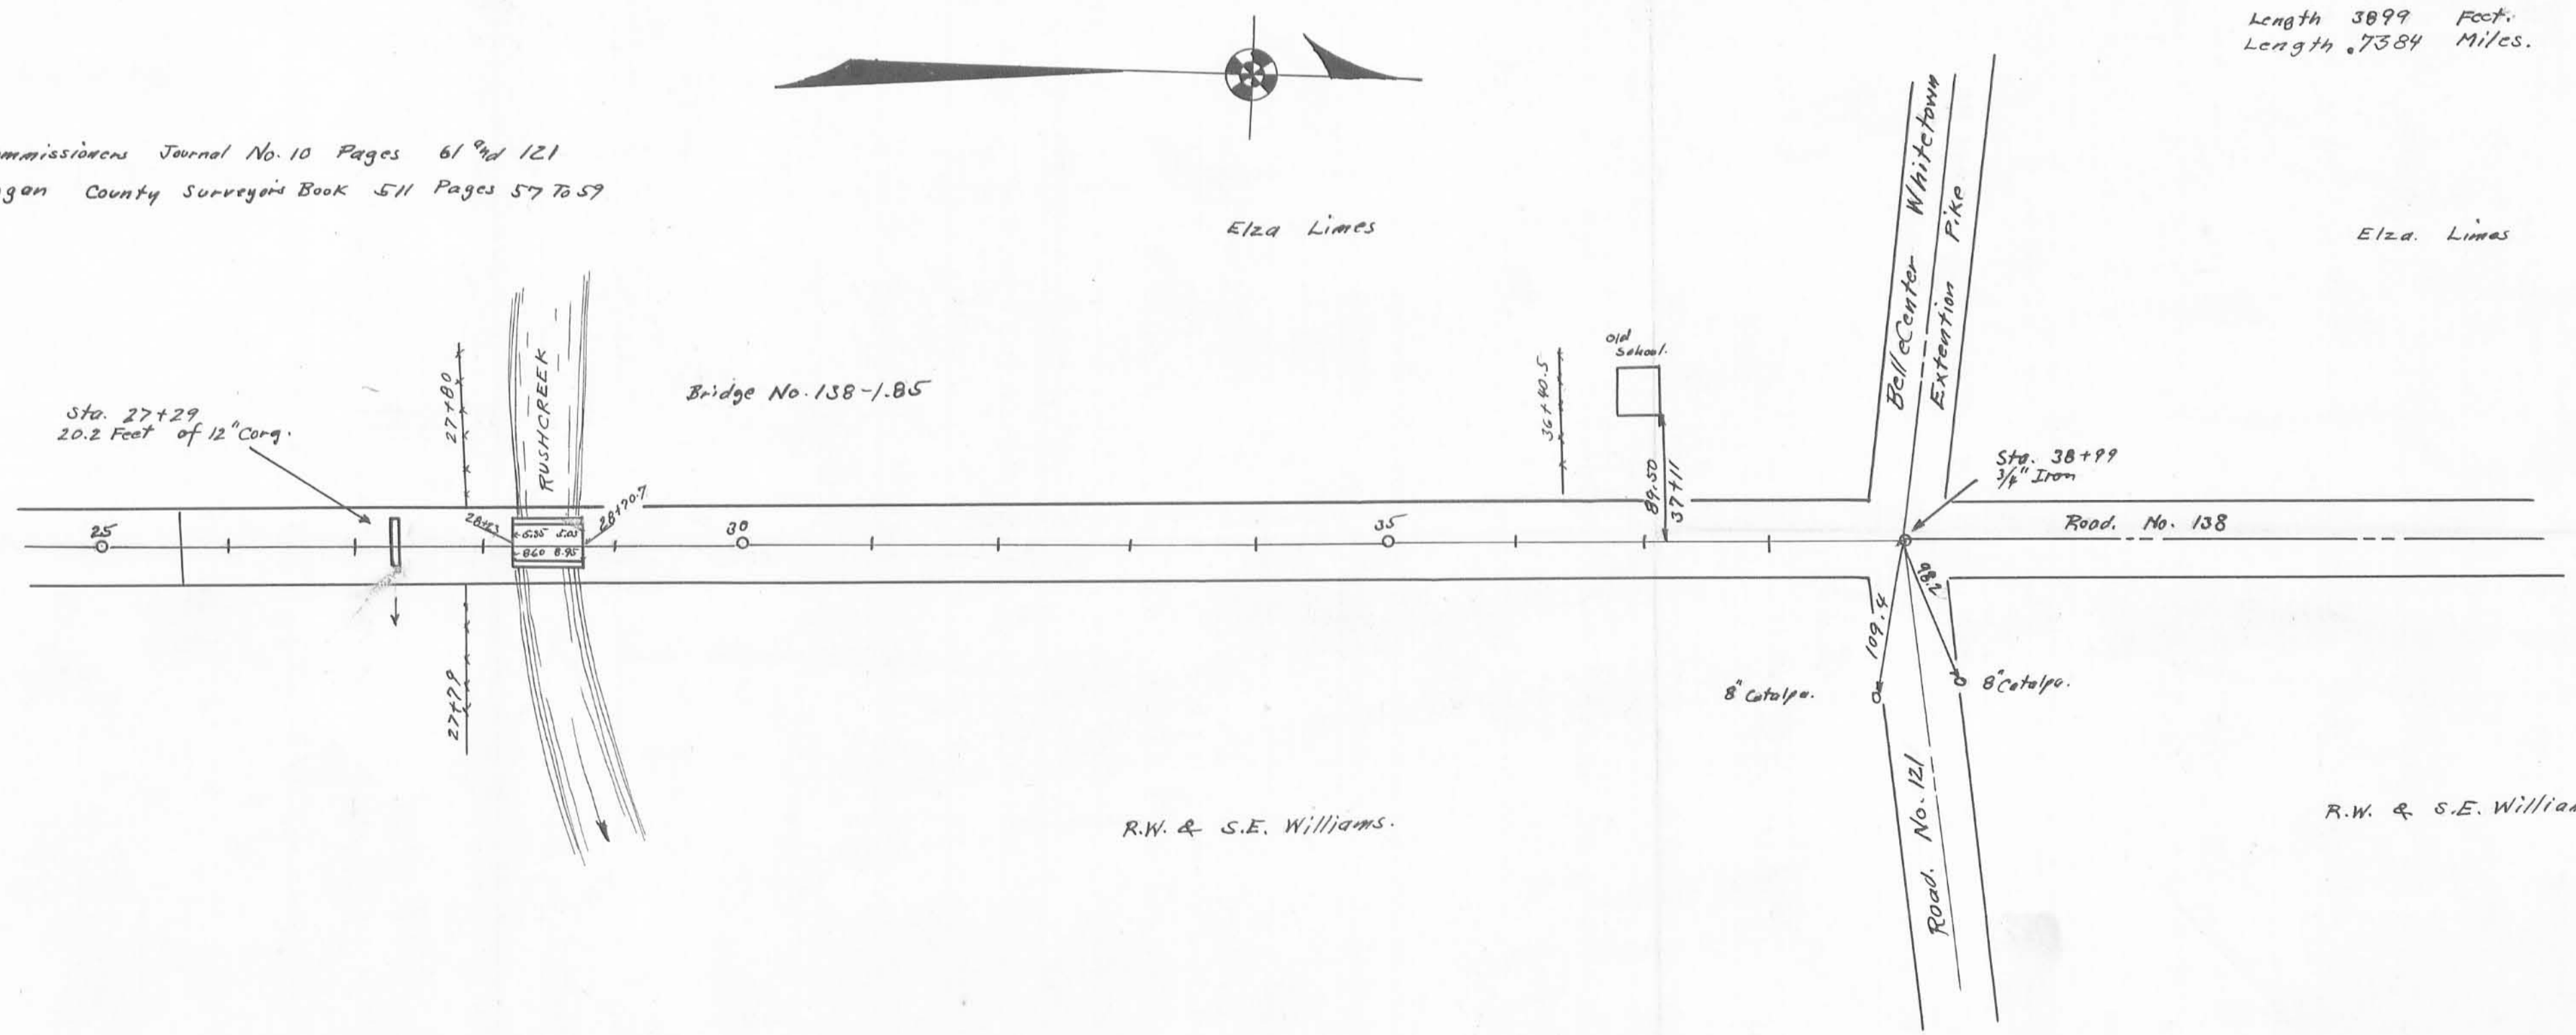

Length 3899 Feet.  
 Length .7384 Miles.

Priddy & Co.