



INDEXED ON MAP (12.51)

ROAD NO. 208
PLEASANT TOWNSHIP
LOGAN COUNTY
1931

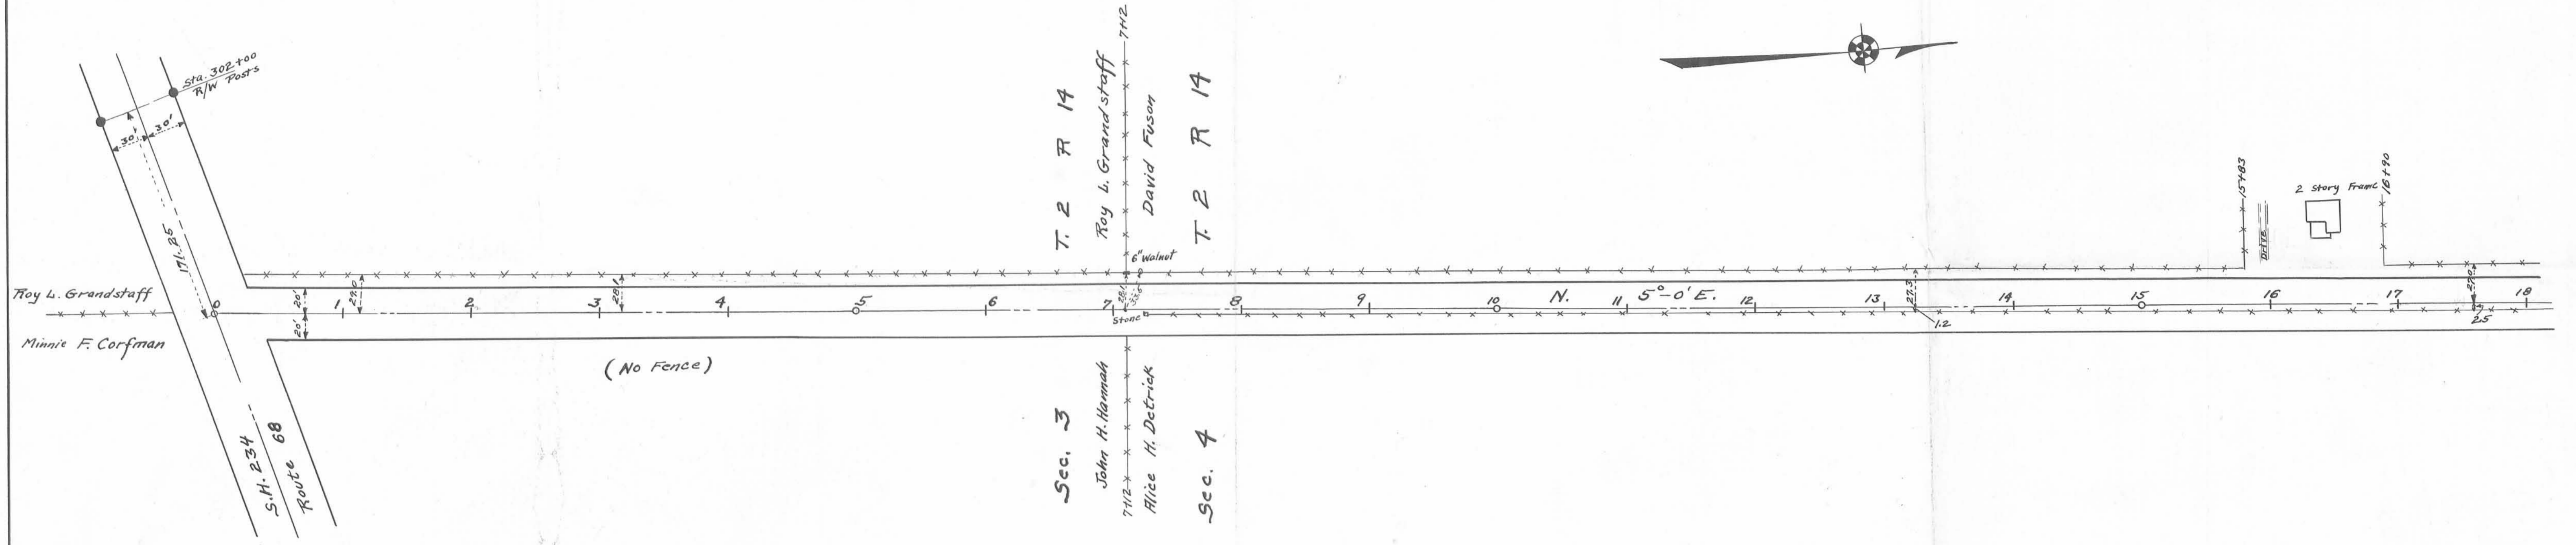

Scale 1" = 60'

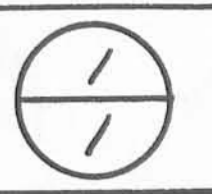

Length 3369 Feet
Length 0.6380 Miles

Book 552
520

