


Fences Set for 40' Road as Shown
Field Notes Logan County Surveyors
Book No. 431 Pgs. 19 to 22

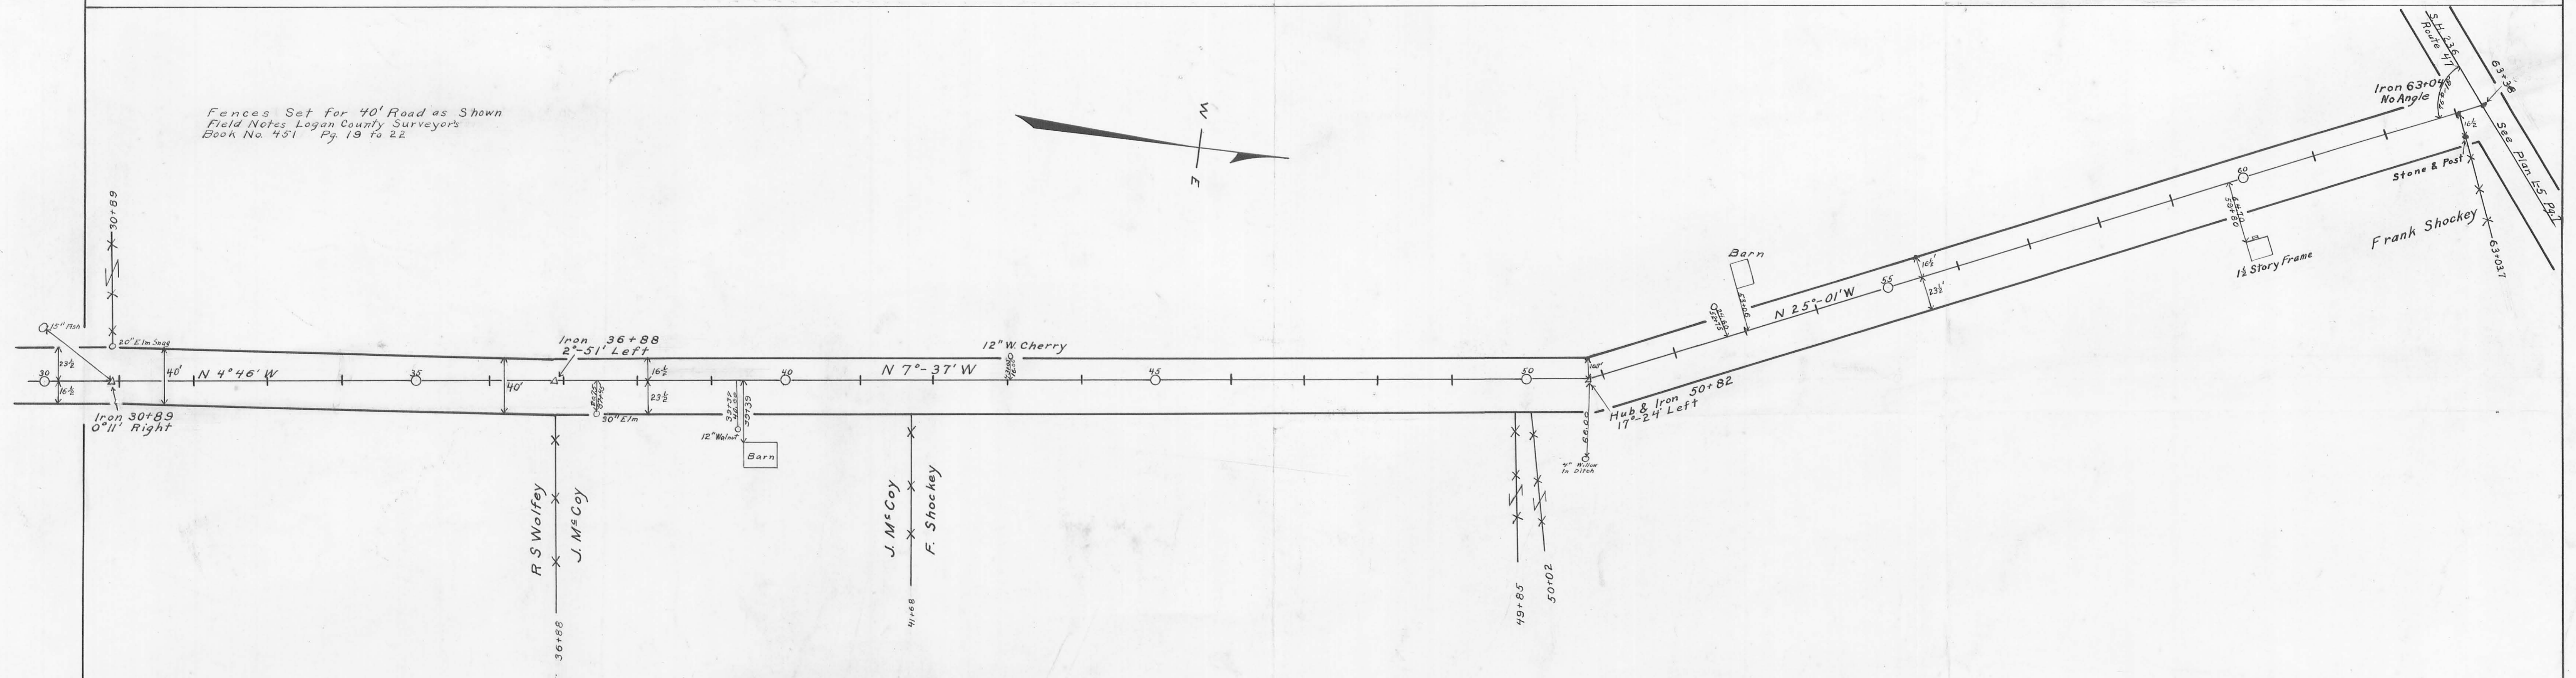

Surveyed by F.F. Wright
Drawn by John Montgomery