


McARTHUR TOWNSHIP.

Corrected To and
Feb 1 - 1938
April 12 - 1942

INDEX MAP

RED FIGURES REFER TO PAGE.

RICHLAND TP.

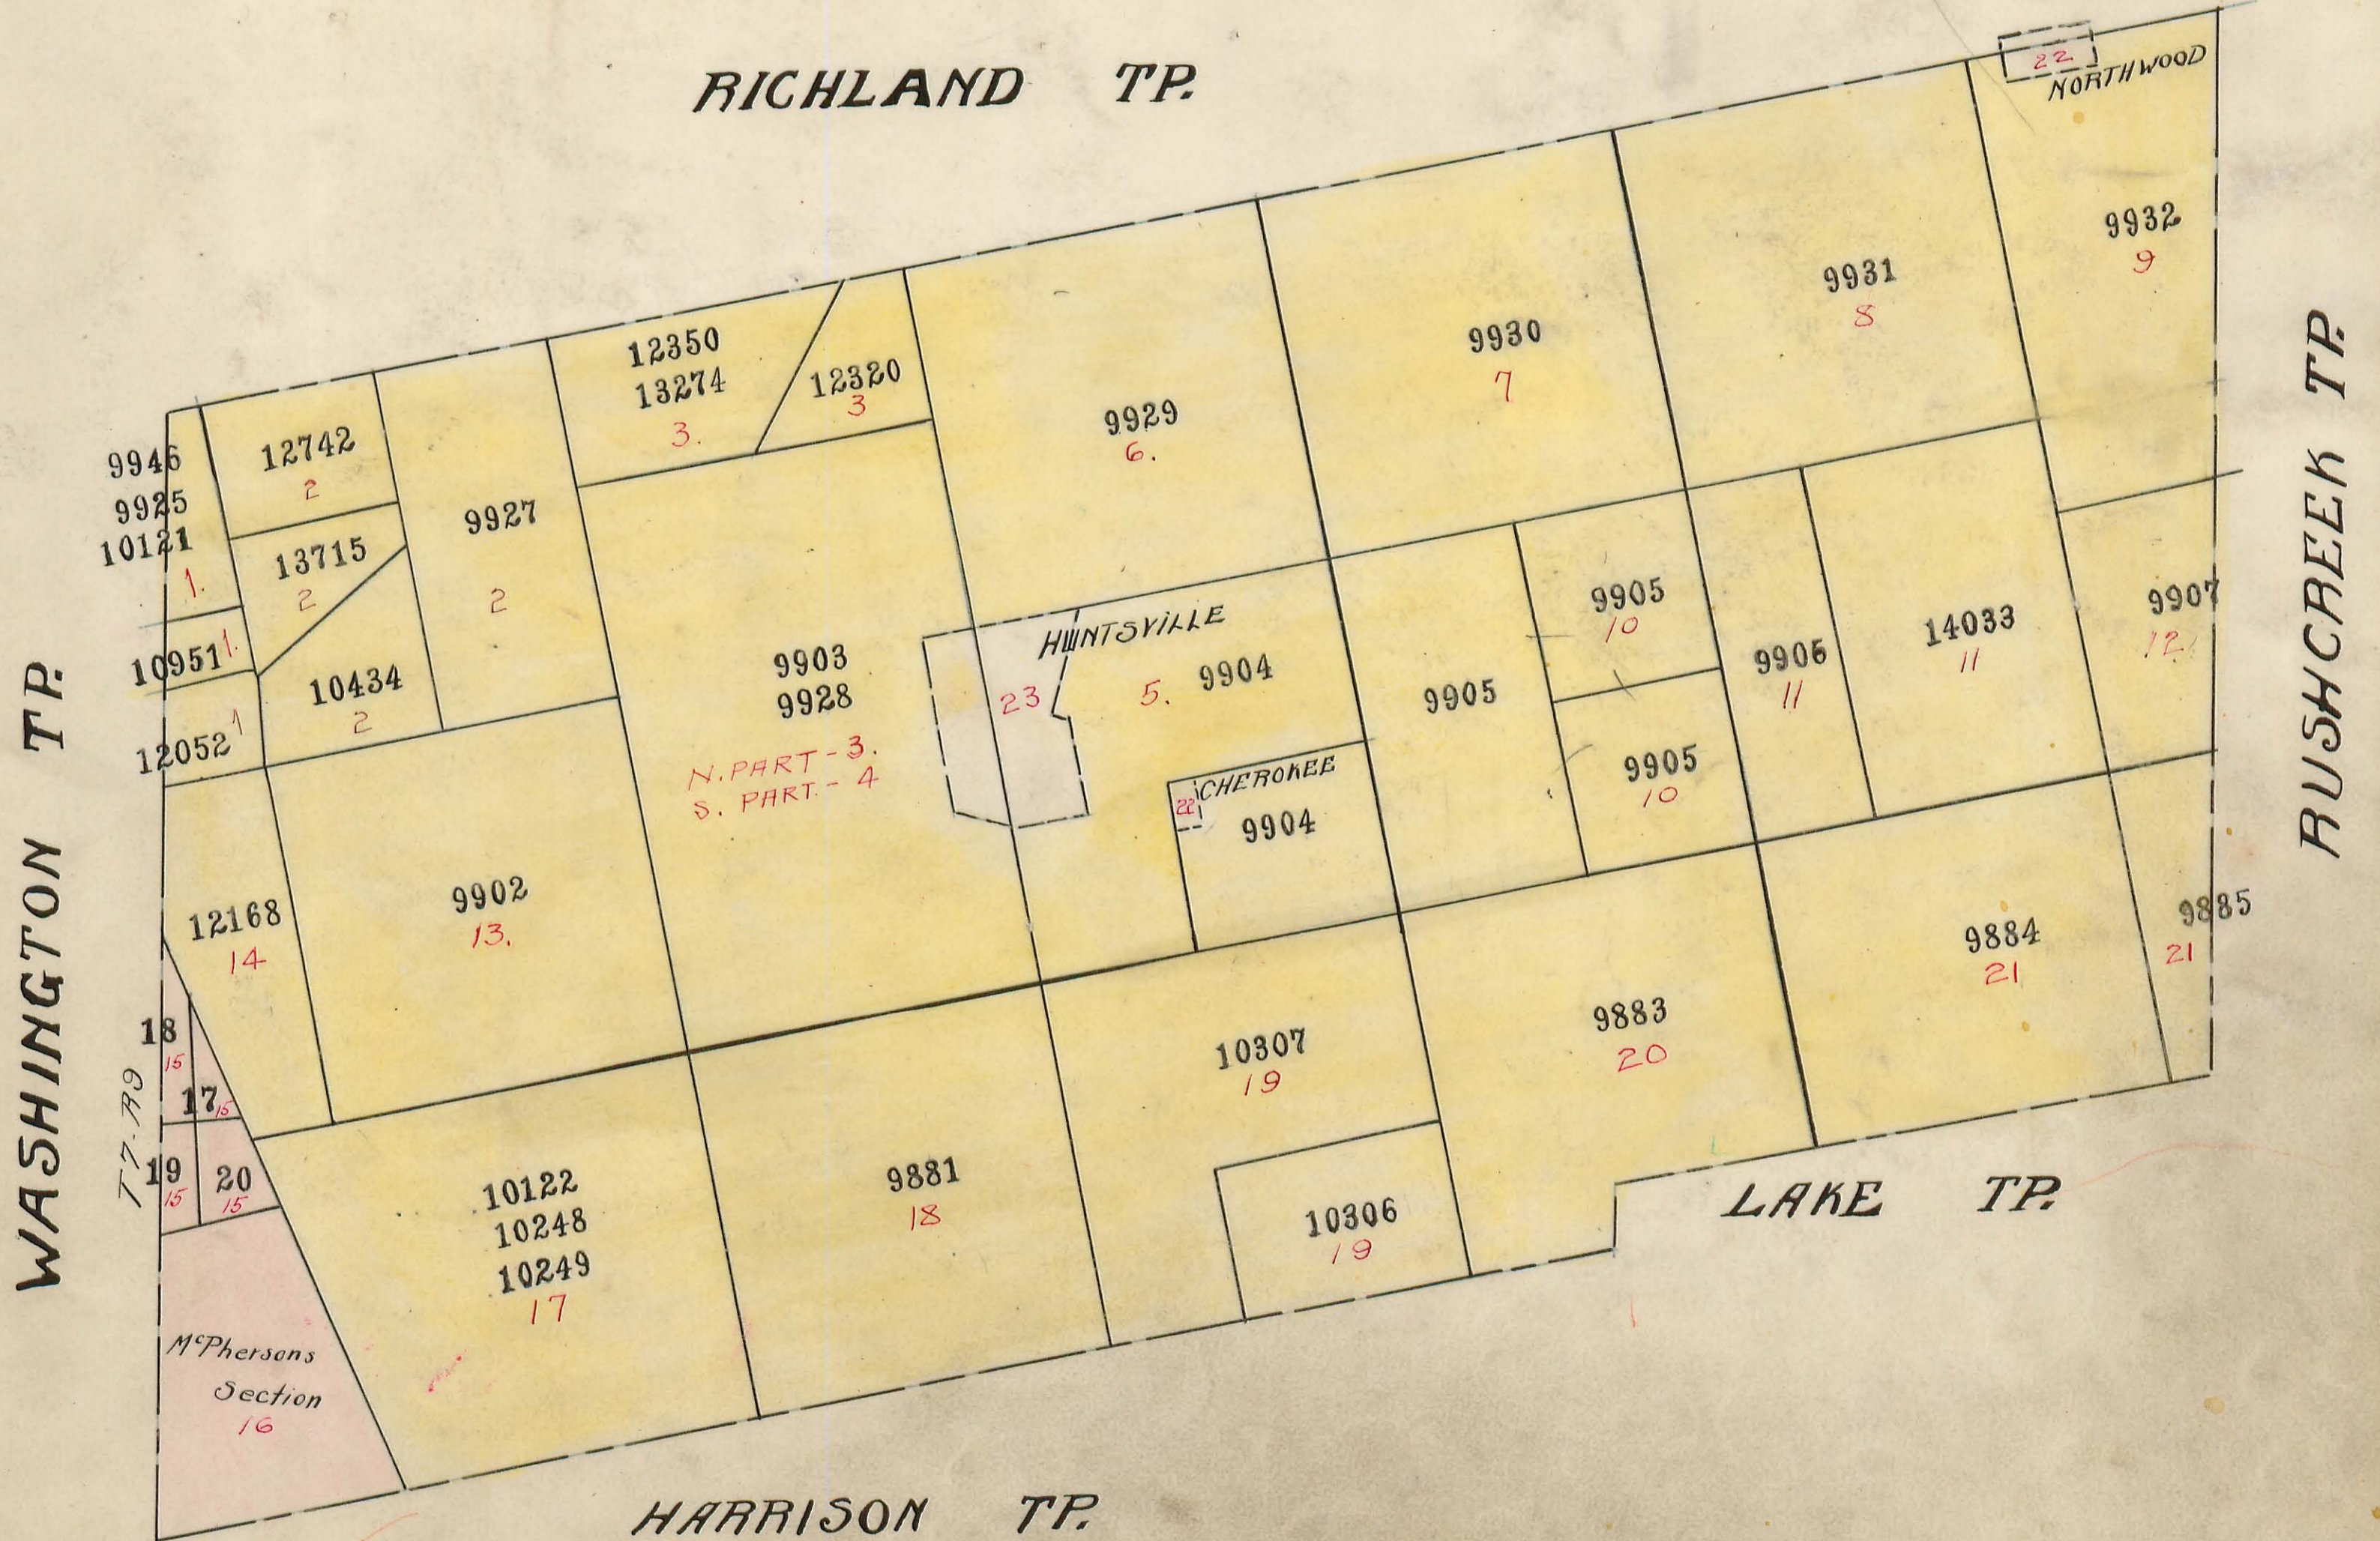


McARTHUR TOWNSHIP.

Plat of Virginia Military Survey No. $\left. \begin{array}{l} 9946 \\ 9925 \\ 10121 \end{array} \right\}$

Scale: 1 inch = 10 chains.

$\left. \begin{array}{l} 10951 \\ 12052 \end{array} \right\}$

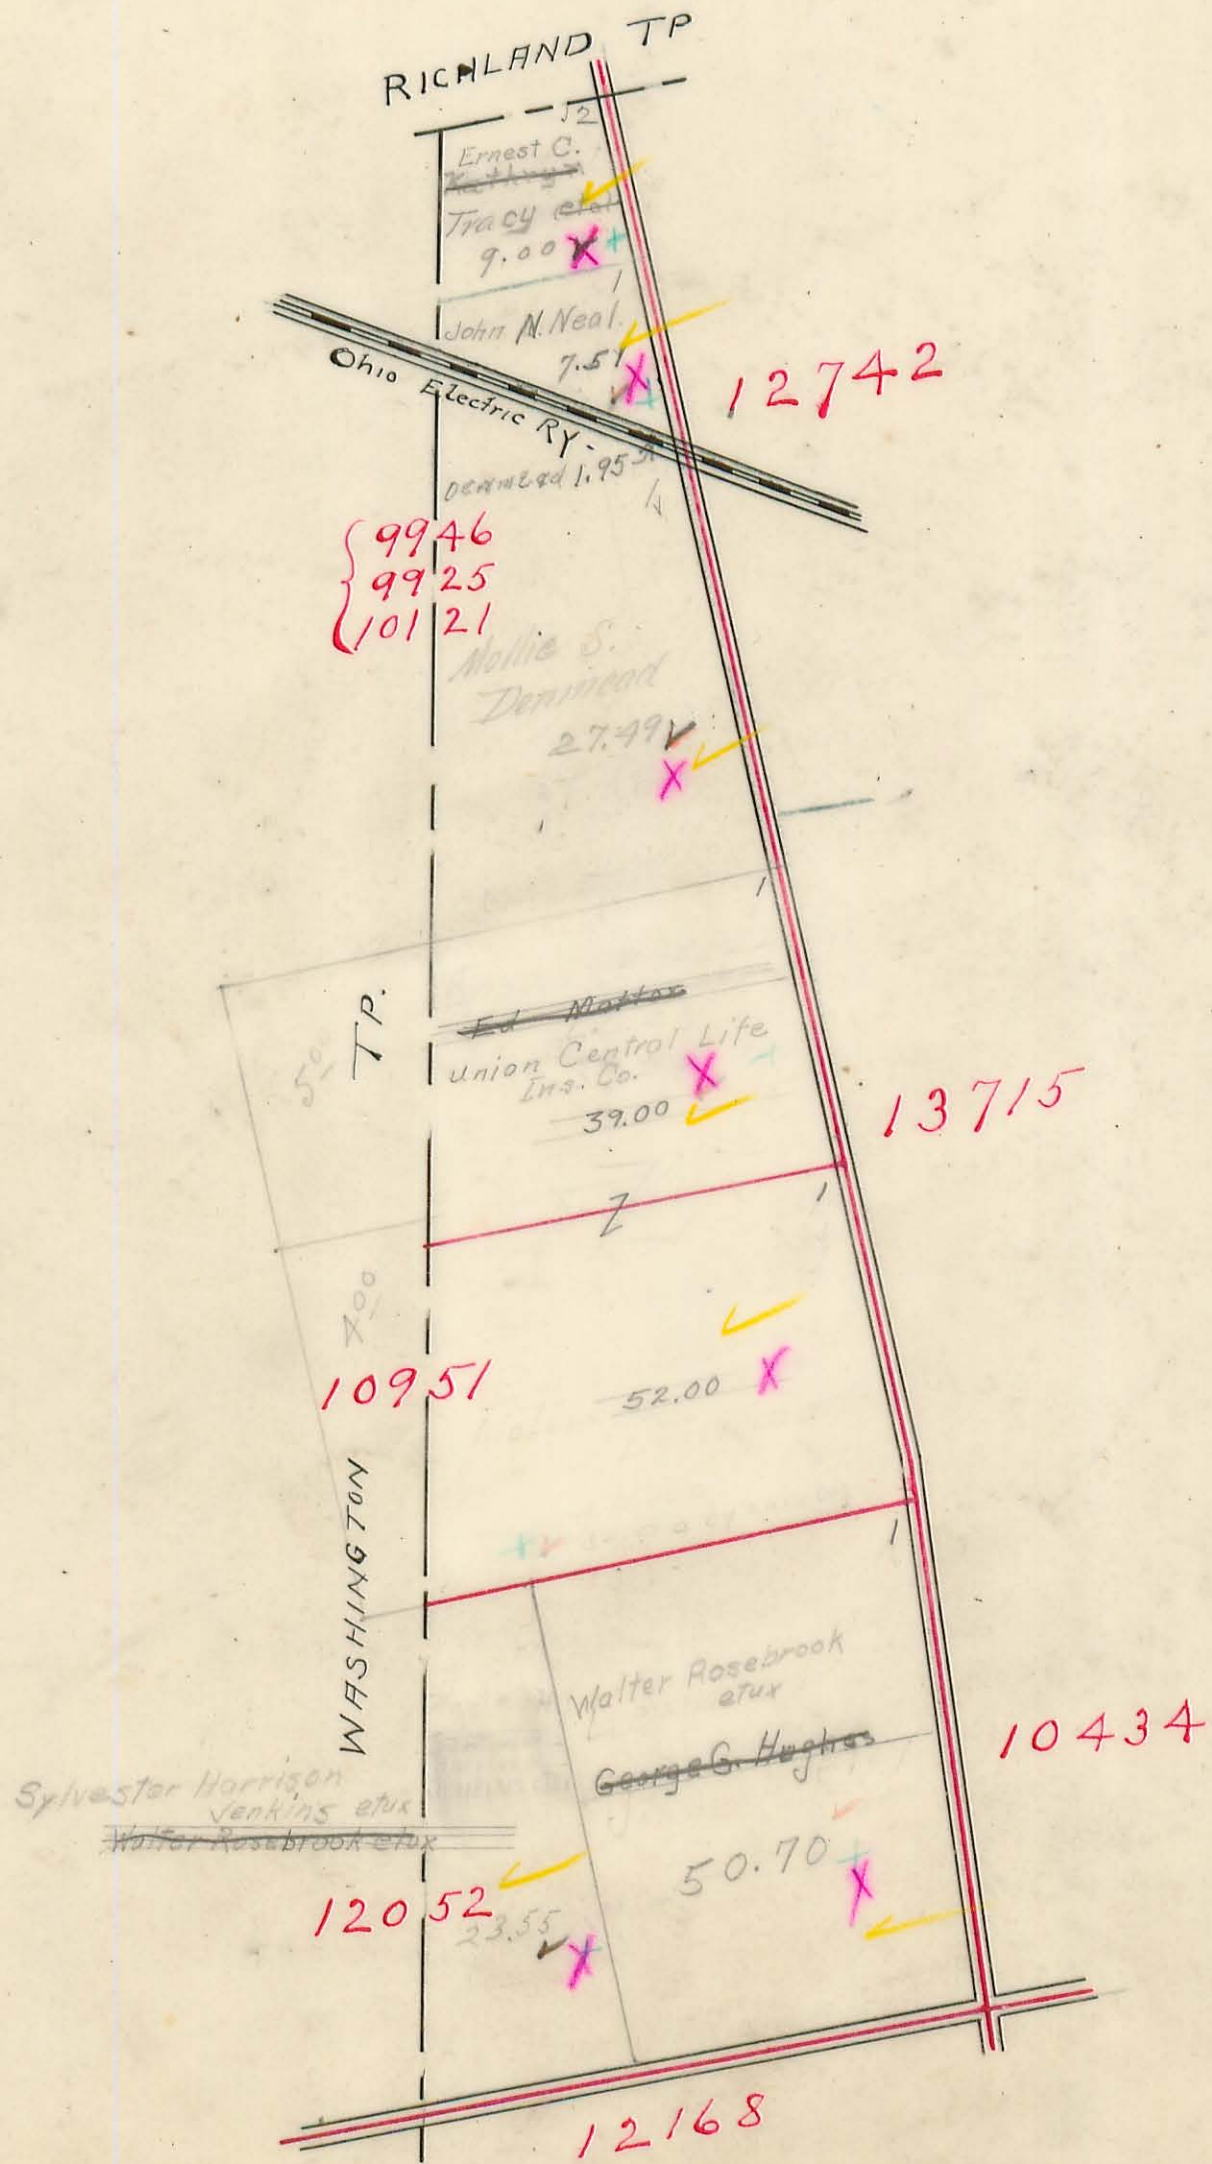

3327
19.1
14.28


006.0
09
52.64

OK X
4-12-47

McARTHUR TOWNSHIP.

Plat of Virginia Military Survey No. 12742
13715
10434
9927

Scale: 1 inch = 10 chains.

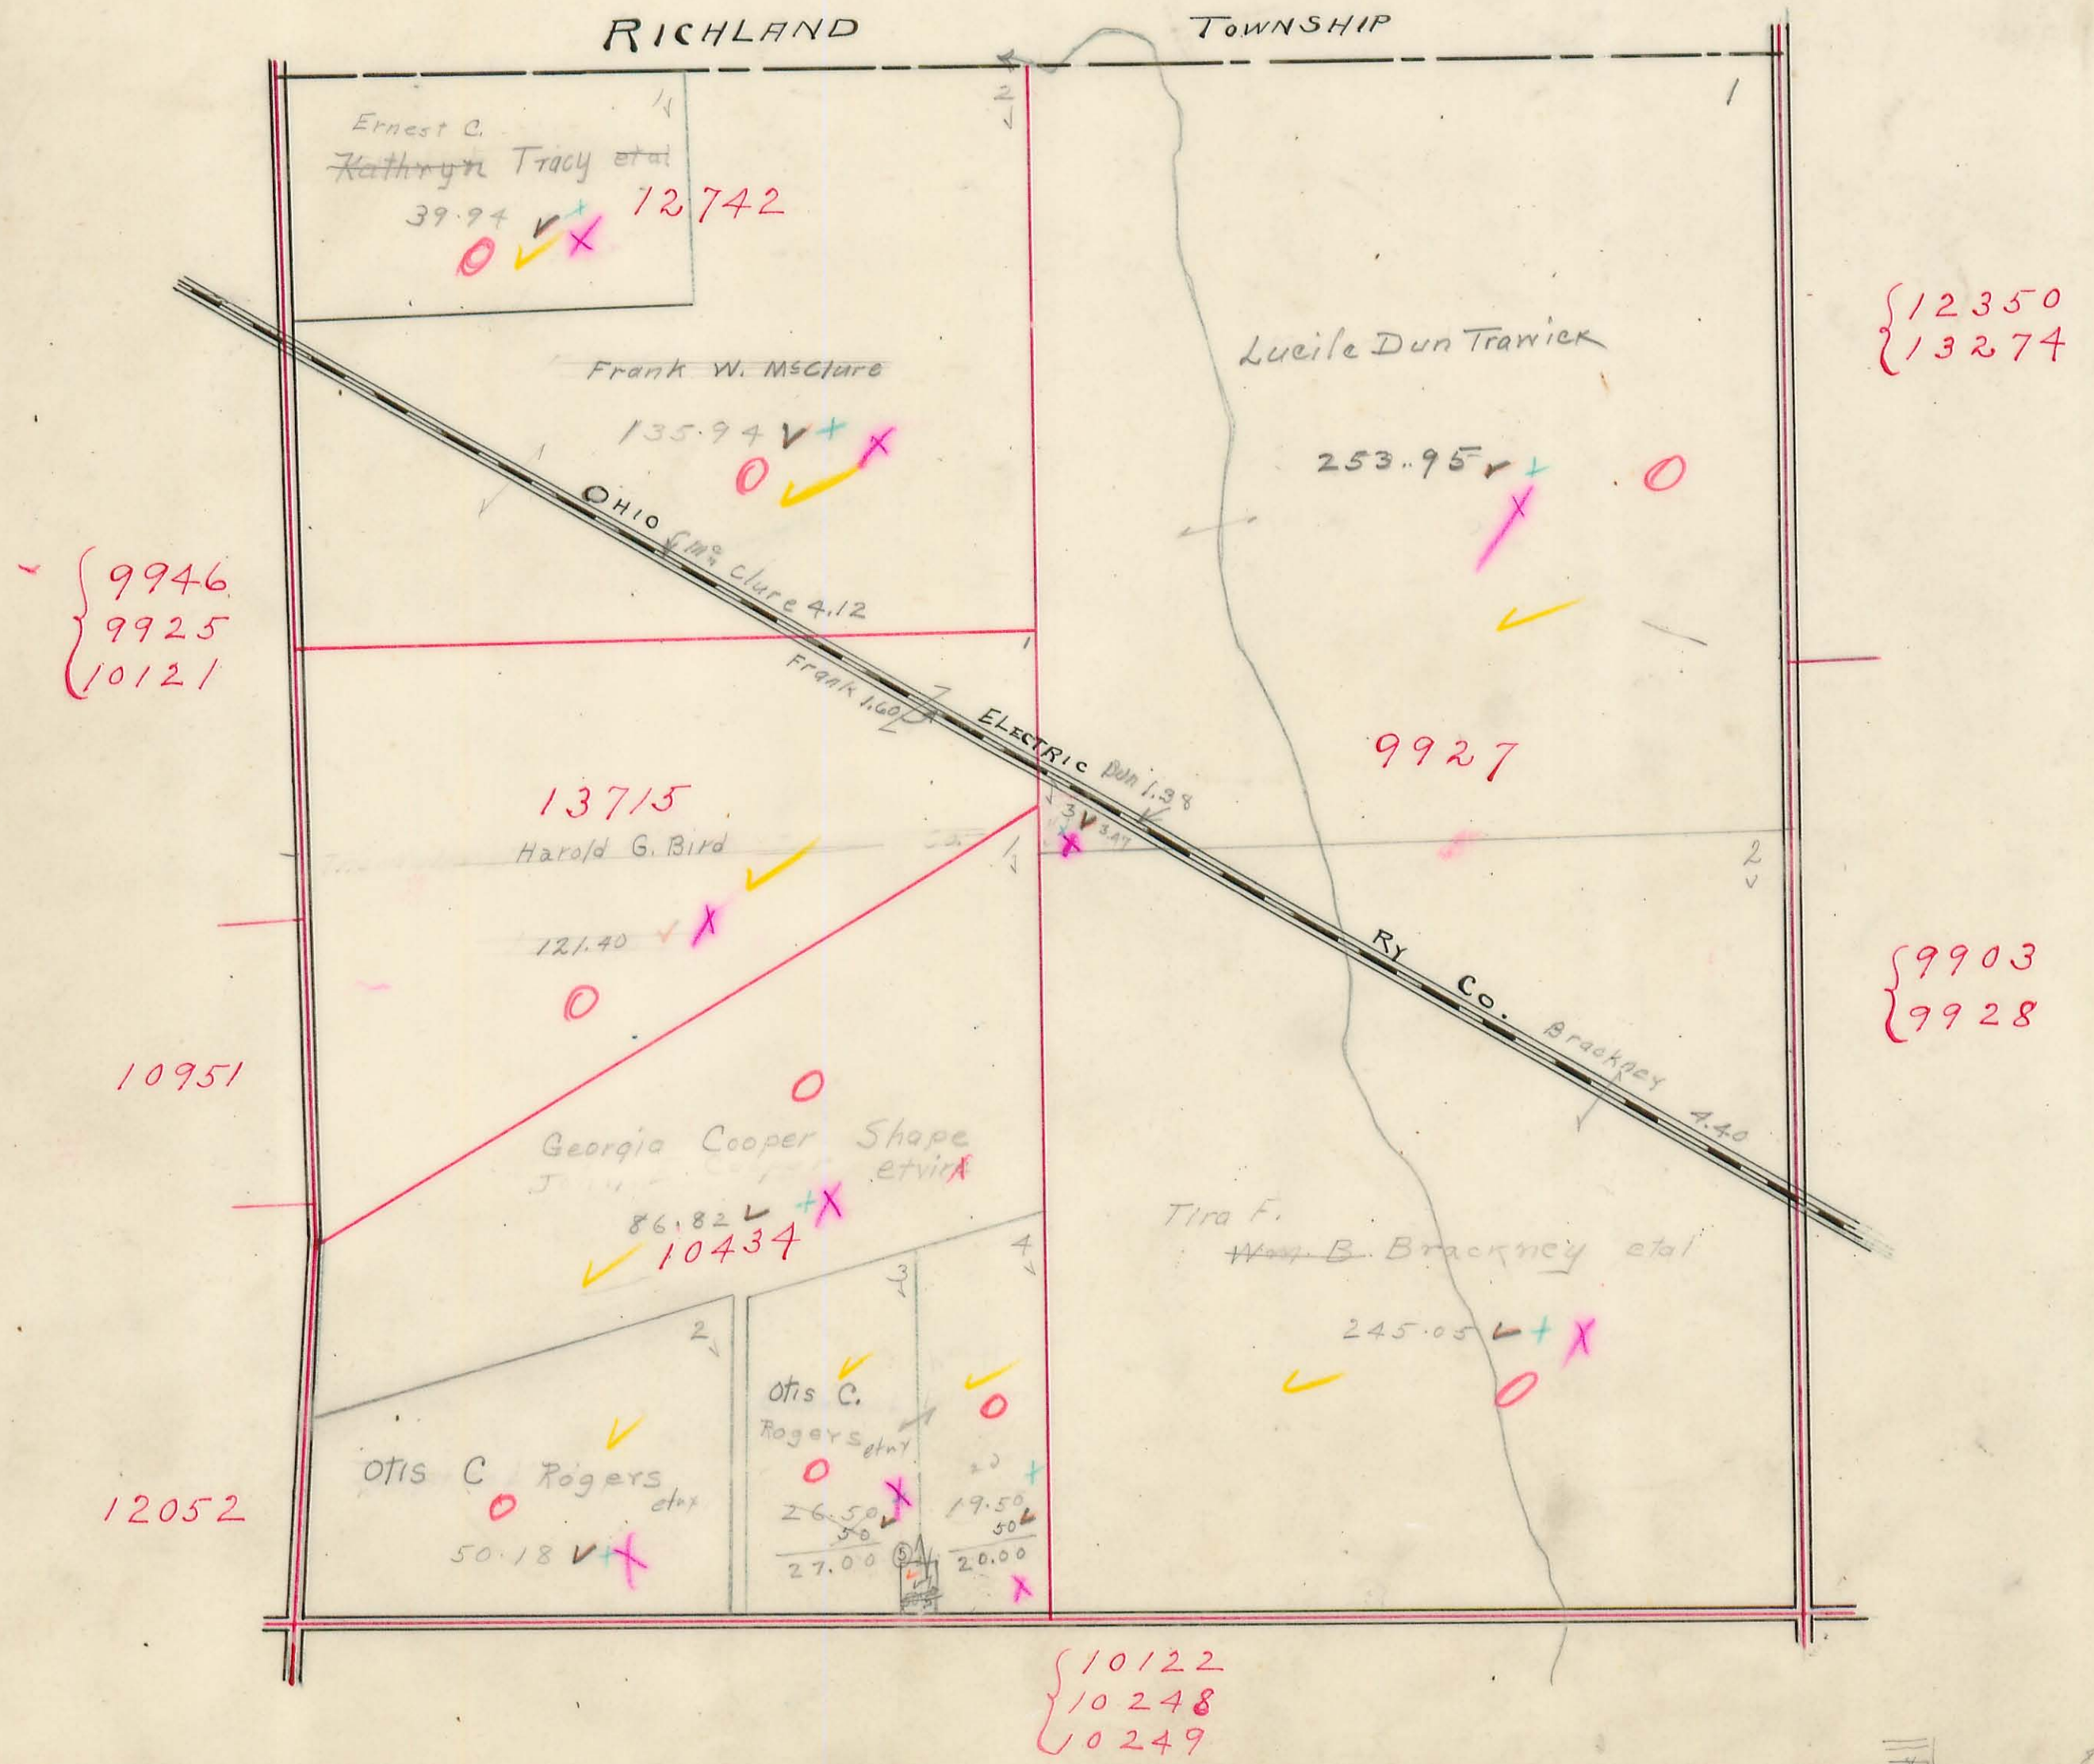


McARTHUR TOWNSHIP.

Plat of Virginia Military Survey No. 12320

Scale: 1 inch = 10 chains.


12350
13274
N. PART } 9903
 } 9928

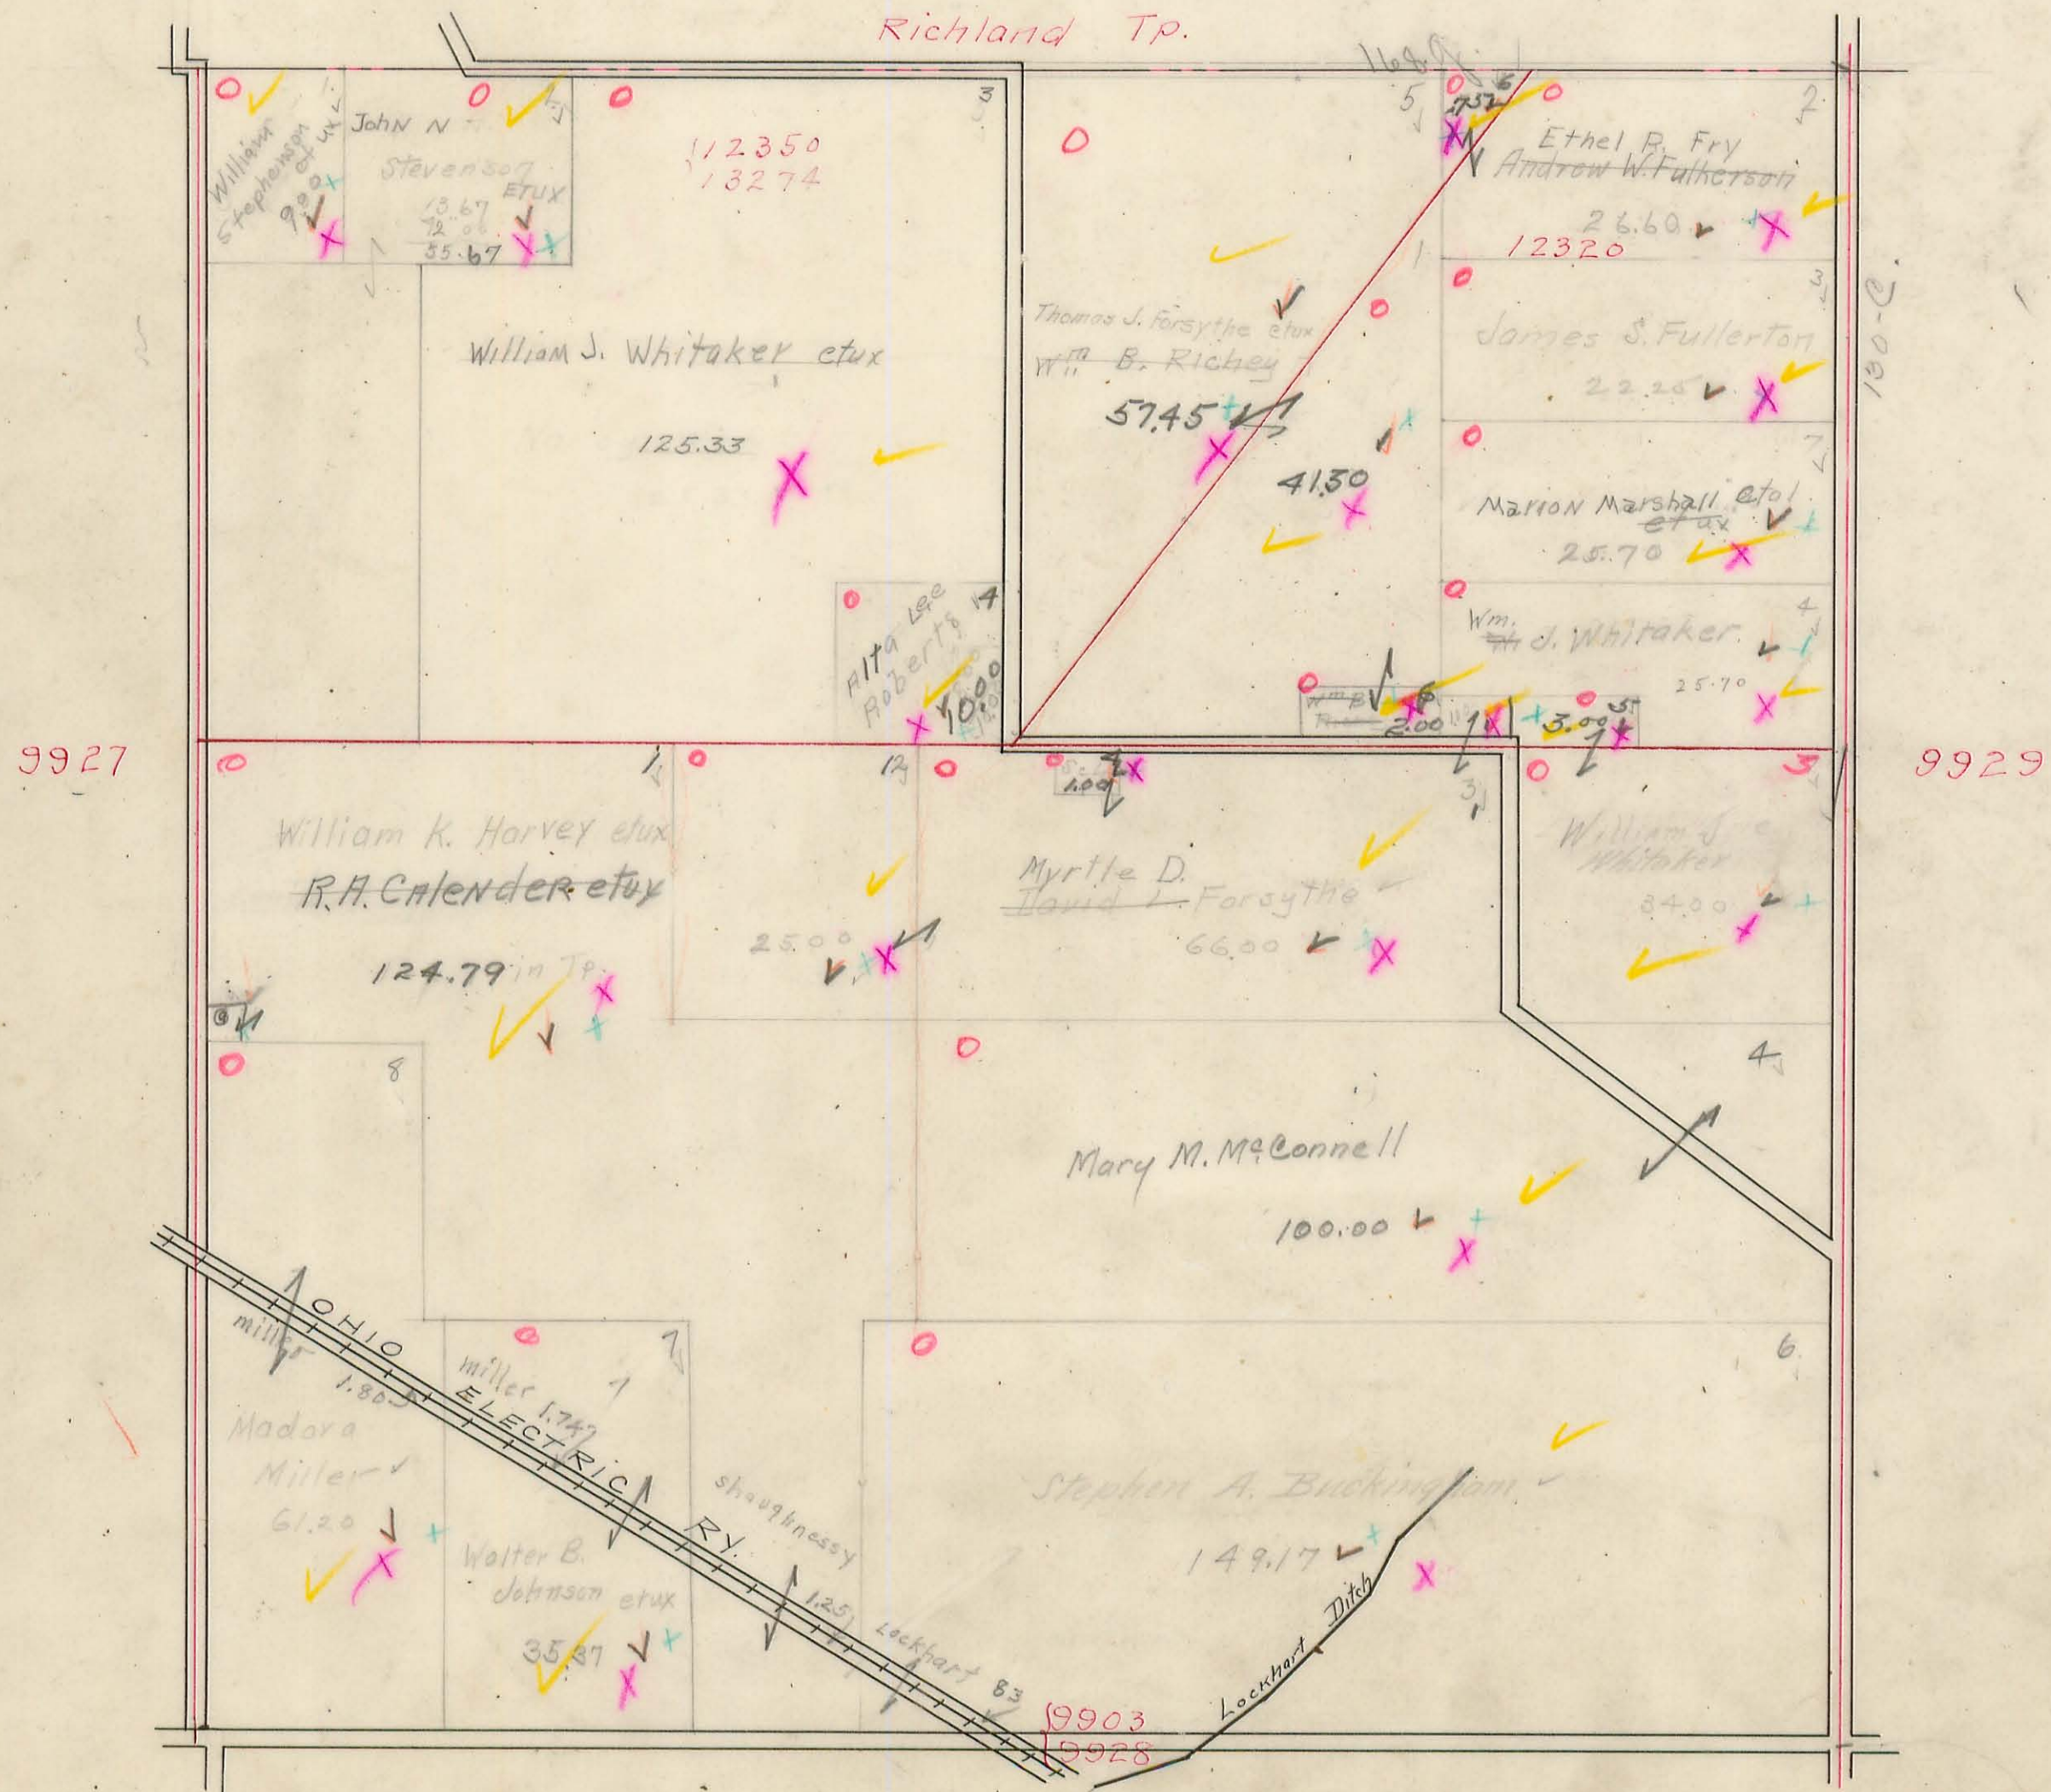

McARTHUR TOWNSHIP.

Plat of Virginia Military Survey No. 9904

Scale: 1 inch = 10 chains.

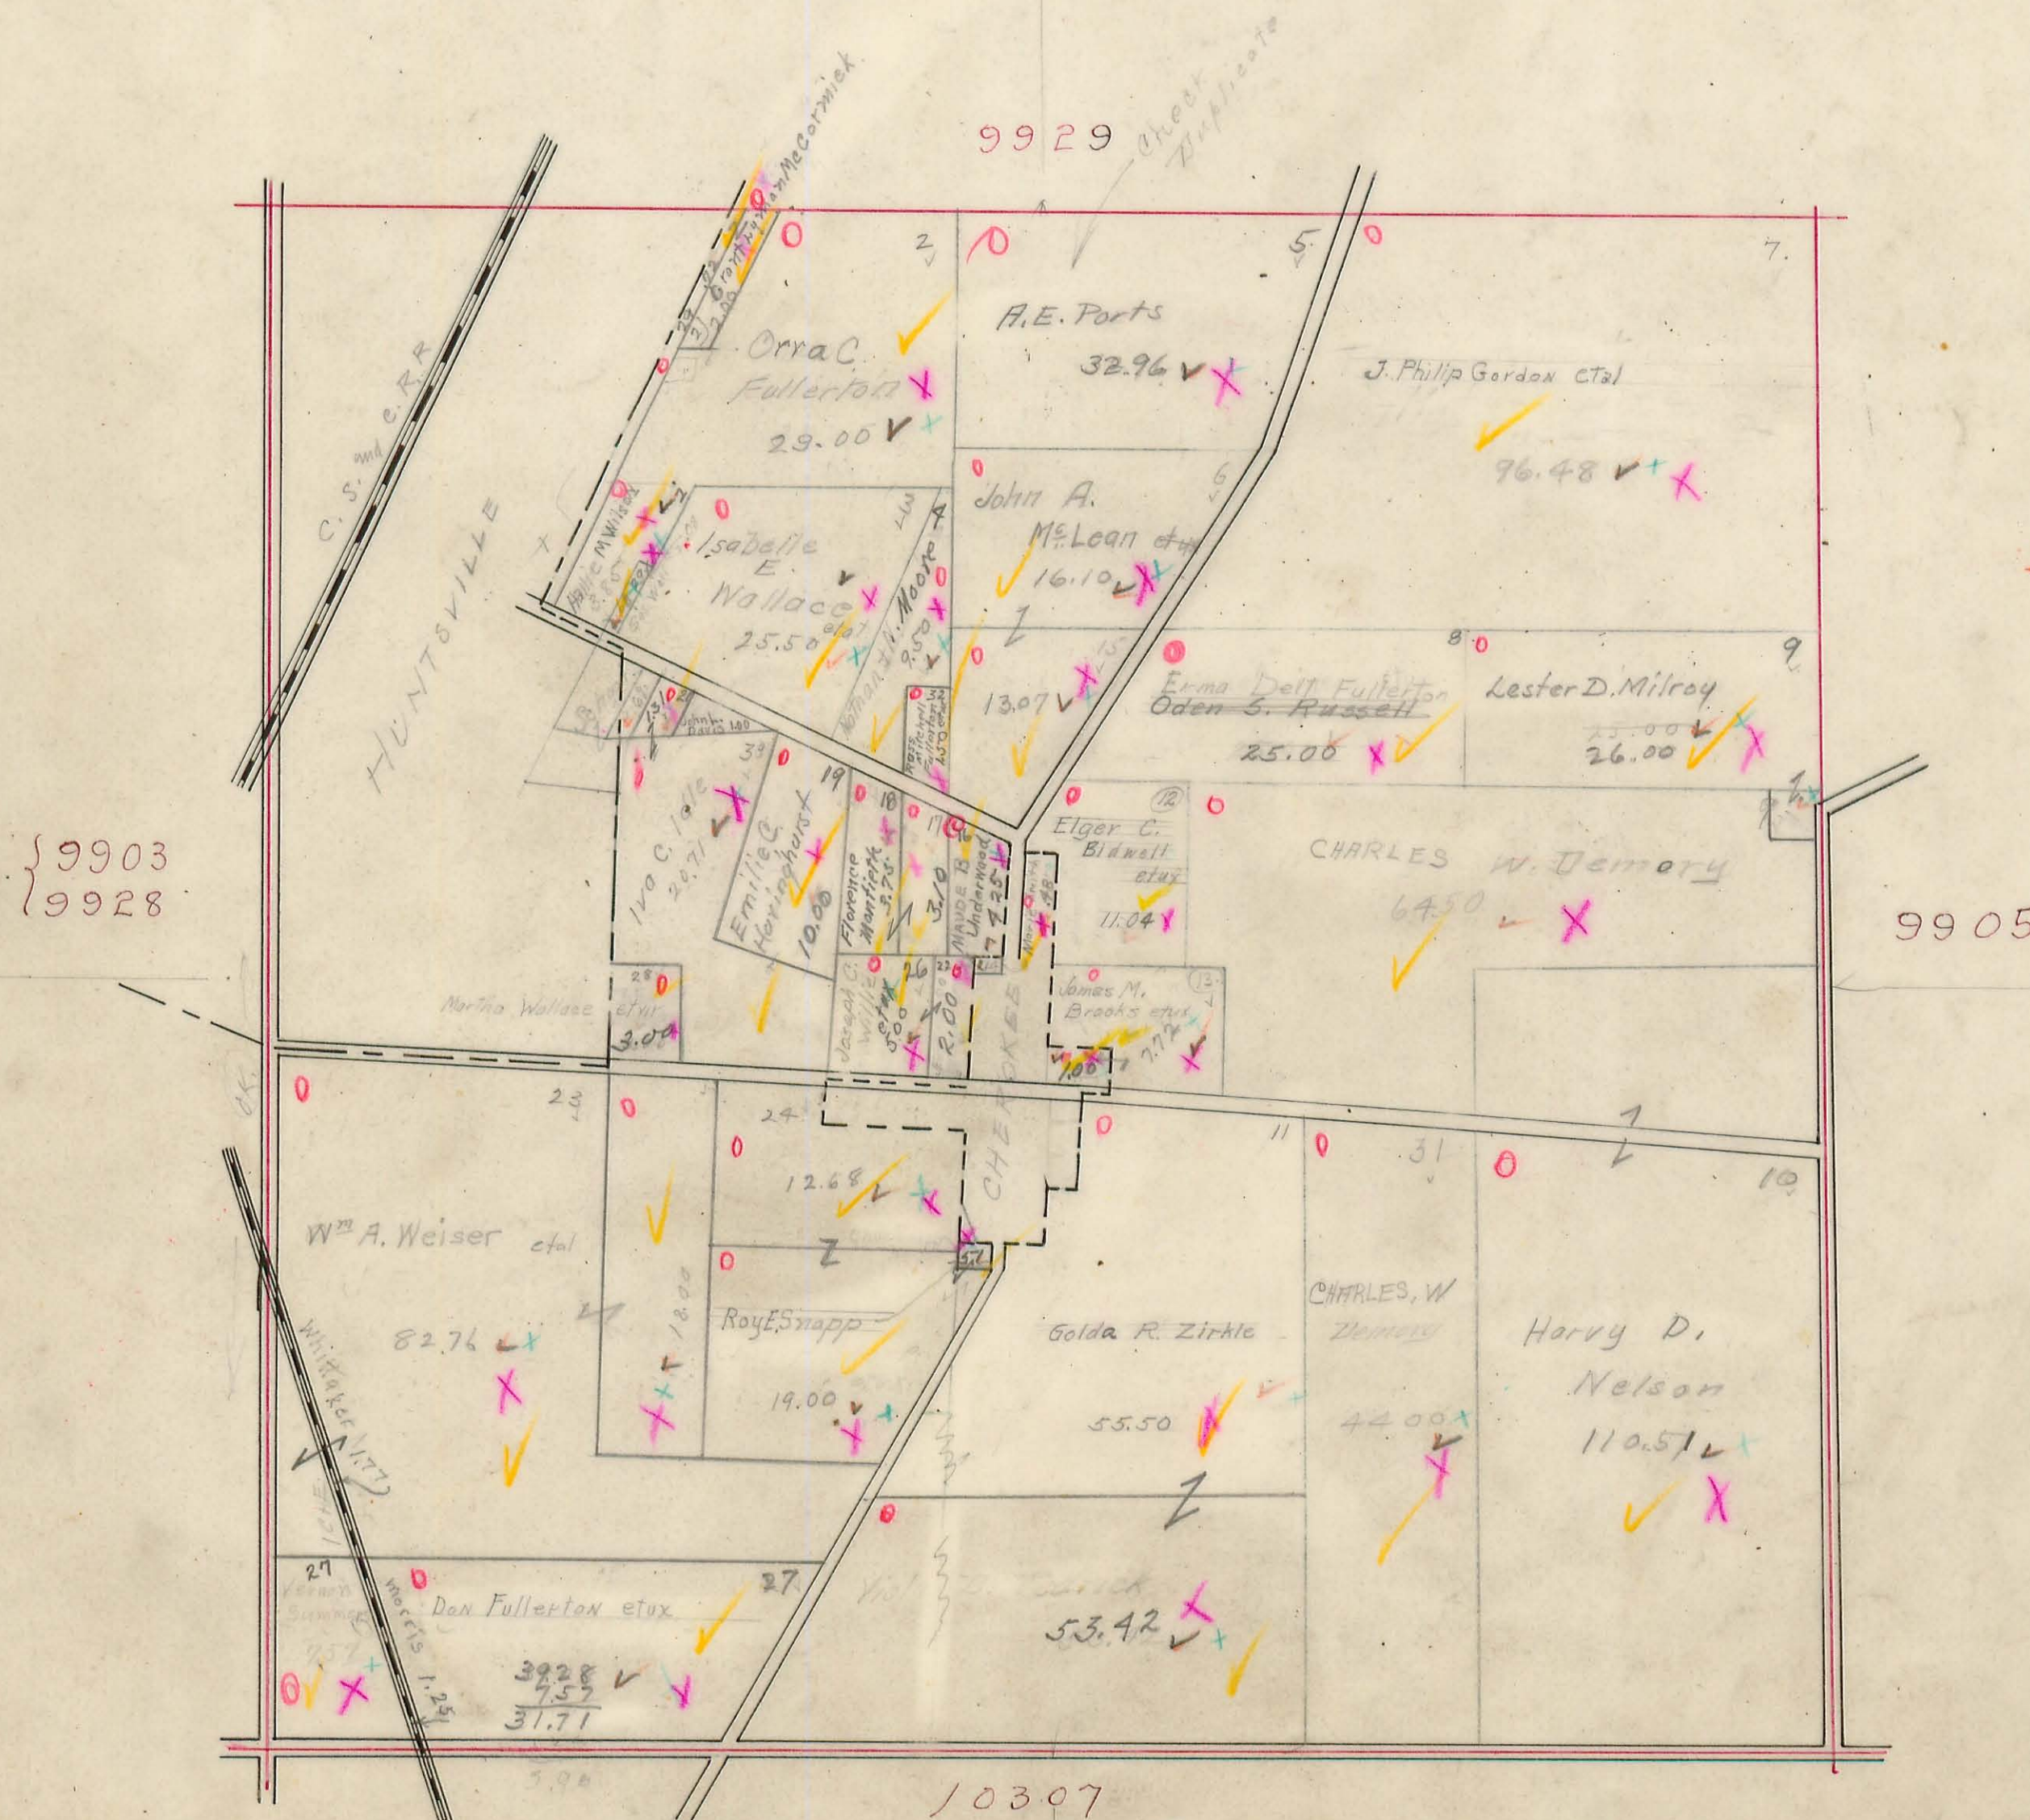


18
16
108
188
197

406
12
3930

McARTHUR TOWNSHIP.

Plat of Virginia Military Survey No. 9929

Scale: 1 inch = 10 chains.

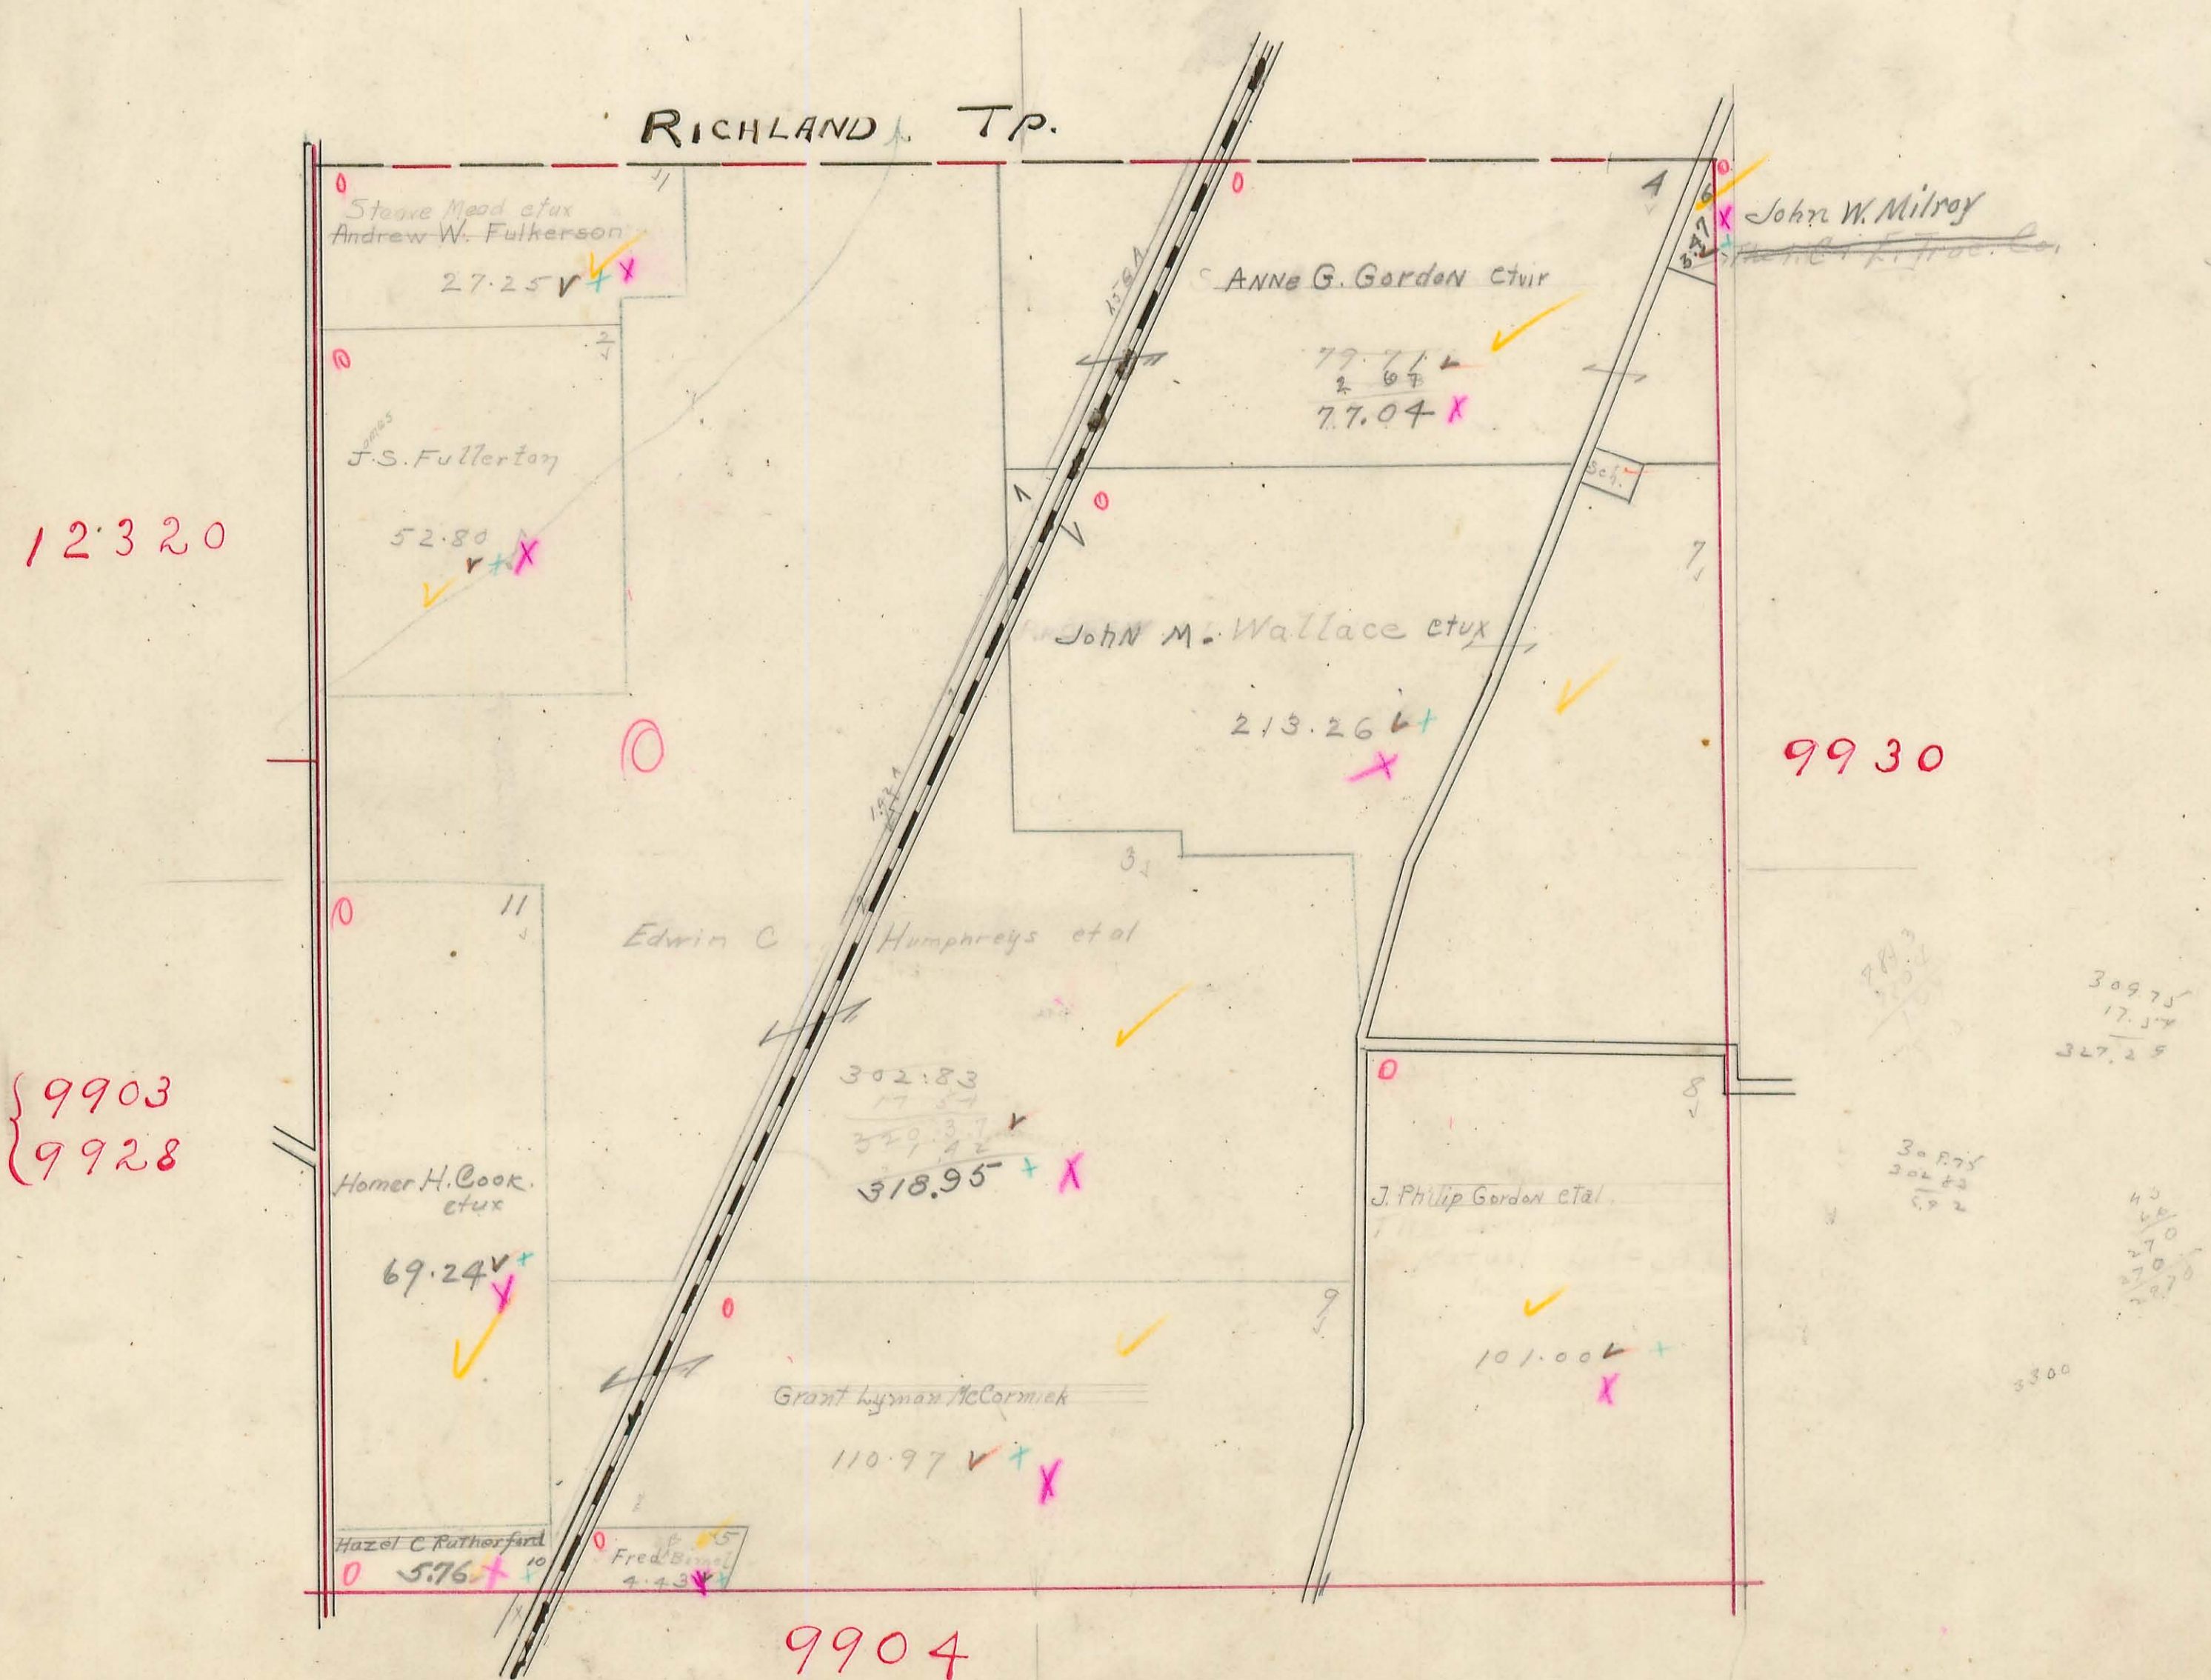


McARTHUR TOWNSHIP.

Plat of Virginia Military Survey No. 9930

Scale: 1 inch = 10 chains.

RICHLAND TOWNSHIP

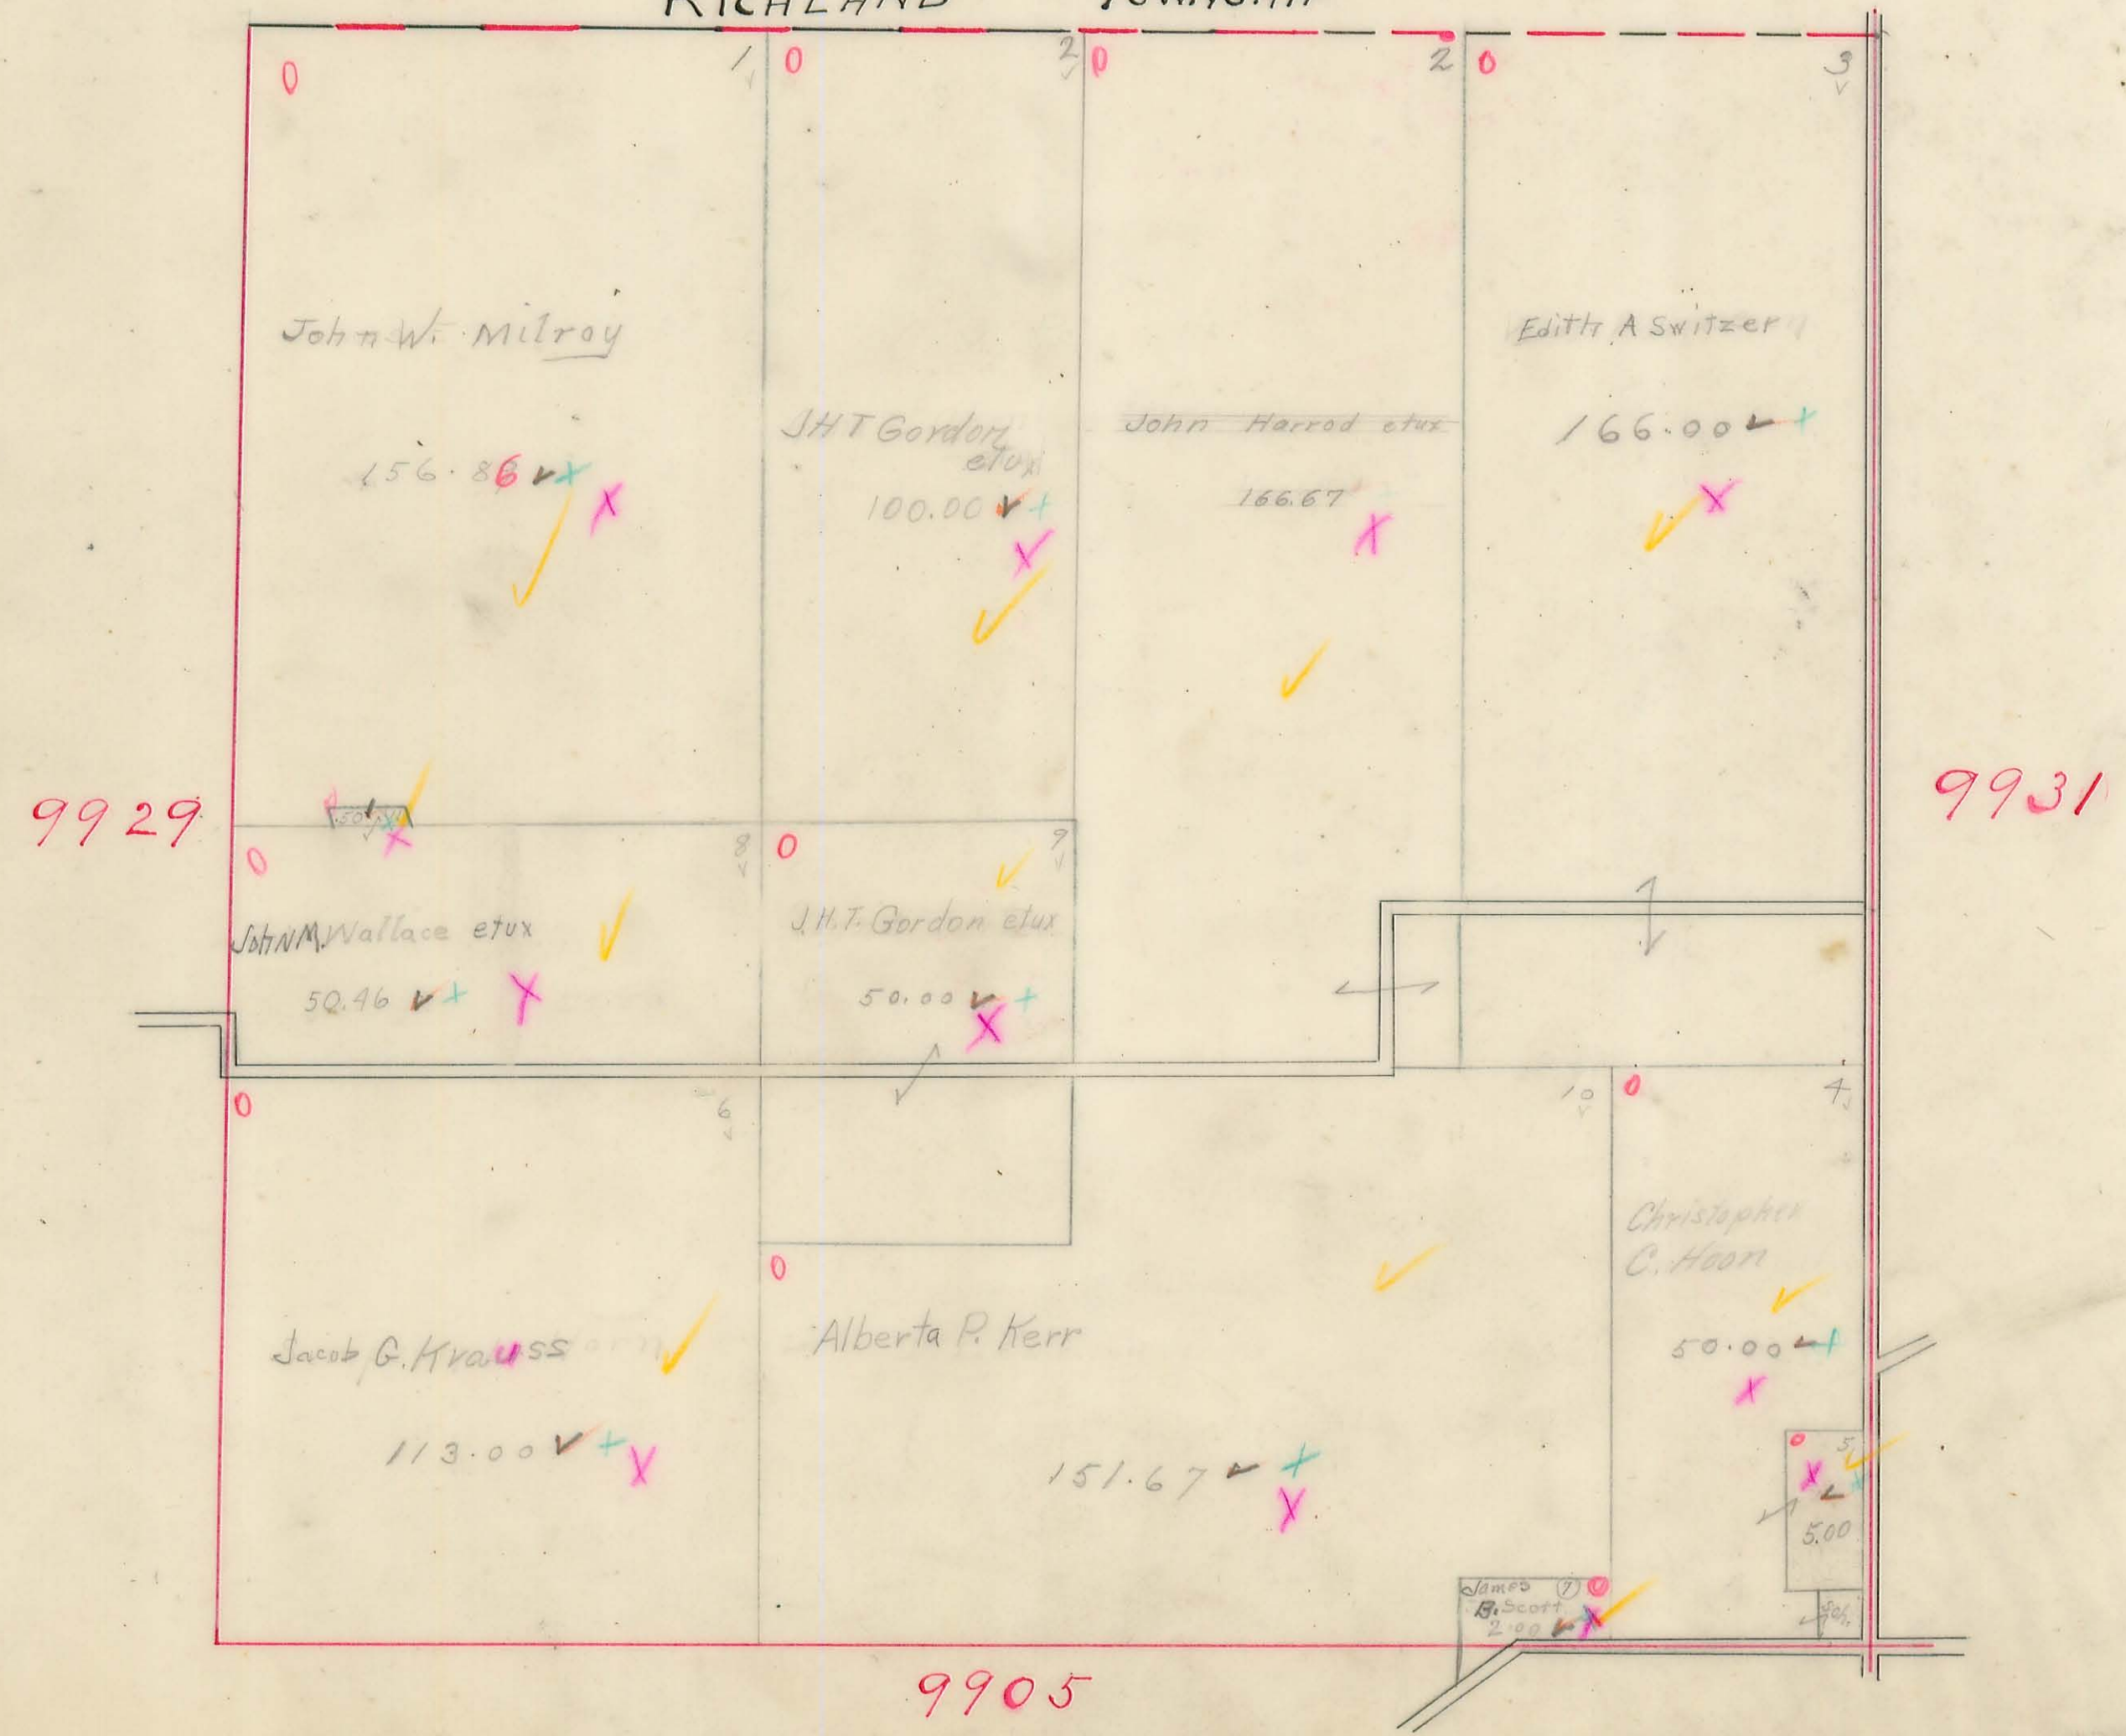


McARTHUR TOWNSHIP.

Plat of Virginia Military Survey No. 9931

Scale: 1 inch = 10 chains.

RICHLAND TP.

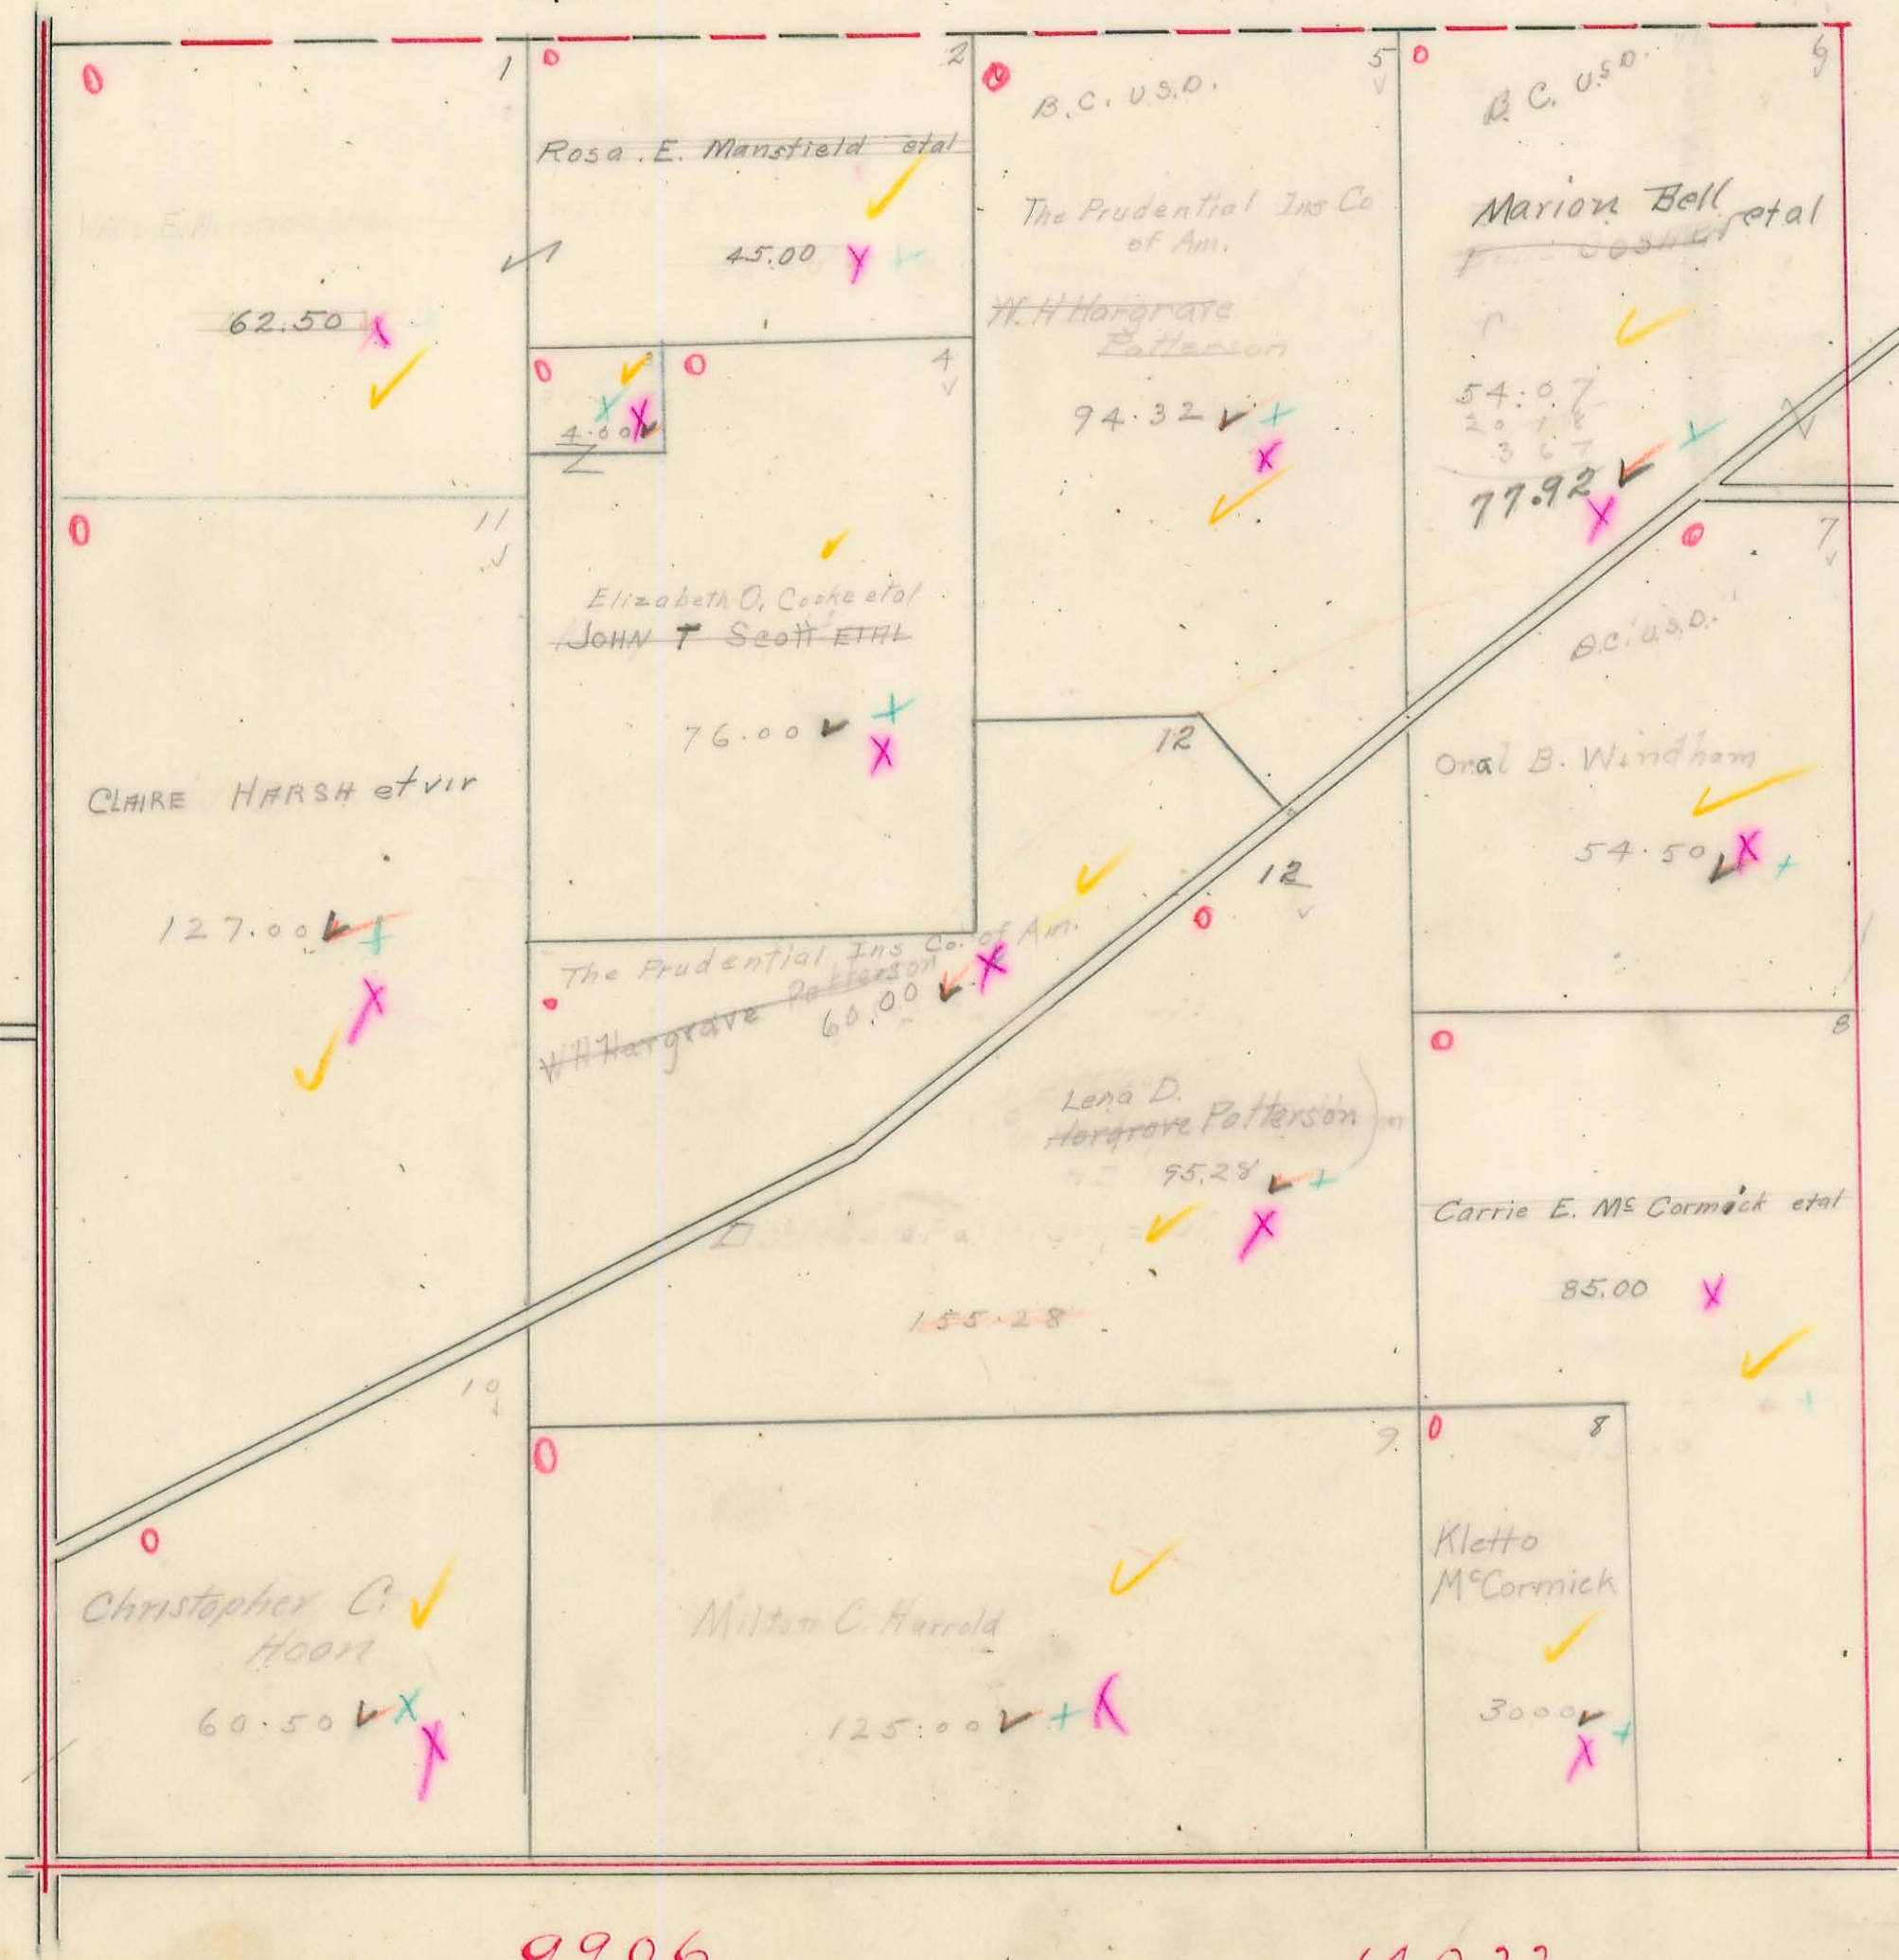

9930

9932

9906

14033

OK
4/24

McARTHUR TOWNSHIP.

Plat of Virginia Military Survey No. 9932


Scale: 1 inch = 10 chains.



McARTHUR TOWNSHIP.

Plat of Virginia Military Survey No. 9905


Scale: 1 inch = 10 chains.

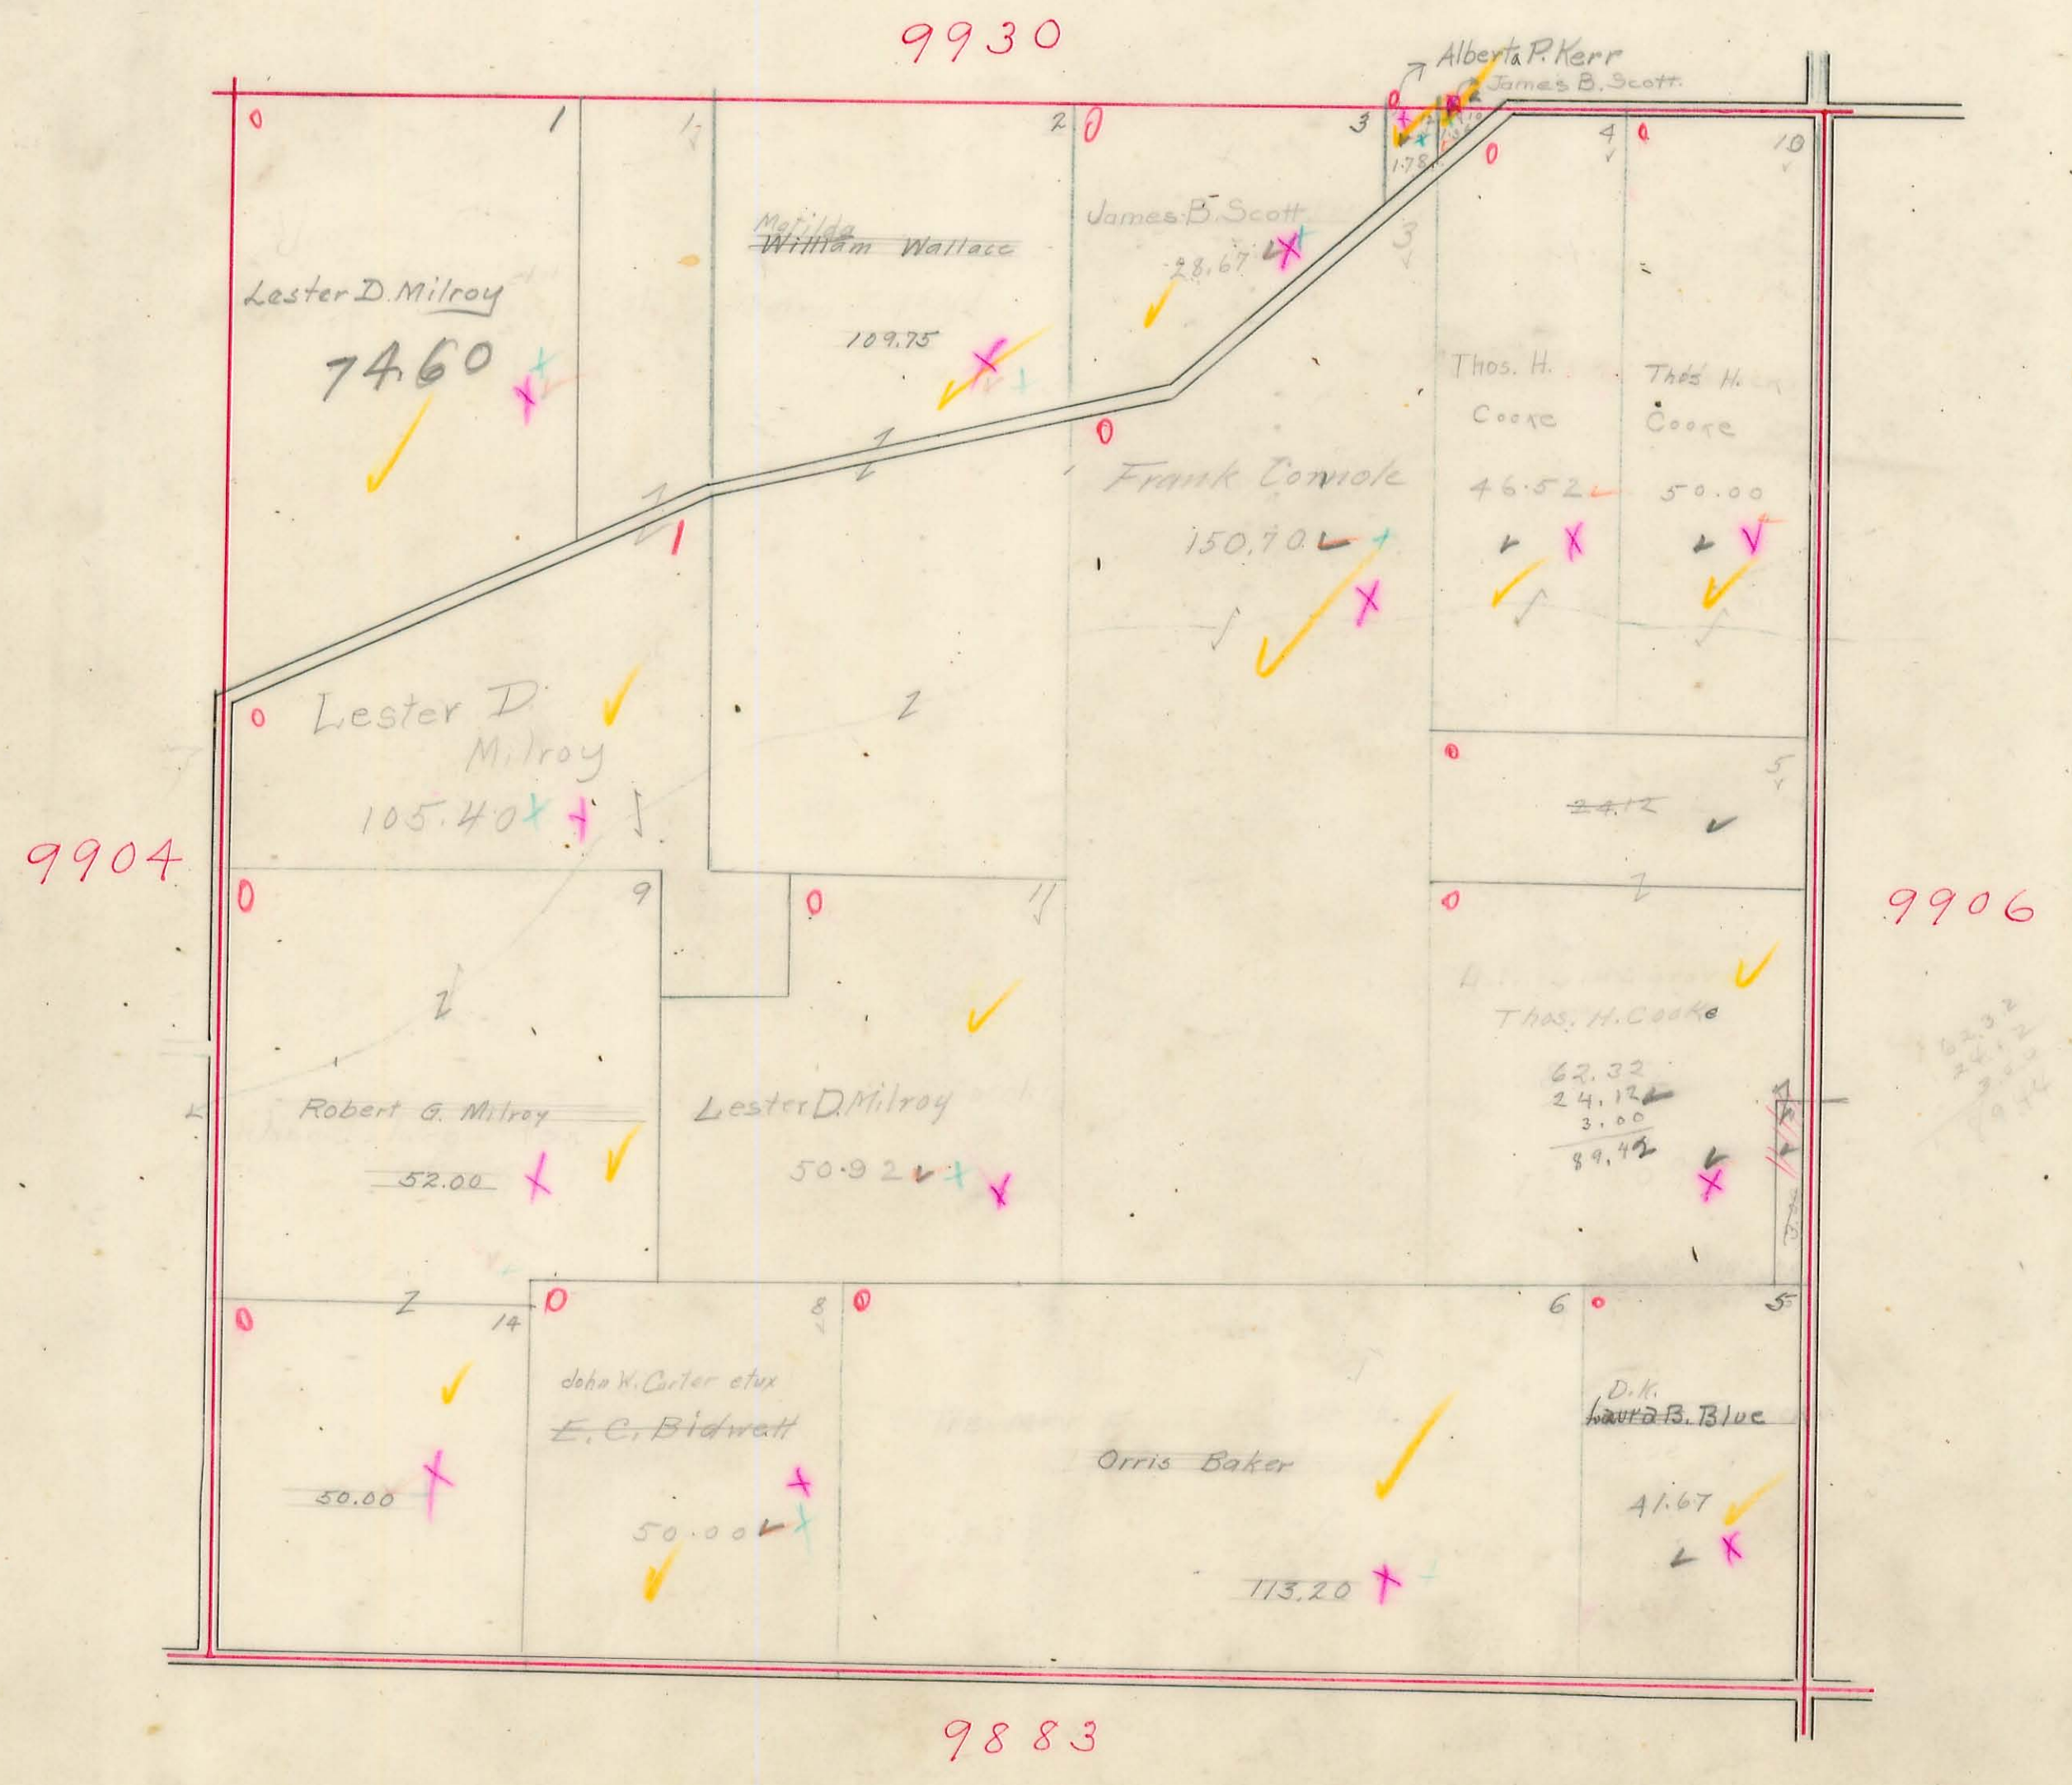

McARTHUR TOWNSHIP.

Plat of Virginia Military Survey No. 9907


Scale: 1 inch = 10 chains.

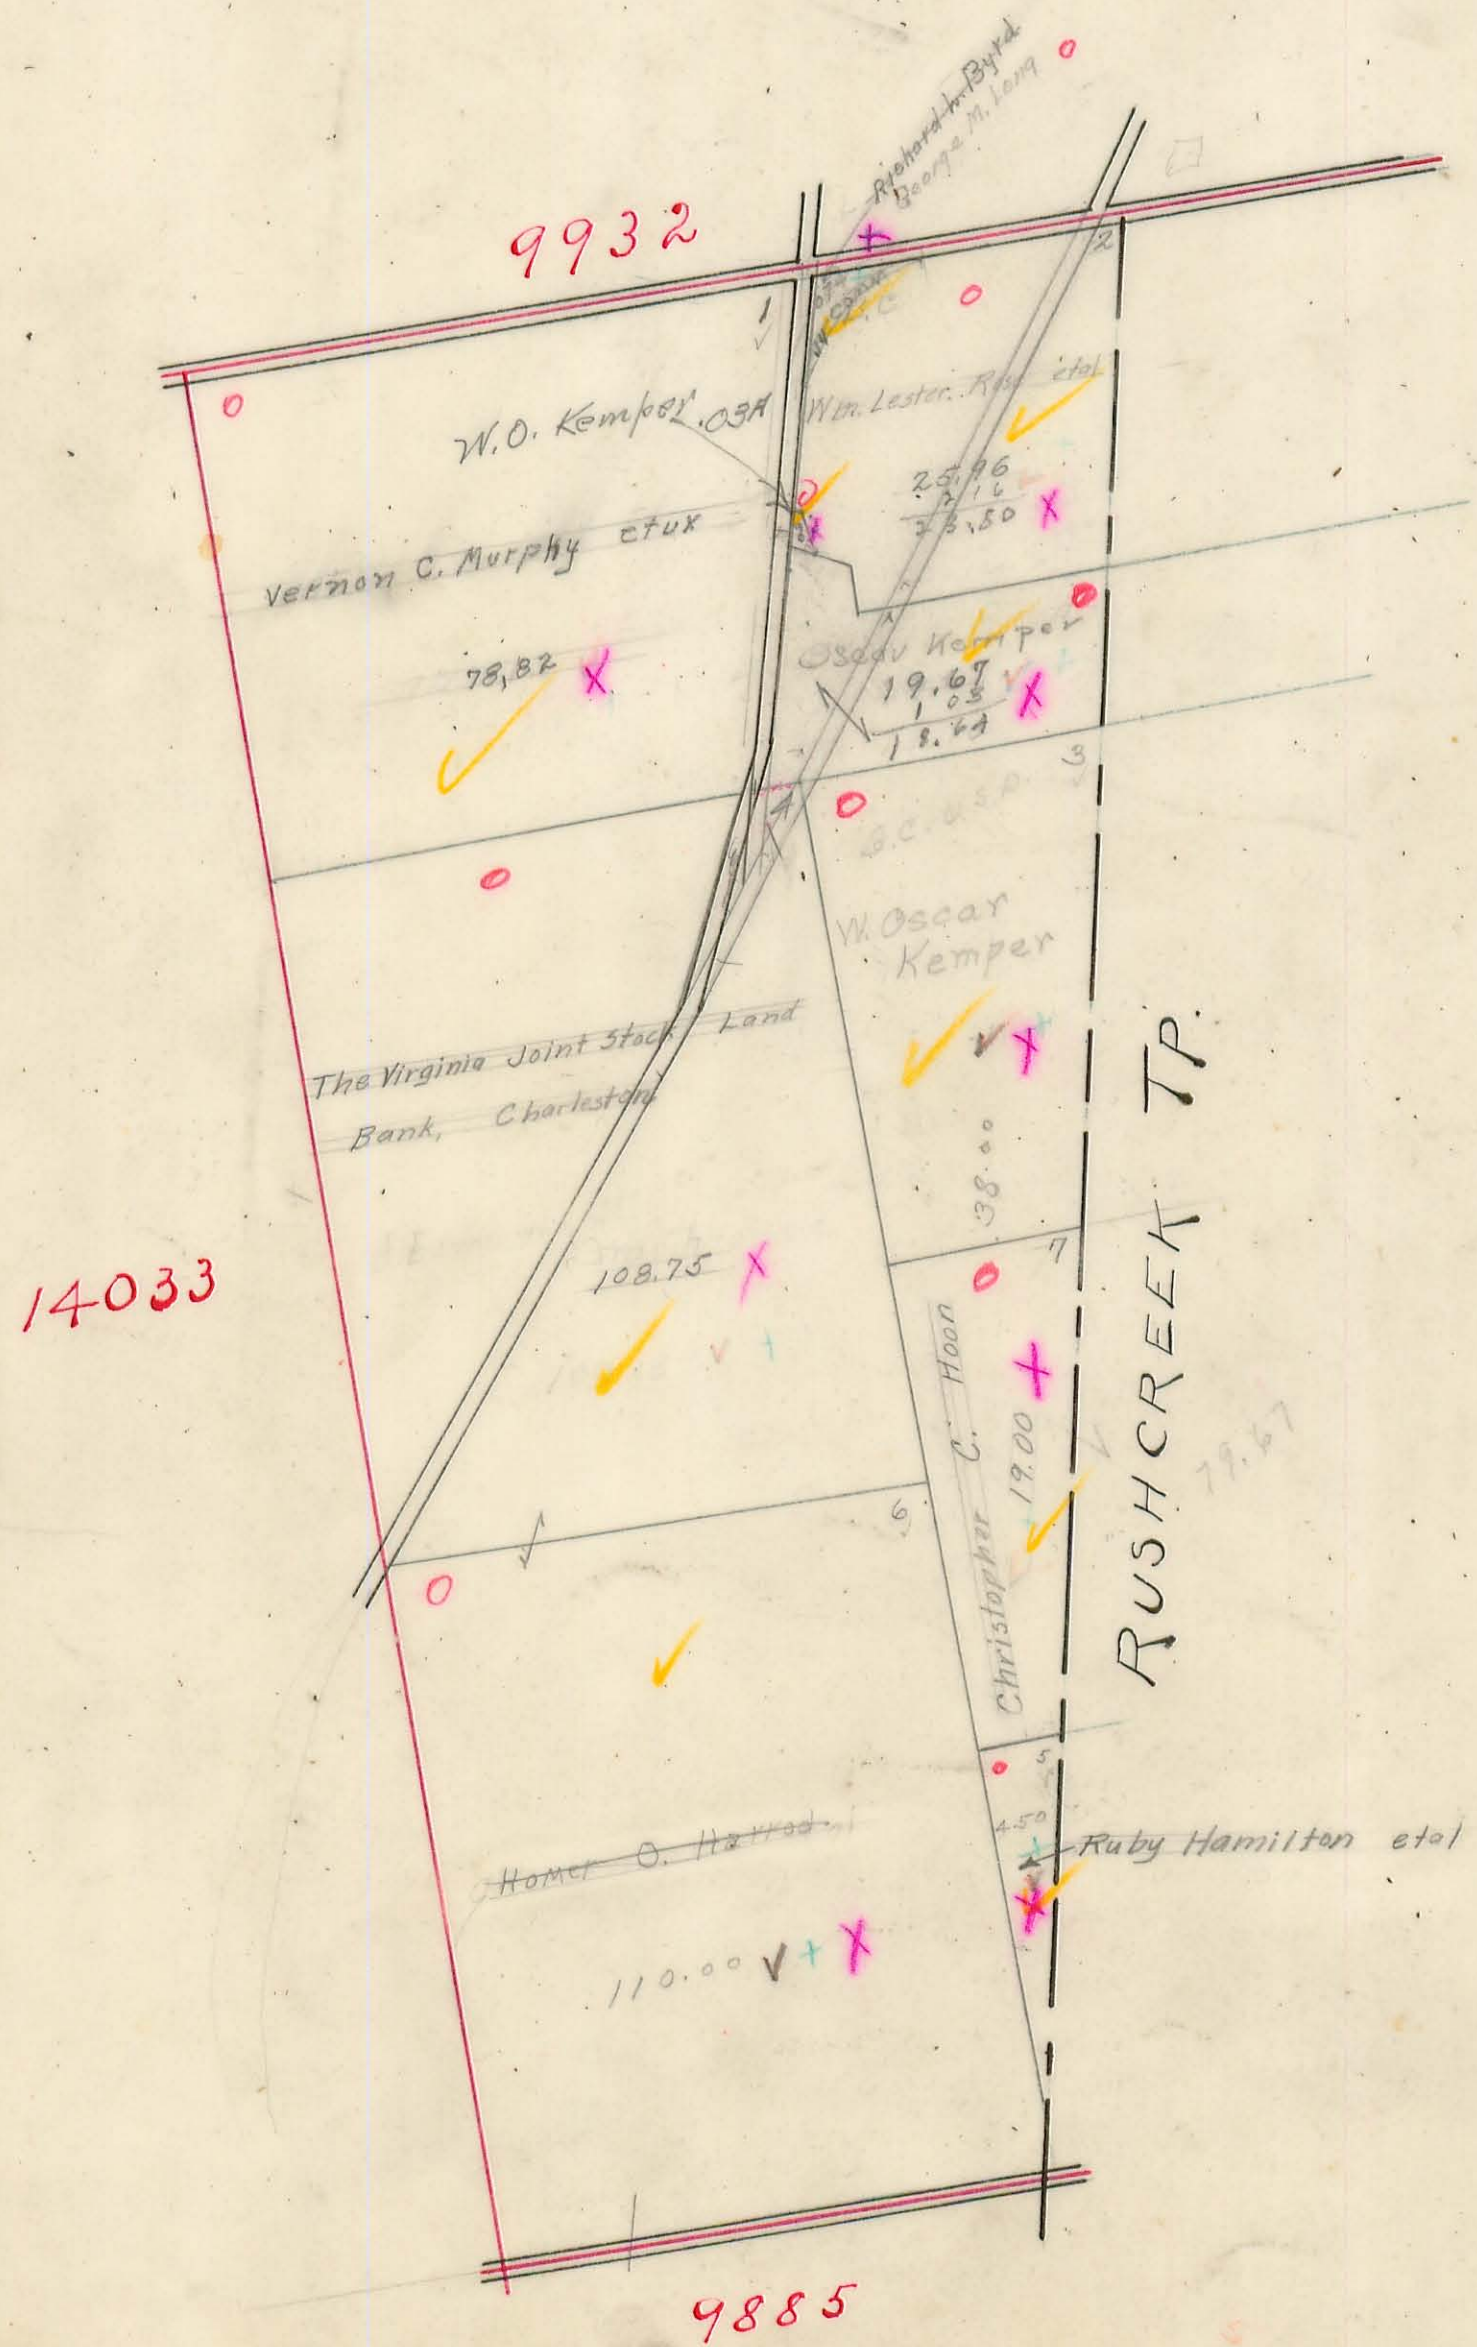

McARTHUR TOWNSHIP.

Plat of Virginia Military Survey No. 9902


Scale: 1 inch = 10 chains.

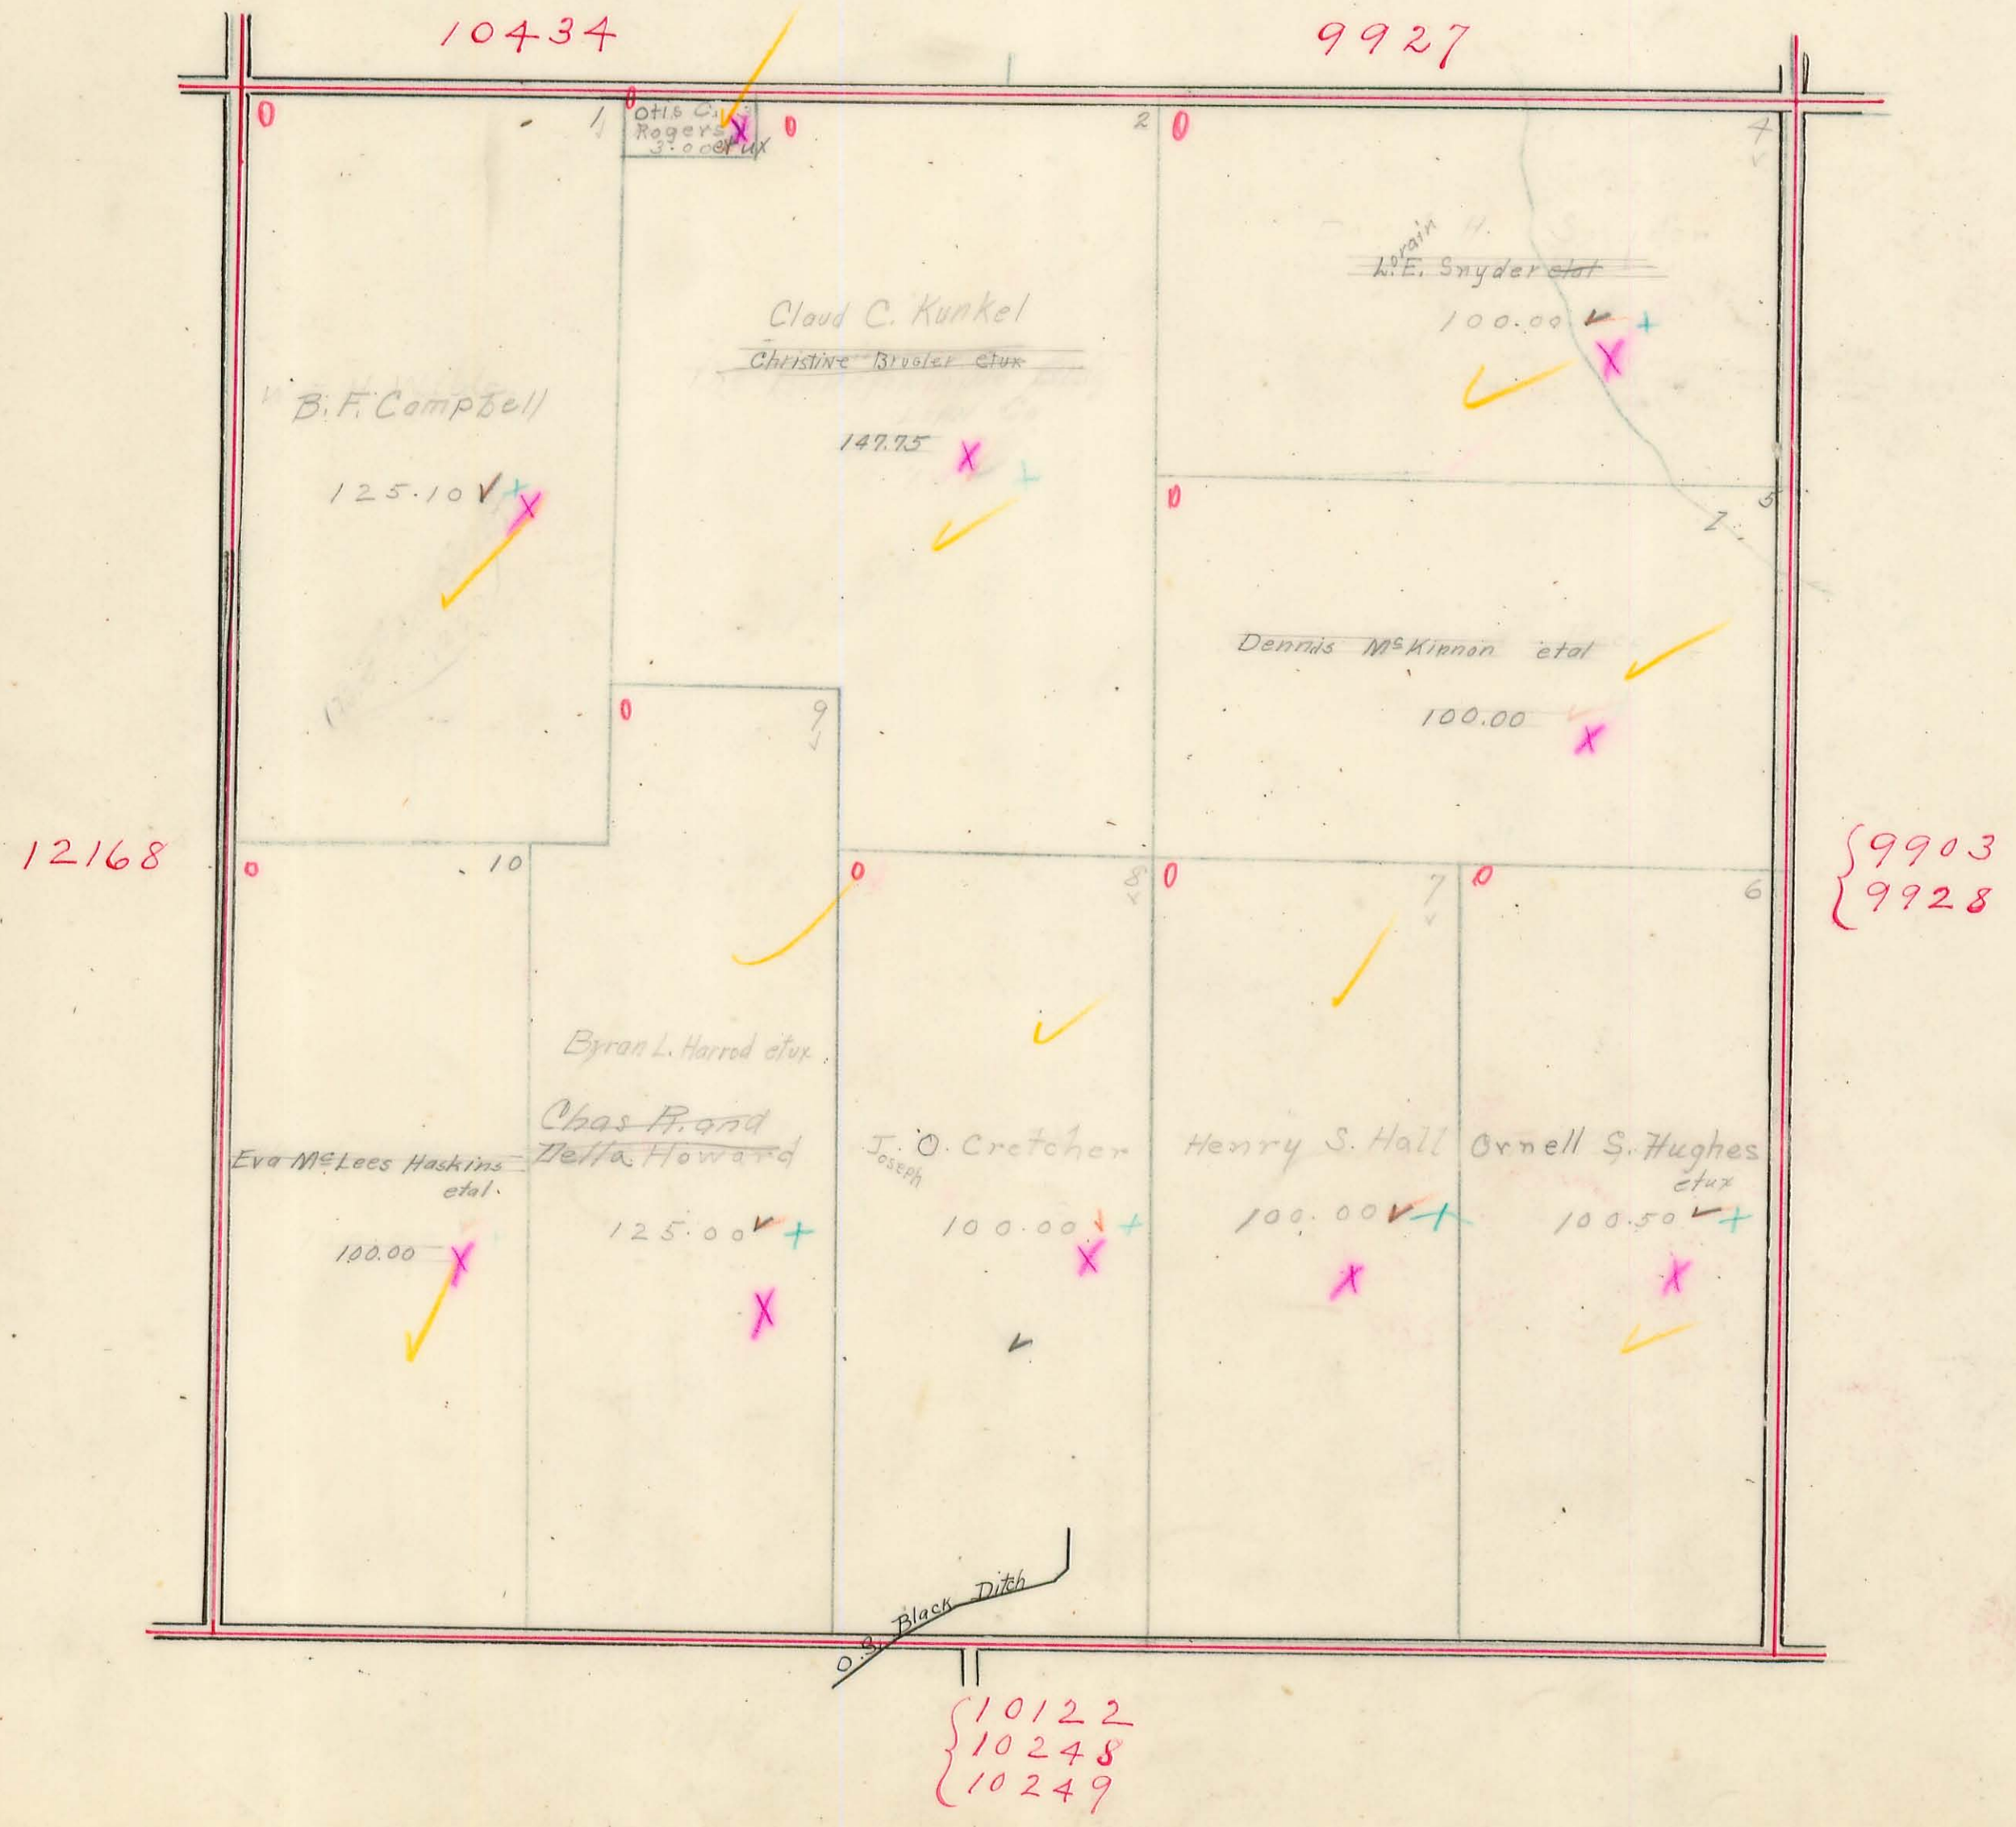

McARTHUR TOWNSHIP.


SECTIONS 17, 18, 19, 20 T. 7, R. 9.

SCALE: 1-INCH=10 CHAINS

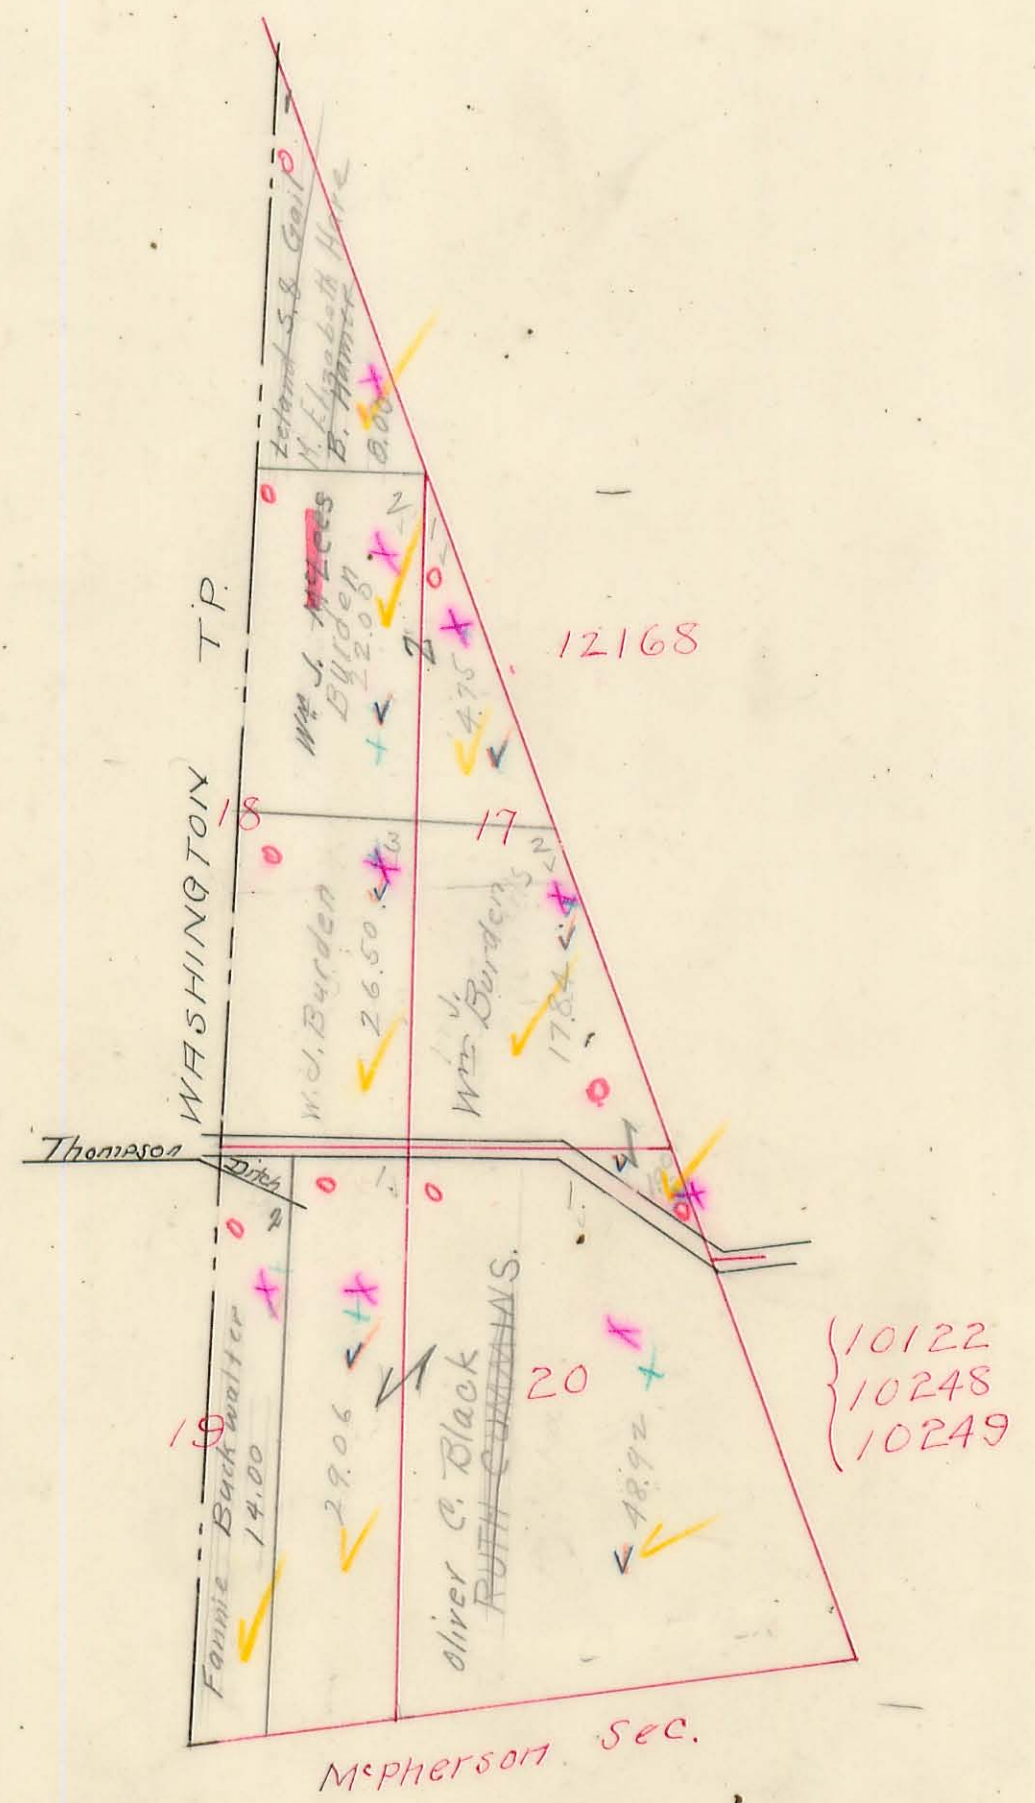

McARTHUR TOWNSHIP.

McPHERSON SECTION T. 7. R. 9.

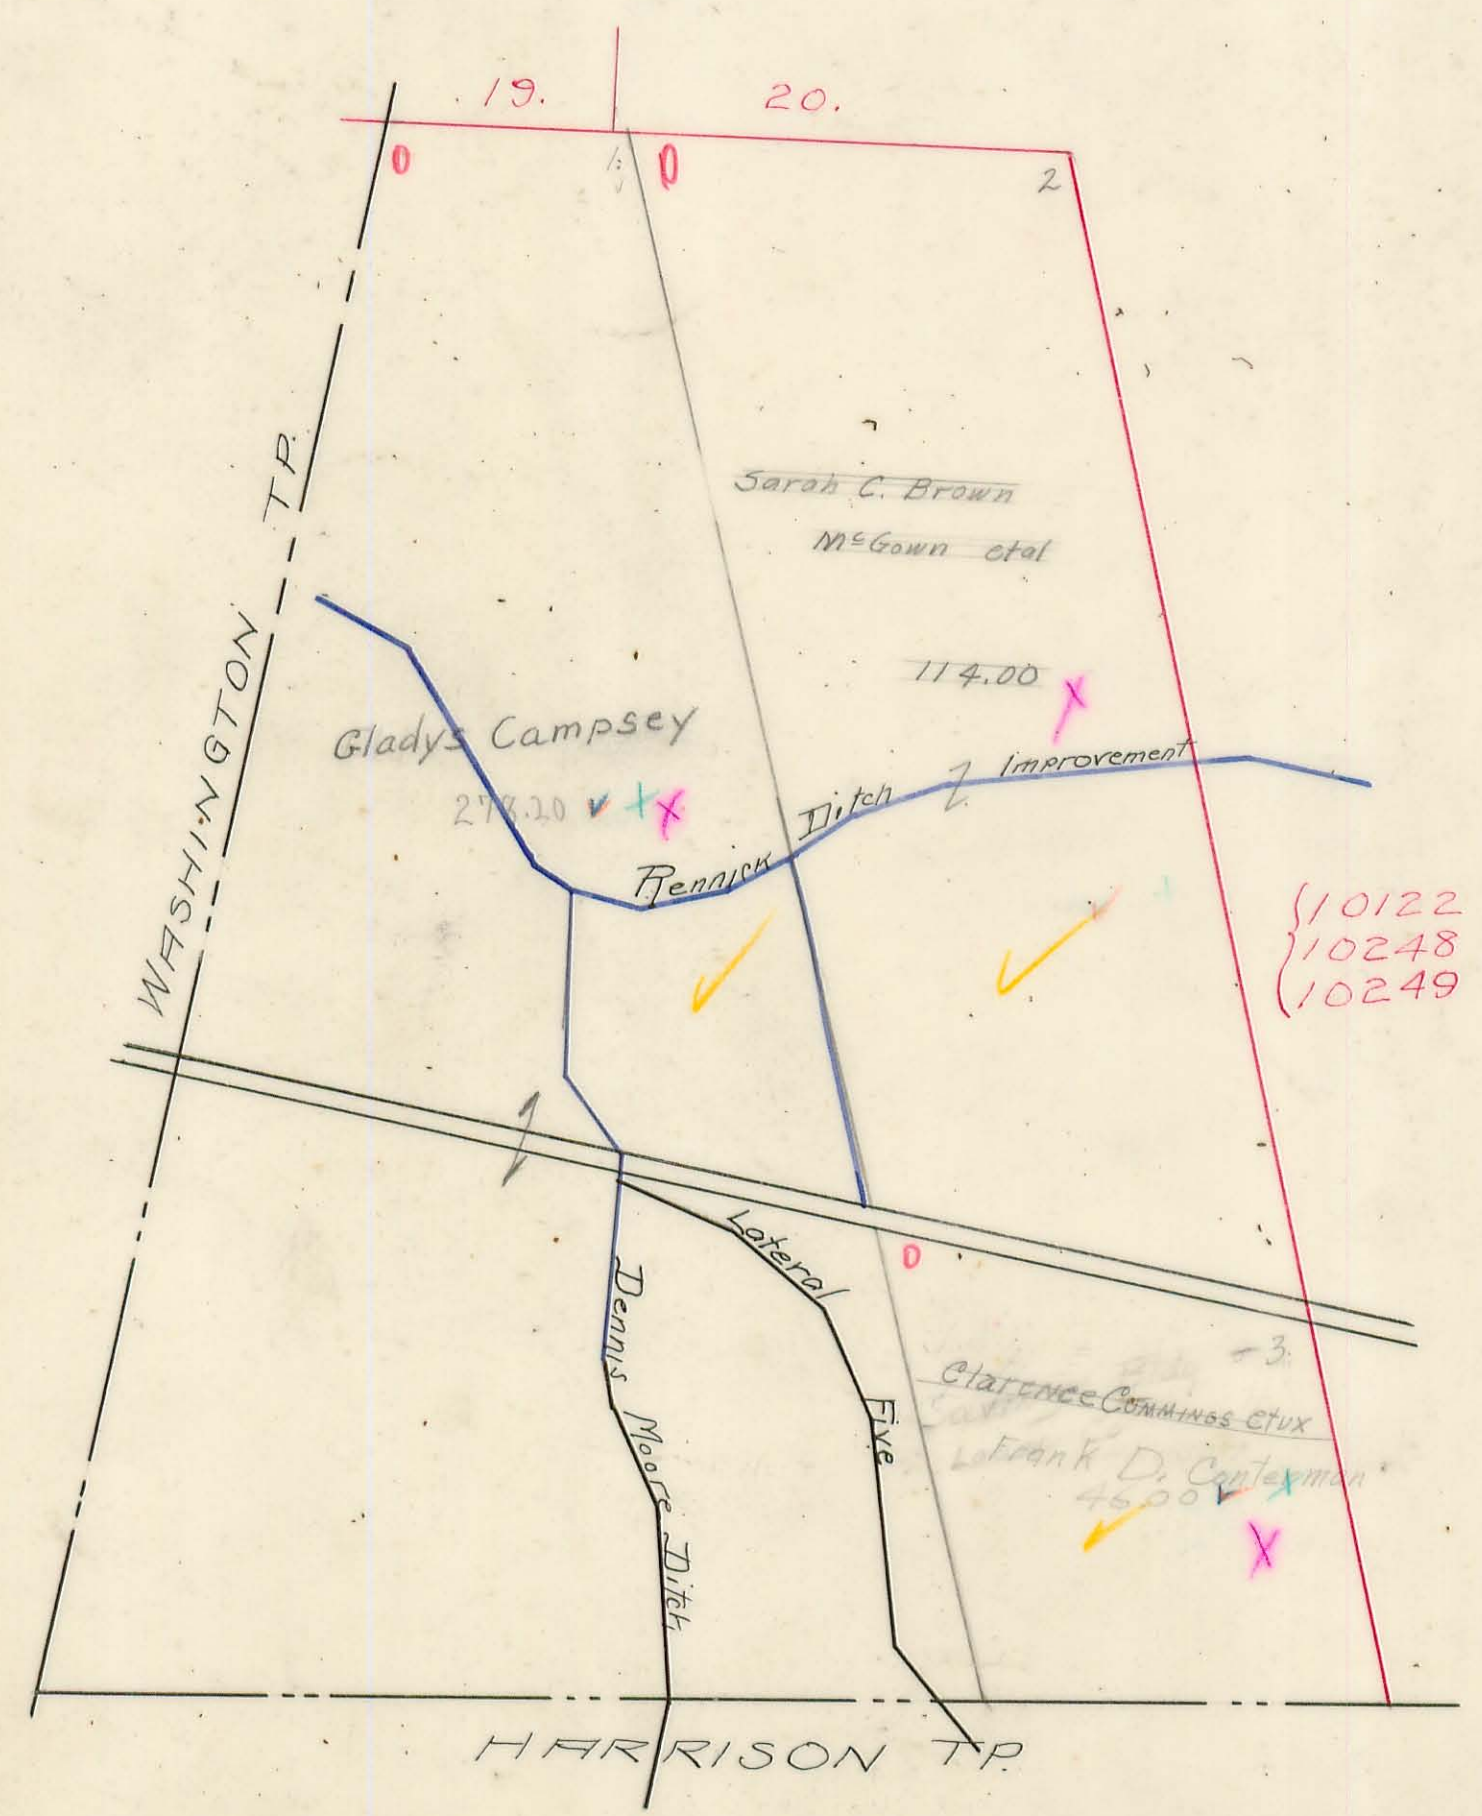


McARTHUR TOWNSHIP.

Plat of Virginia Military Survey No. } 10122
10248

Scale: 1 inch = 10 chains.


10249

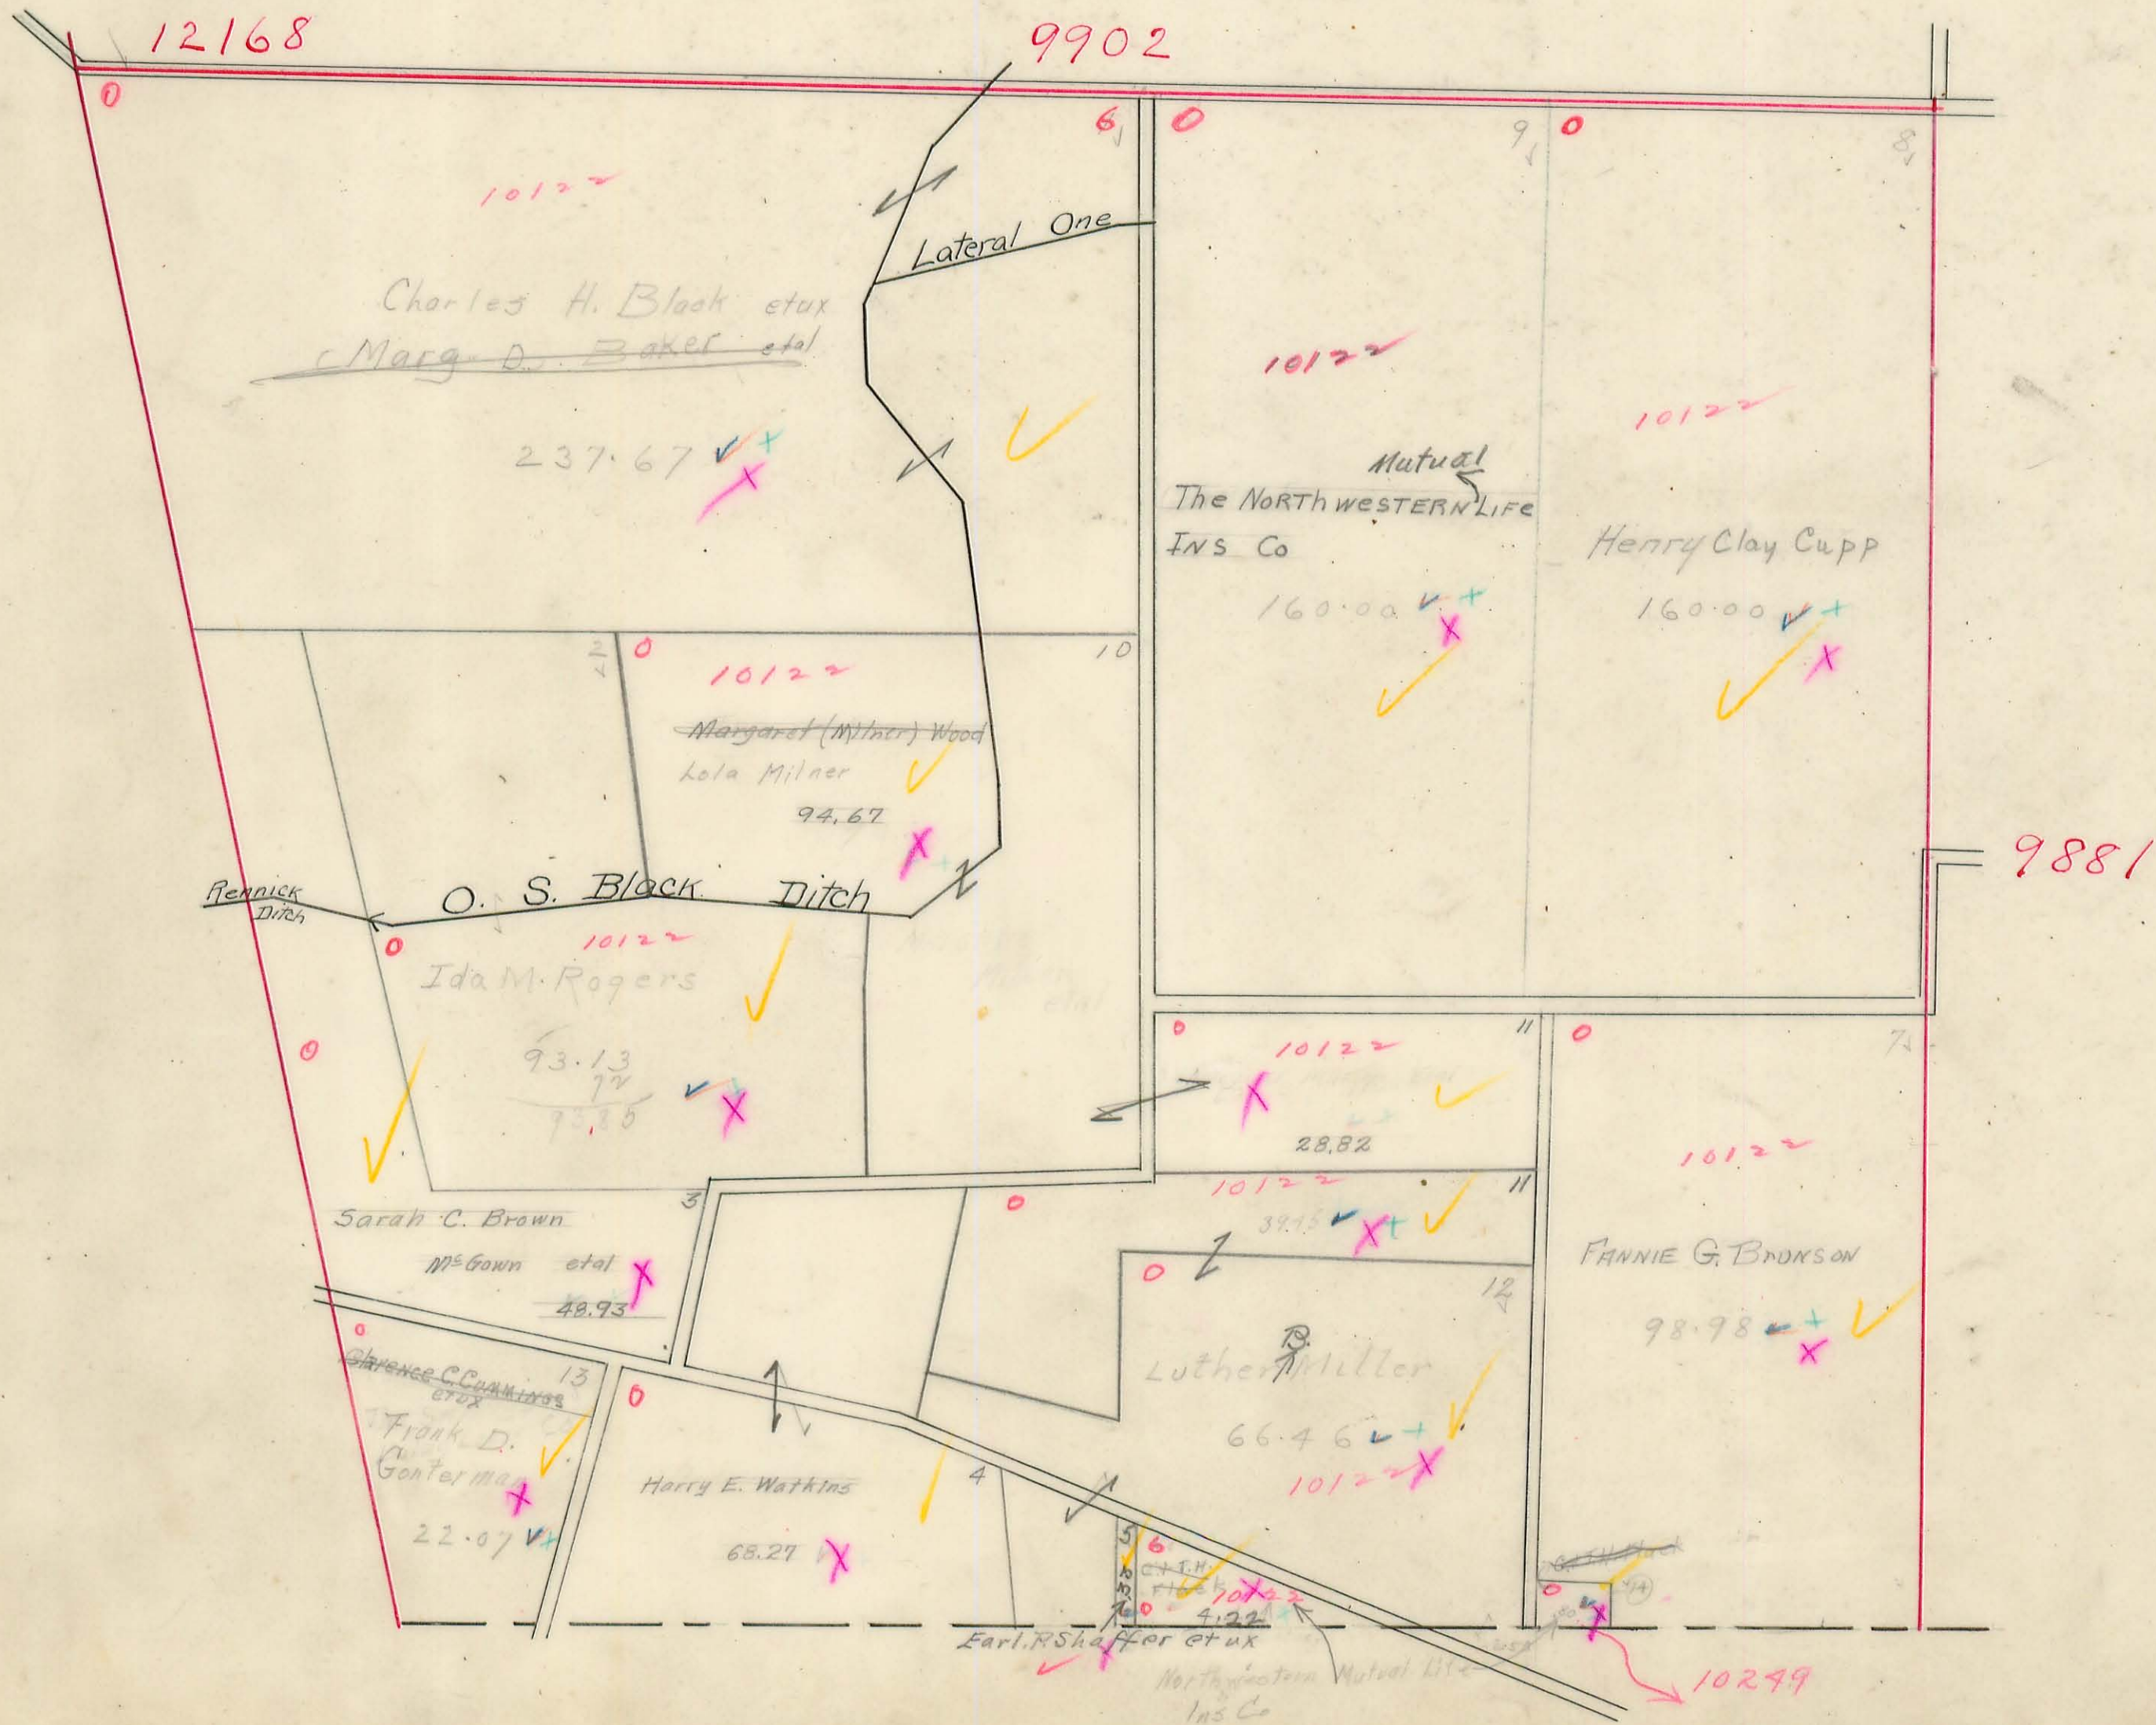

McARTHUR TOWNSHIP.

Plat of Virginia Military Survey No. 9881

Scale: 1 inch = 10 chains.

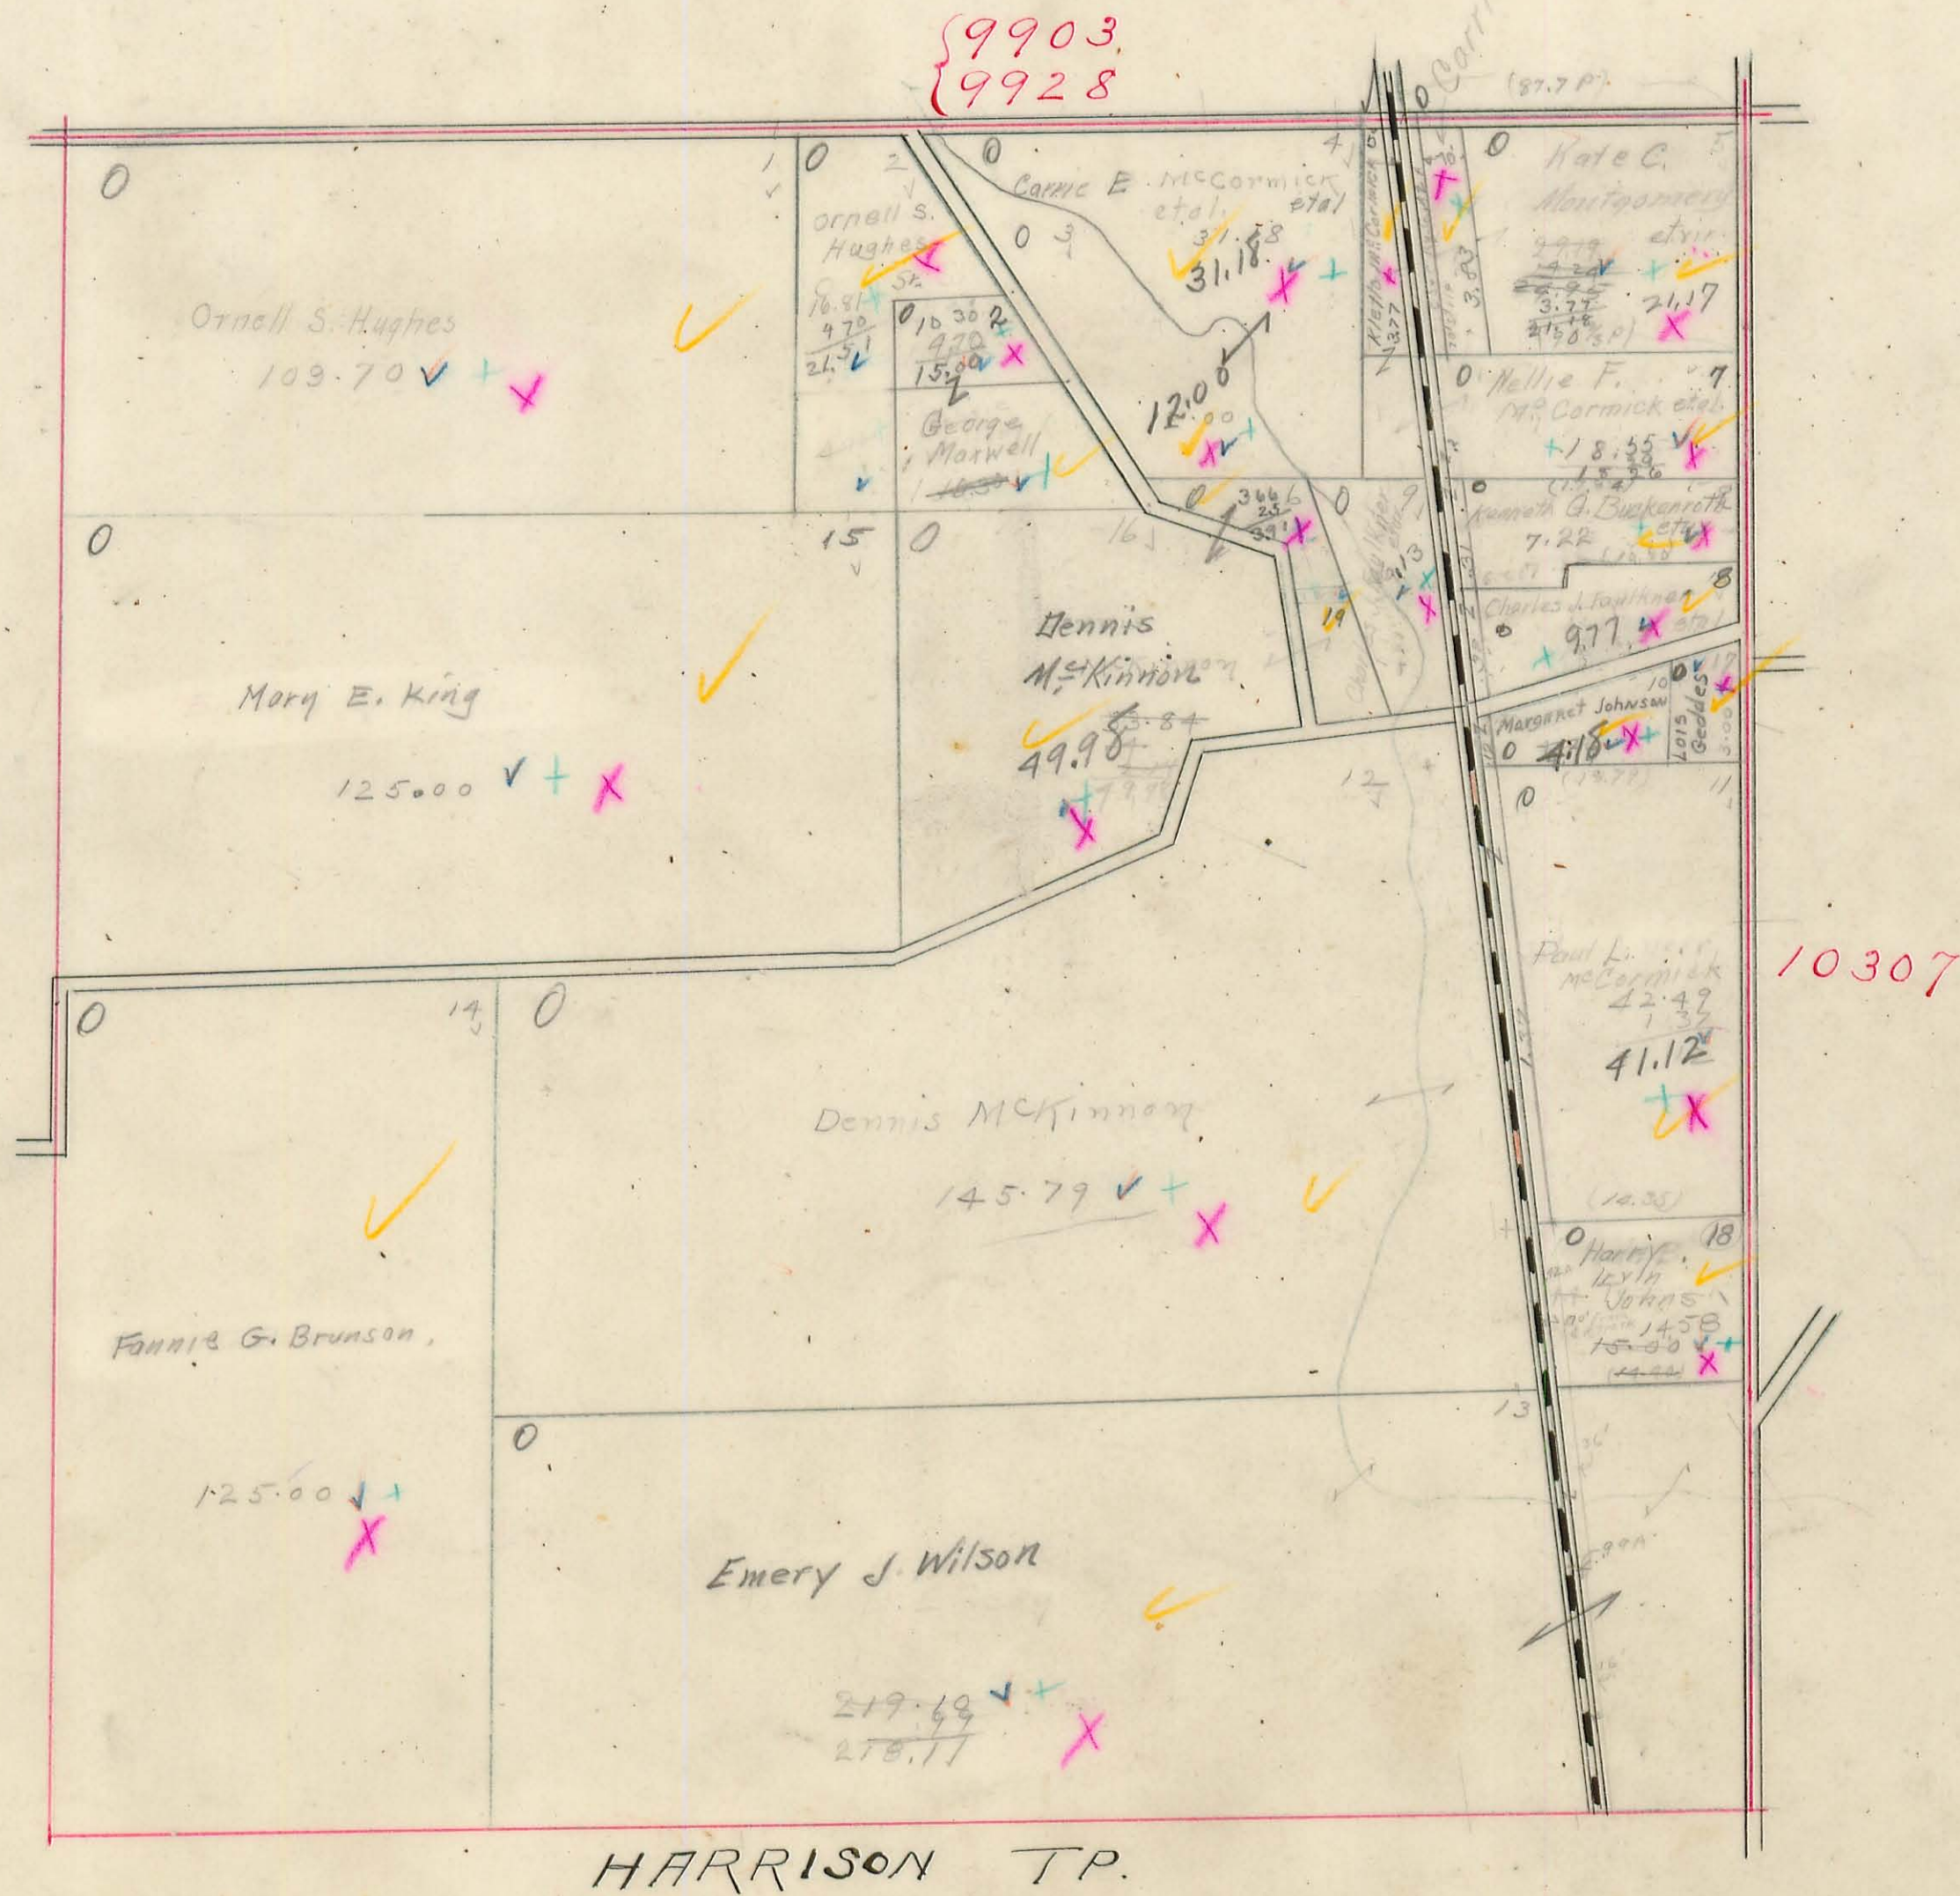


HARRISON TP.

McARTHUR TOWNSHIP.

Plat of Virginia Military Survey No. 10307
10306

Scale: 1 inch = 10 chains.

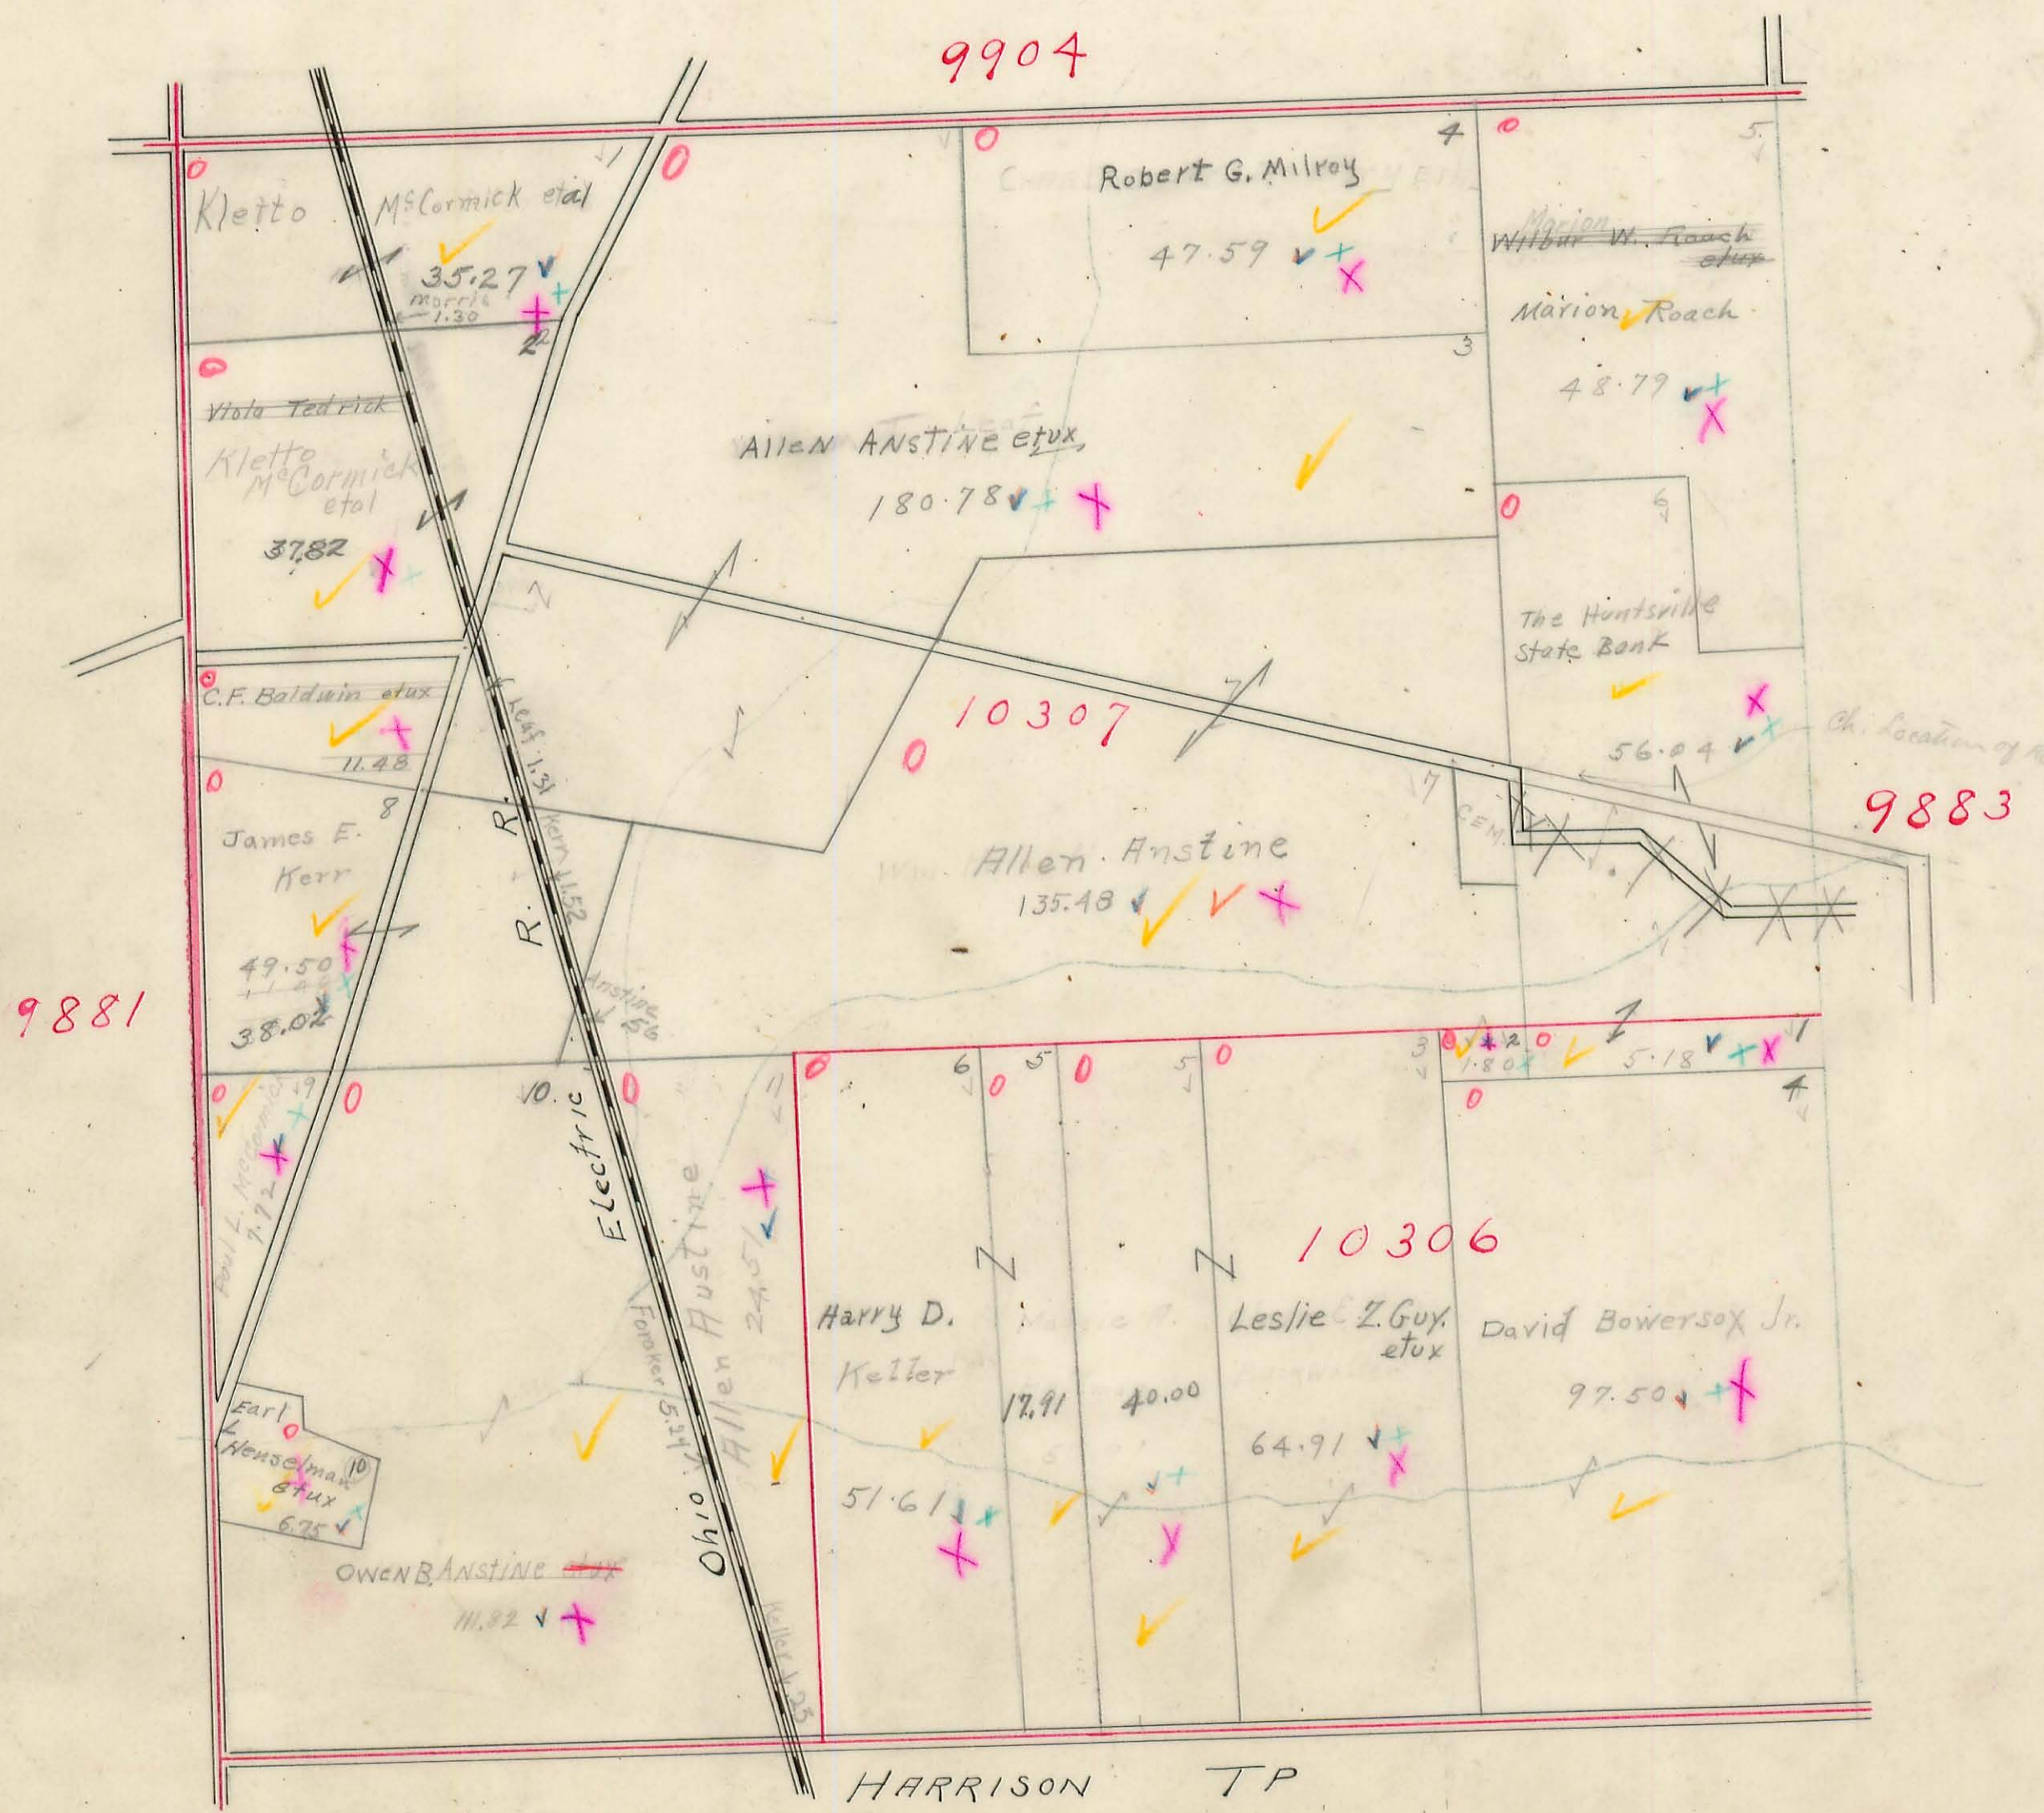

3157.91
193

204
2901
2697

McARTHUR TOWNSHIP.

Plat of Virginia Military Survey No. 9883


Scale: 1 inch = 10 chains.

9905

10307

10306

9884

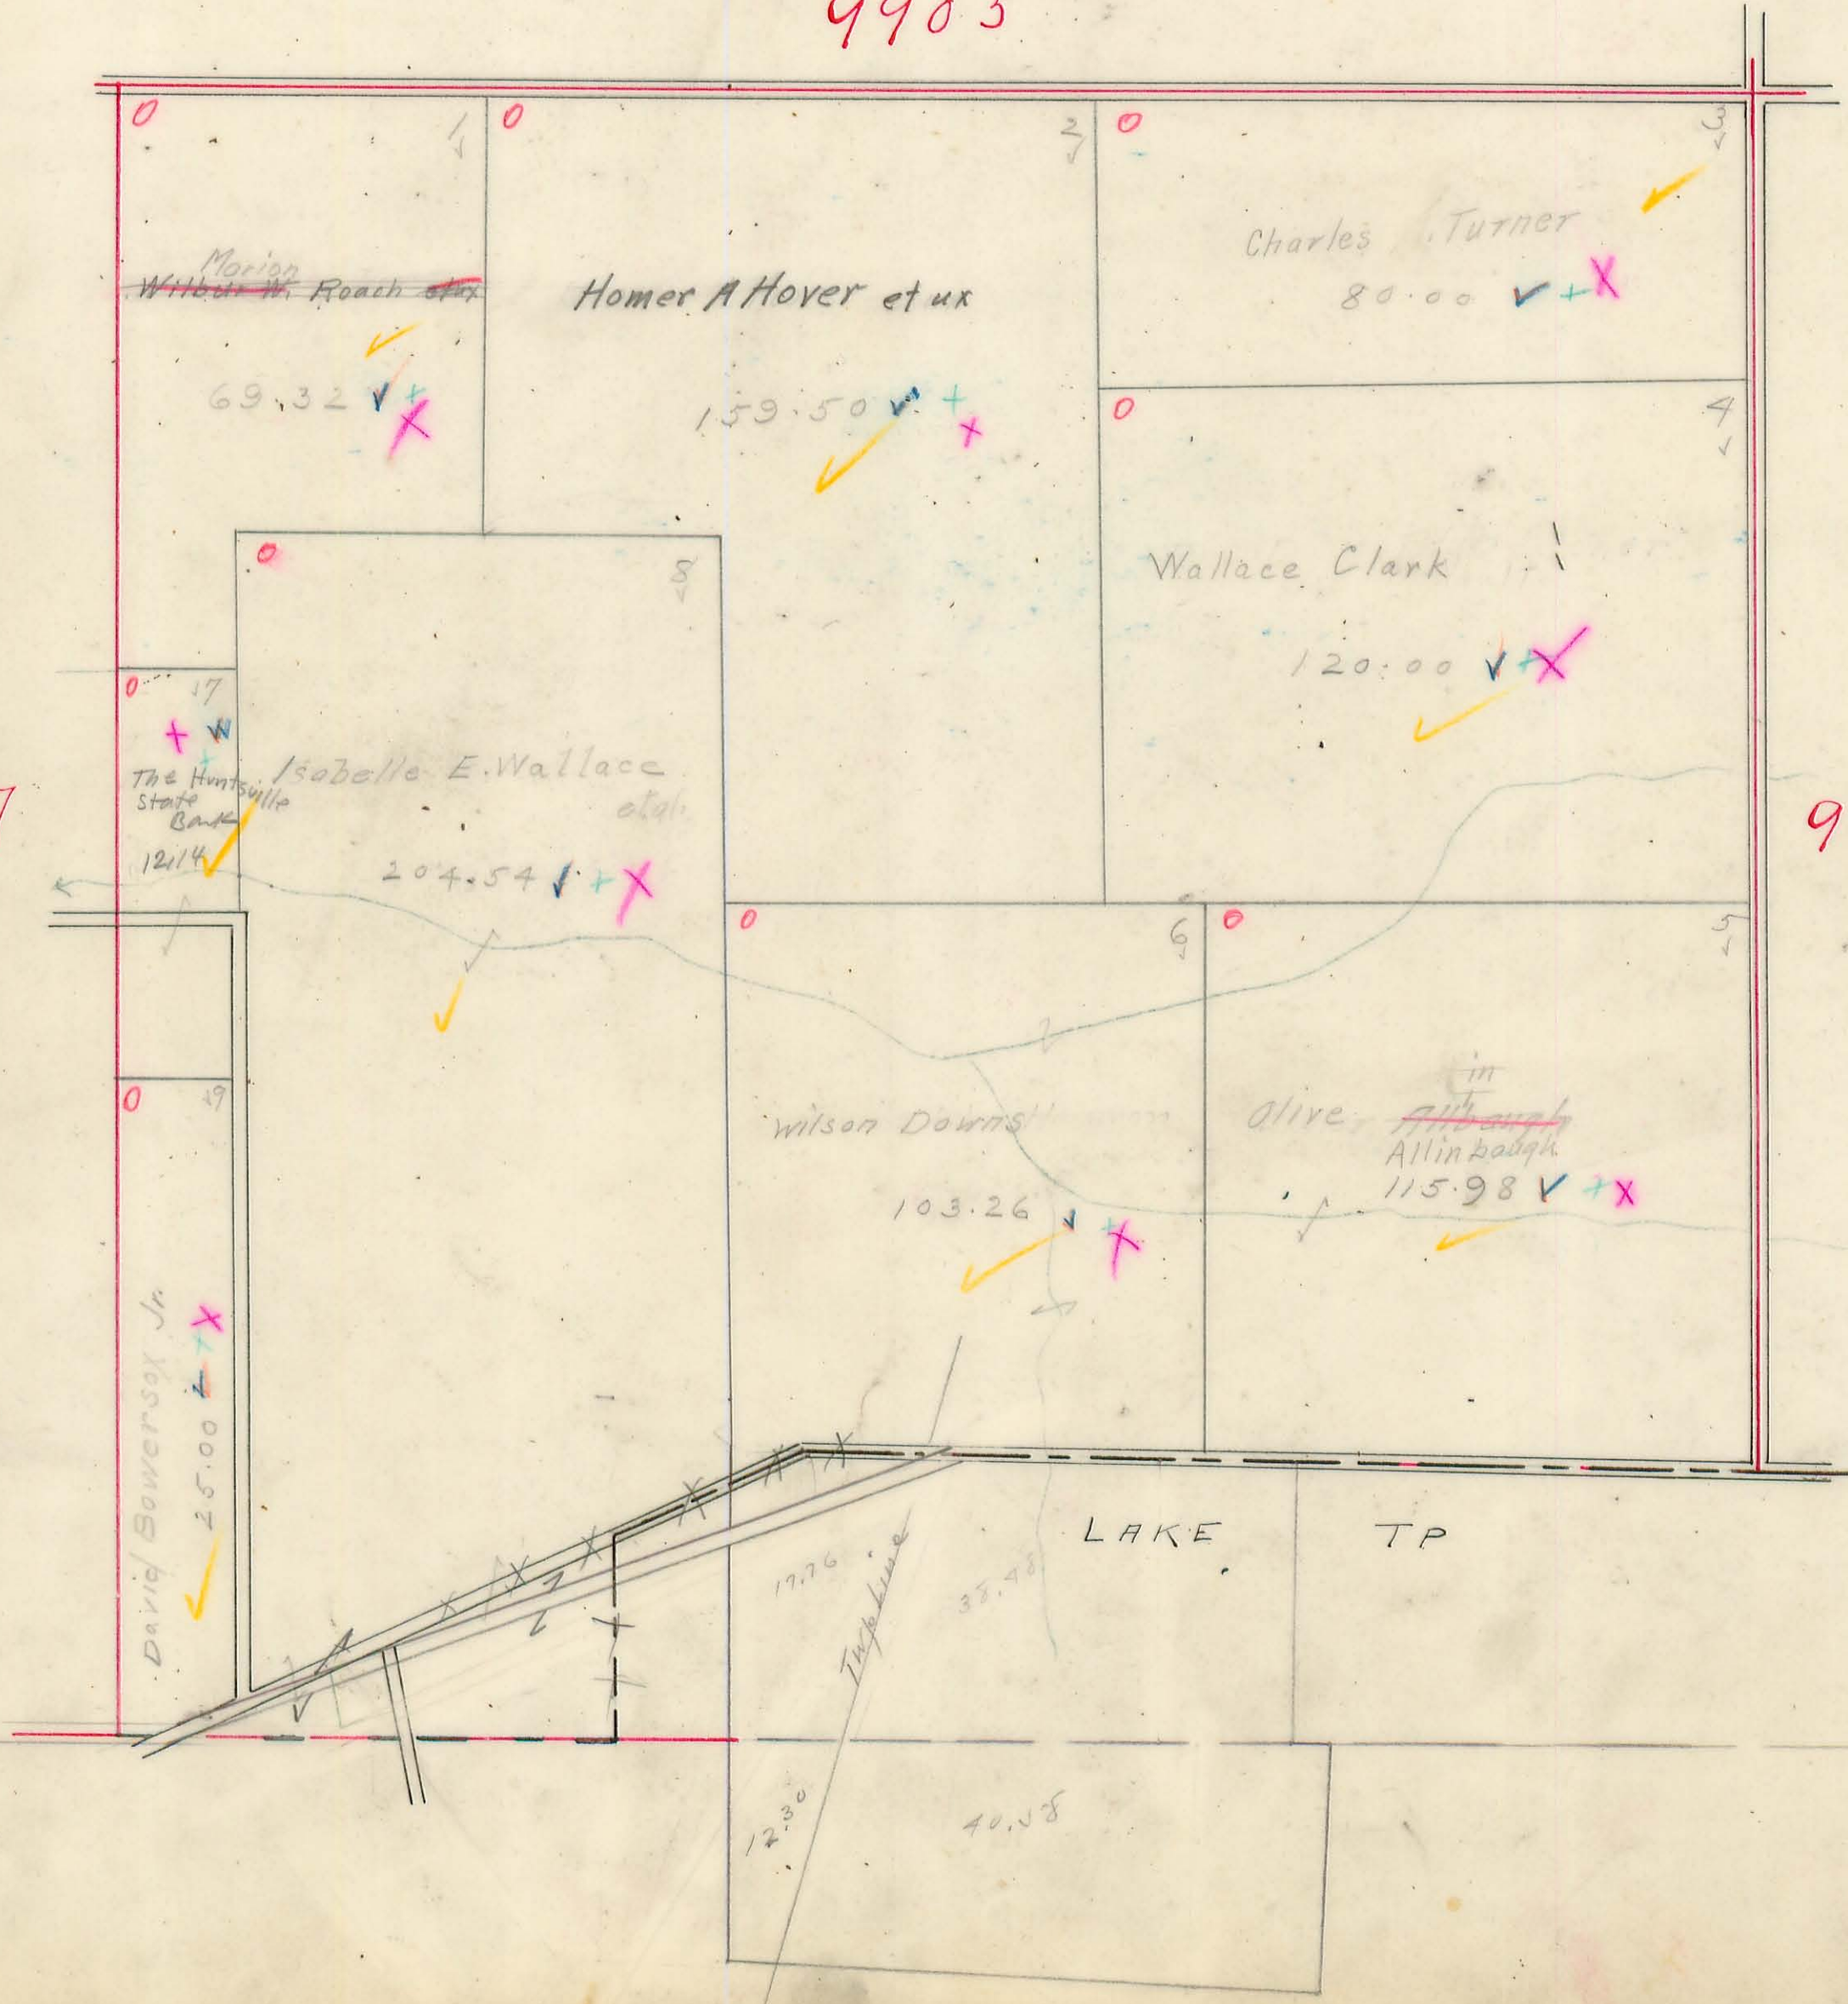


Show Oscar W. Kempfer
Aug. 1 - 17.76 A.

X

McARTHUR TOWNSHIP.

Plat of Virginia Military Survey No. 9884
9885

Scale: 1 inch = 10 chains.

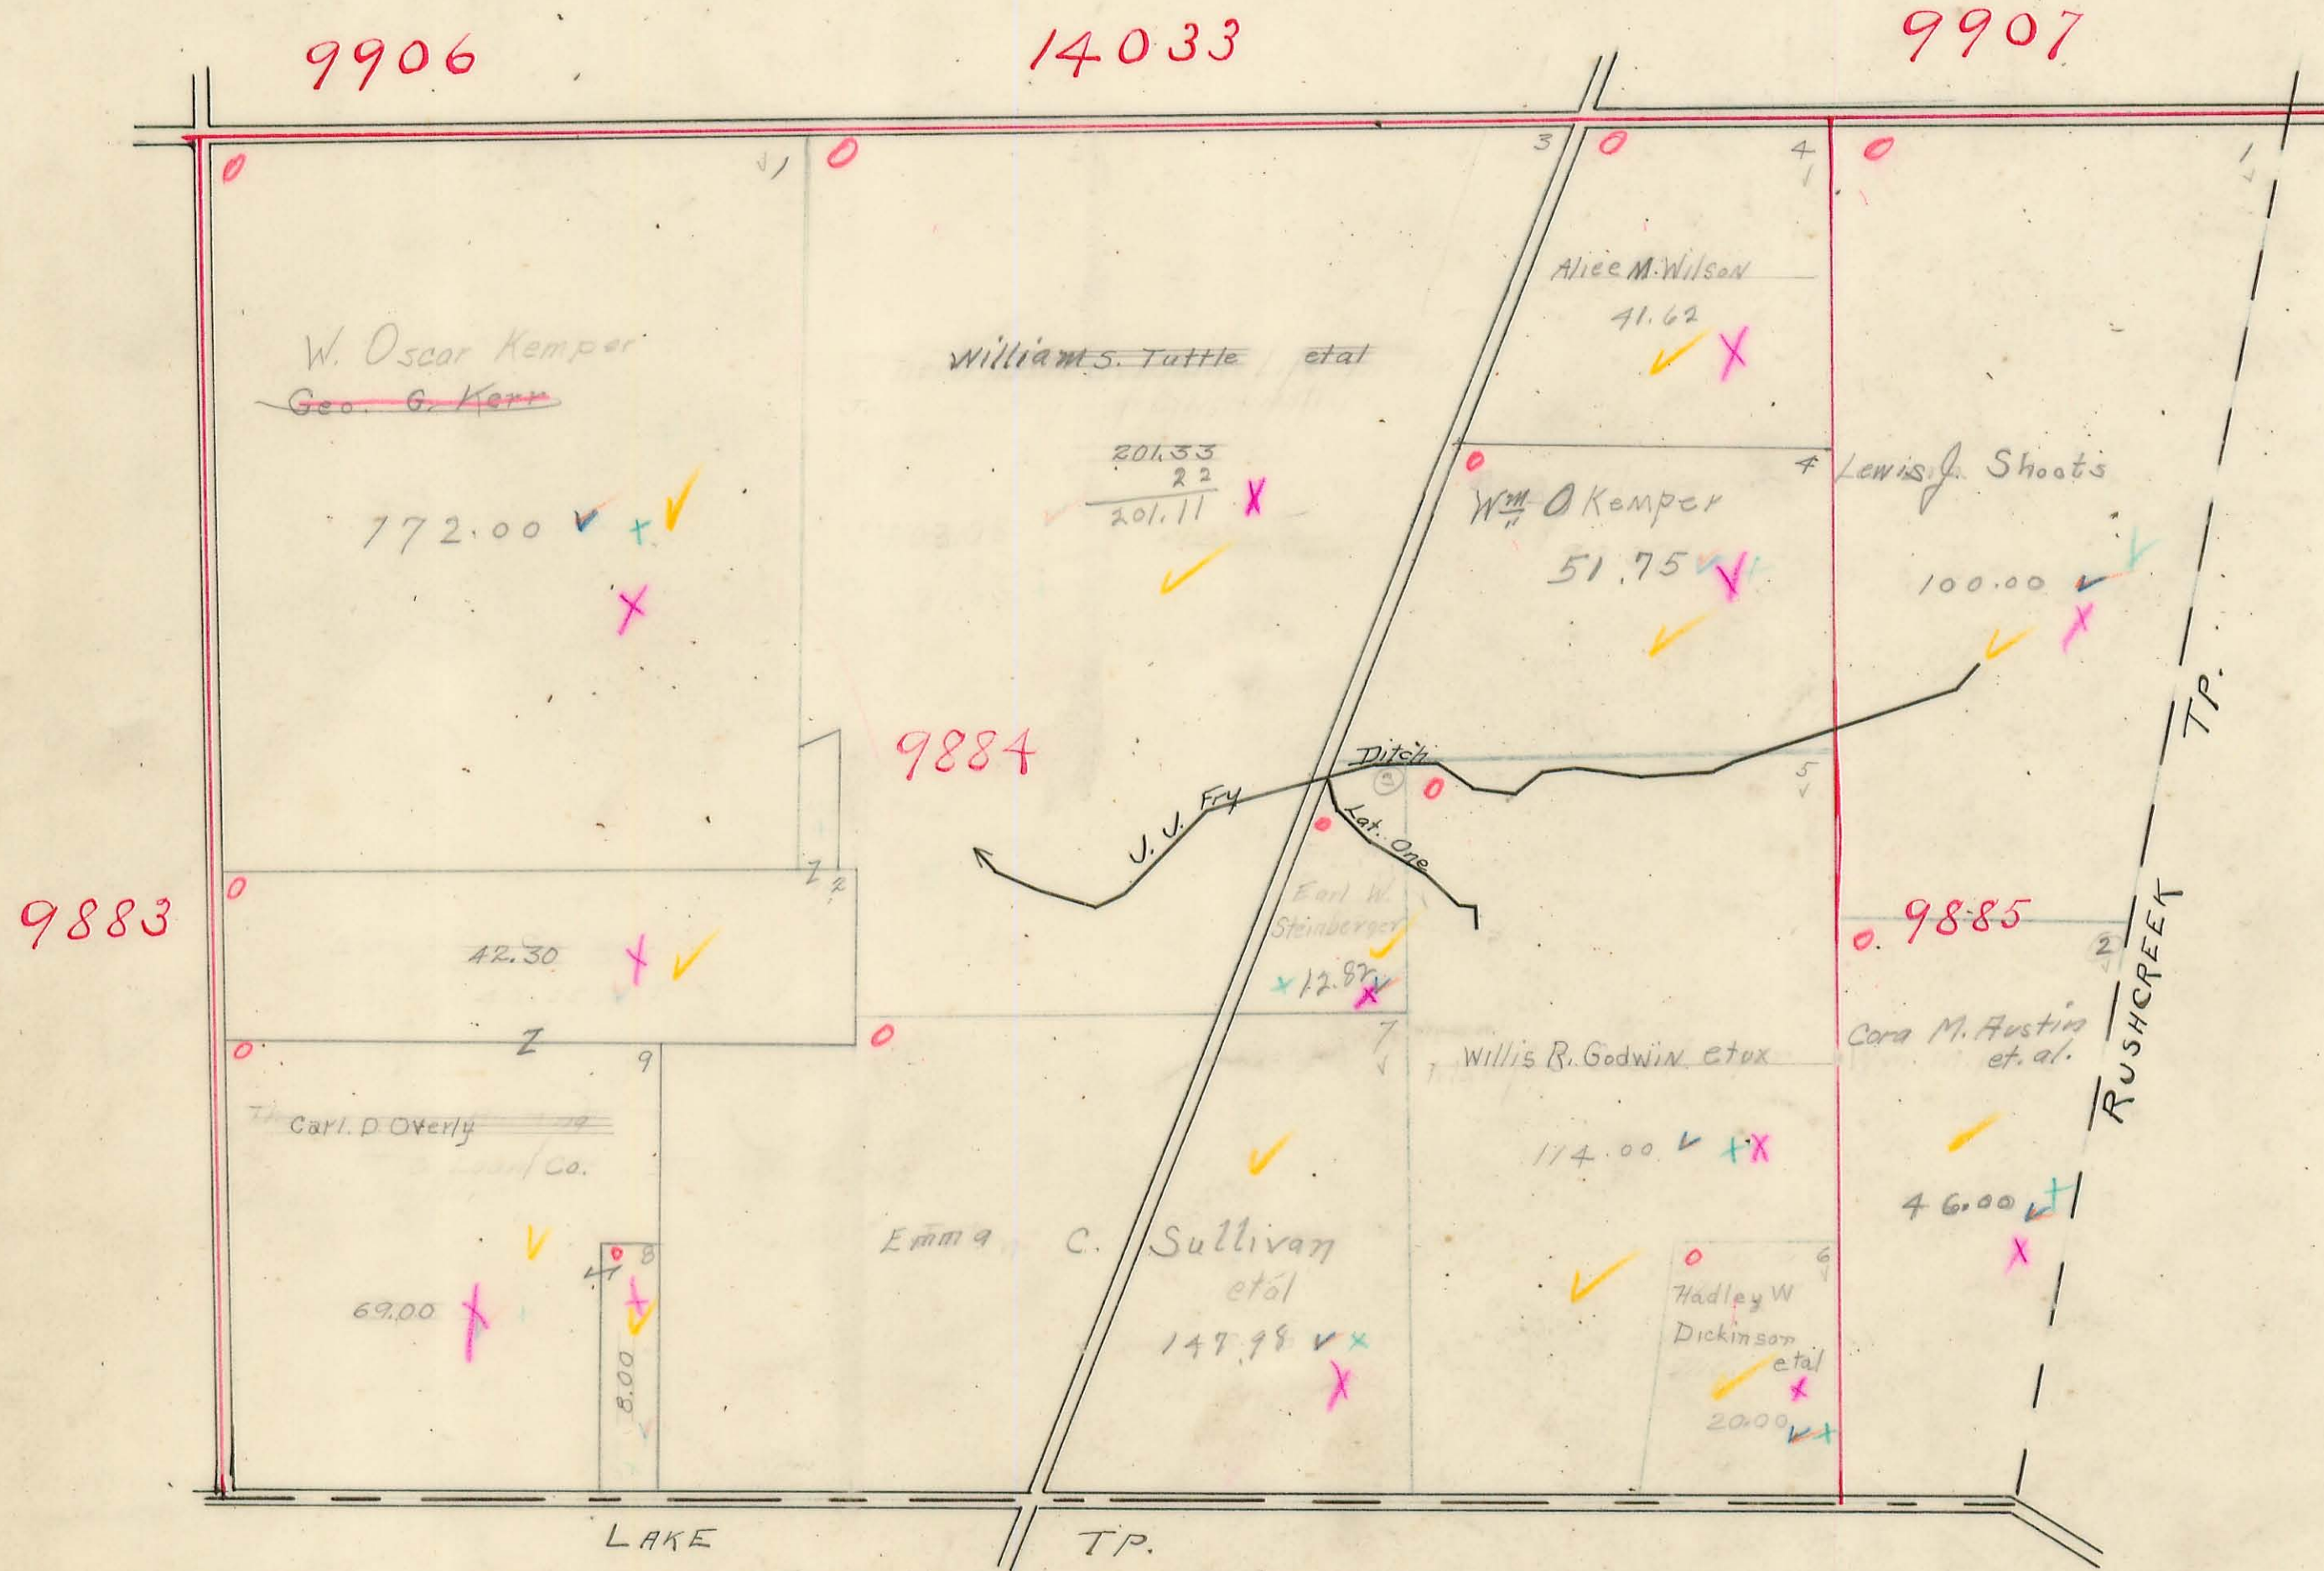


69.00
40.33
109.33
117.55
17.55
119.00

OK

70/50


McARTHUR TOWNSHIP.


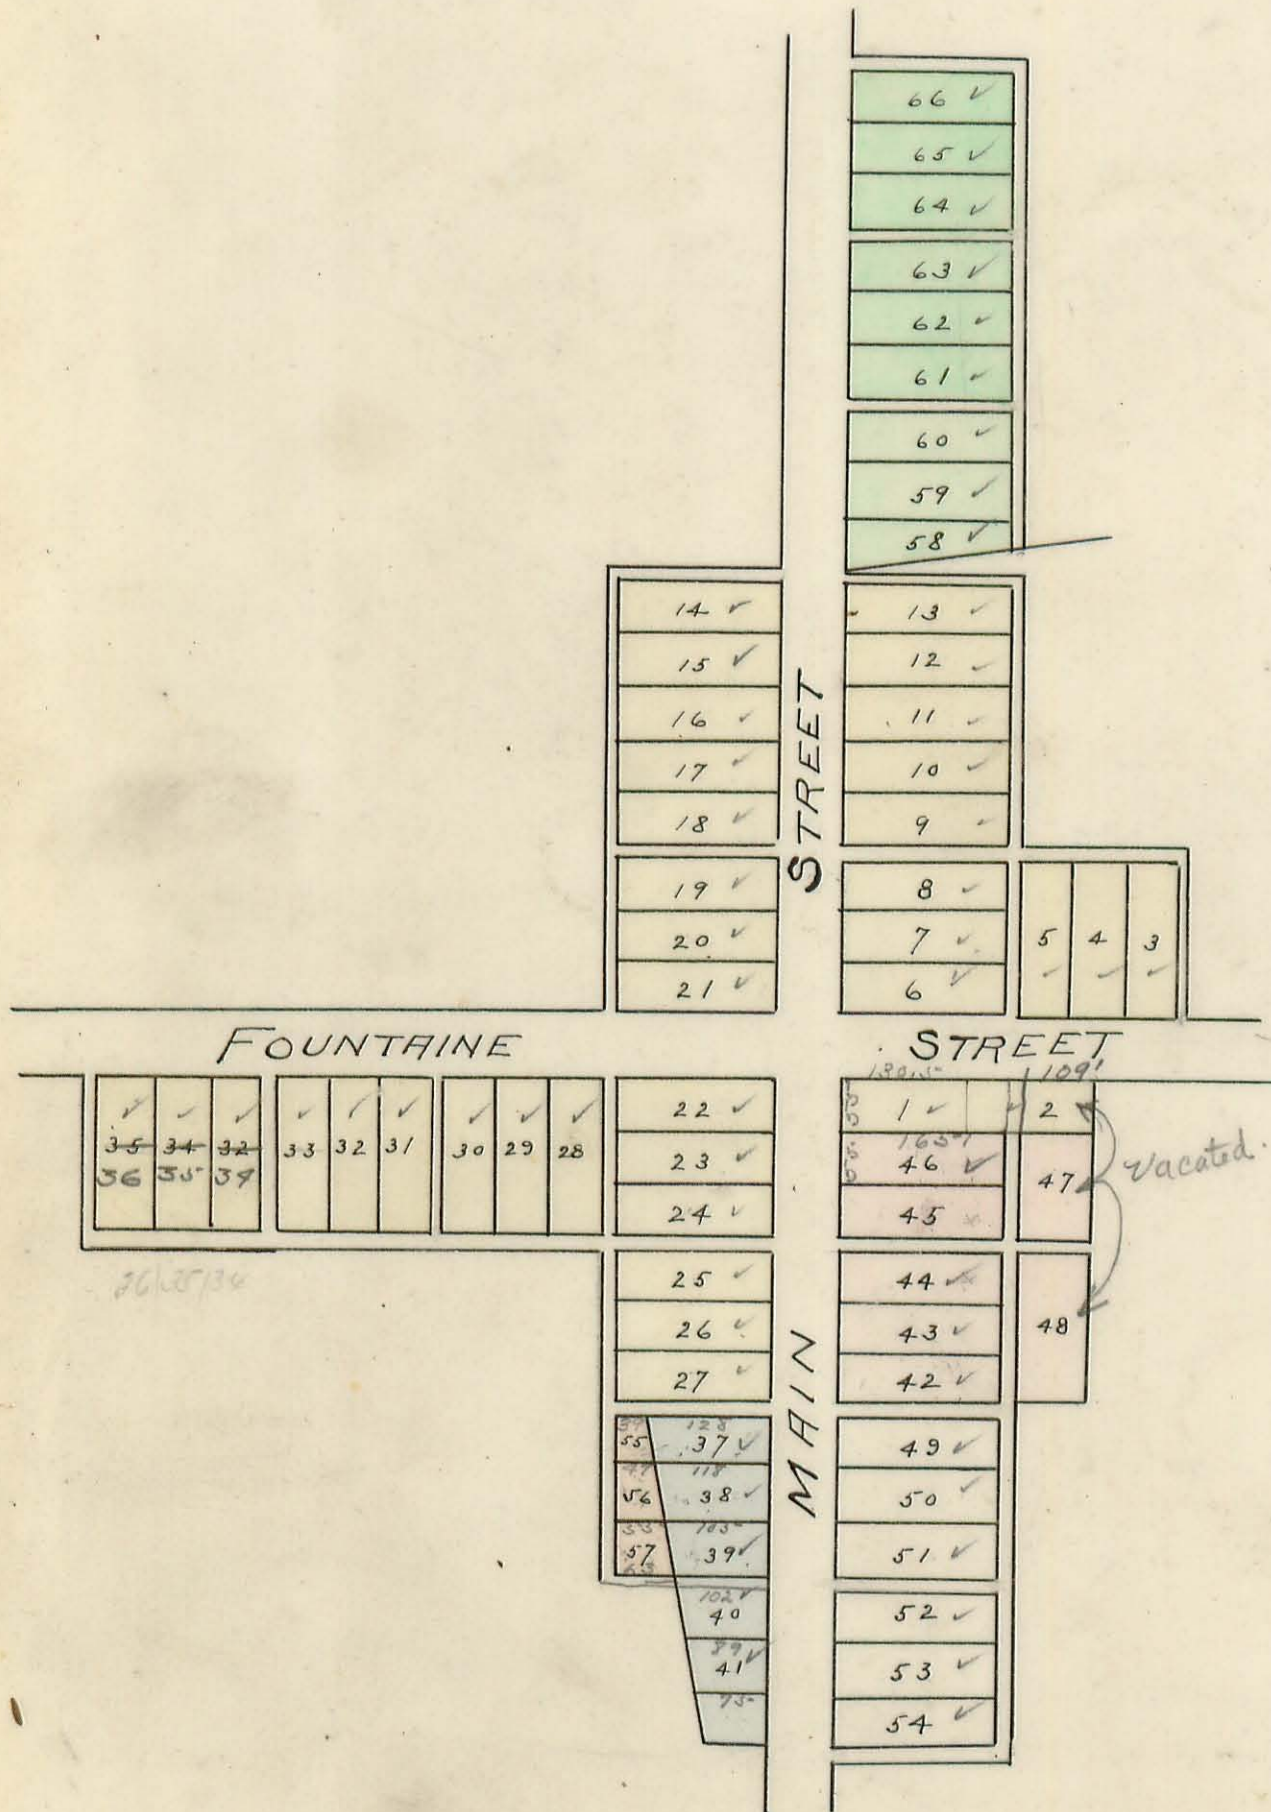

- Old Town
- Hamiltons Add.
- Edminsons Add.
- 1st South Add.
- 2nd South Add.
- Havens Add.

Northwood
Scale: 1-in. = 100ft.

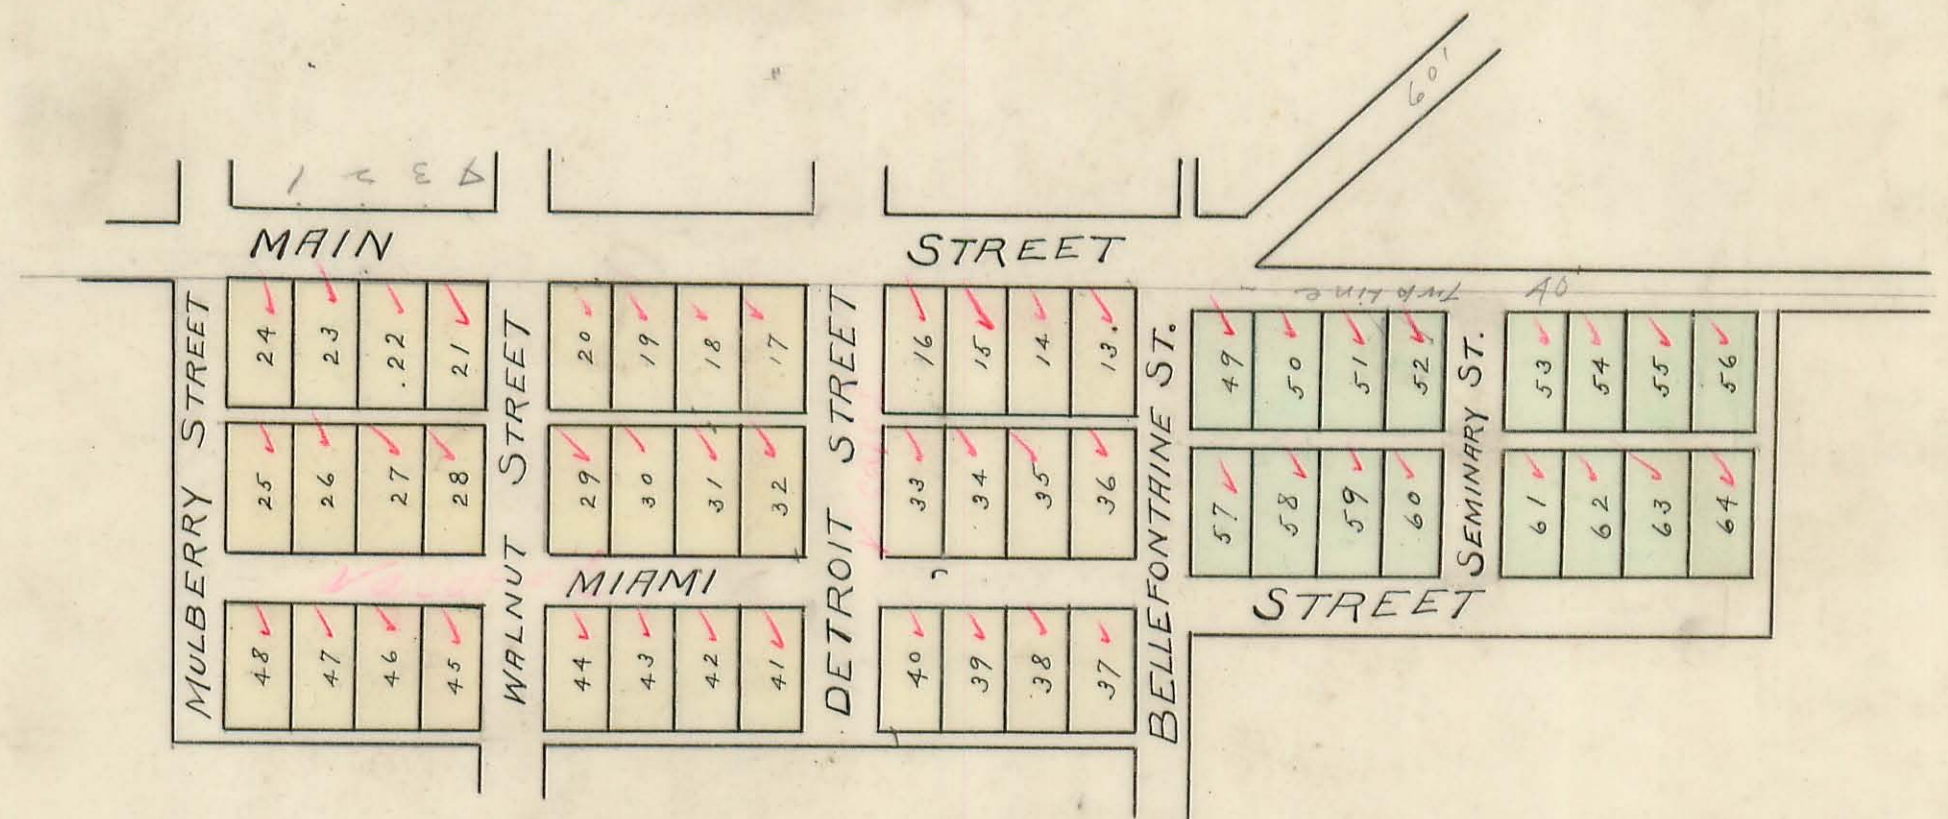


- Original Town
- Smiths Add.

X
X

McARTHUR TOWNSHIP.

Huntsville

Scale: 1 in. = 200 feet

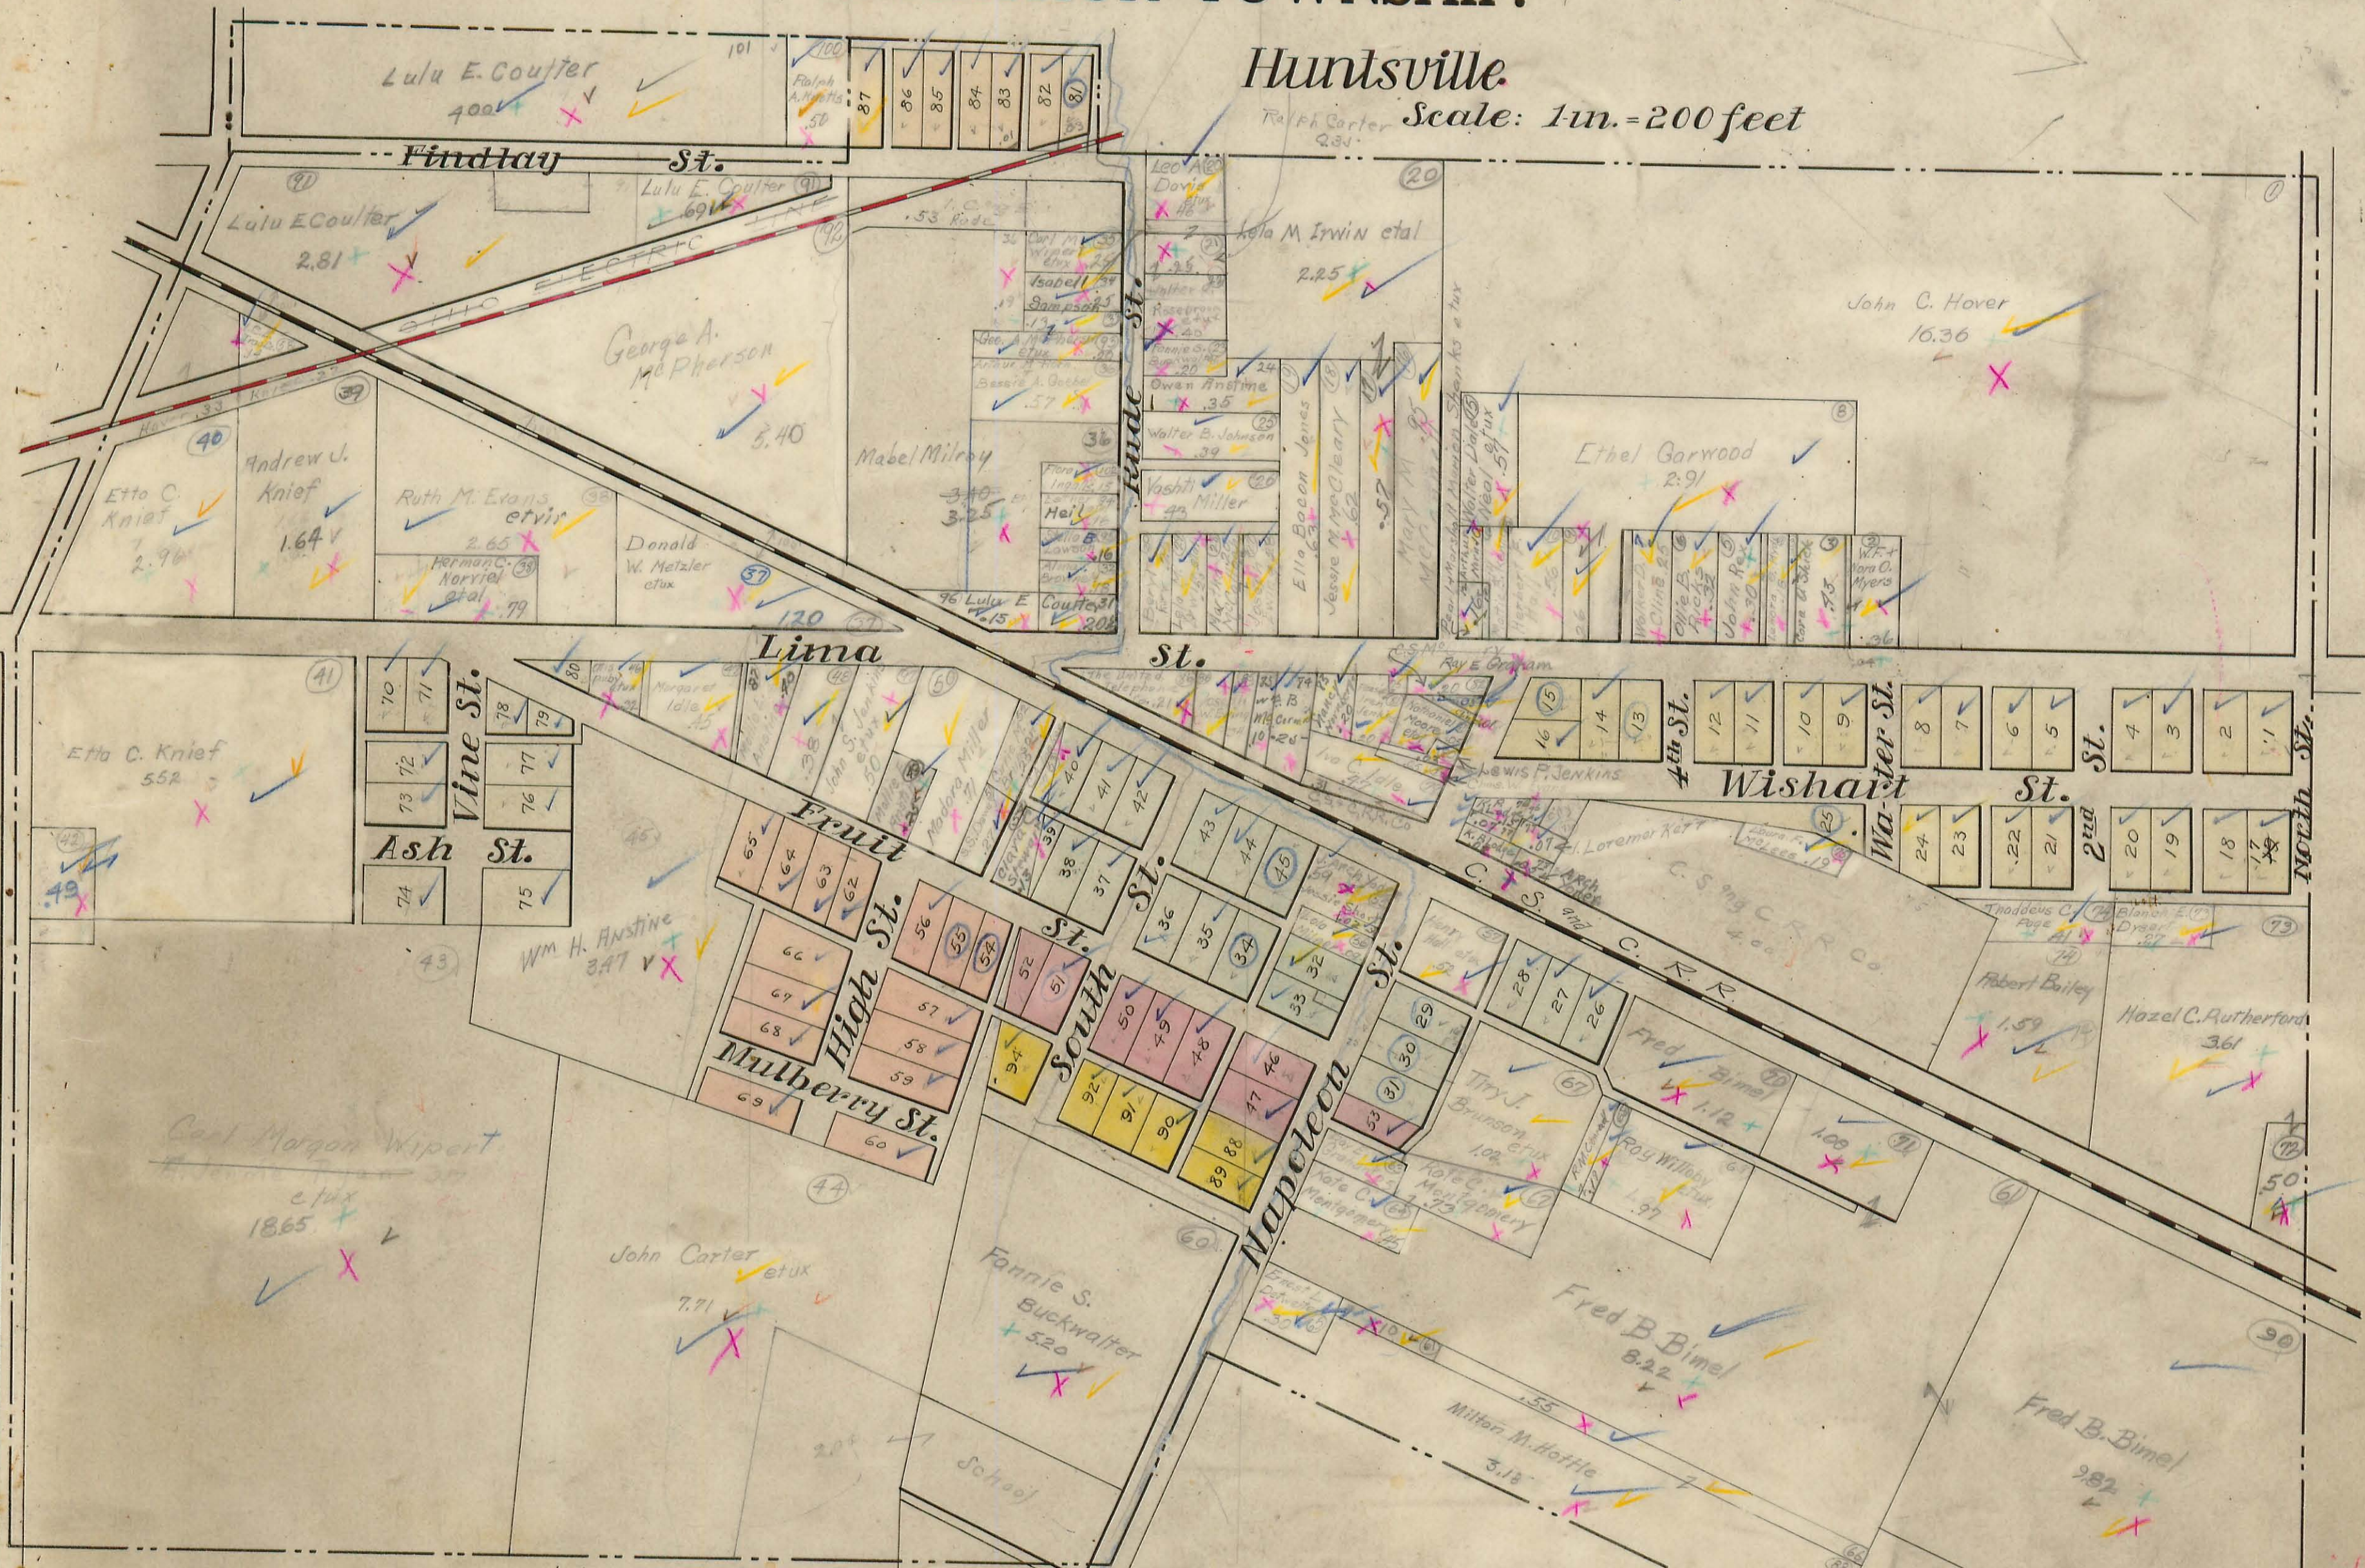

- Wishart's Add.
- Hoover's 1st Add.
- Bickham's Add.
- Hoover's 2nd Add.
- Original Town
- Rude's Add.
- Welsh & Shaffers Add.

