

C H A M P

600  
100



# MIAMI TOWNSHIP.

## INDEX MAP

RED FIGURES REFER TO PAGES


Replaced By New Set Jan-1933

*Corrected to and Including*

11-22-32

Degraff Corporation  
checked 7/21/32

Quincy Corporation  
checked 7/21/32

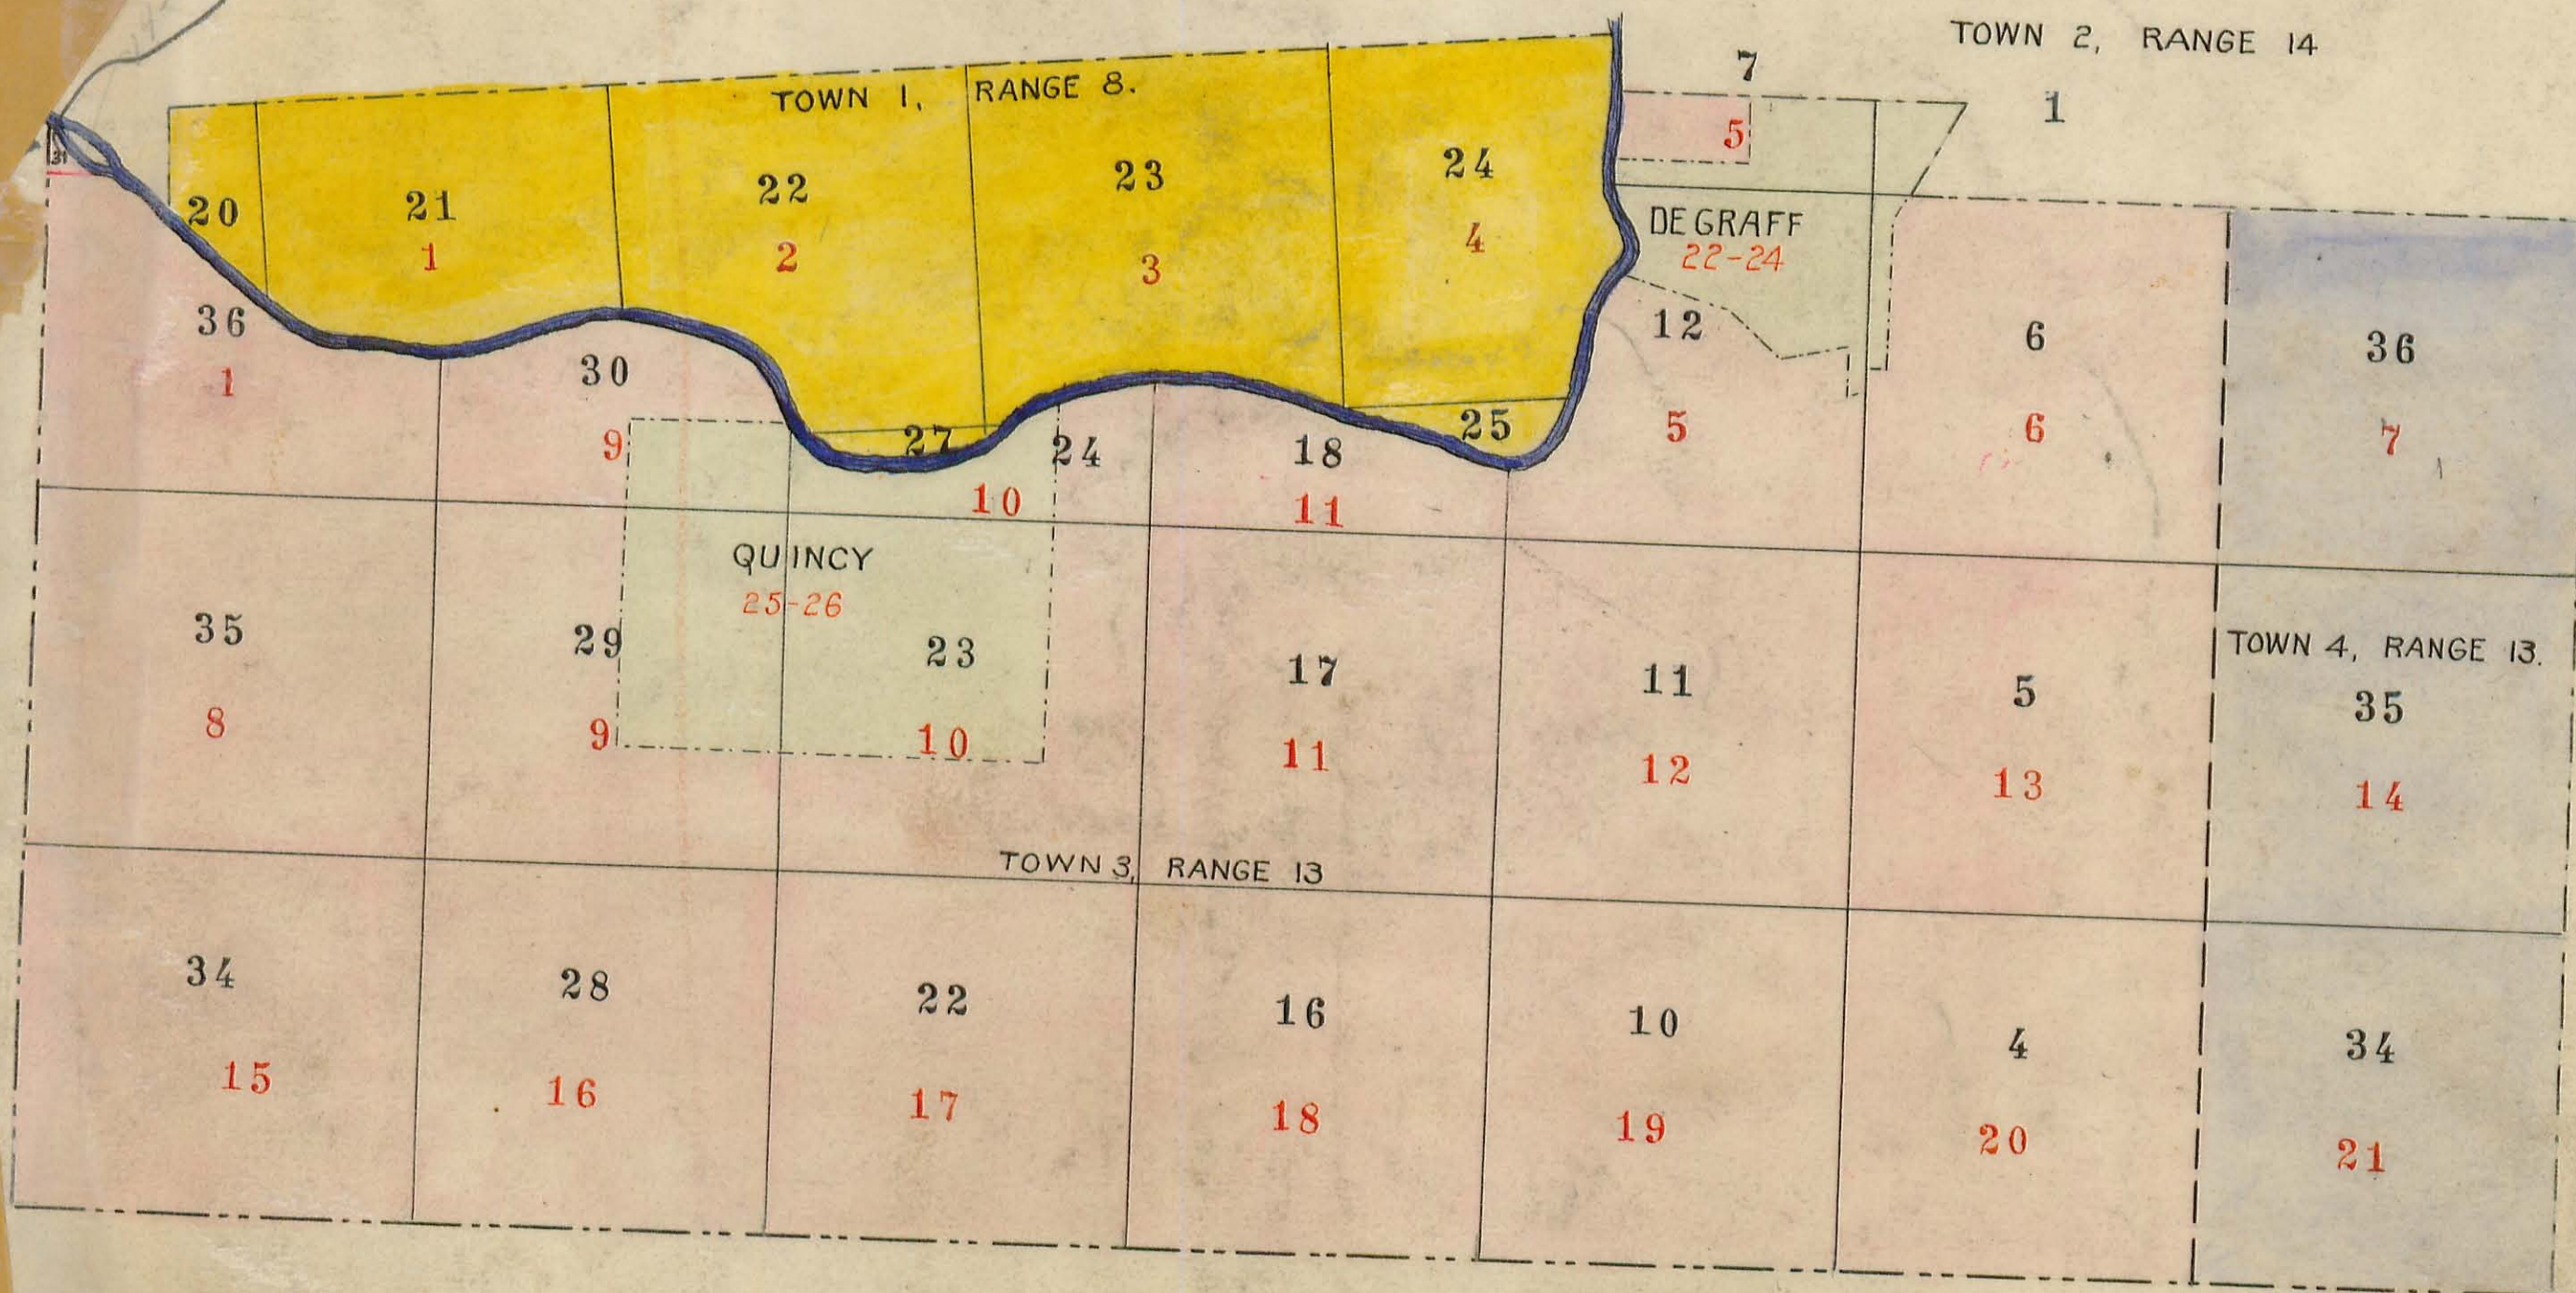



# MIAMI TOWNSHIP.

Plat of Section No. <sup>36</sup><sub>20</sub><sup>21</sup> Range No. <sup>13</sup><sub>8</sub><sup>8</sup> Town No. <sup>7</sup><sub>1</sub><sup>1</sup>

Scale 10 Chains Per Inch.

SHELBY COUNTY.






# MIAMI TOWNSHIP.

Plat of Section No. <sup>22</sup>/<sub>27</sub> Range No. 8 Town No. 1.

Scale 10 Chains Per Inch.

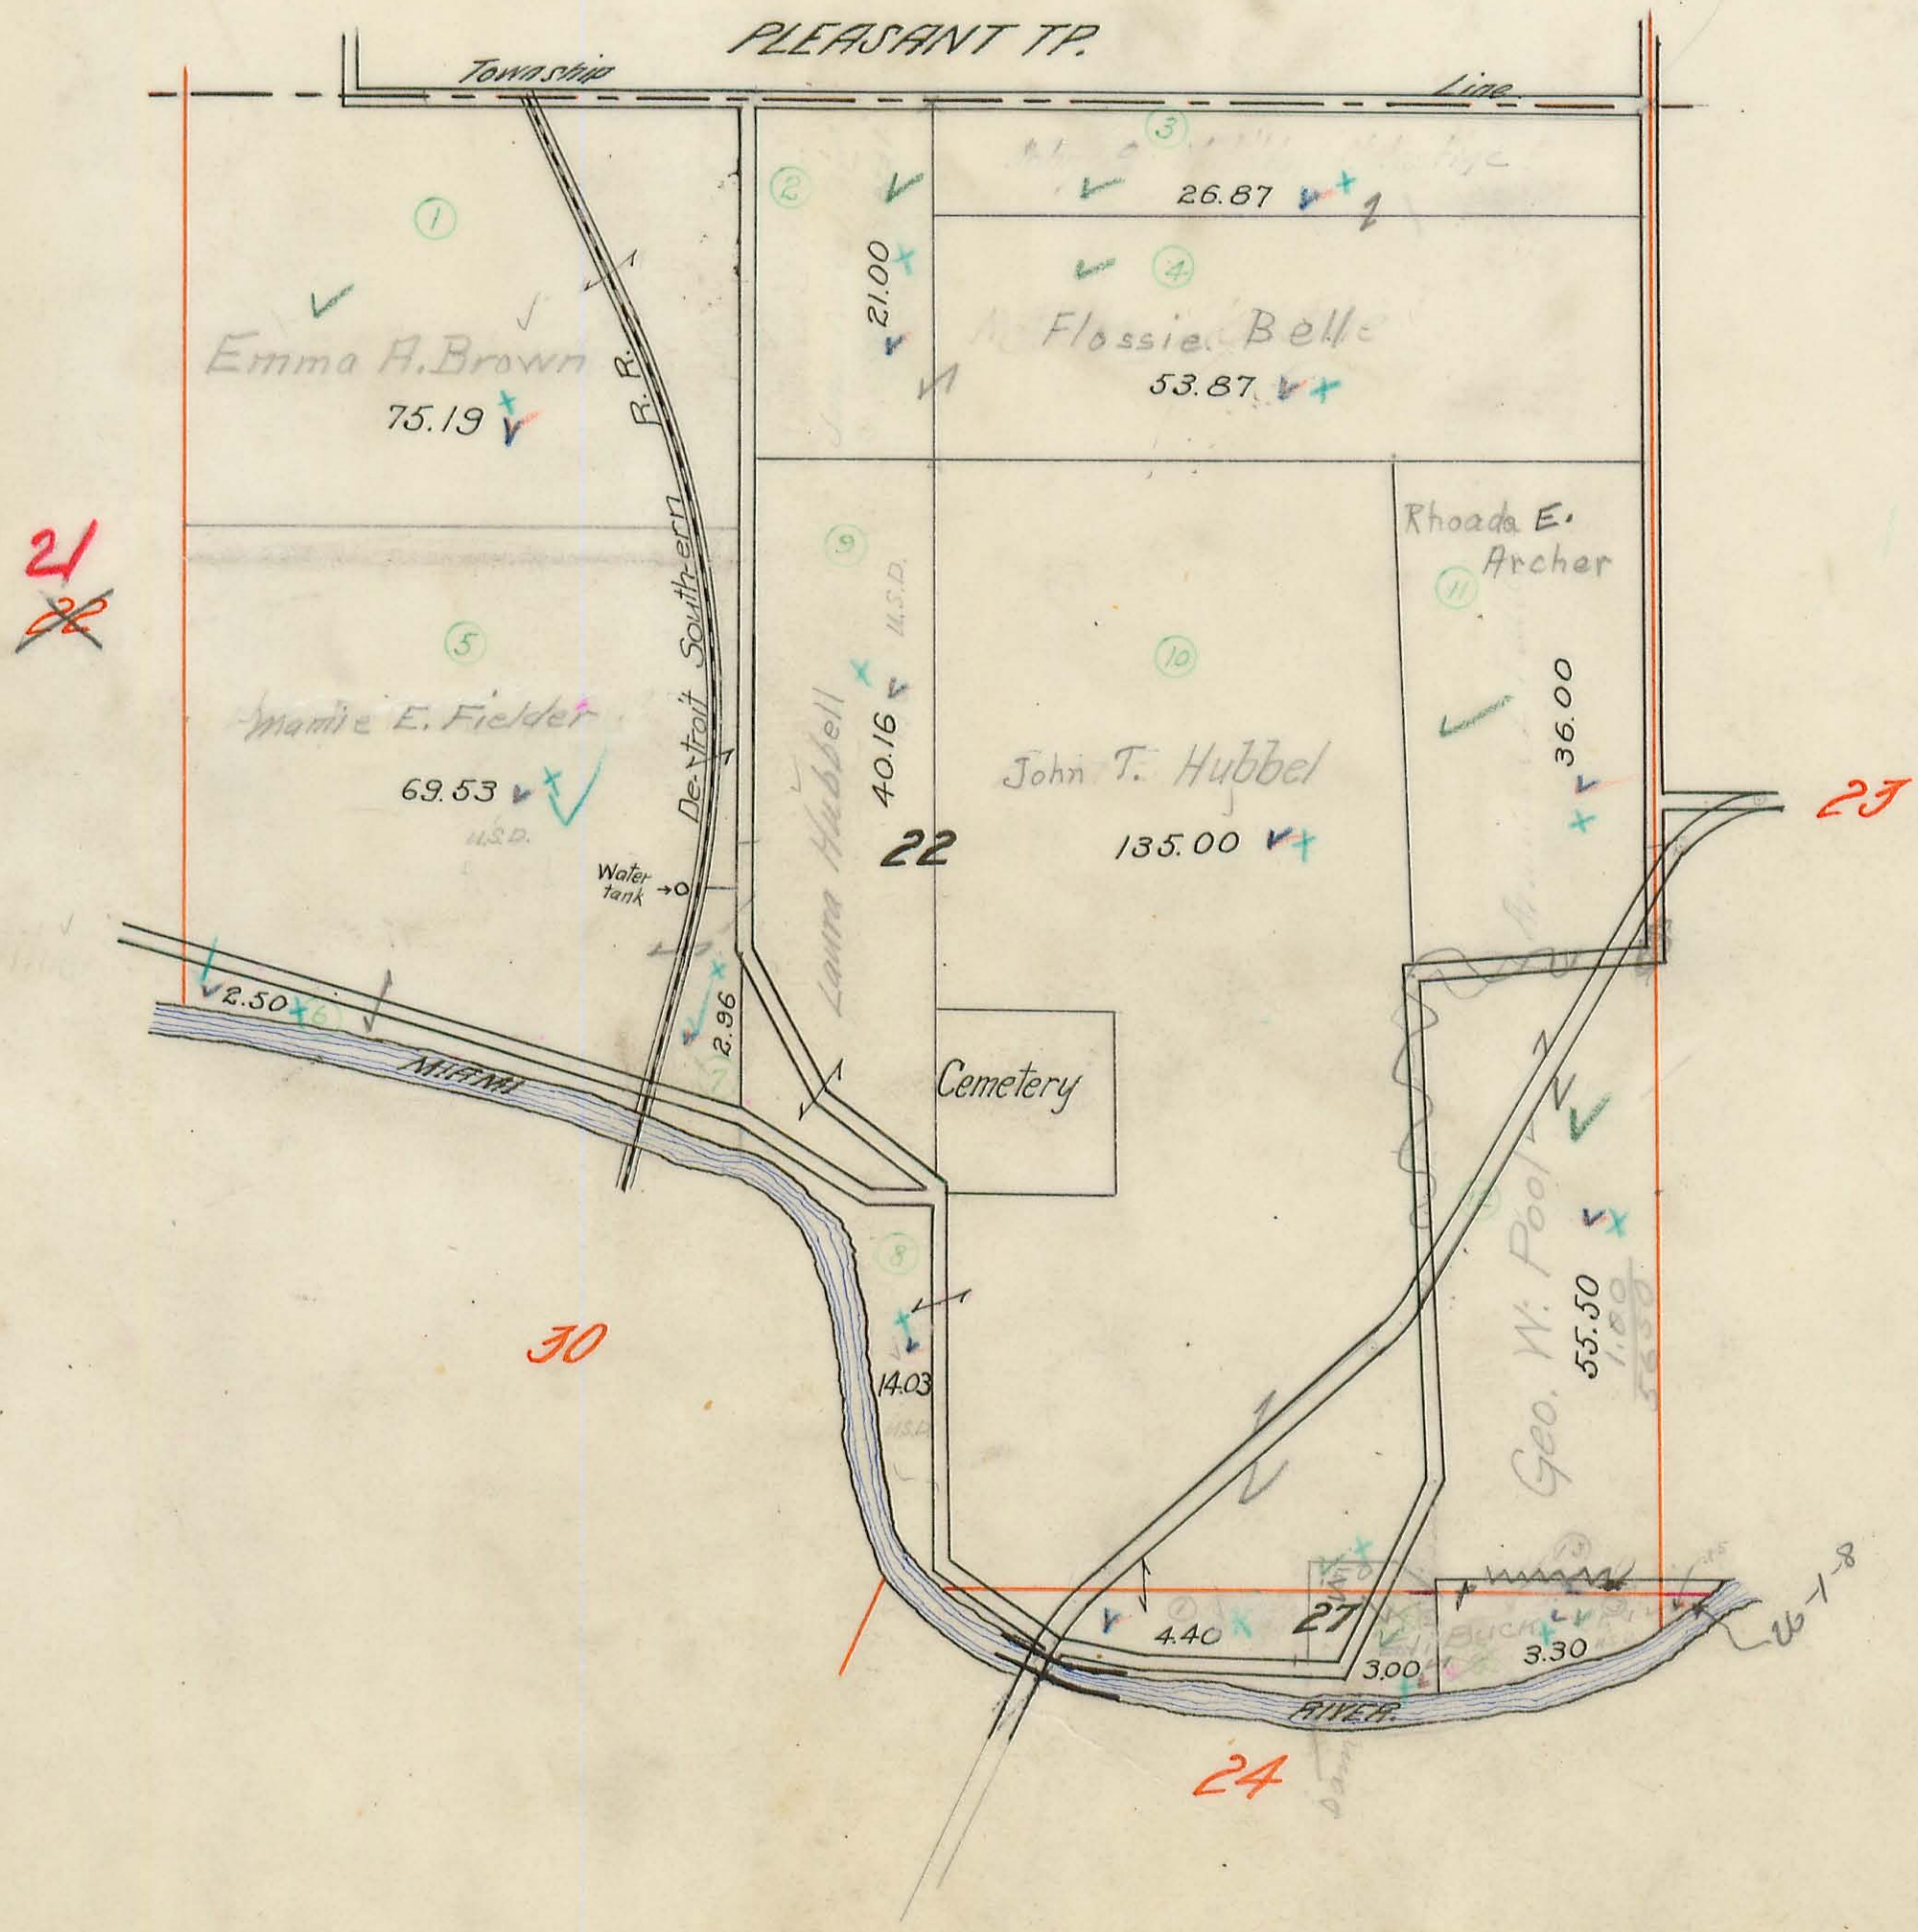




# MIAMI TOWNSHIP.

## Plat of Section No. 23 Range No. 8 Town No. 1

Scale 10 Chains Per Inch.

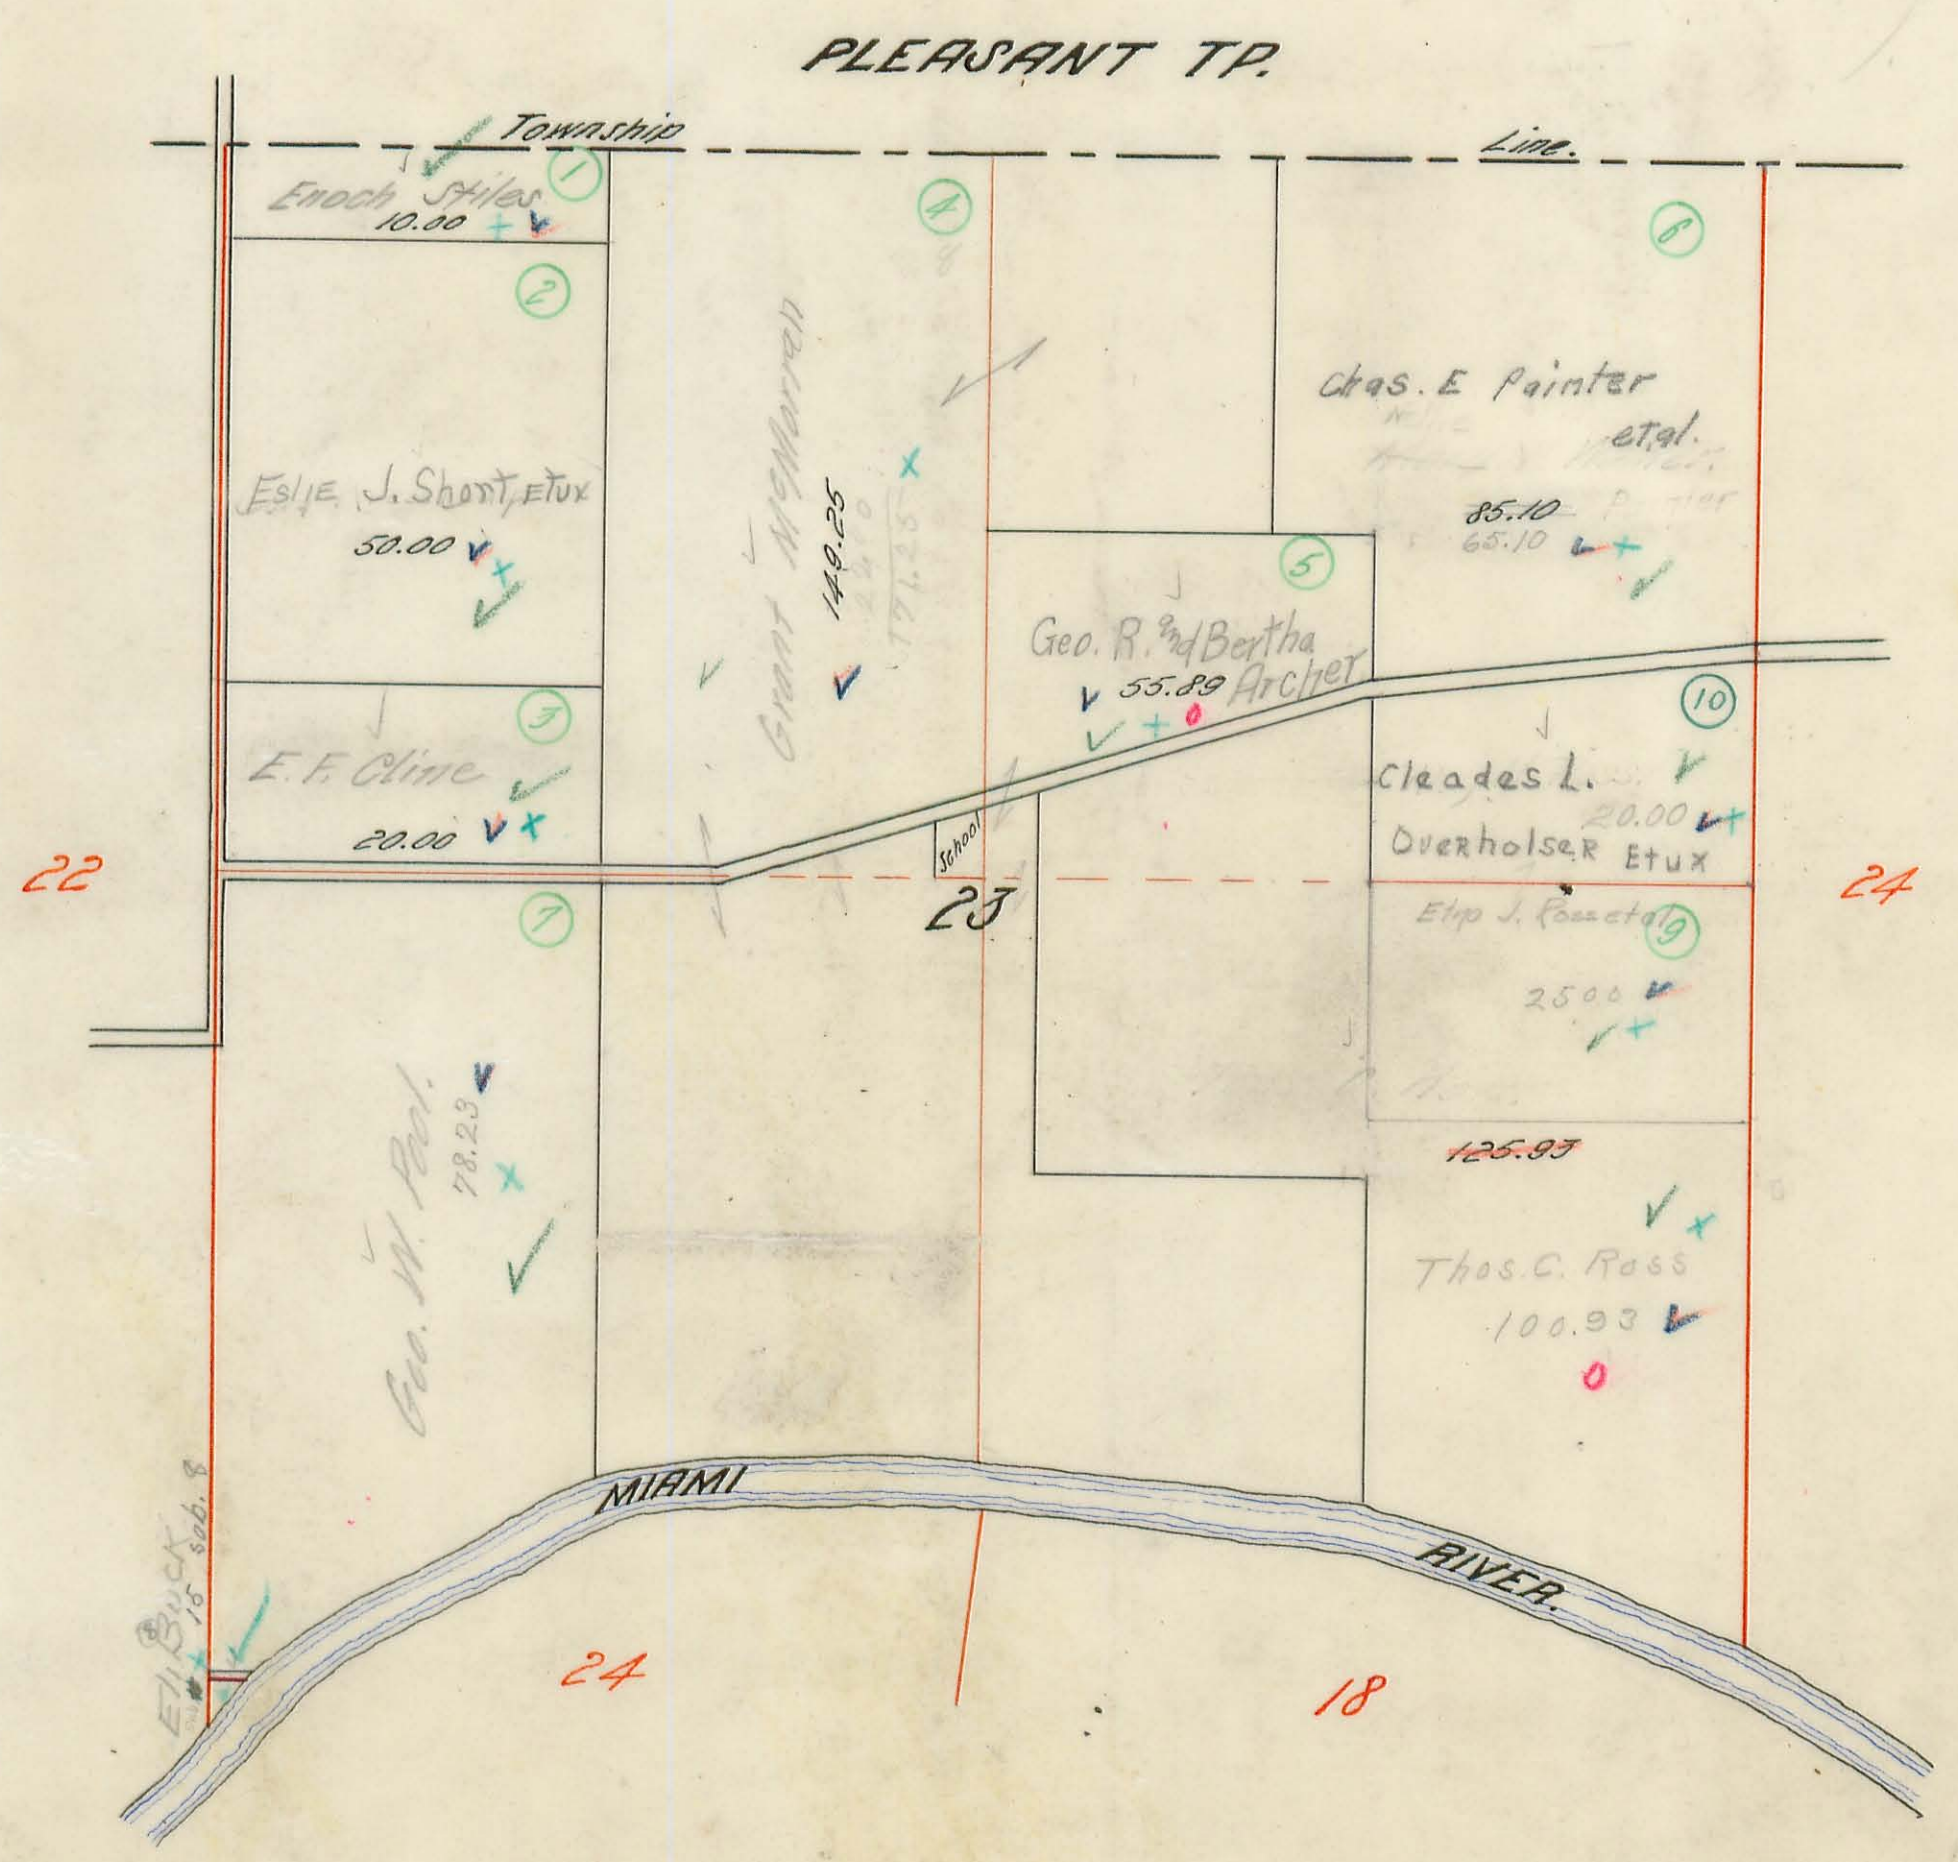




# MIAMI TOWNSHIP.

Plat of Section No. <sup>24</sup>25 Range No. 8 Town No. 1.

Scale 10 Chains Per Inch.

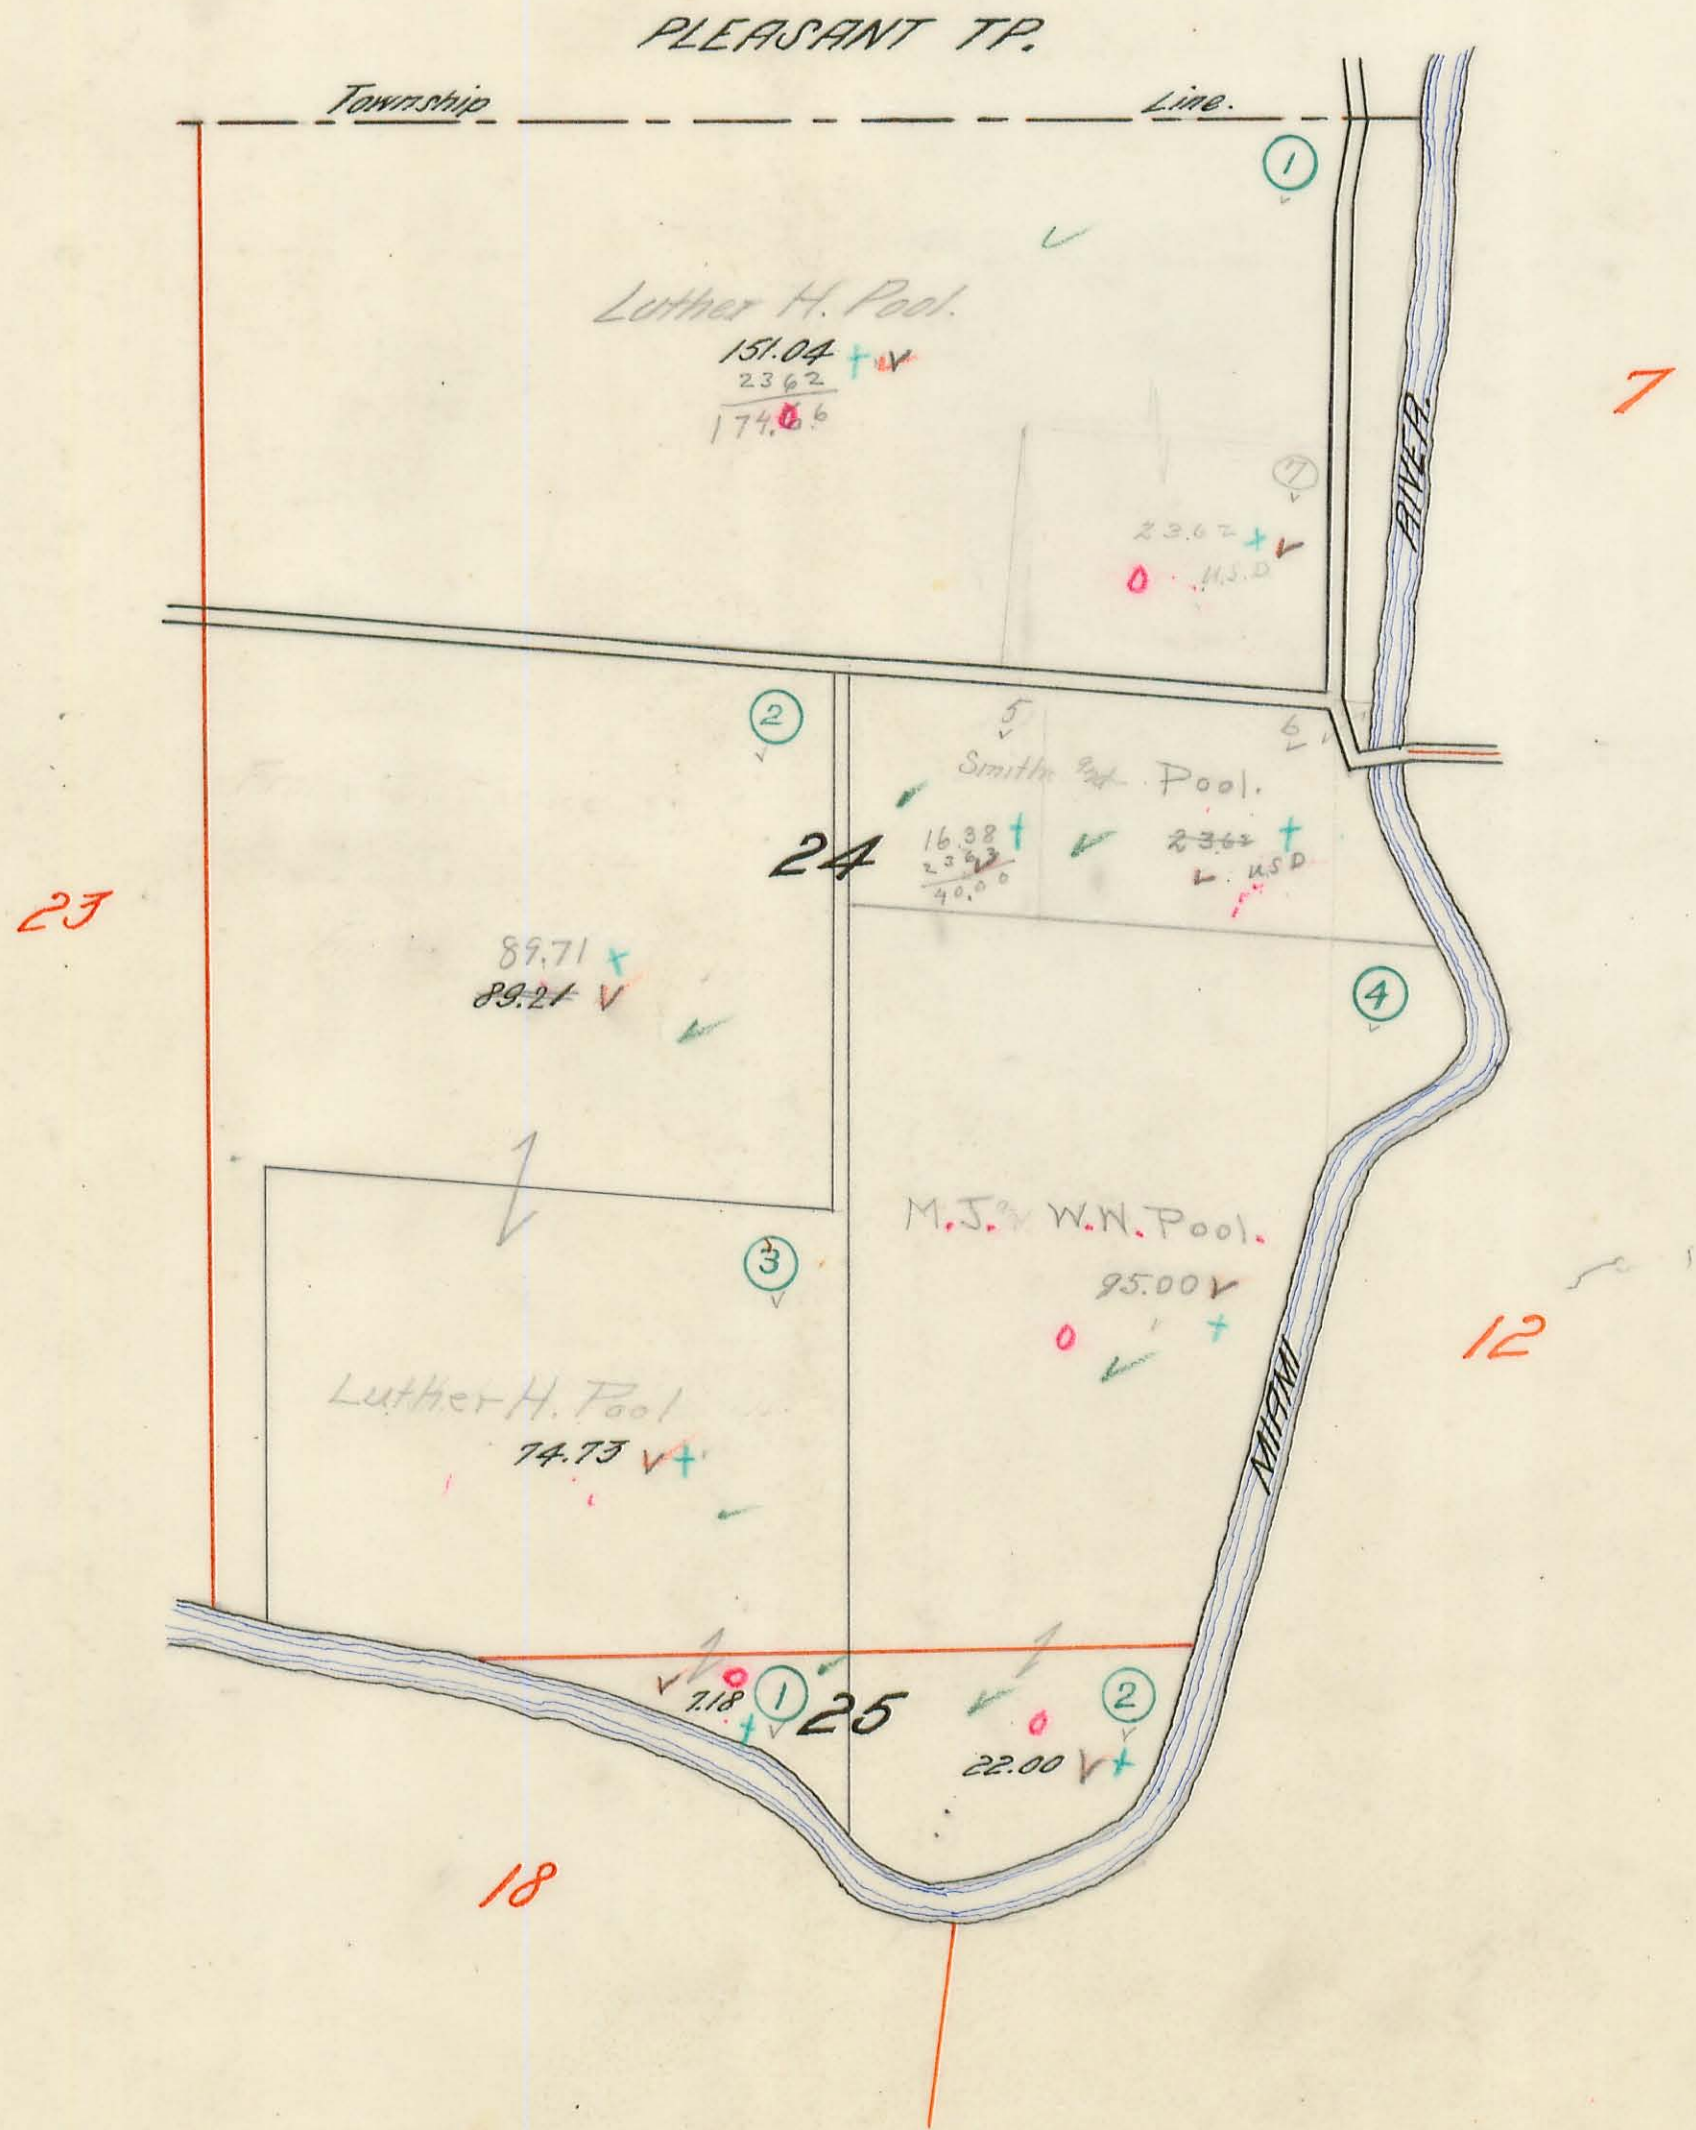




# MIAMI TOWNSHIP.

Plat of Section No. <sup>12</sup> and 7 Range No. <sup>13</sup> Town No. <sup>3</sup> 2.

Scale 10 Chains Per Inch.

97  
1660  
1071

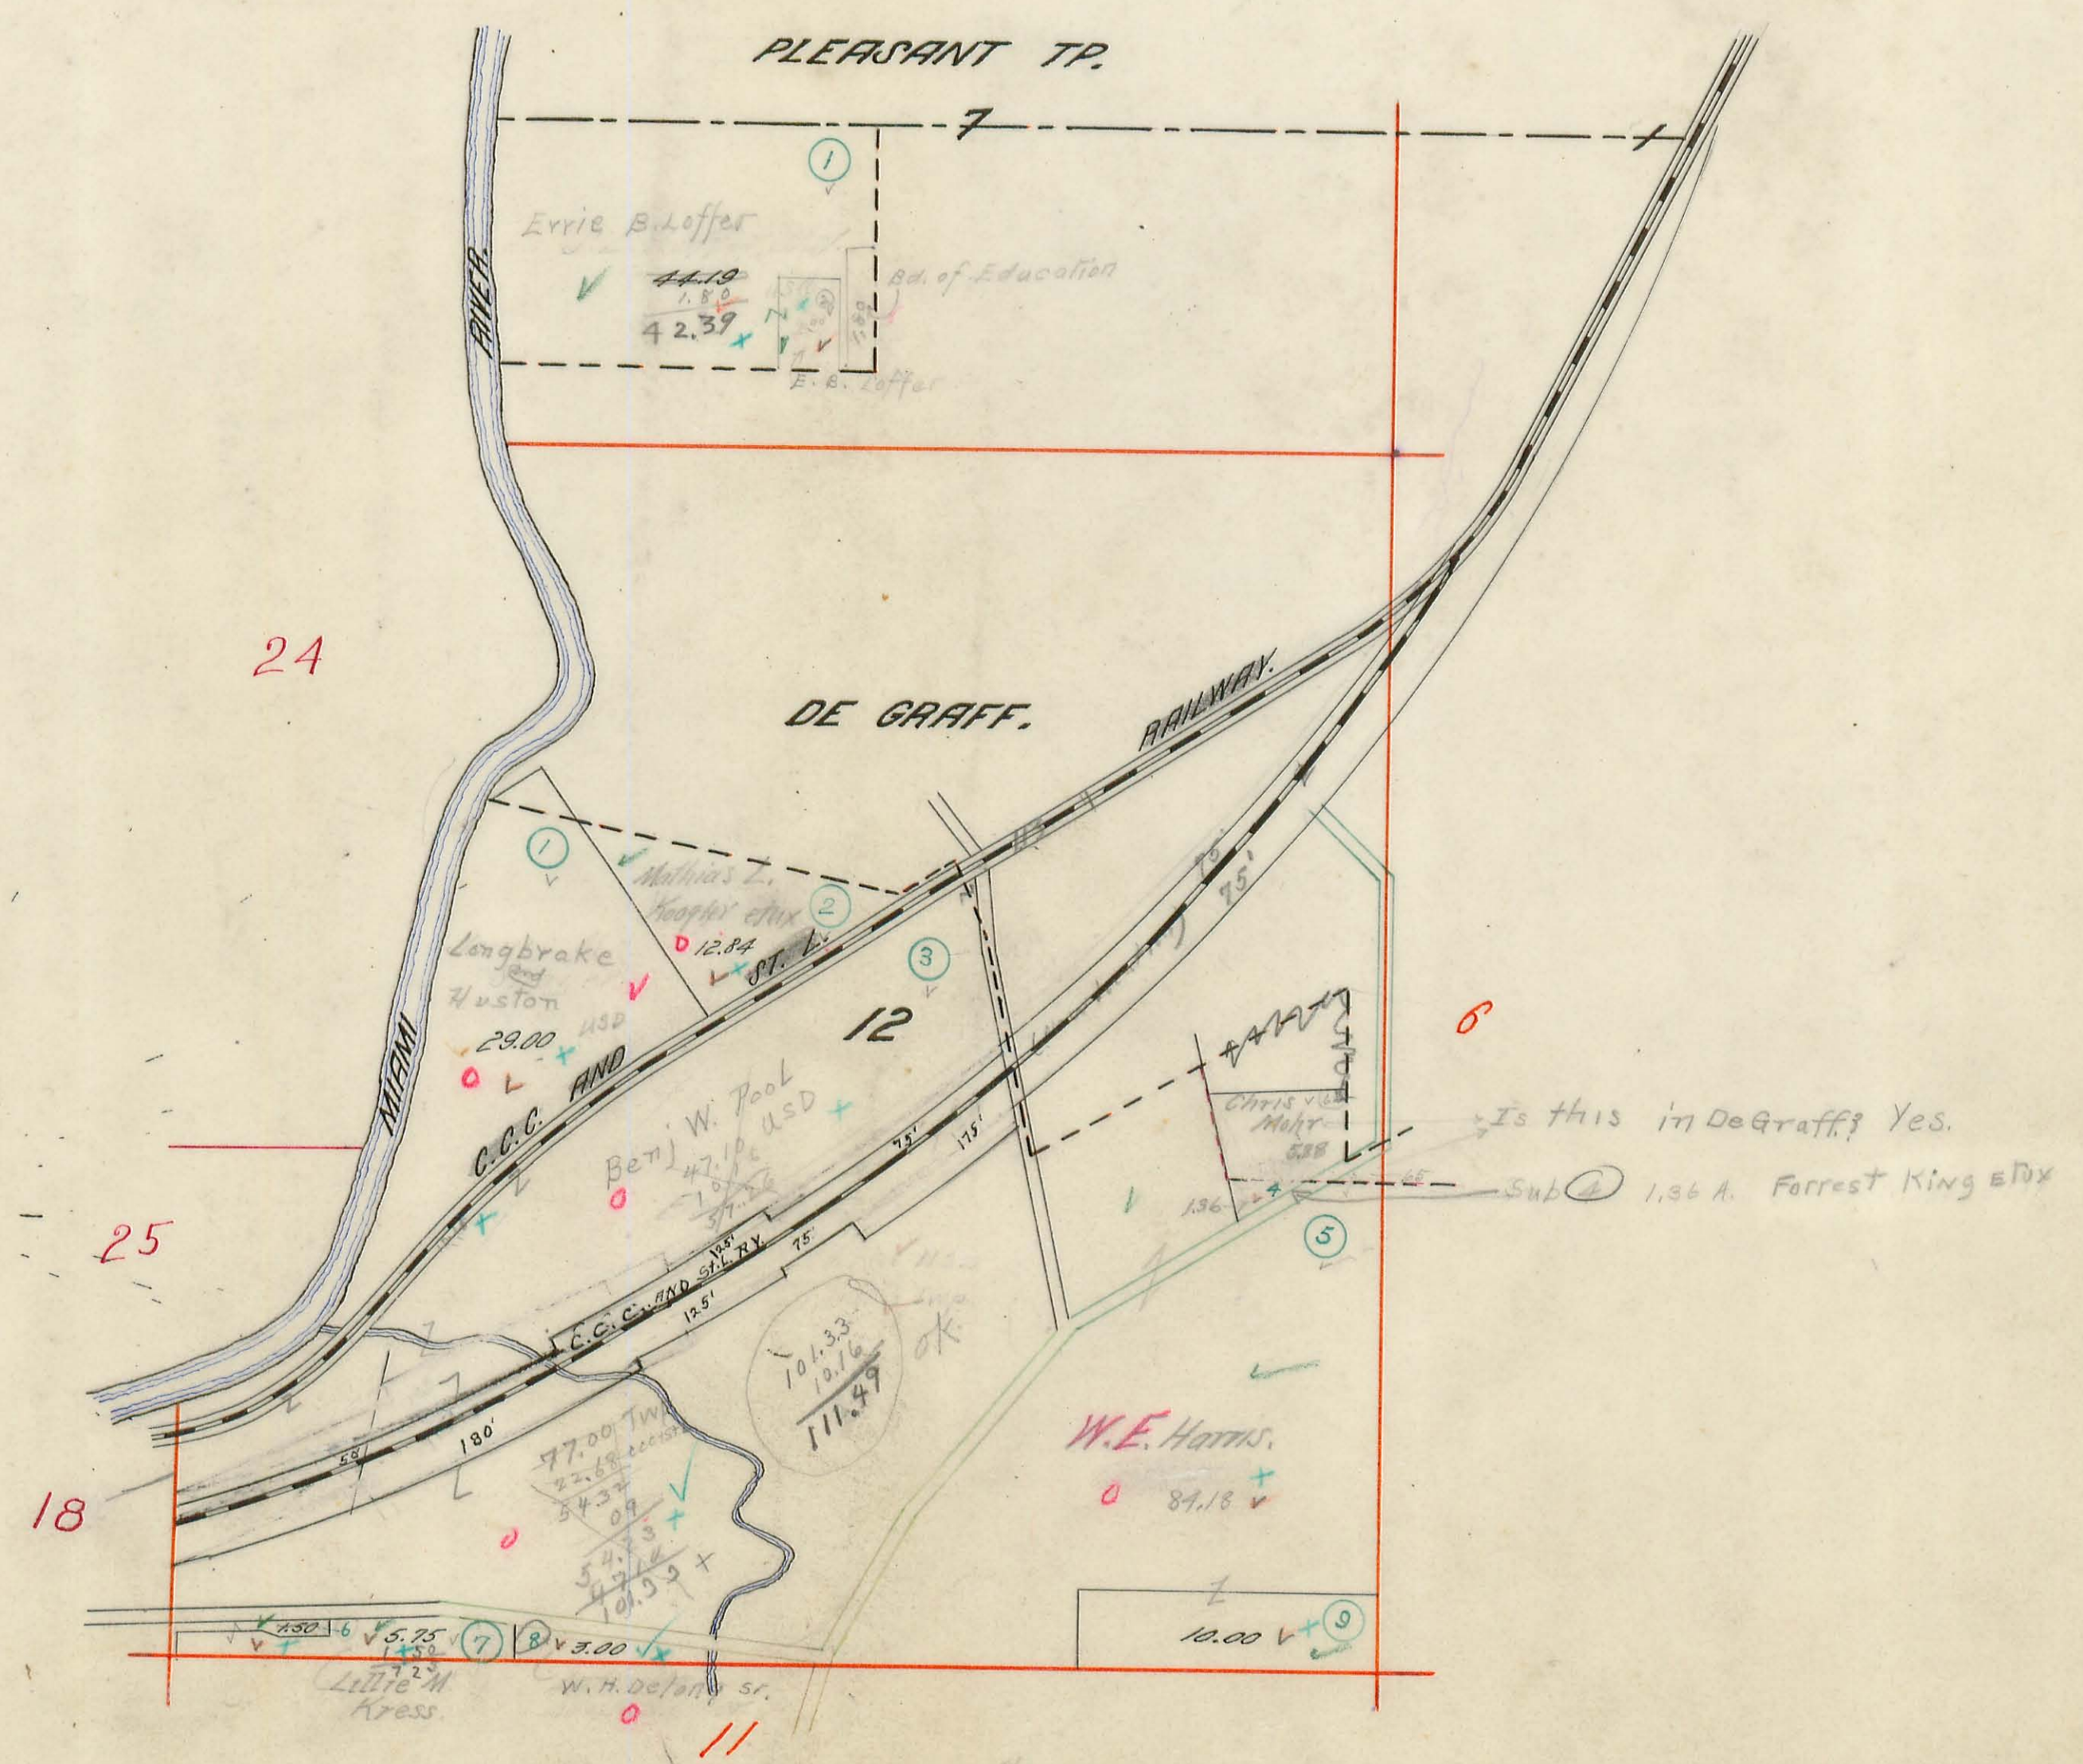




# MIAMI TOWNSHIP.

## Plat of Section No. 6 Range No. 13 Town No. J.

Scale 10 Chains Per Inch.

1.  $59.04 = 4.10 + 54.94$  (CR 1.13)  
 $2.10 = 52.81$  (Anch. 100)

2.  $55.59 = 6.00 + 49.59$   
 $5.90 + 49.59$

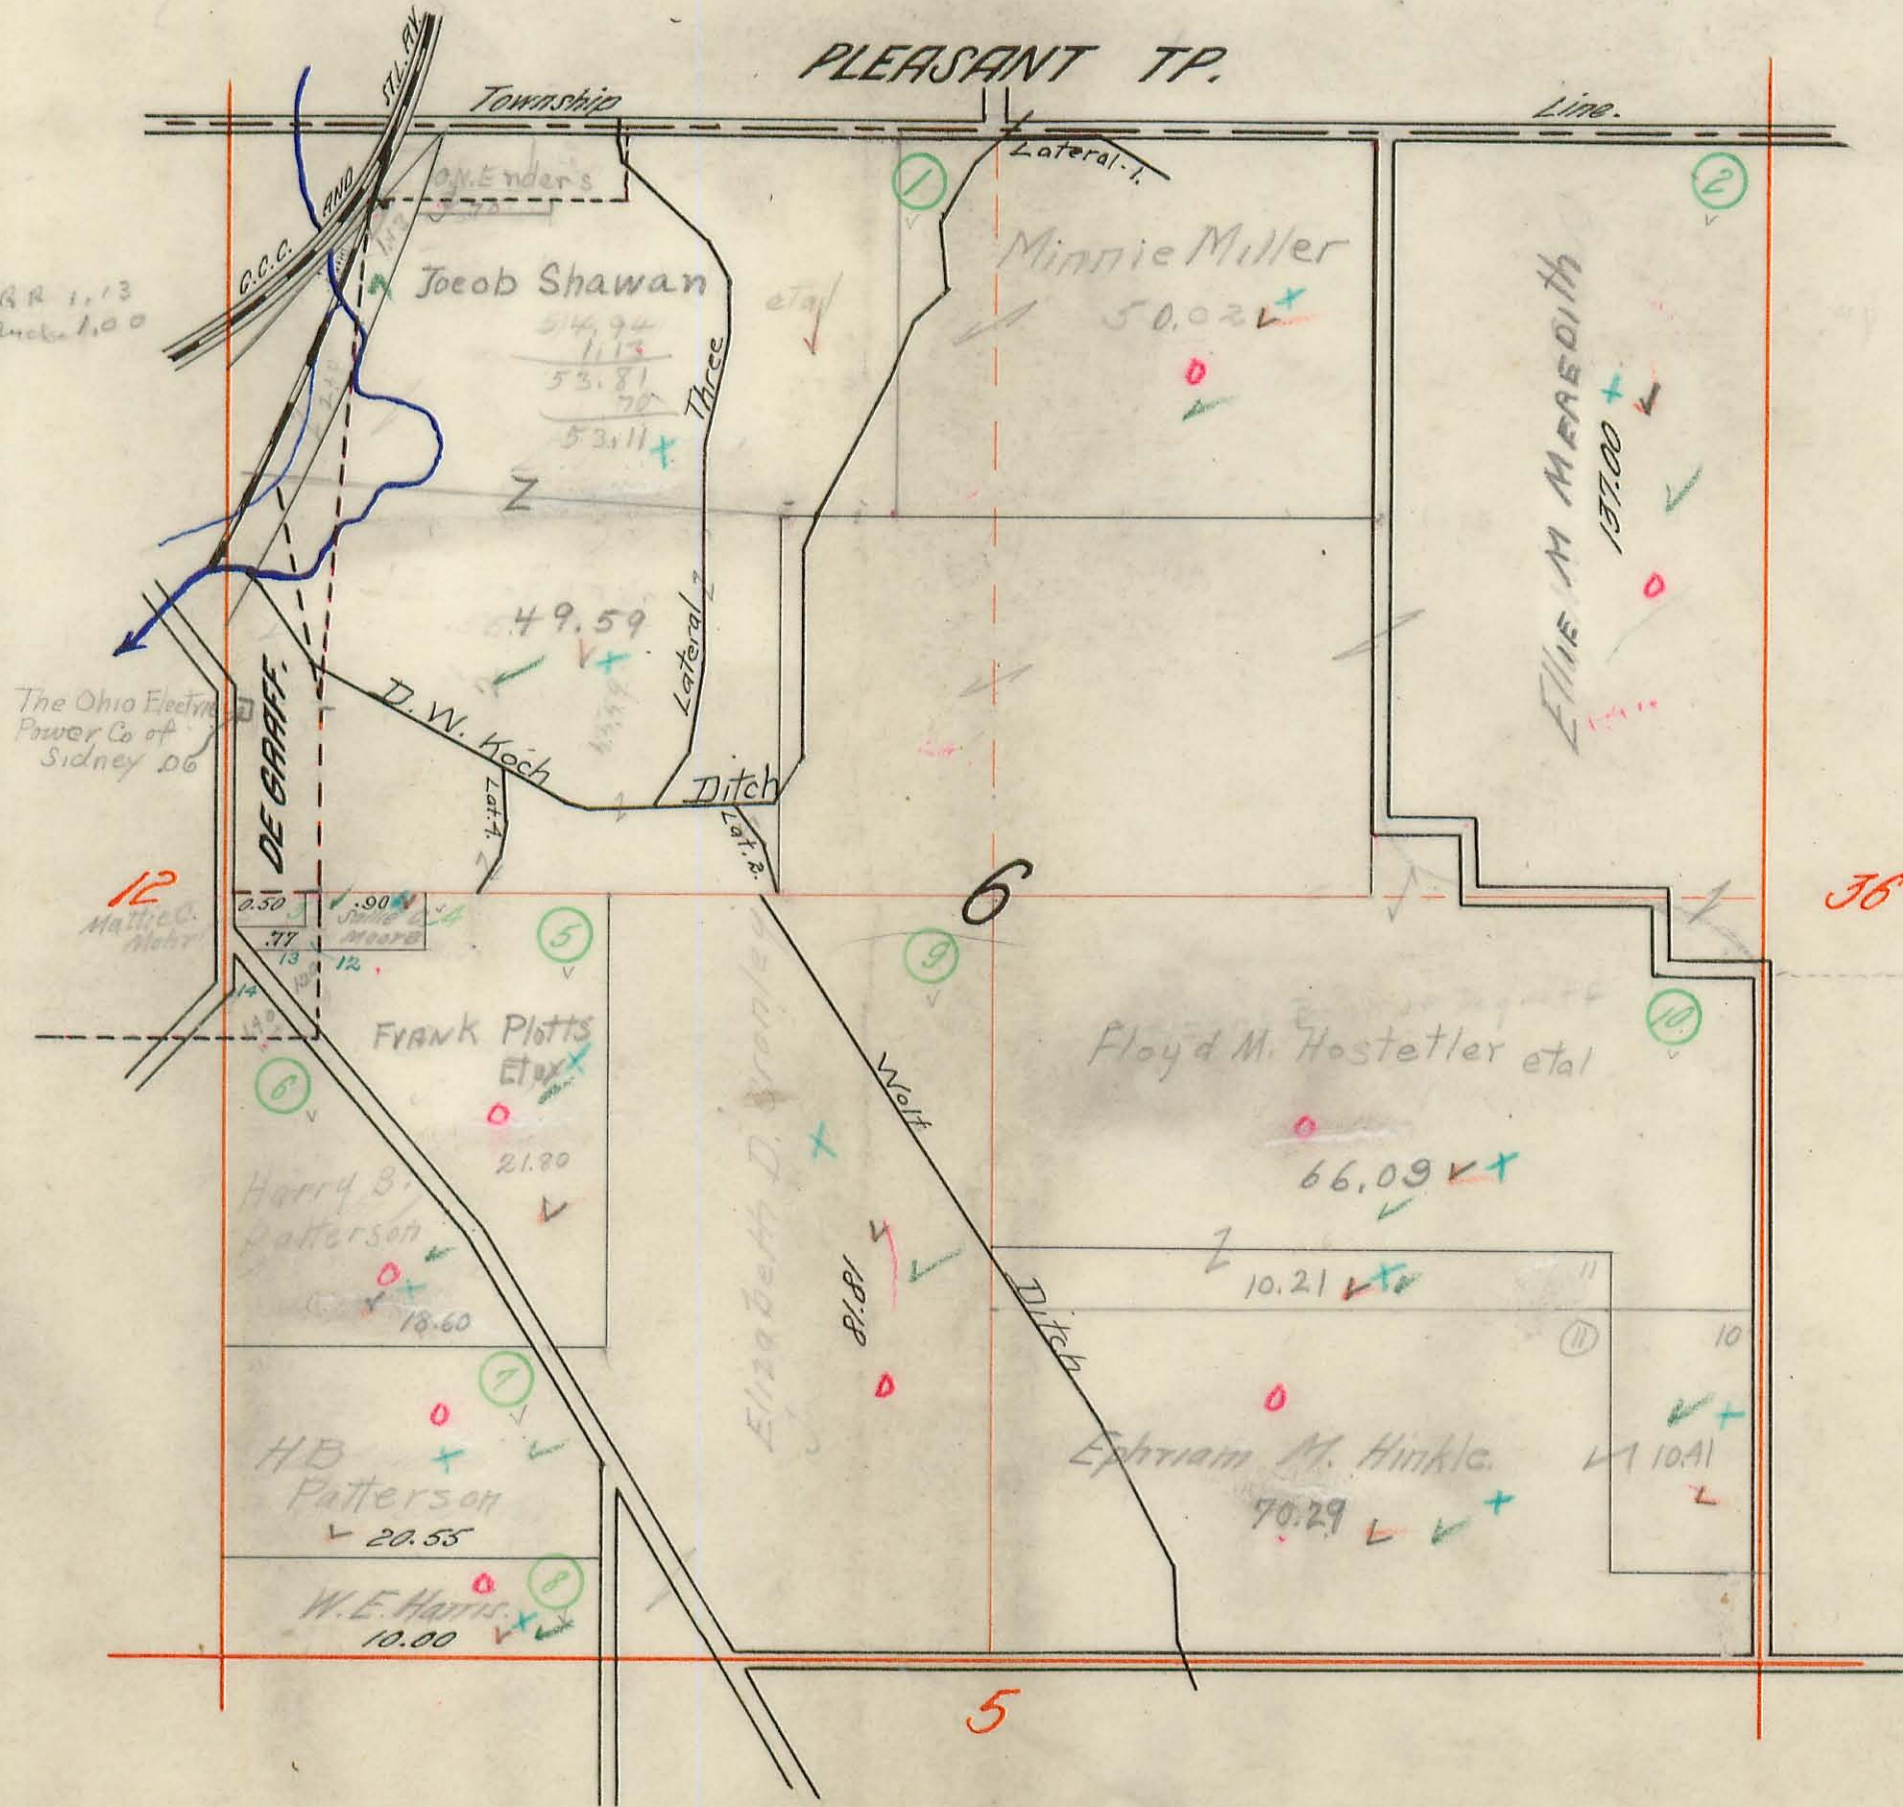

The Ohio Electric Power Co of Sidney, O.

12

6

36


5



# MIAMI TOWNSHIP.

Plat of Section No. 36 Range No. 13 Town No. 4.

Scale 10 Chains Per Inch.

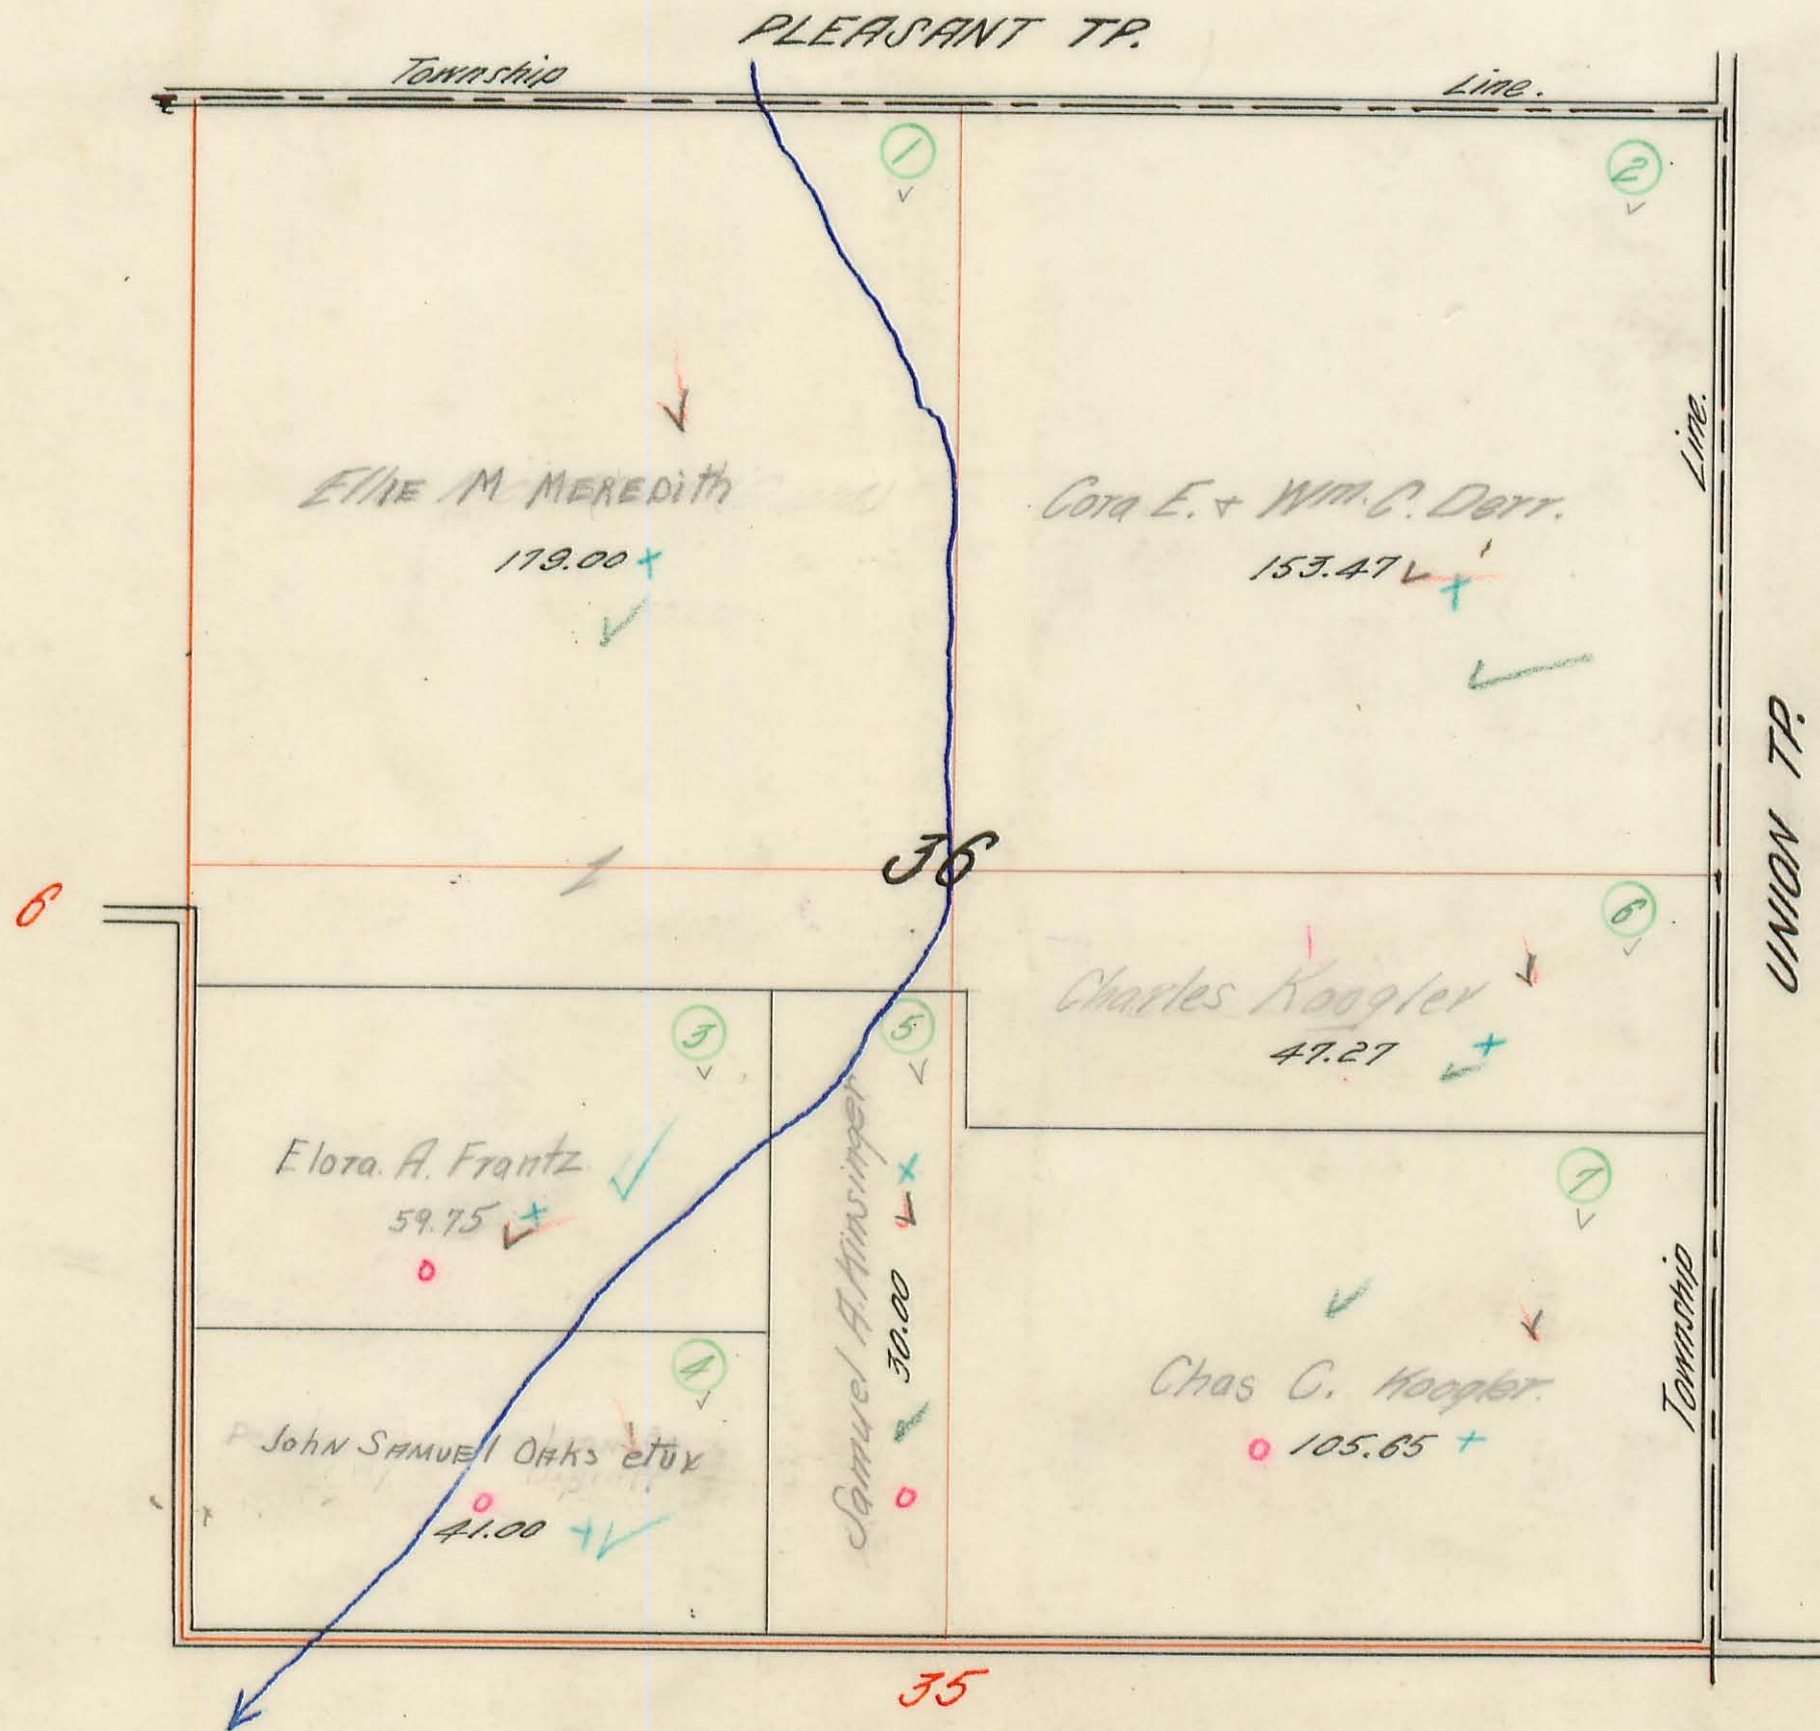




# MIAMI TOWNSHIP.

Plat of Section No. 35 Range No. 13 Town No. 3.

Scale 10 Chains Per Inch.

SHELBY COUNTY.

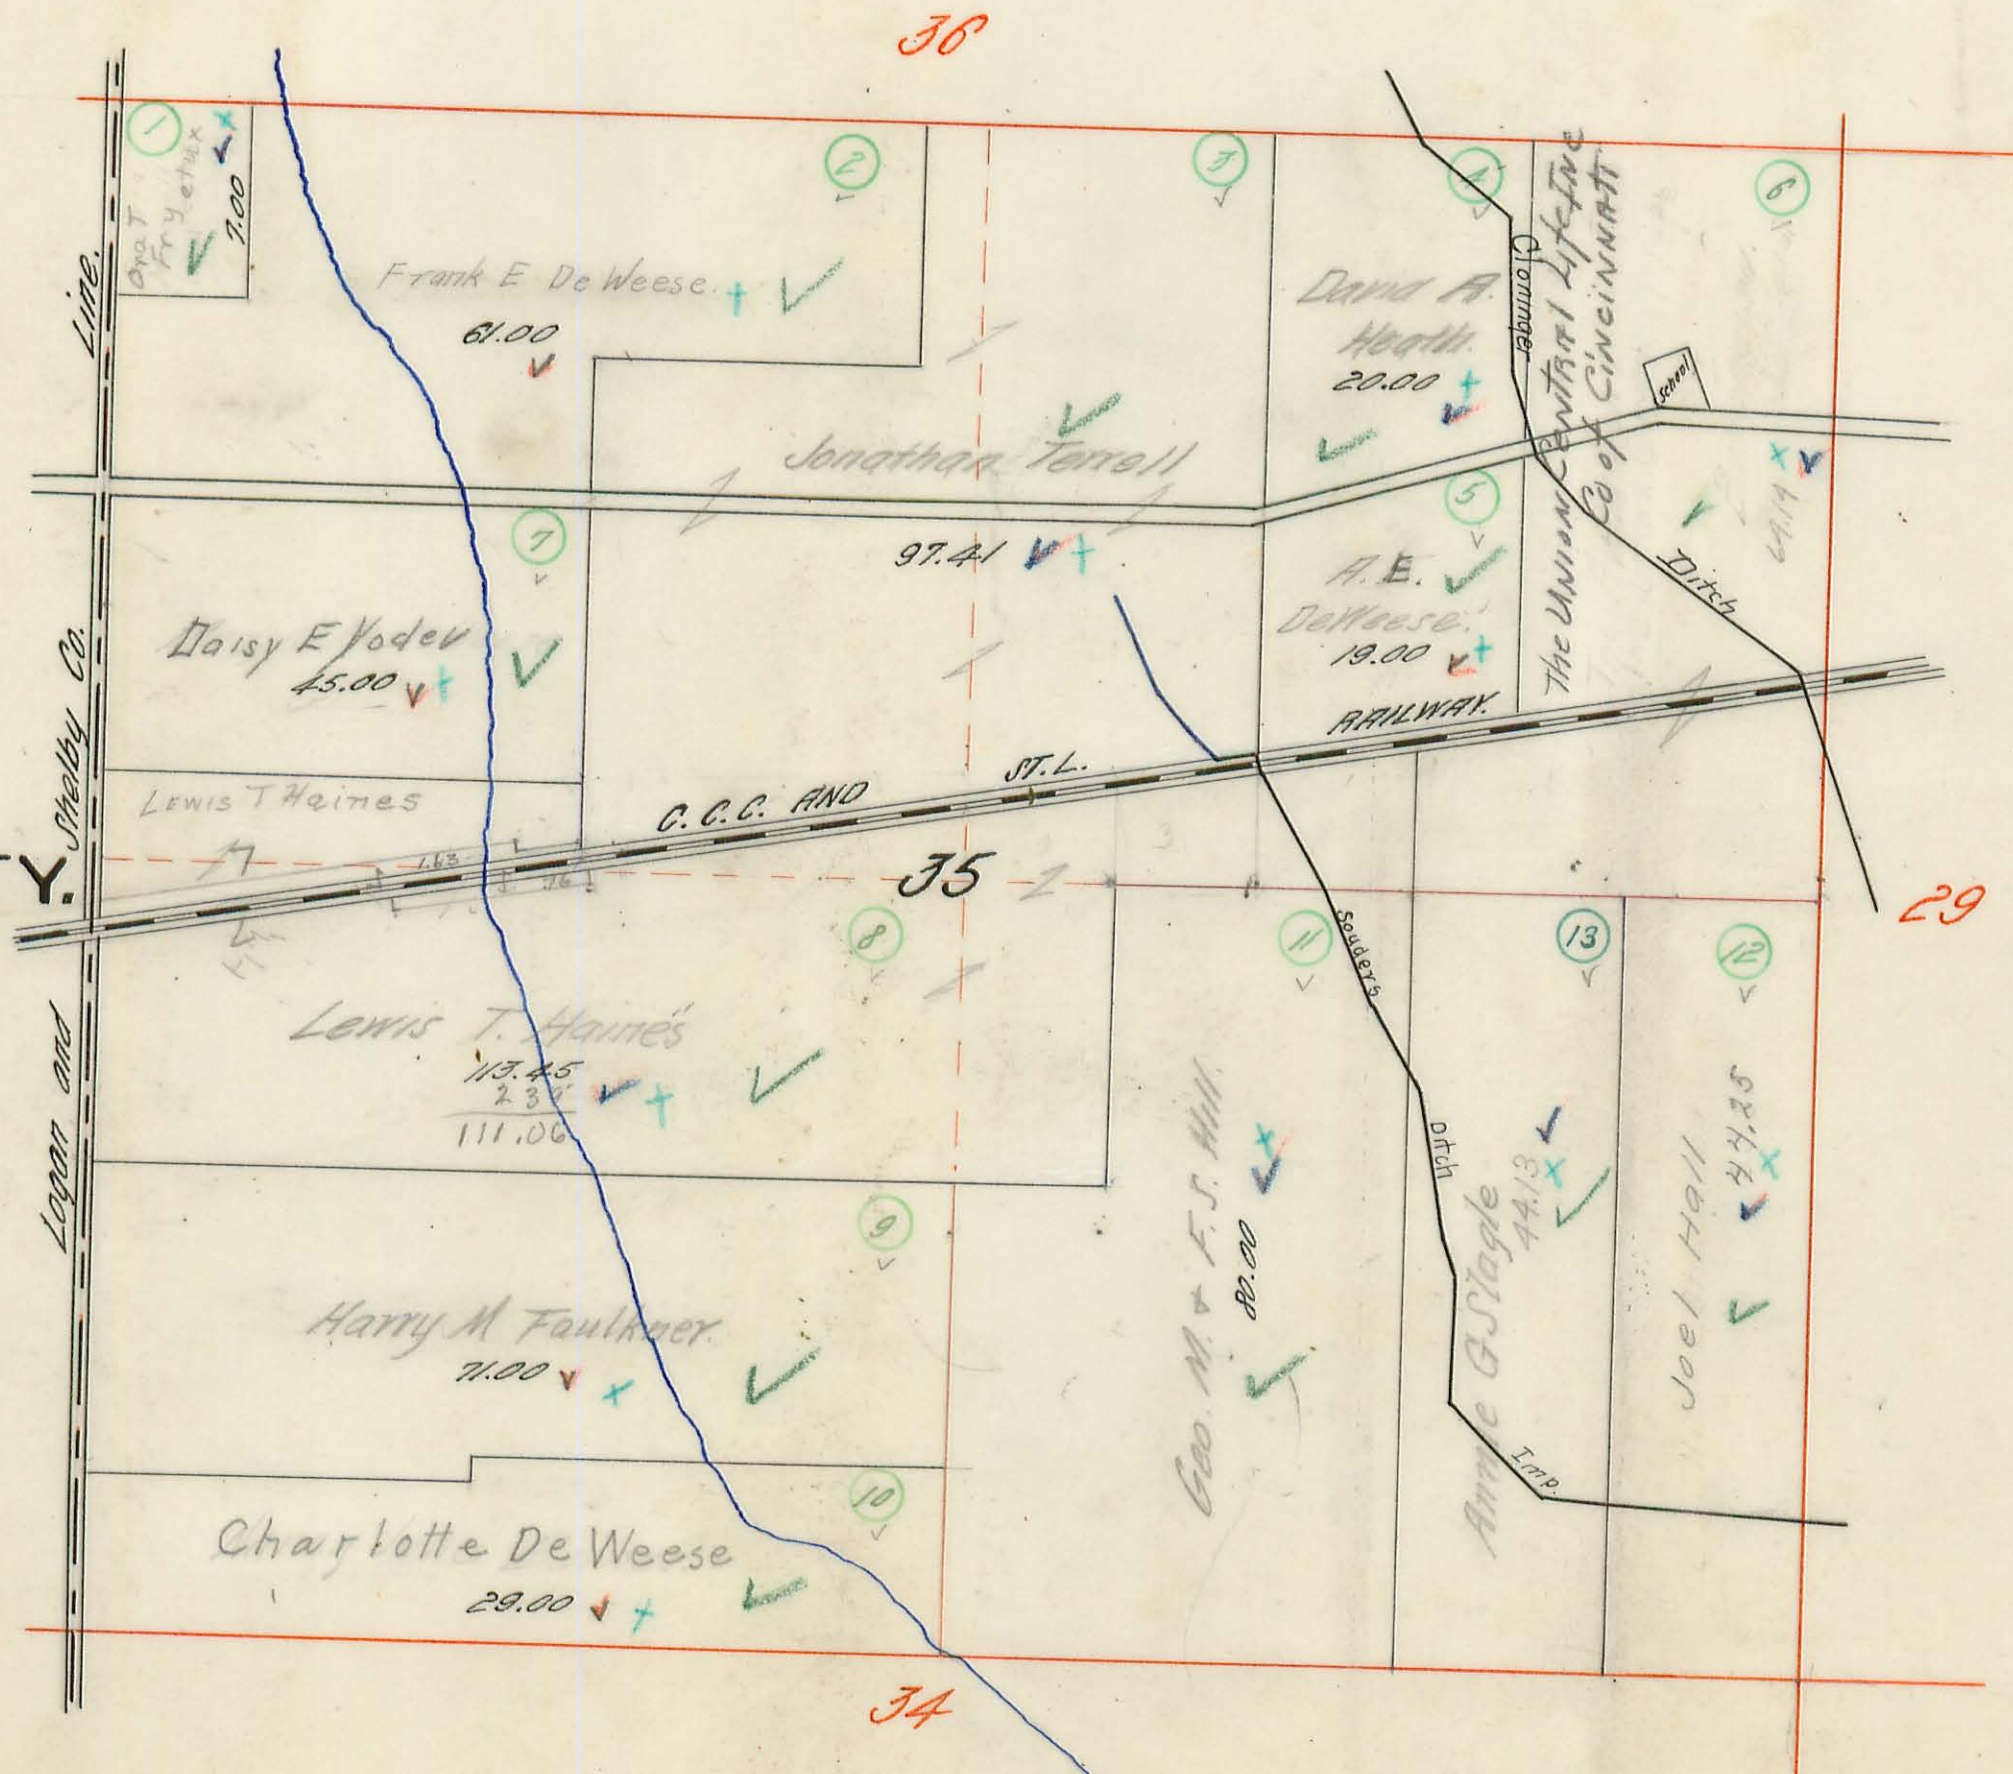




# MIAMI TOWNSHIP.

Plat of Section No. <sup>29</sup>30 Range No. 13 Town No. 3.

Scale 10 Chains Per Inch.

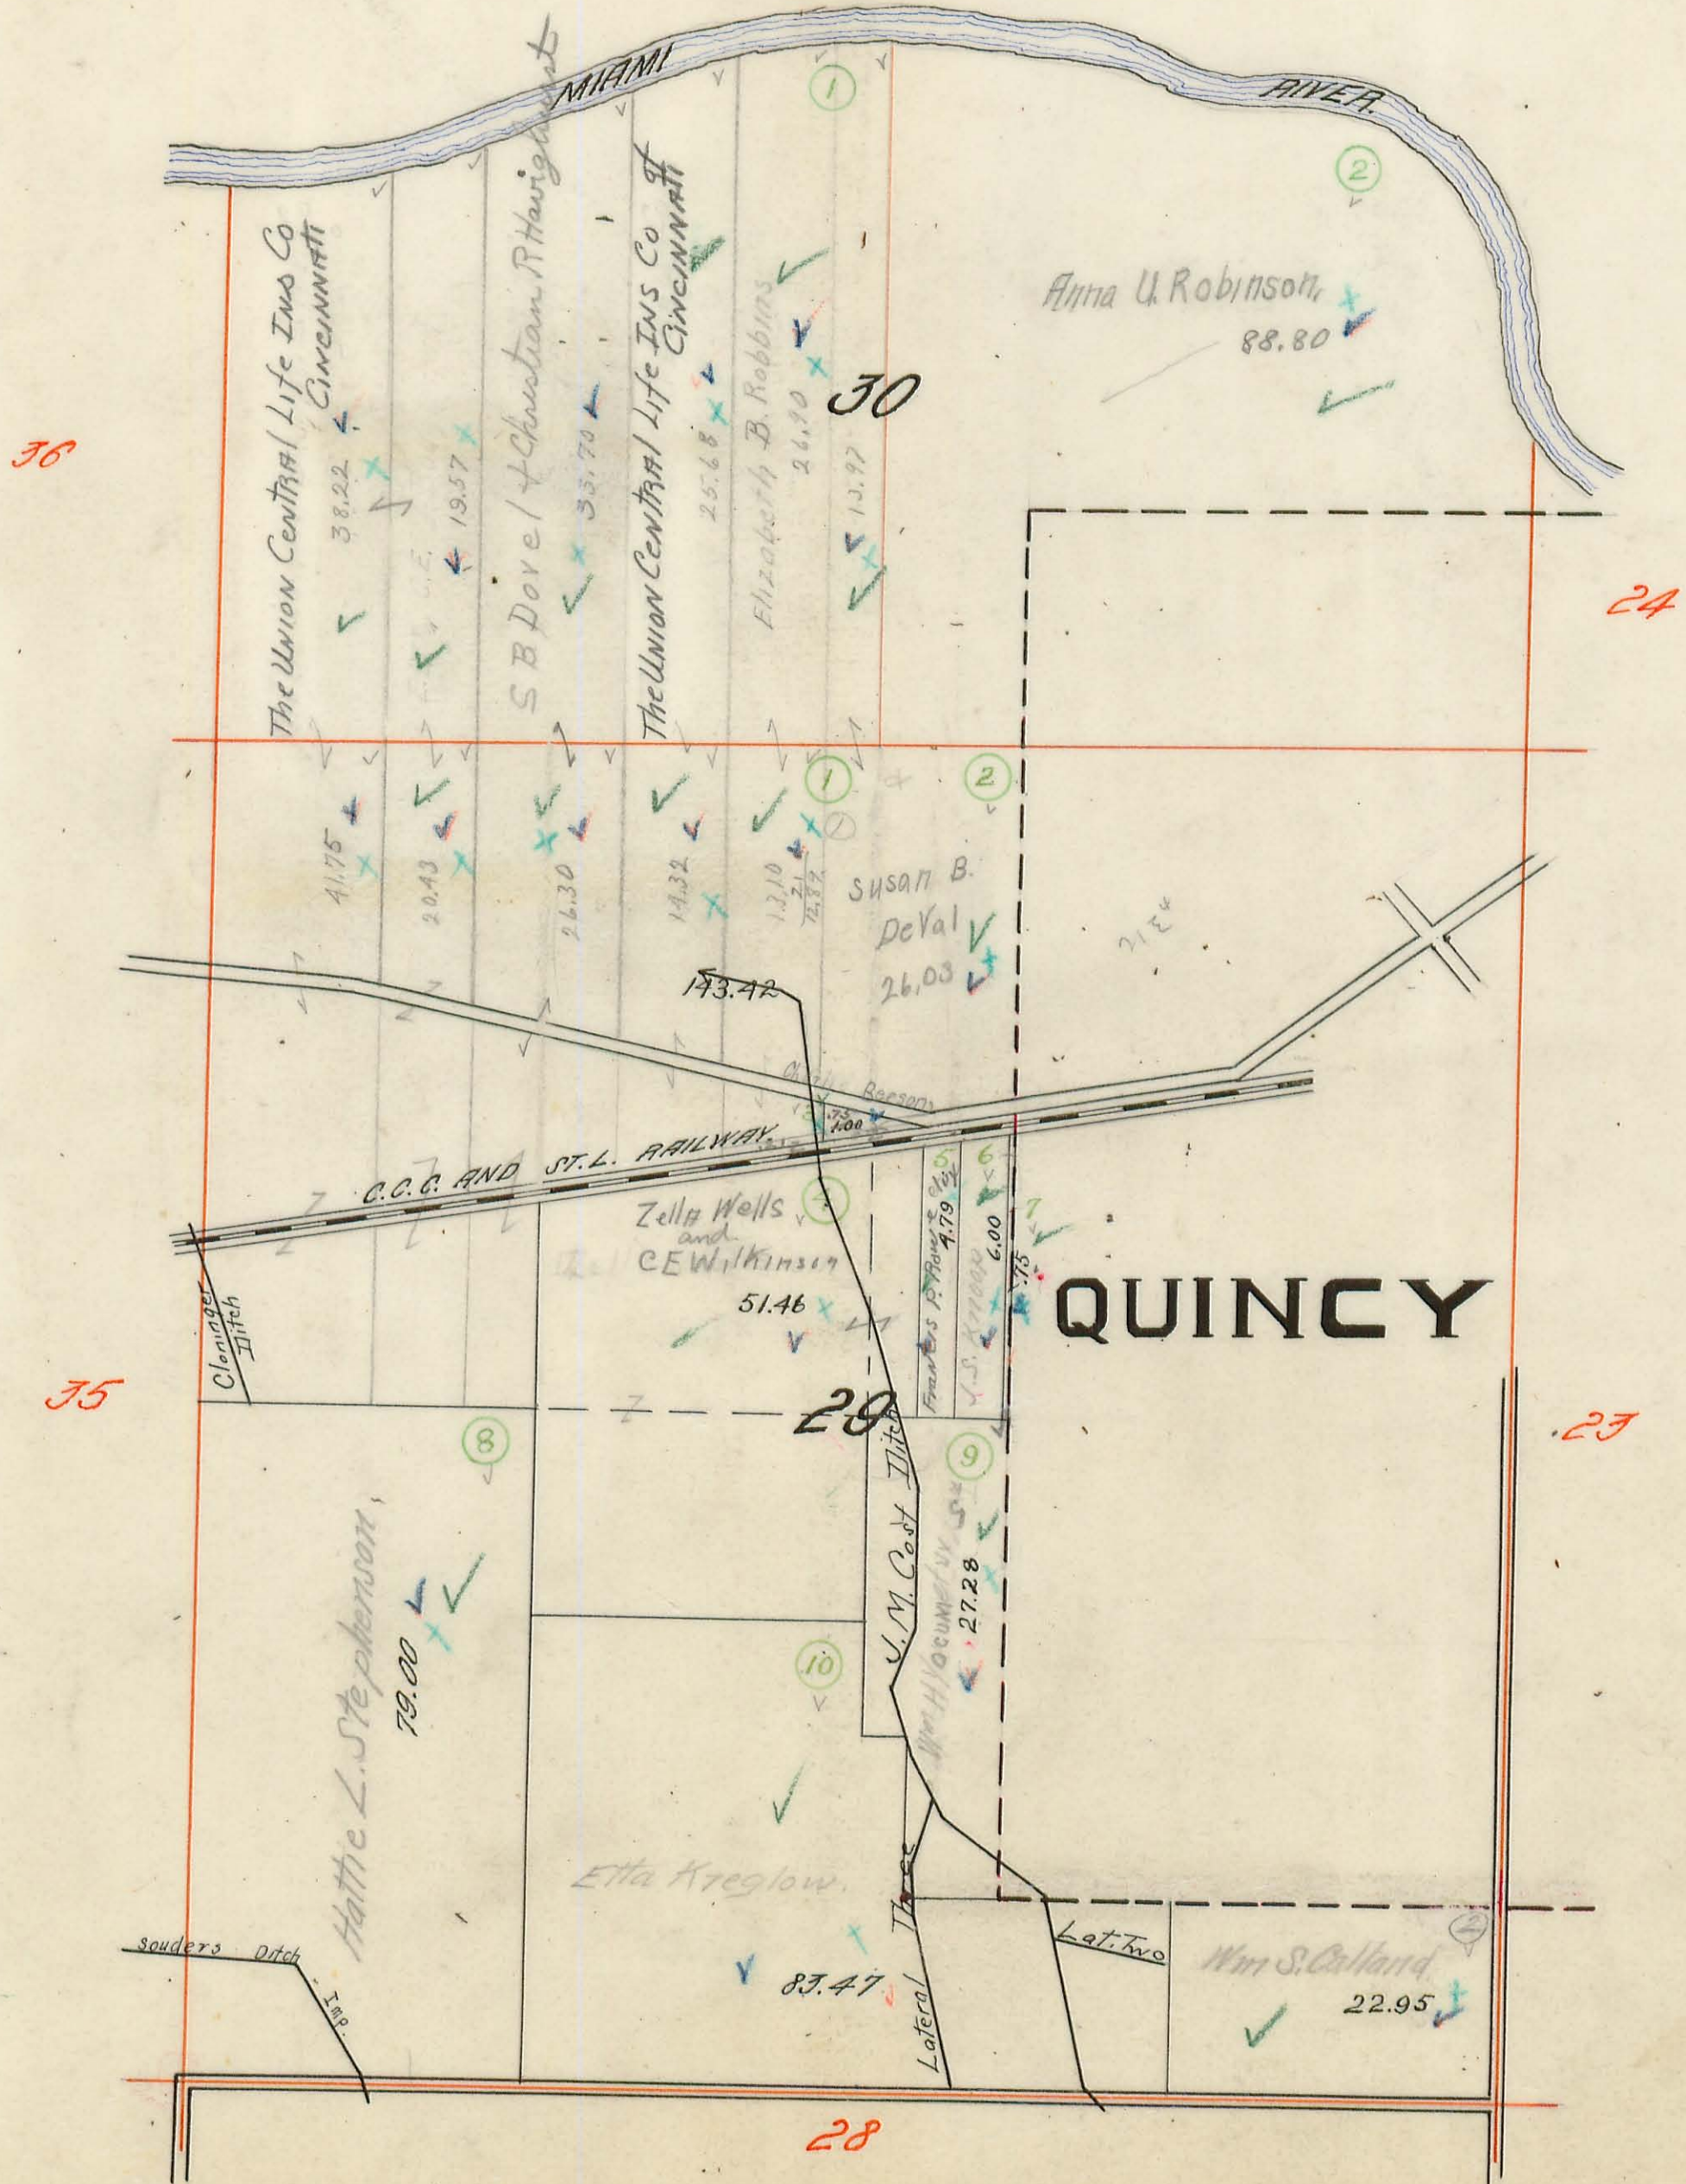




# MIAMI TOWNSHIP.

Plat of Section No. <sup>23</sup>24 Range No. 13 Town No. J.

Scale 10 Chains Per Inch.

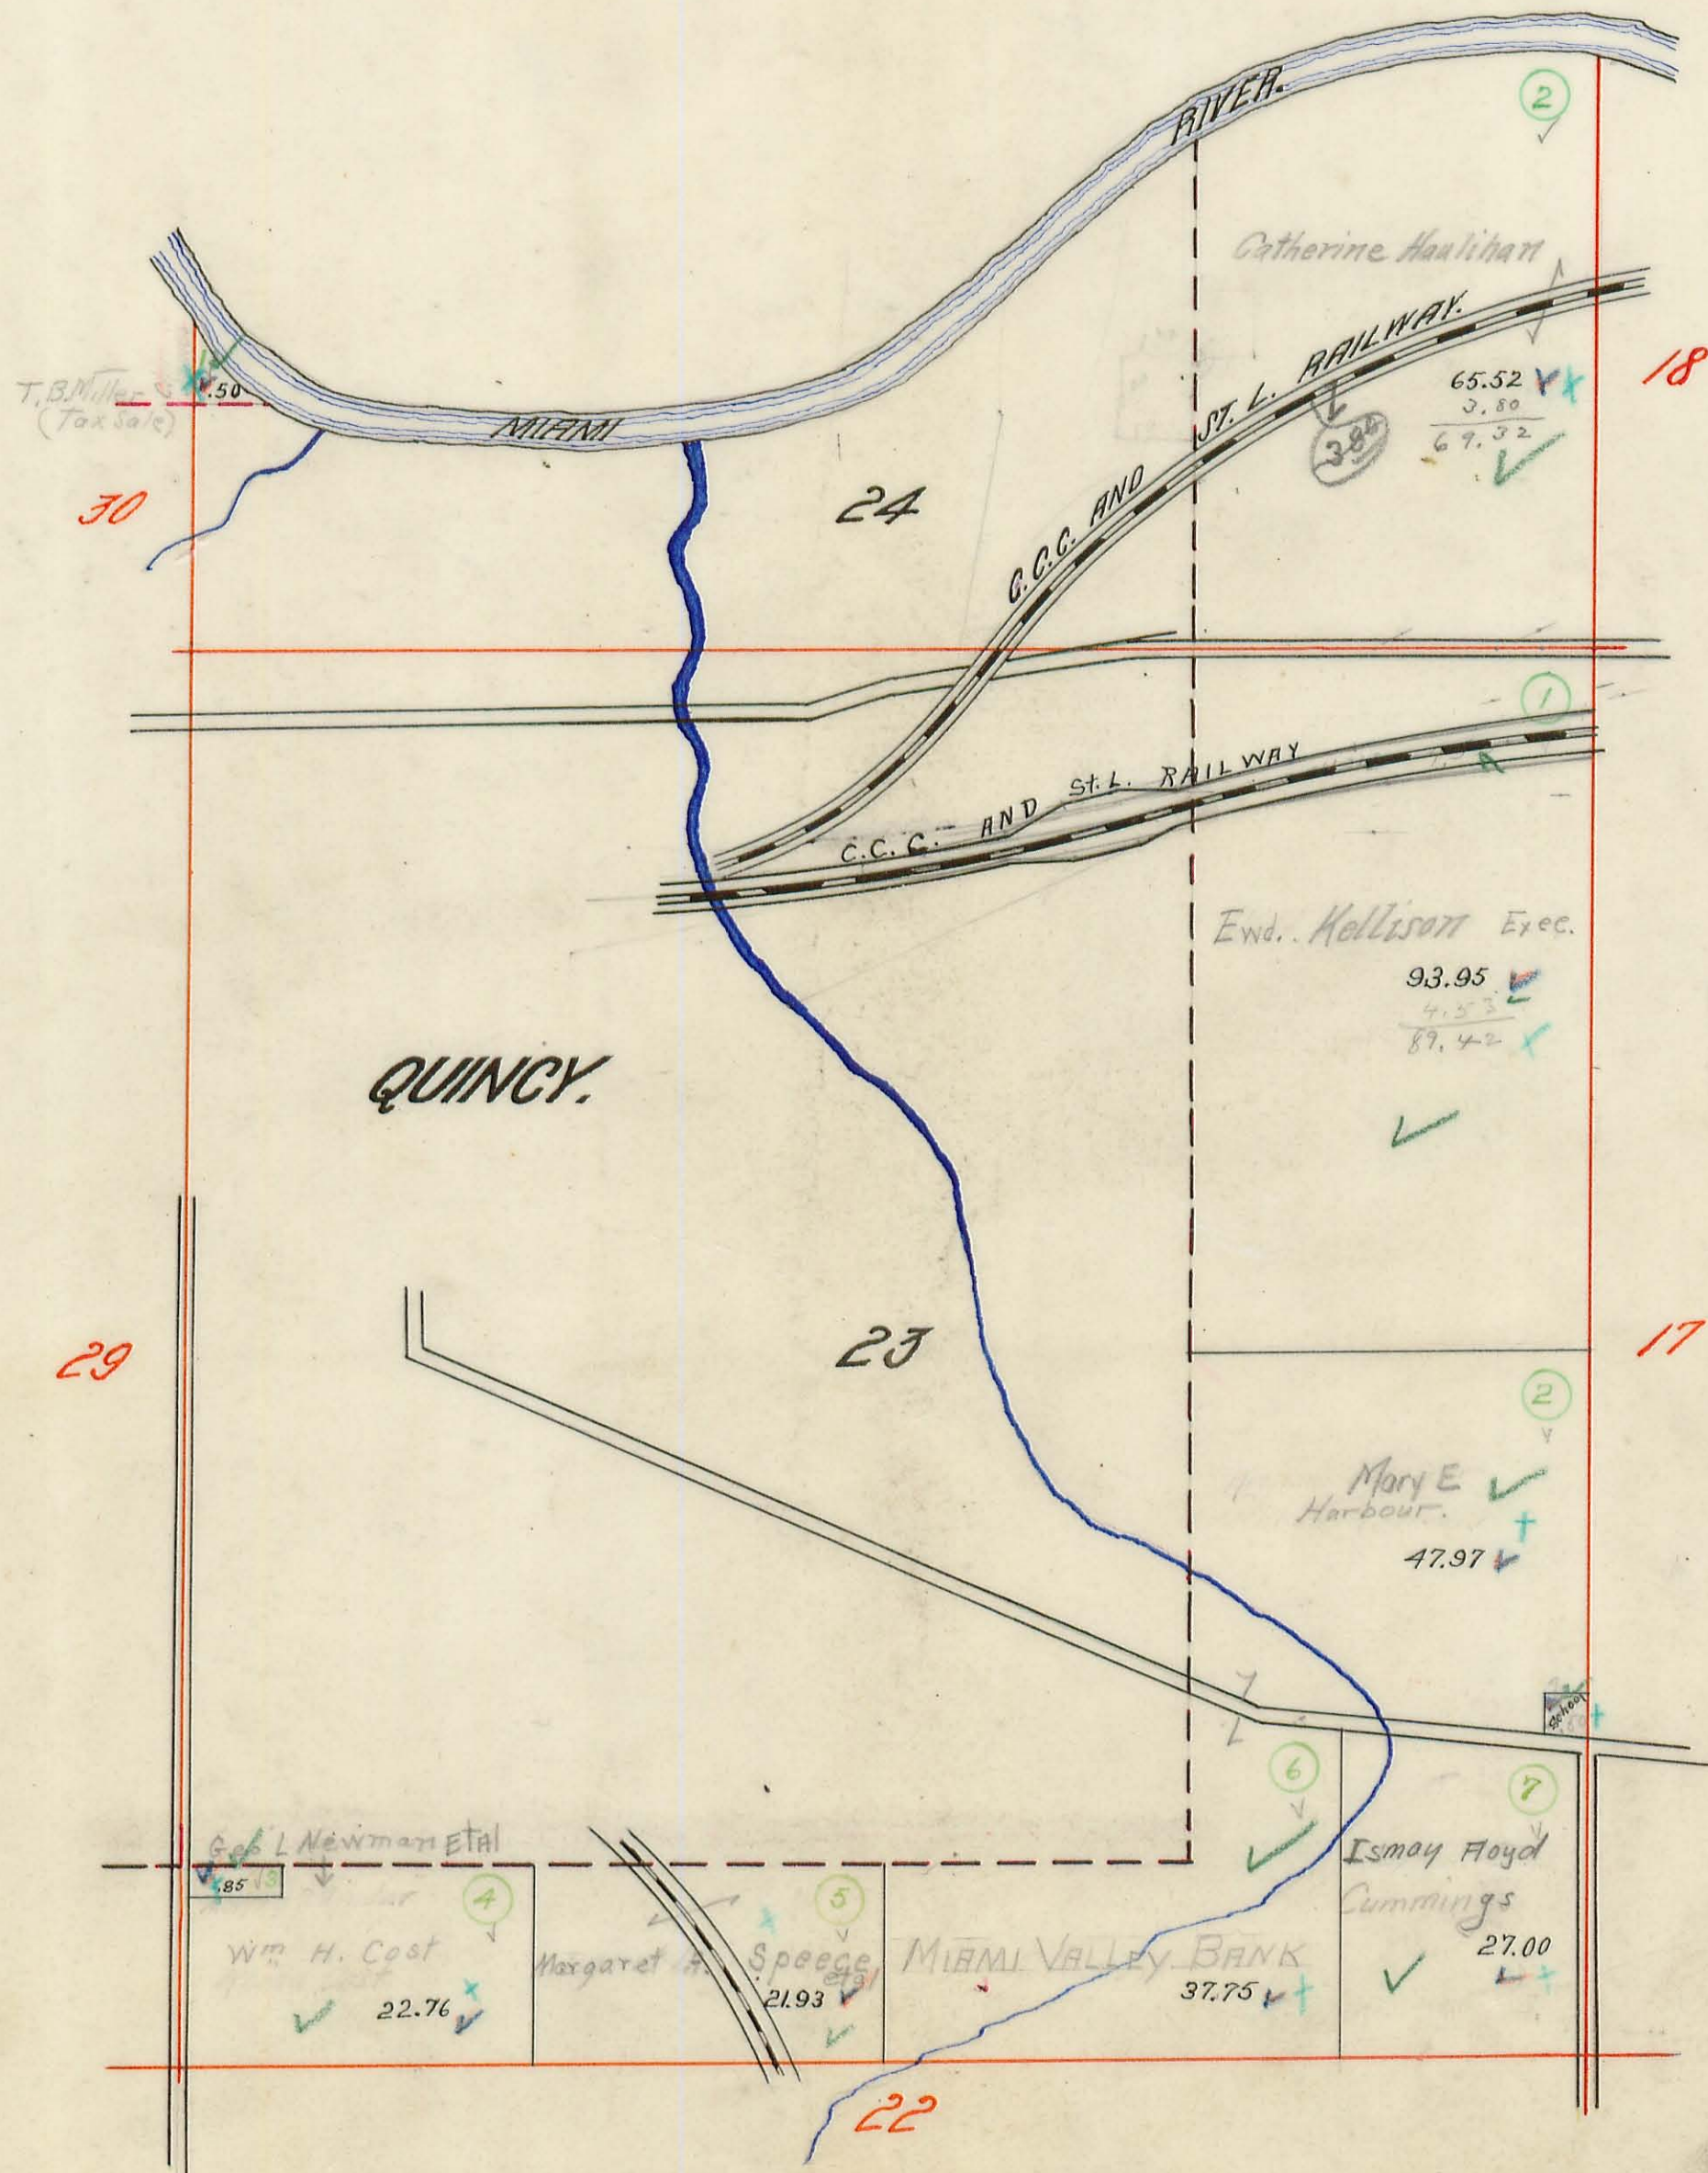




# MIAMI TOWNSHIP.

Plat of Section No. 17 Range No. 17 Town No. 7

Scale 10 Chains Per Inch.

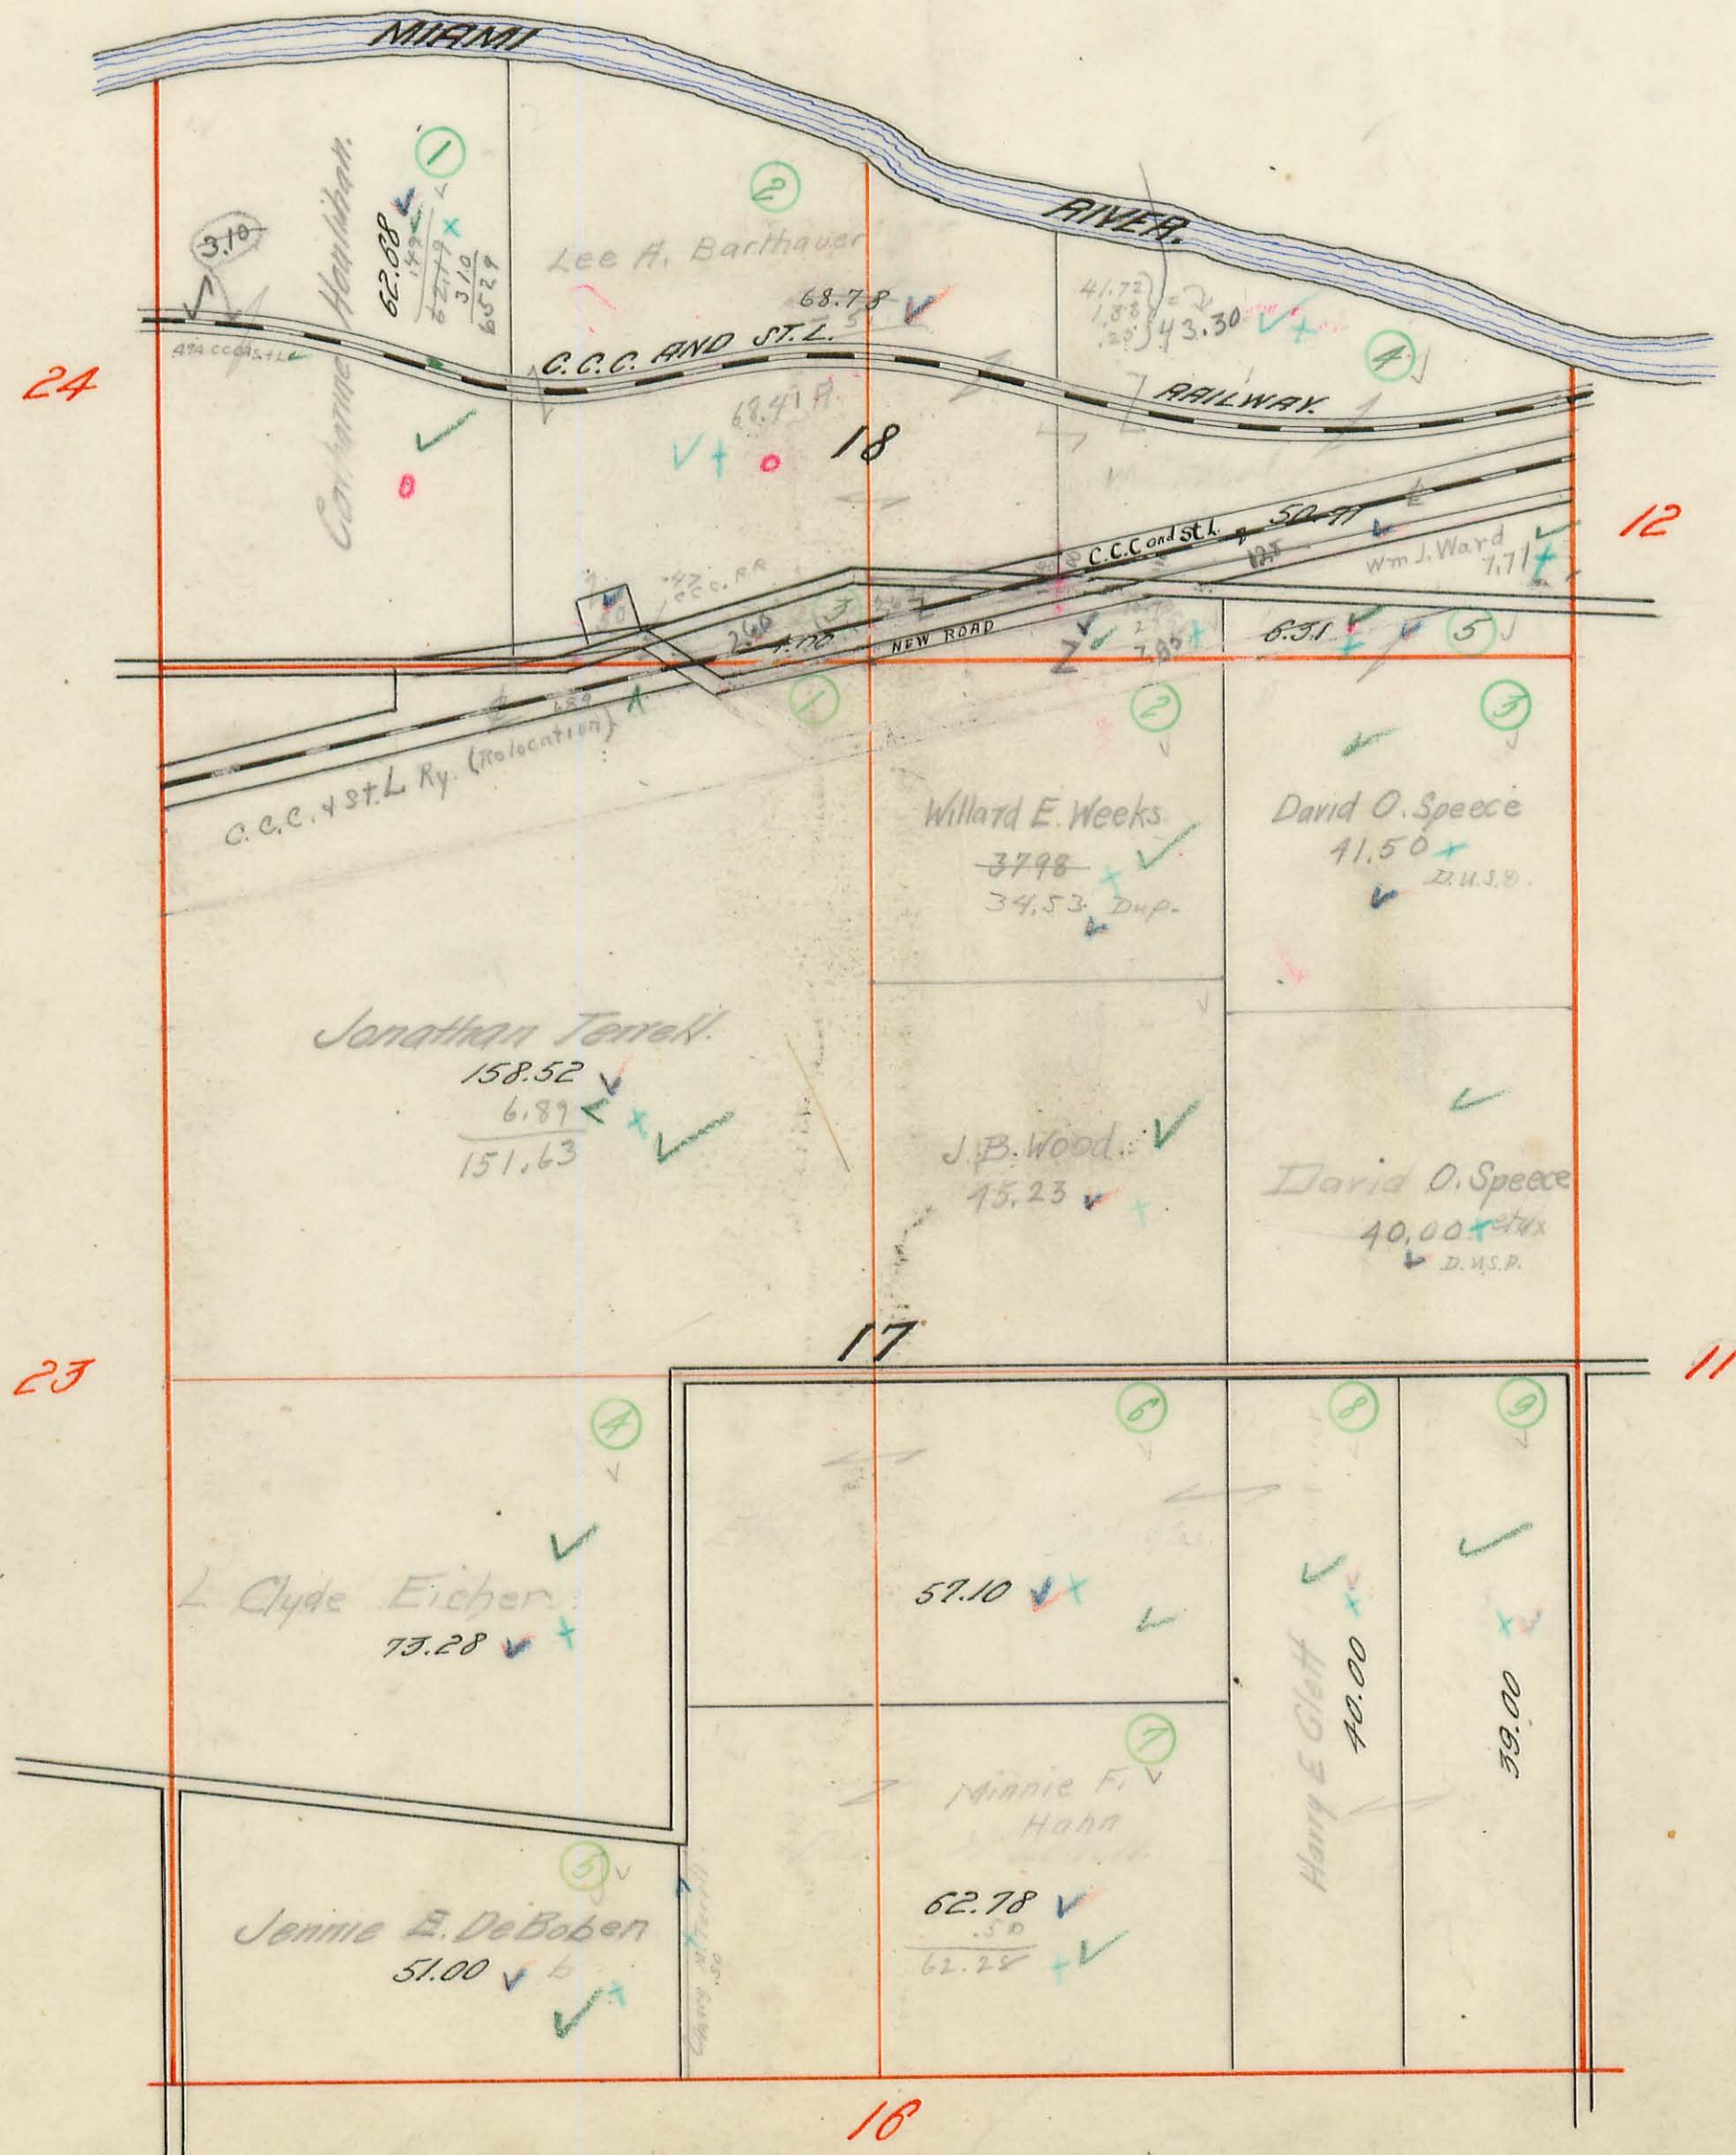




# MIAMI TOWNSHIP.

Plat of Section No. 11 Range No. 13 Town No. 3

Scale 10 Chains Per Inch.

84.82

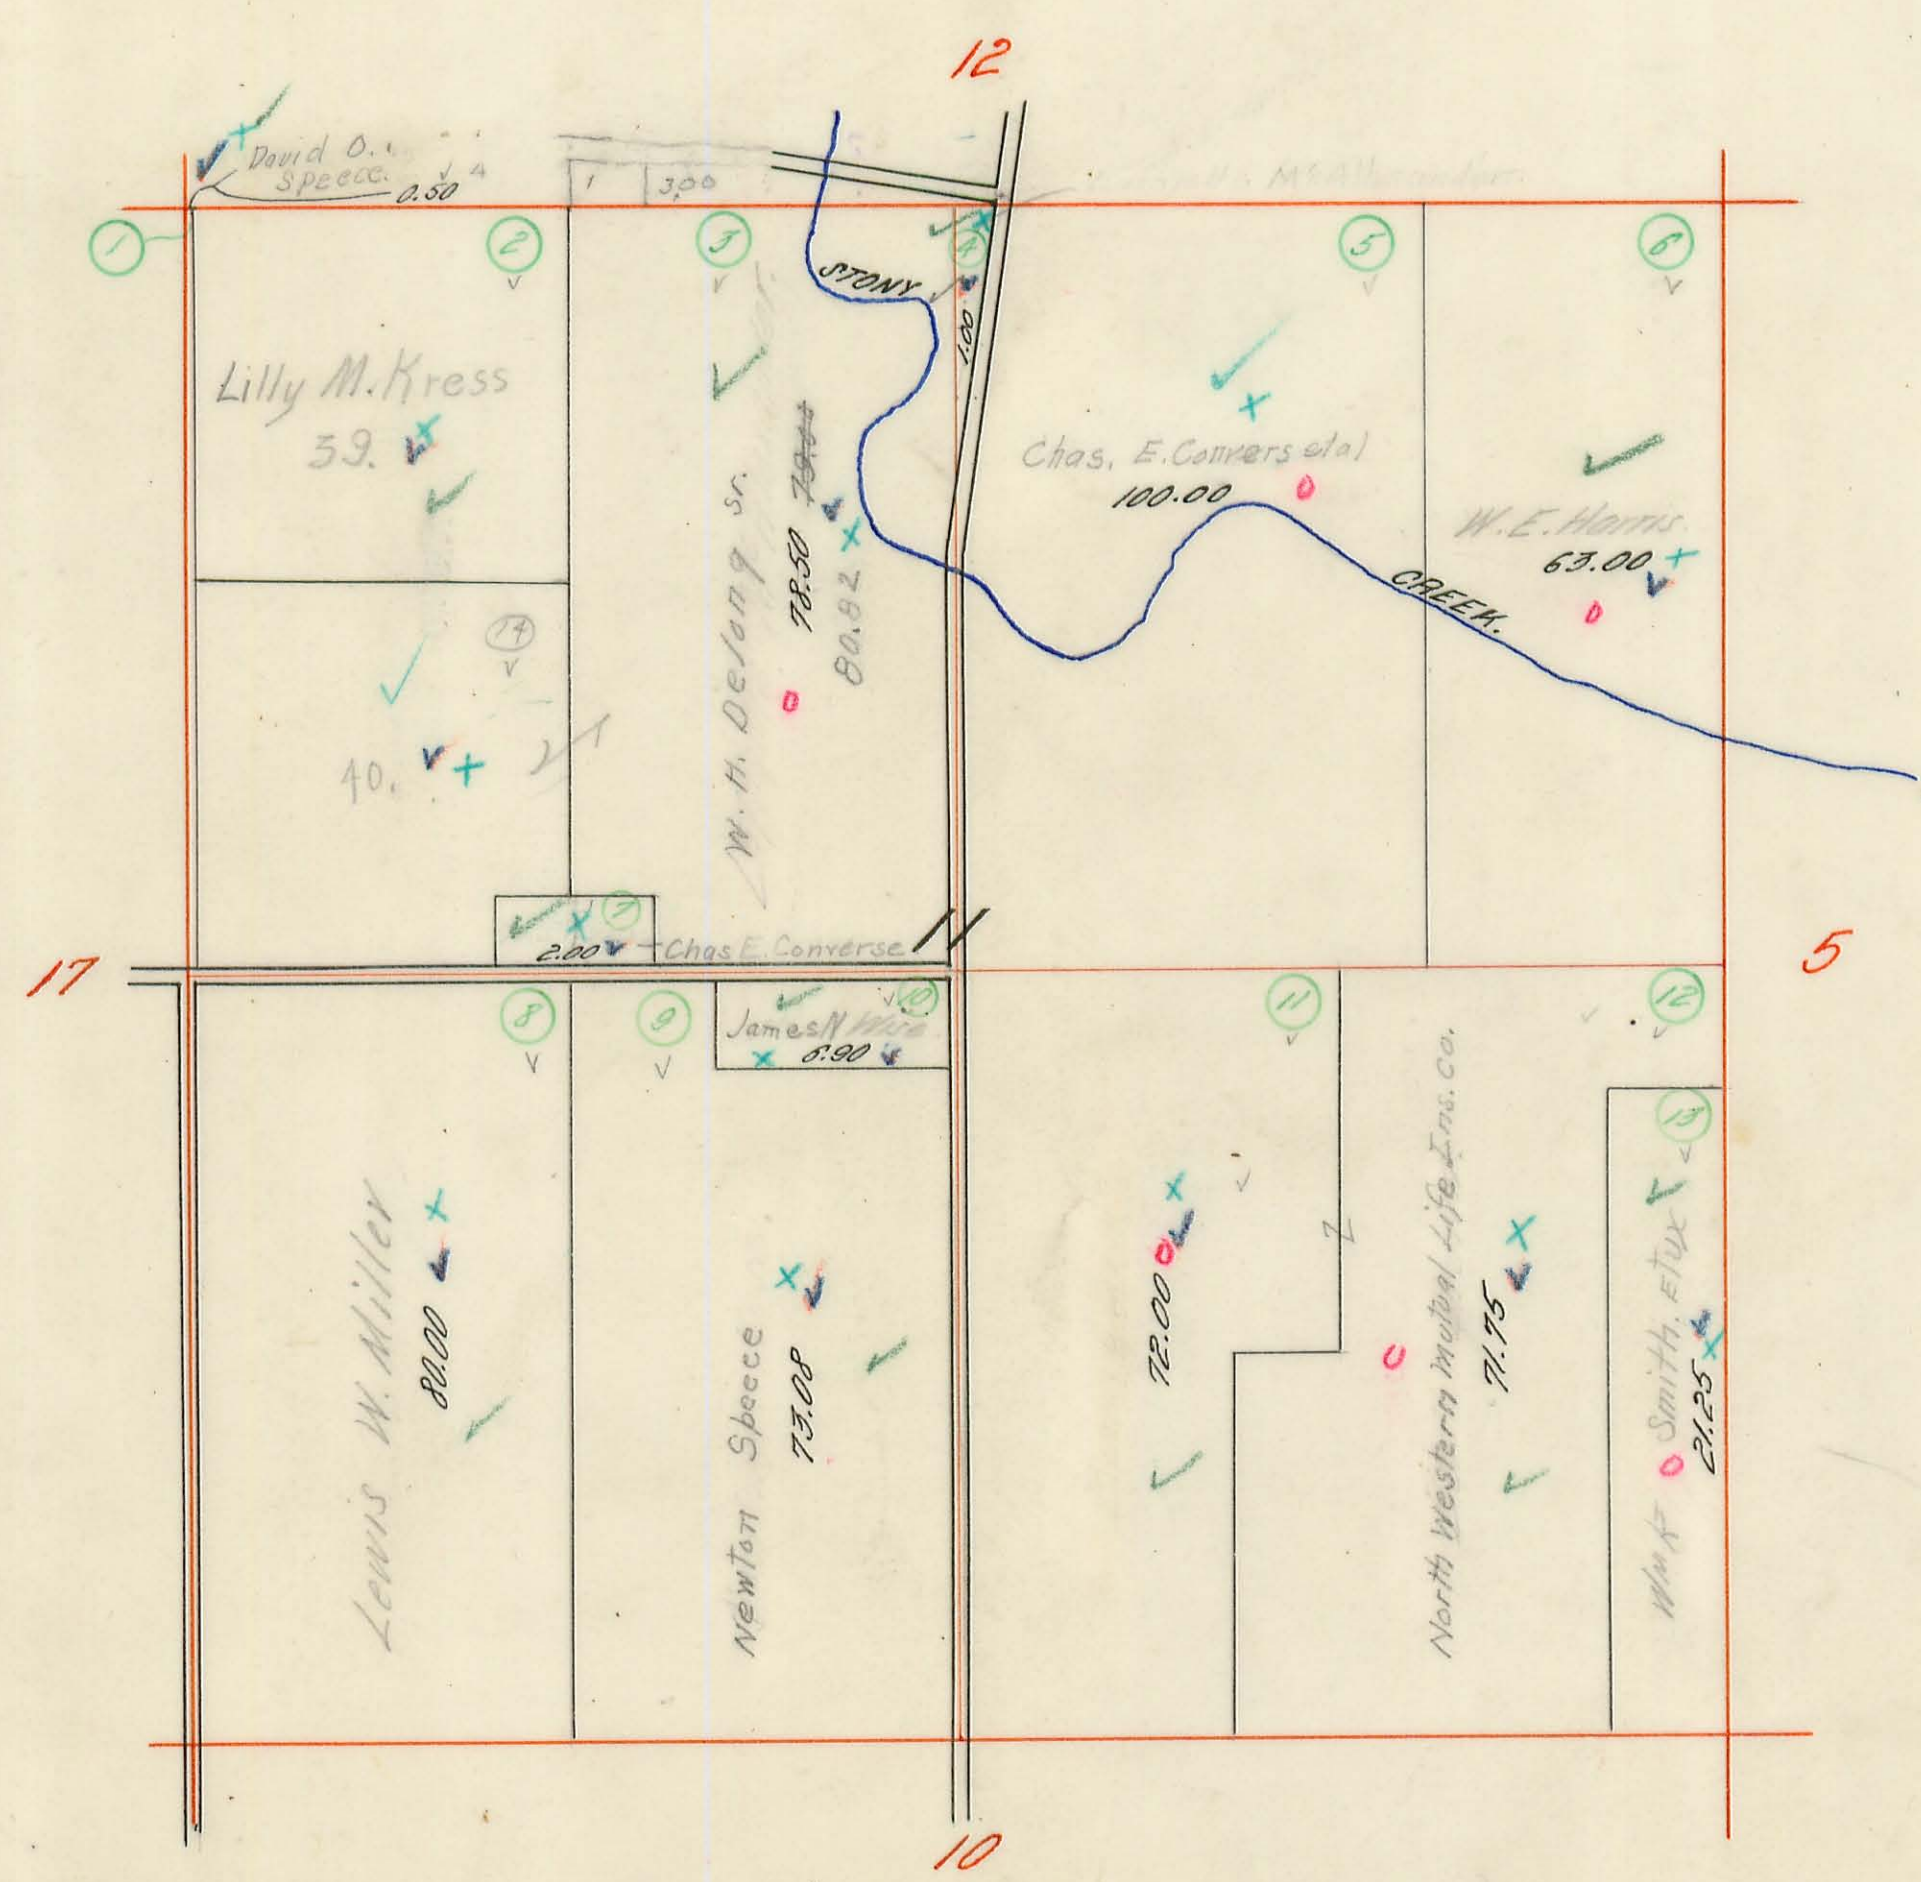




# MIAMI TOWNSHIP.

Plat of Section No. 5 Range No. 13 Town No. 3.

Scale 10 Chains Per Inch.

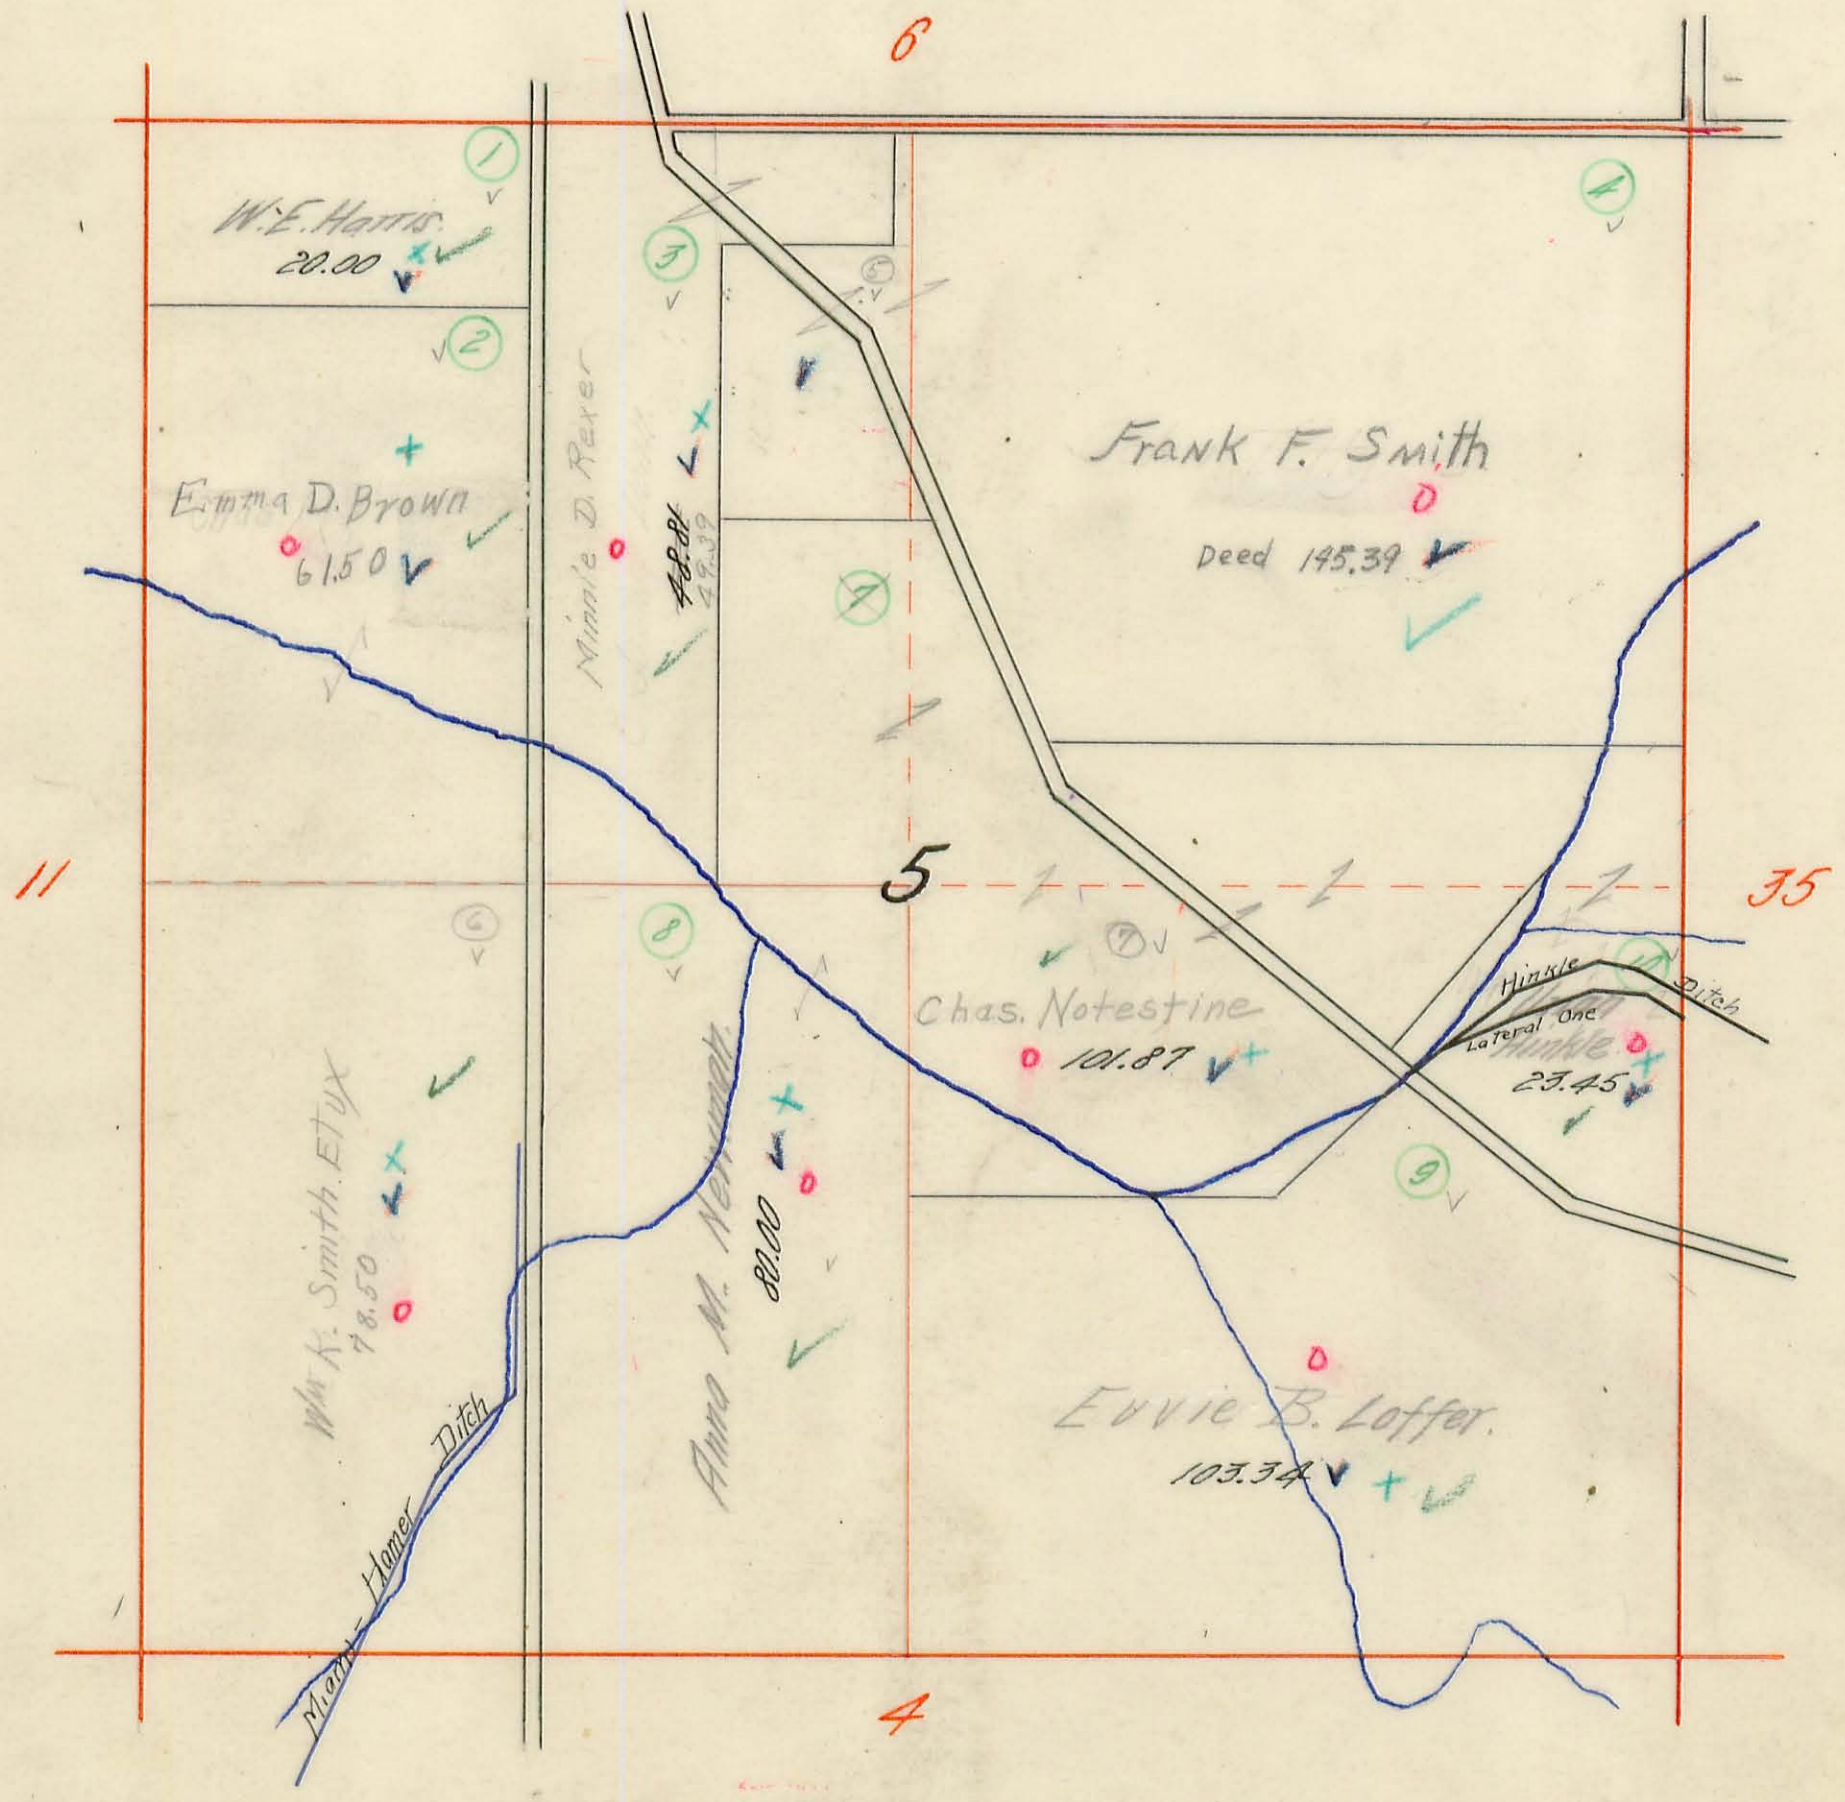




# MIAMI TOWNSHIP.

Plat of Section No. 35 Range No. 13 Town No. 4.

Scale 10 Chains Per Inch.

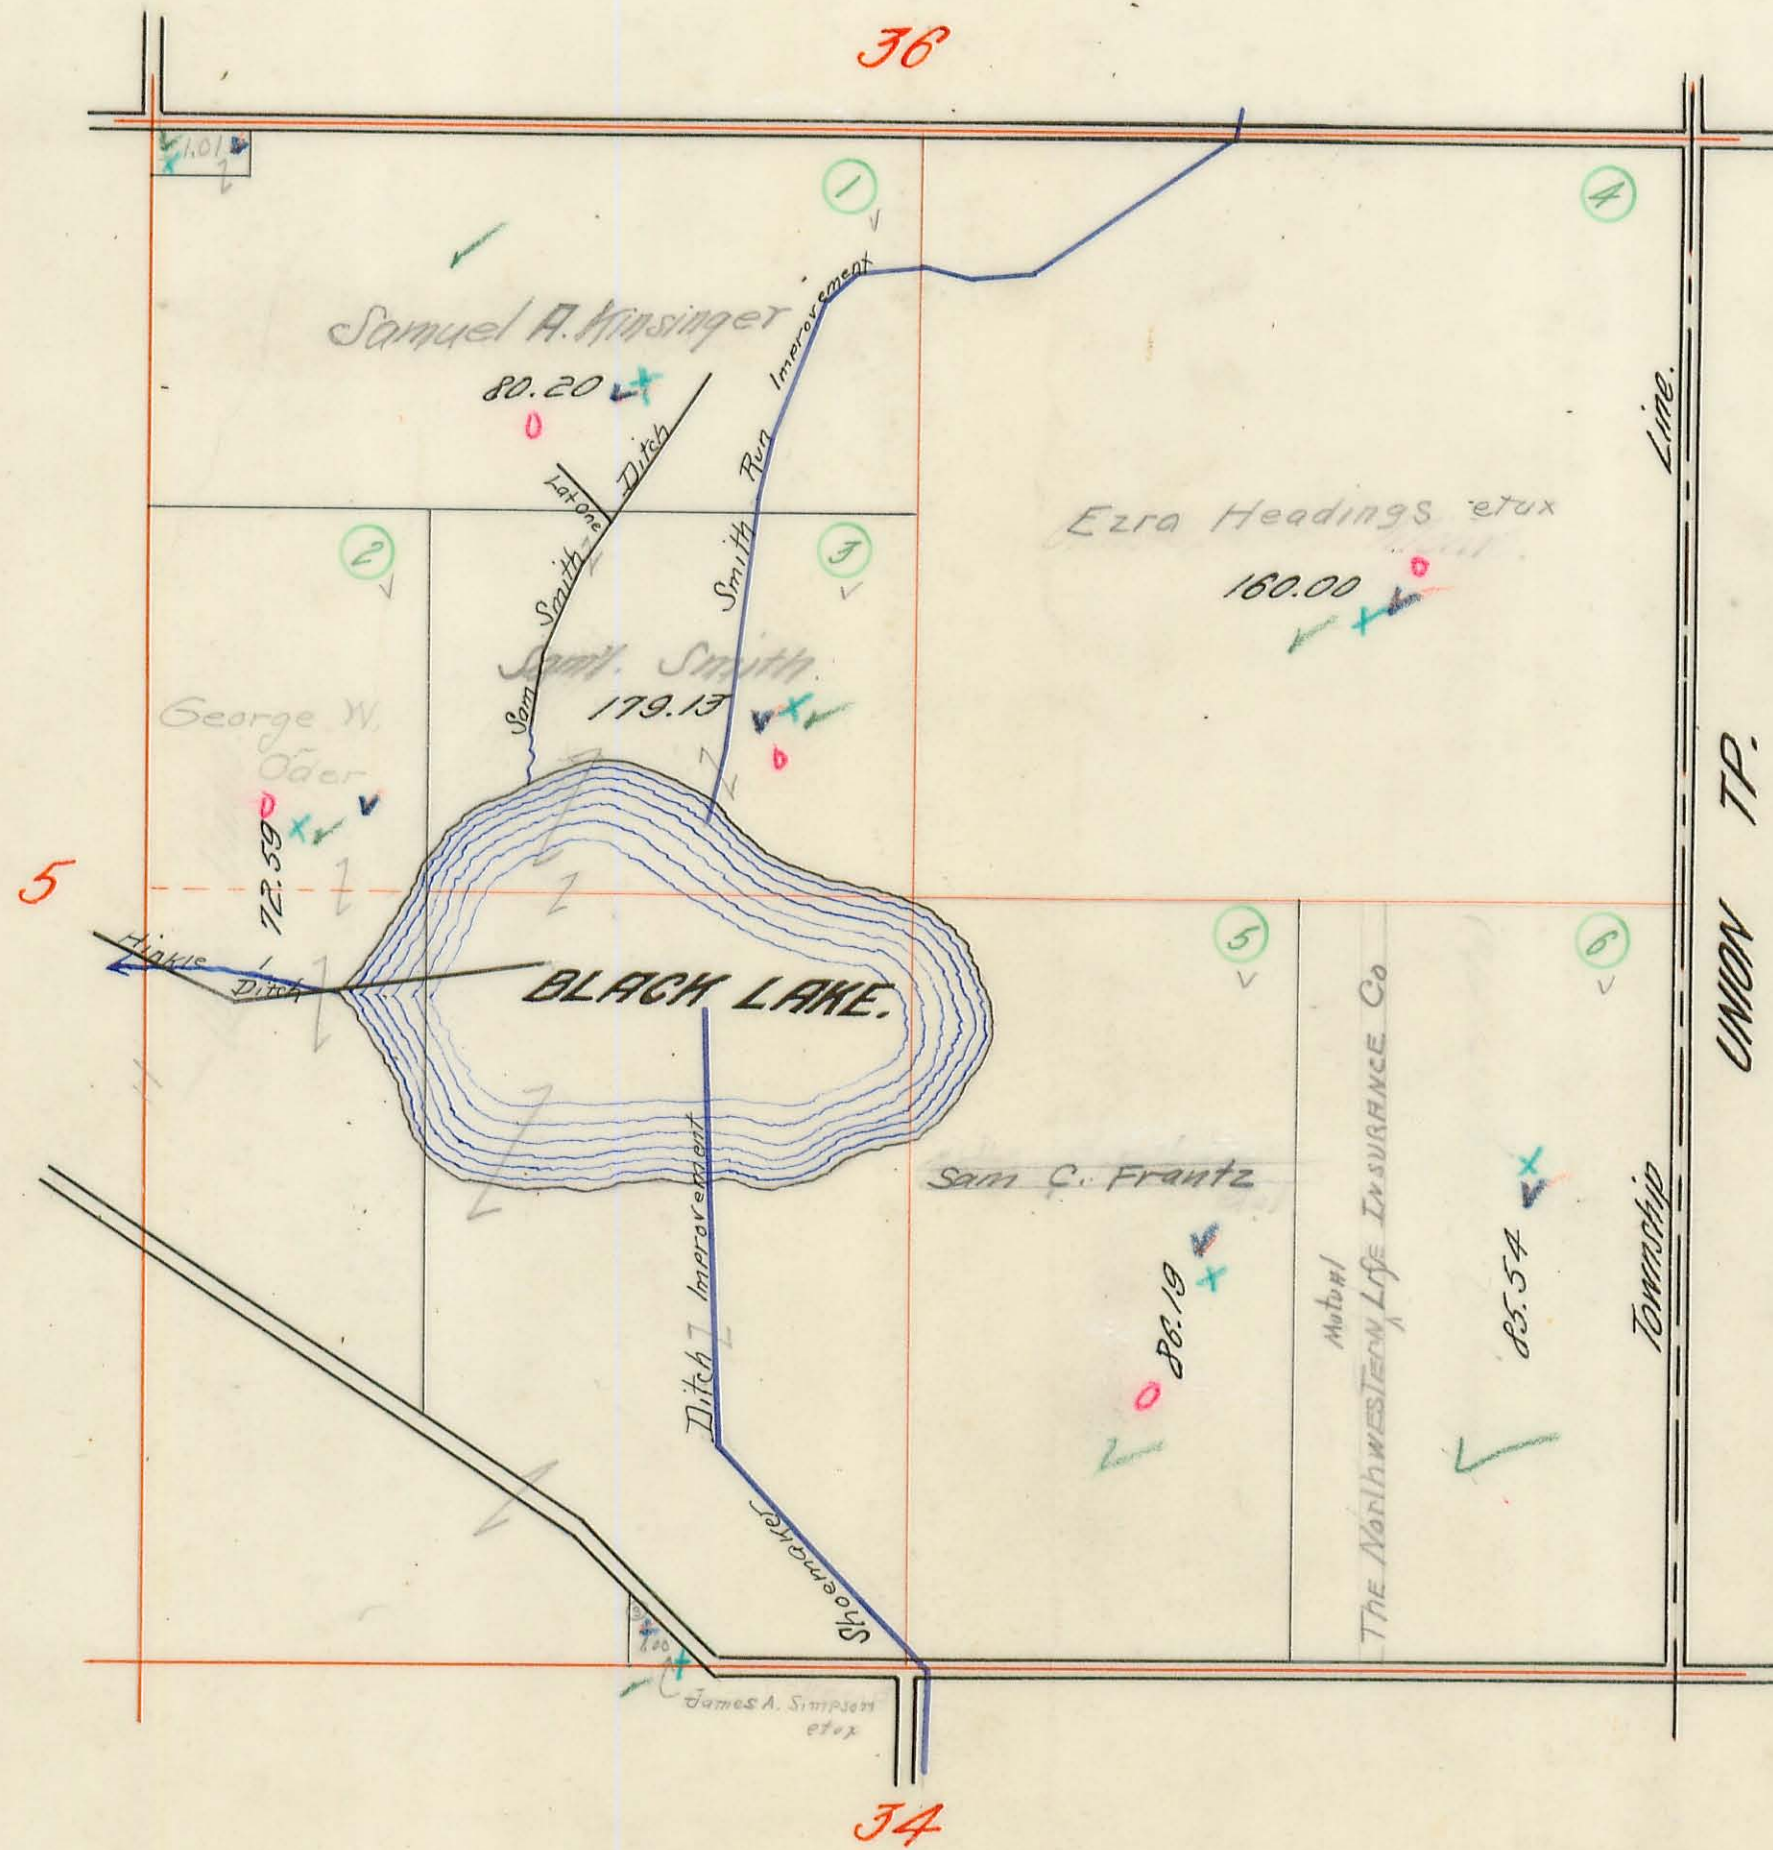




# MIAMI TOWNSHIP.


Scale 10 Chains Per Inch.

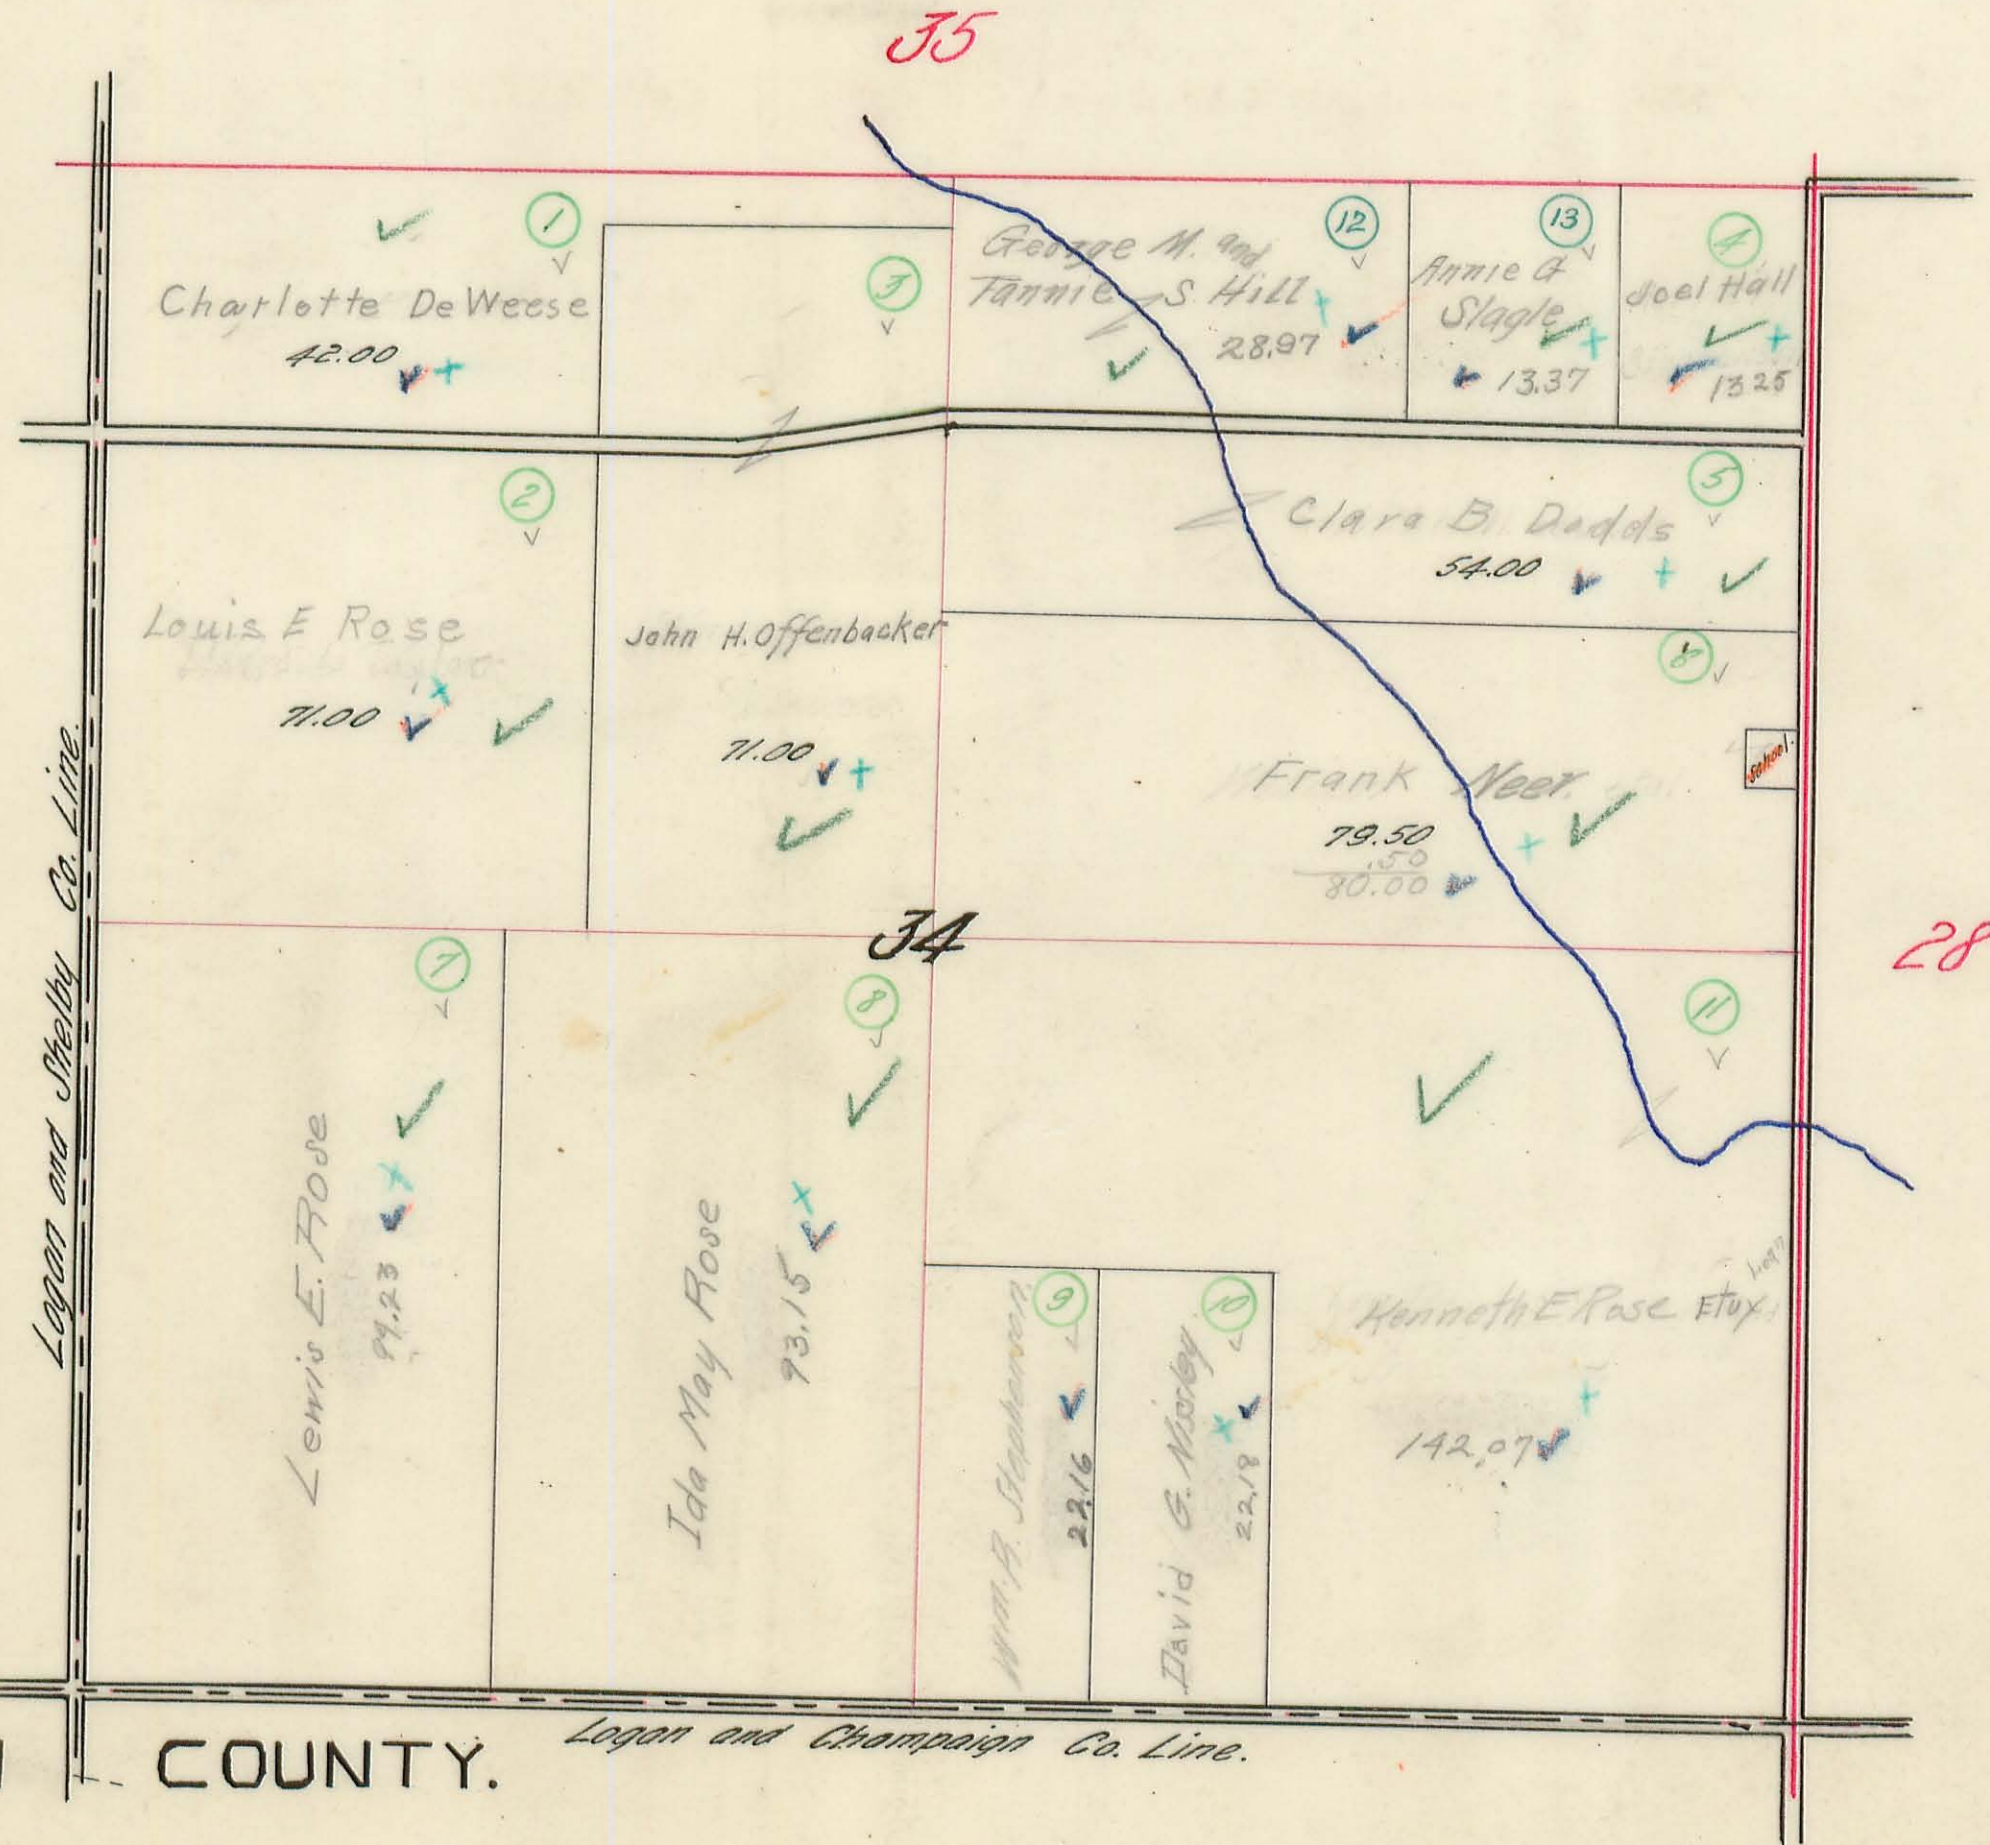

SHELBY COUNTY


CHAMPAIGN COUNTY.



# MIAMI TOWNSHIP.

Plat of Section No. 28 Range No. 13 Town No. 3.

Scale 10 Chains Per Inch.

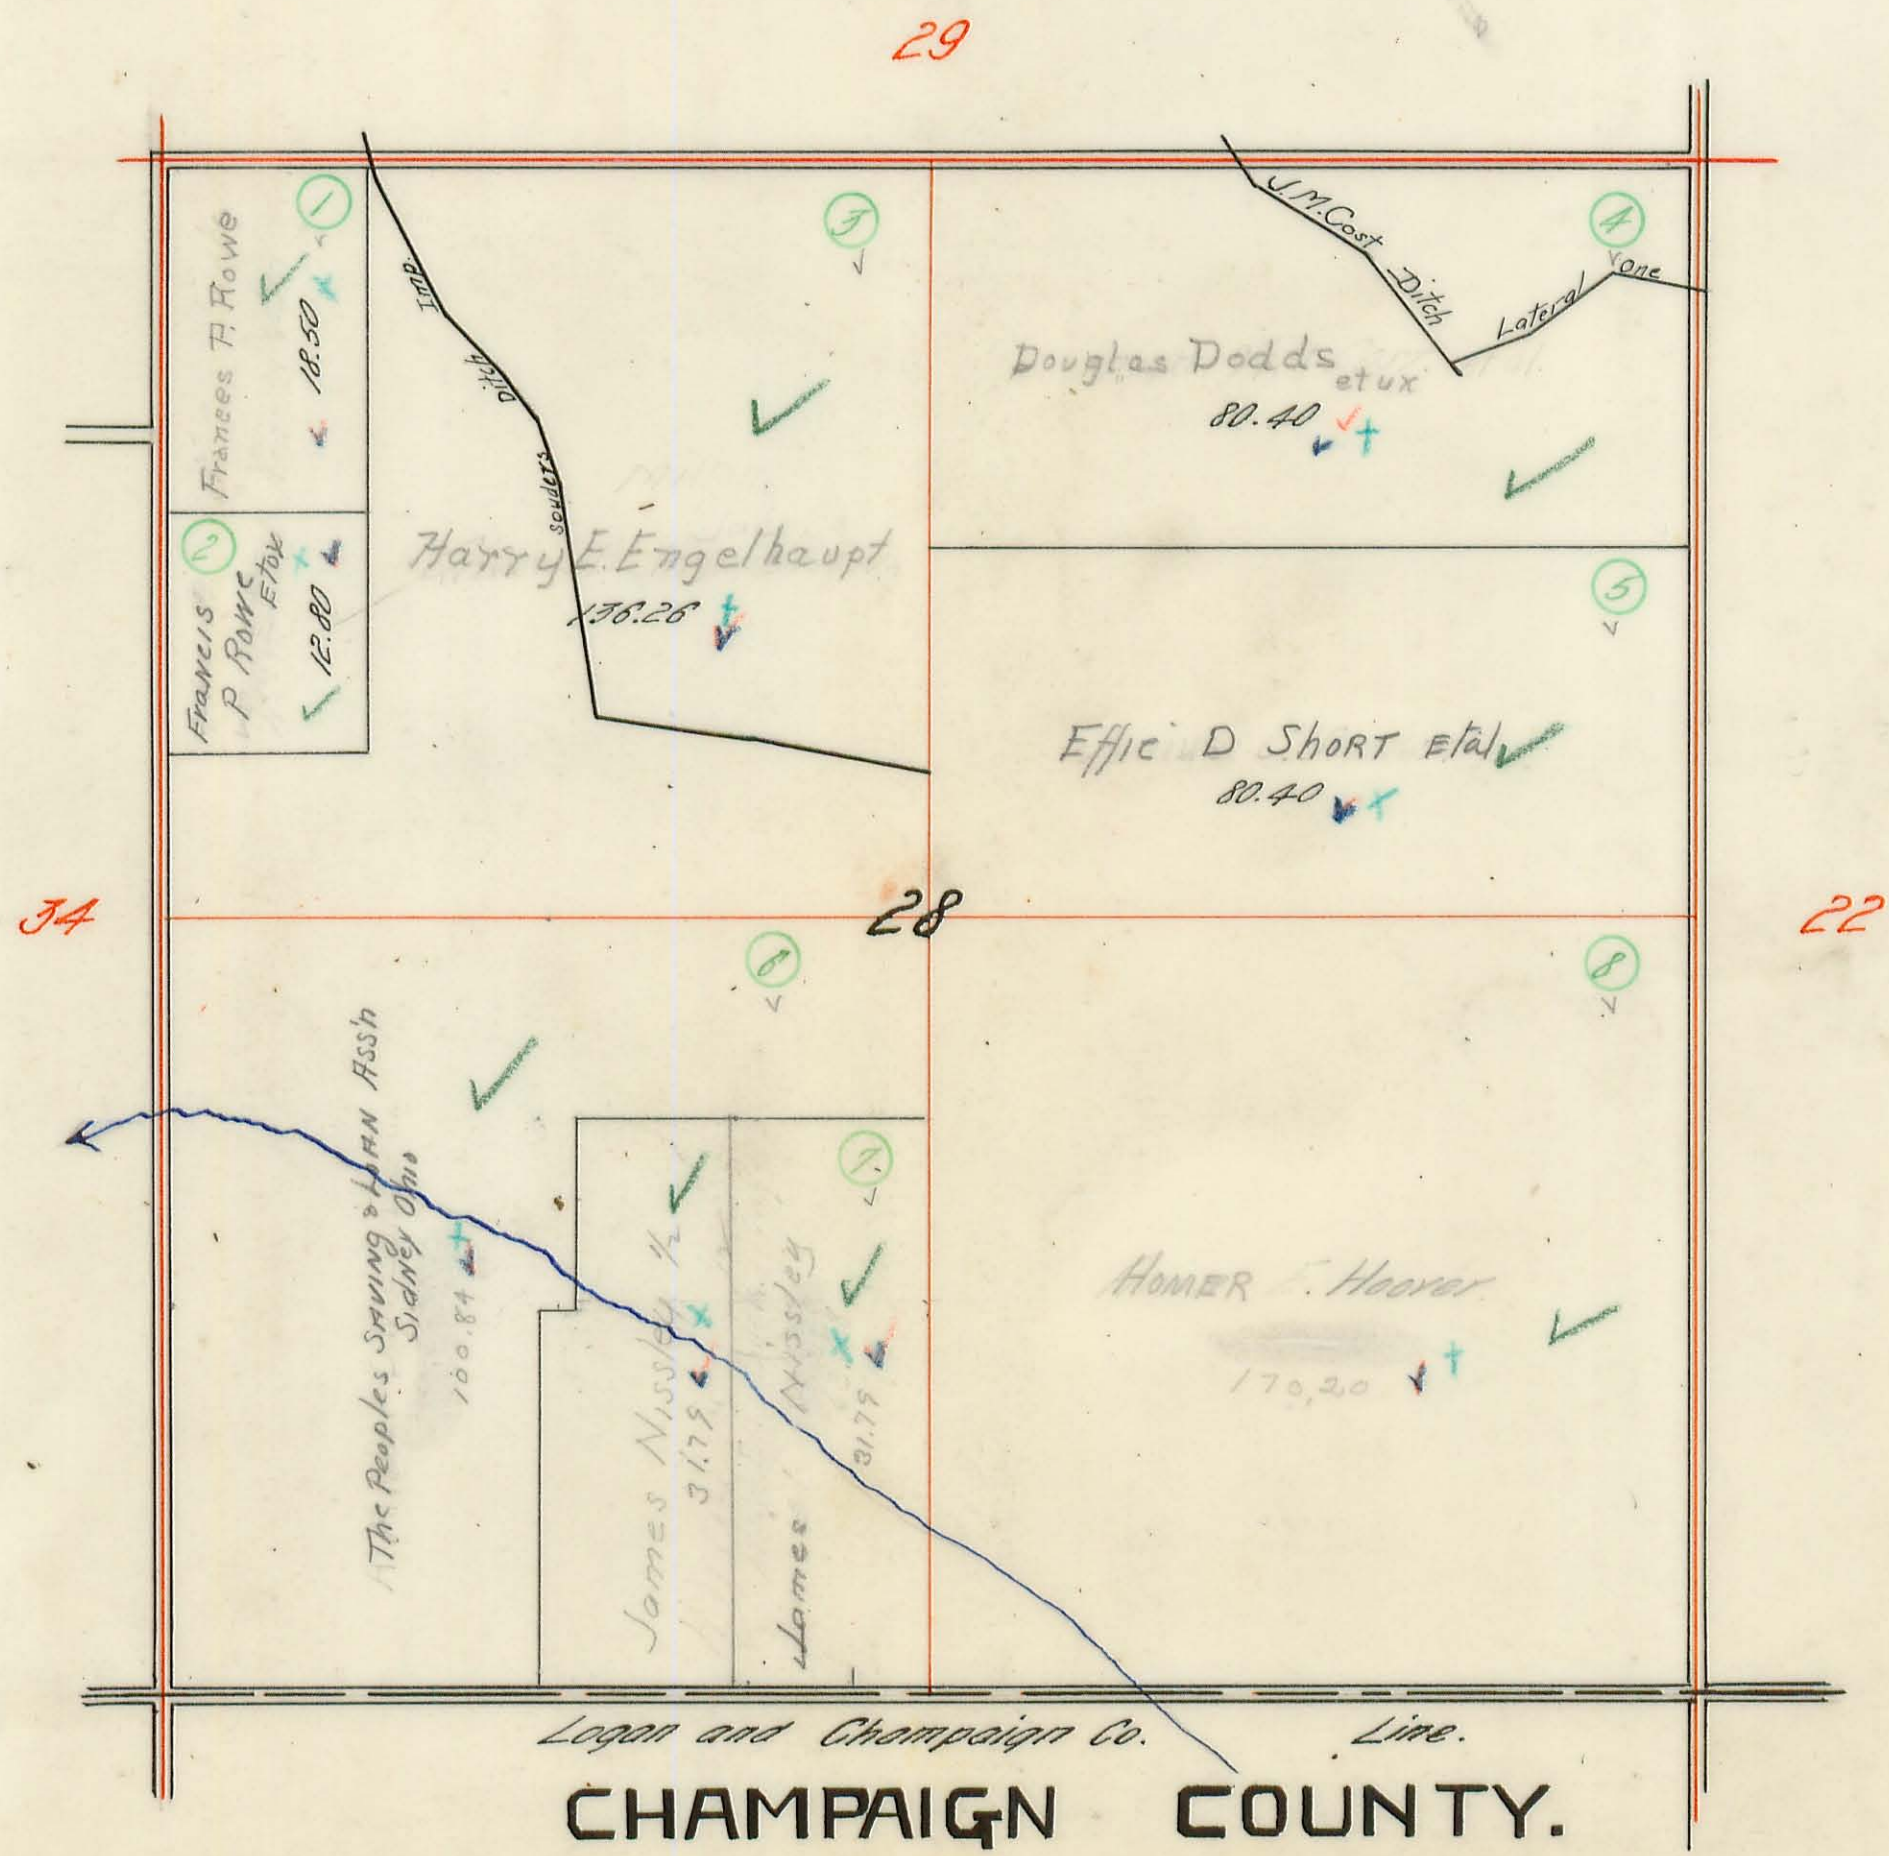


CHAMPAIGN COUNTY.



# MIAMI TOWNSHIP.

Plat of Section No. 22 Range No. 13 Town No. 3.

Scale 10 Chains Per Inch.

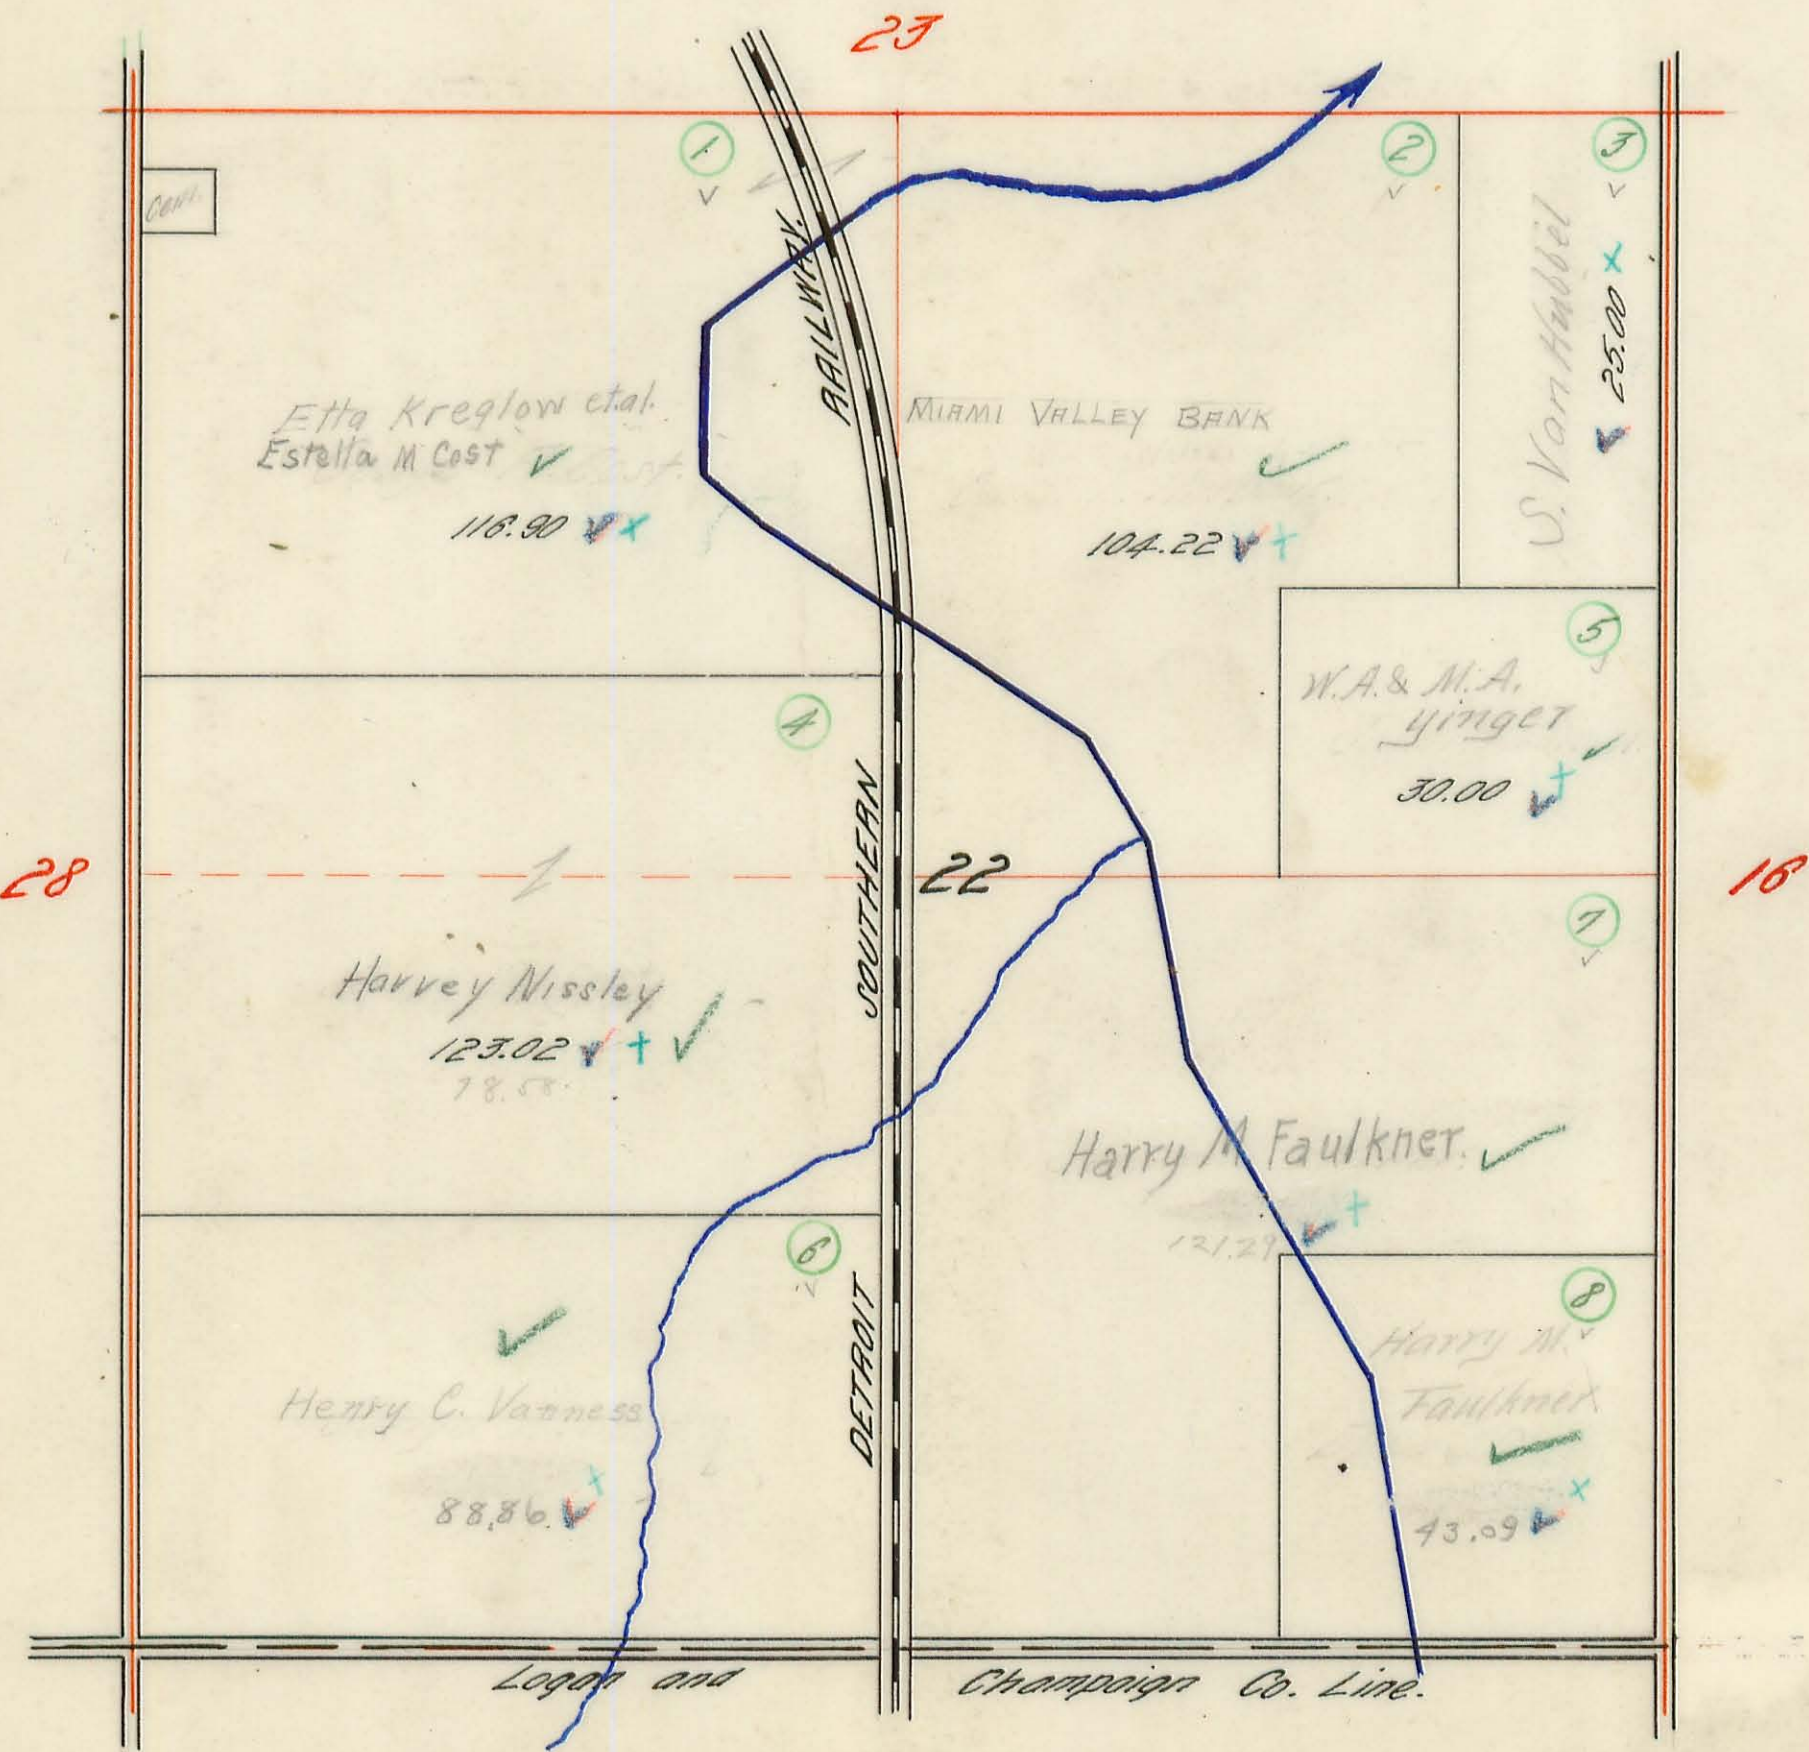

## CHAMPAIGN COUNTY.



# MIAMI TOWNSHIP.

Plat of Section No. 16 Range No. 13 Town No. 3.

Scale 10 Chains Per Inch.




## CHAMPAIGN COUNTY.



# MIAMI TOWNSHIP.

Plat of Section No. 10 Range No. 17 Town No. 3.

Scale 10 Chains Per Inch.

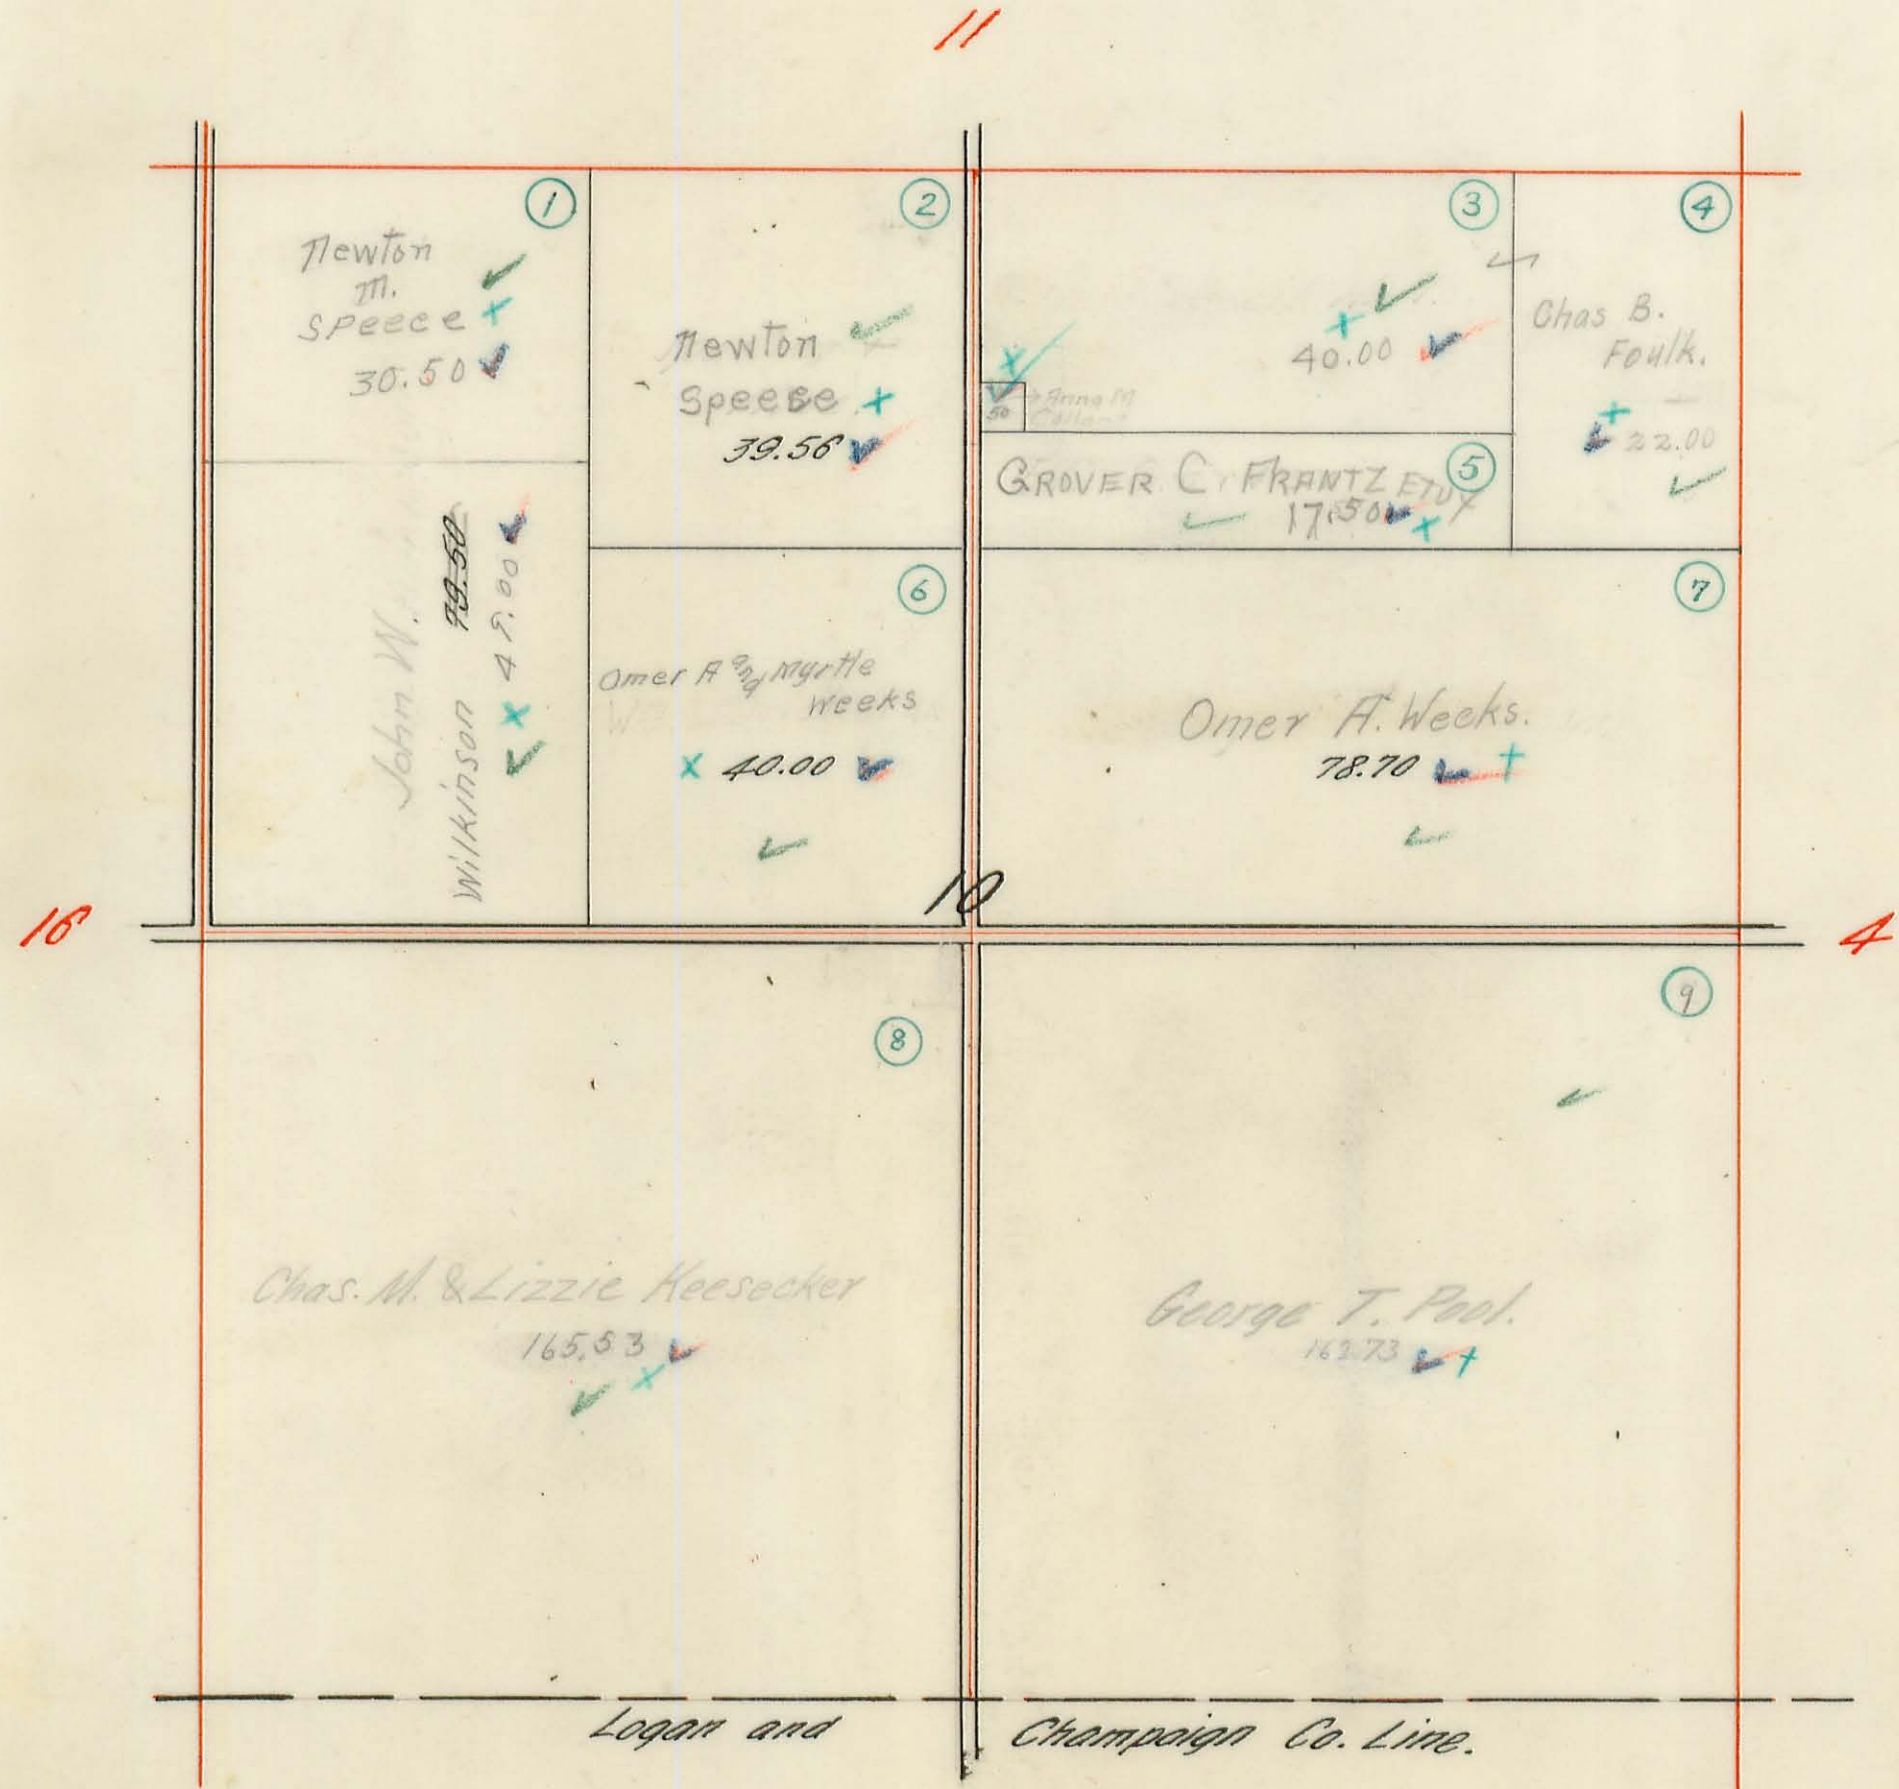


## CHAMPAIGN COUNTY.



# MIAMI TOWNSHIP.

Plat of Section No. 4 Range No. 13 Town No. 3.

Scale 10 Chains Per Inch.

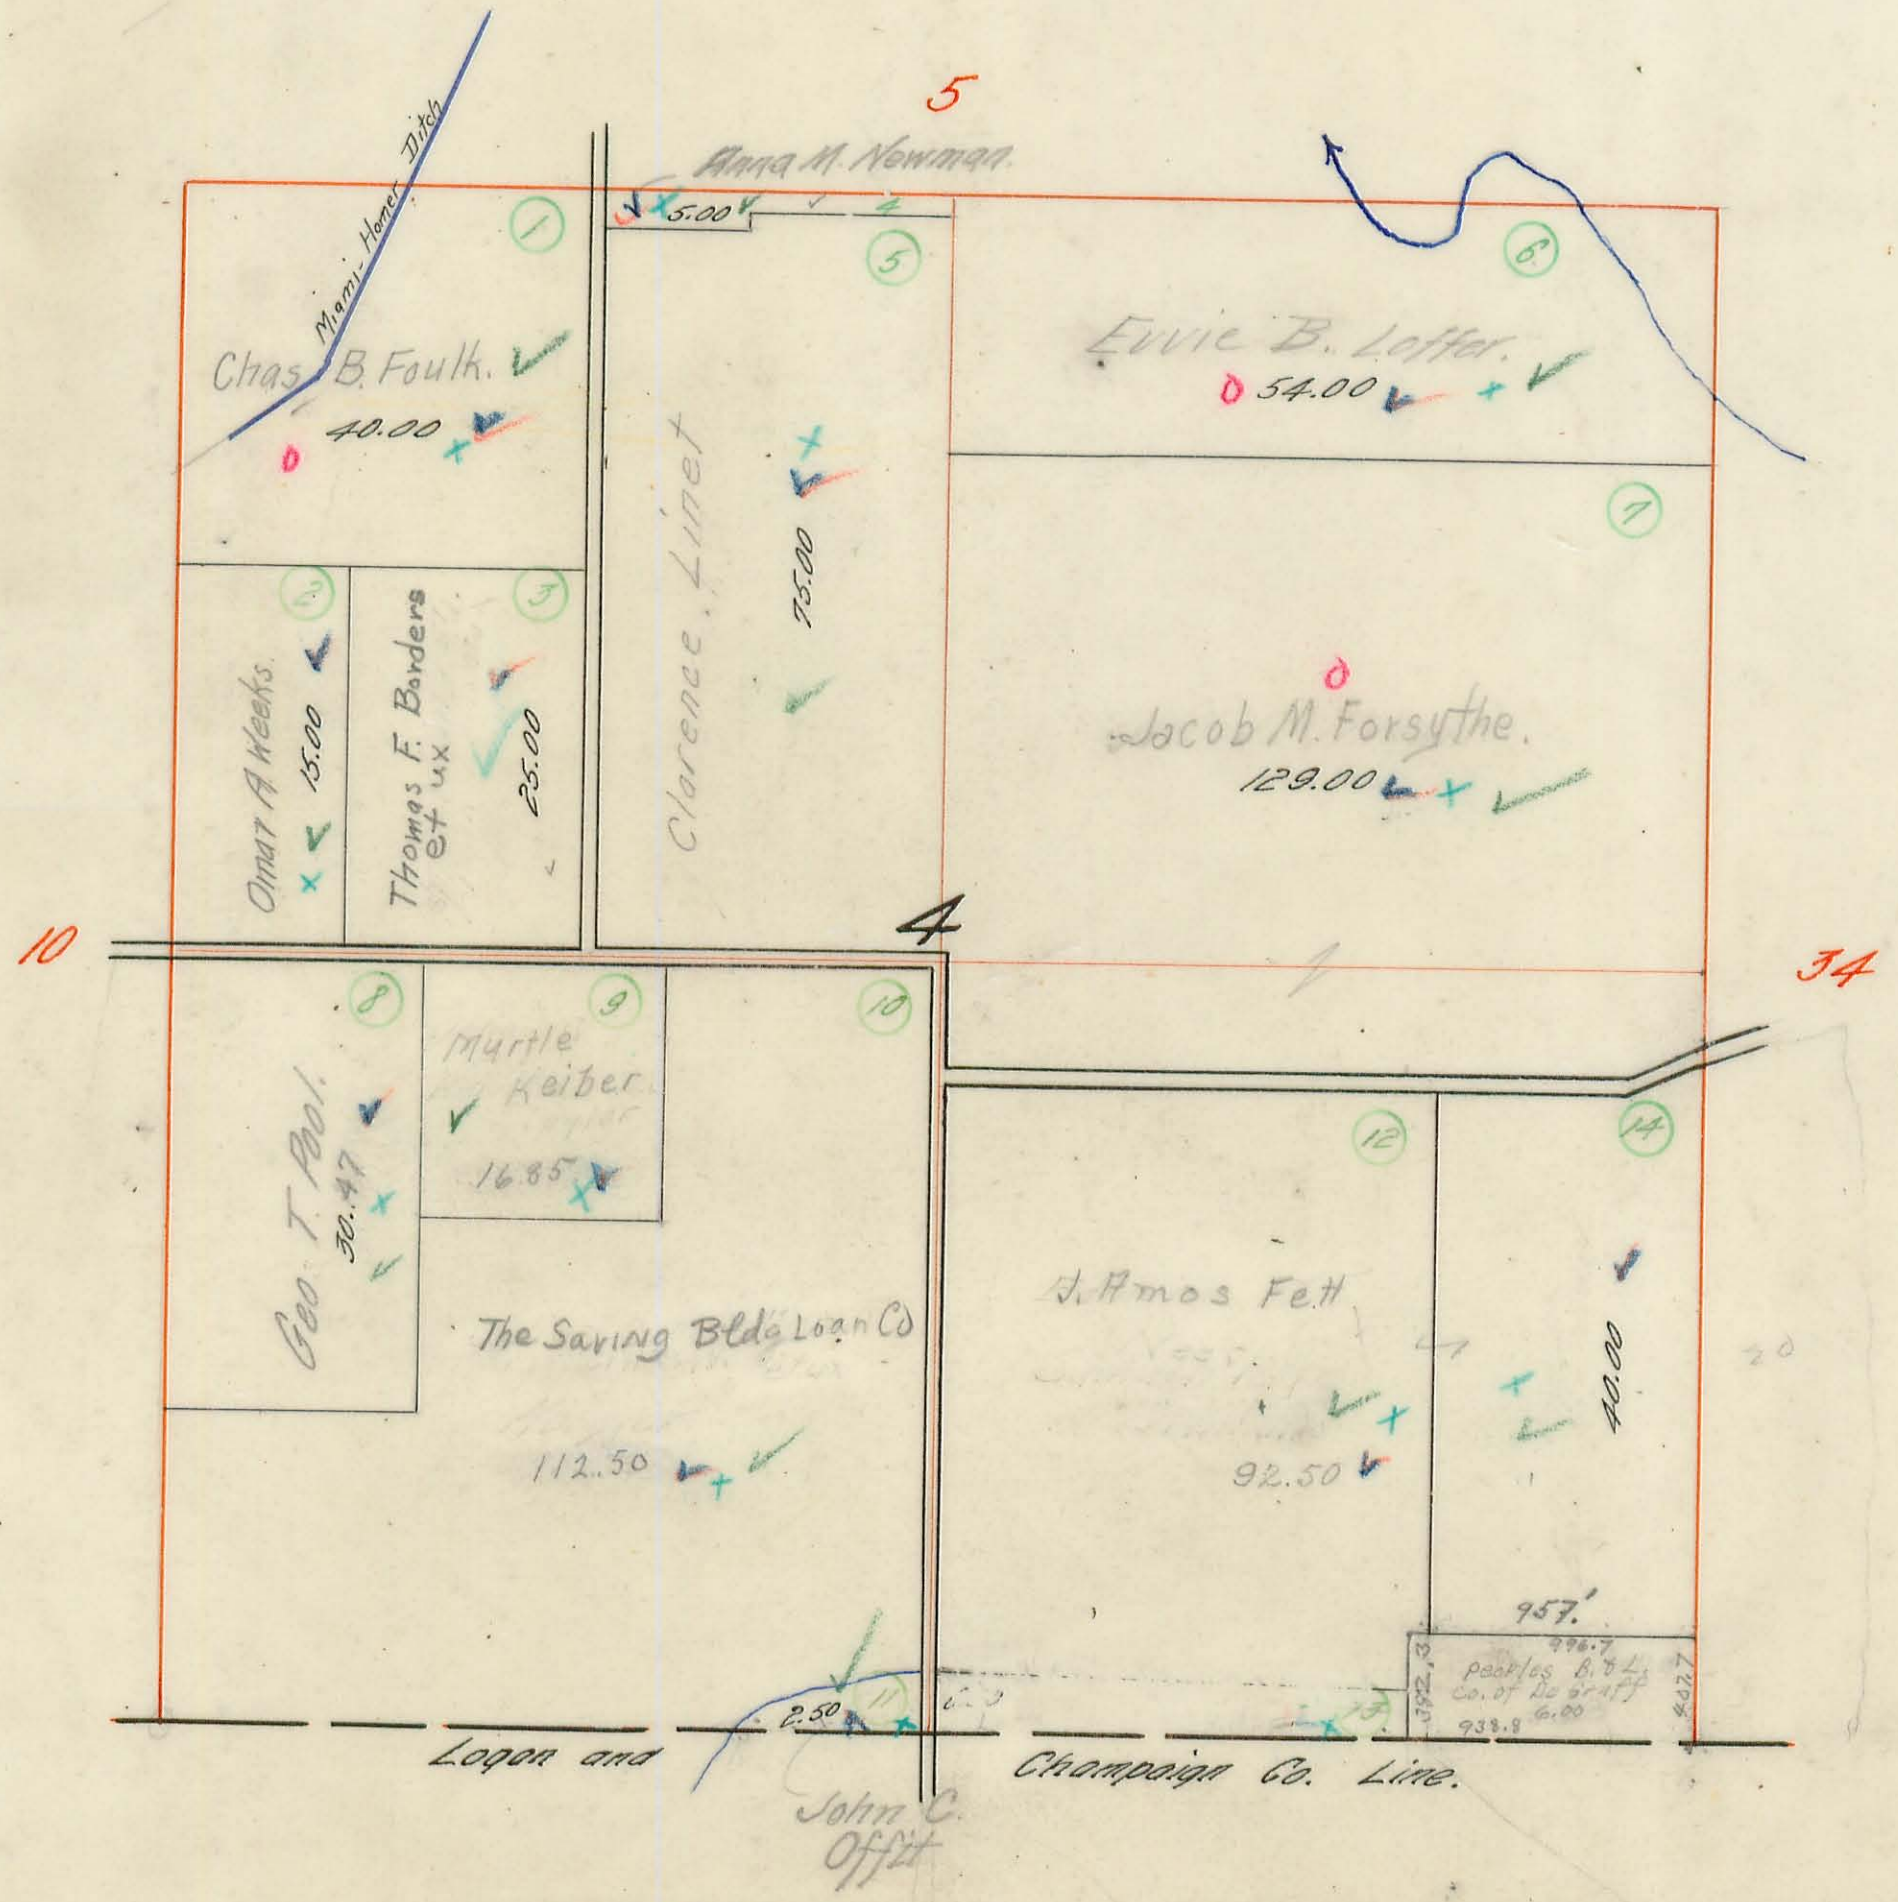


## CHAMPAIGN COUNTY.



# MIAMI TOWNSHIP.

Plat of Section No. 34 Range No. 13 Town No. 4.

Scale 10 Chains Per Inch.

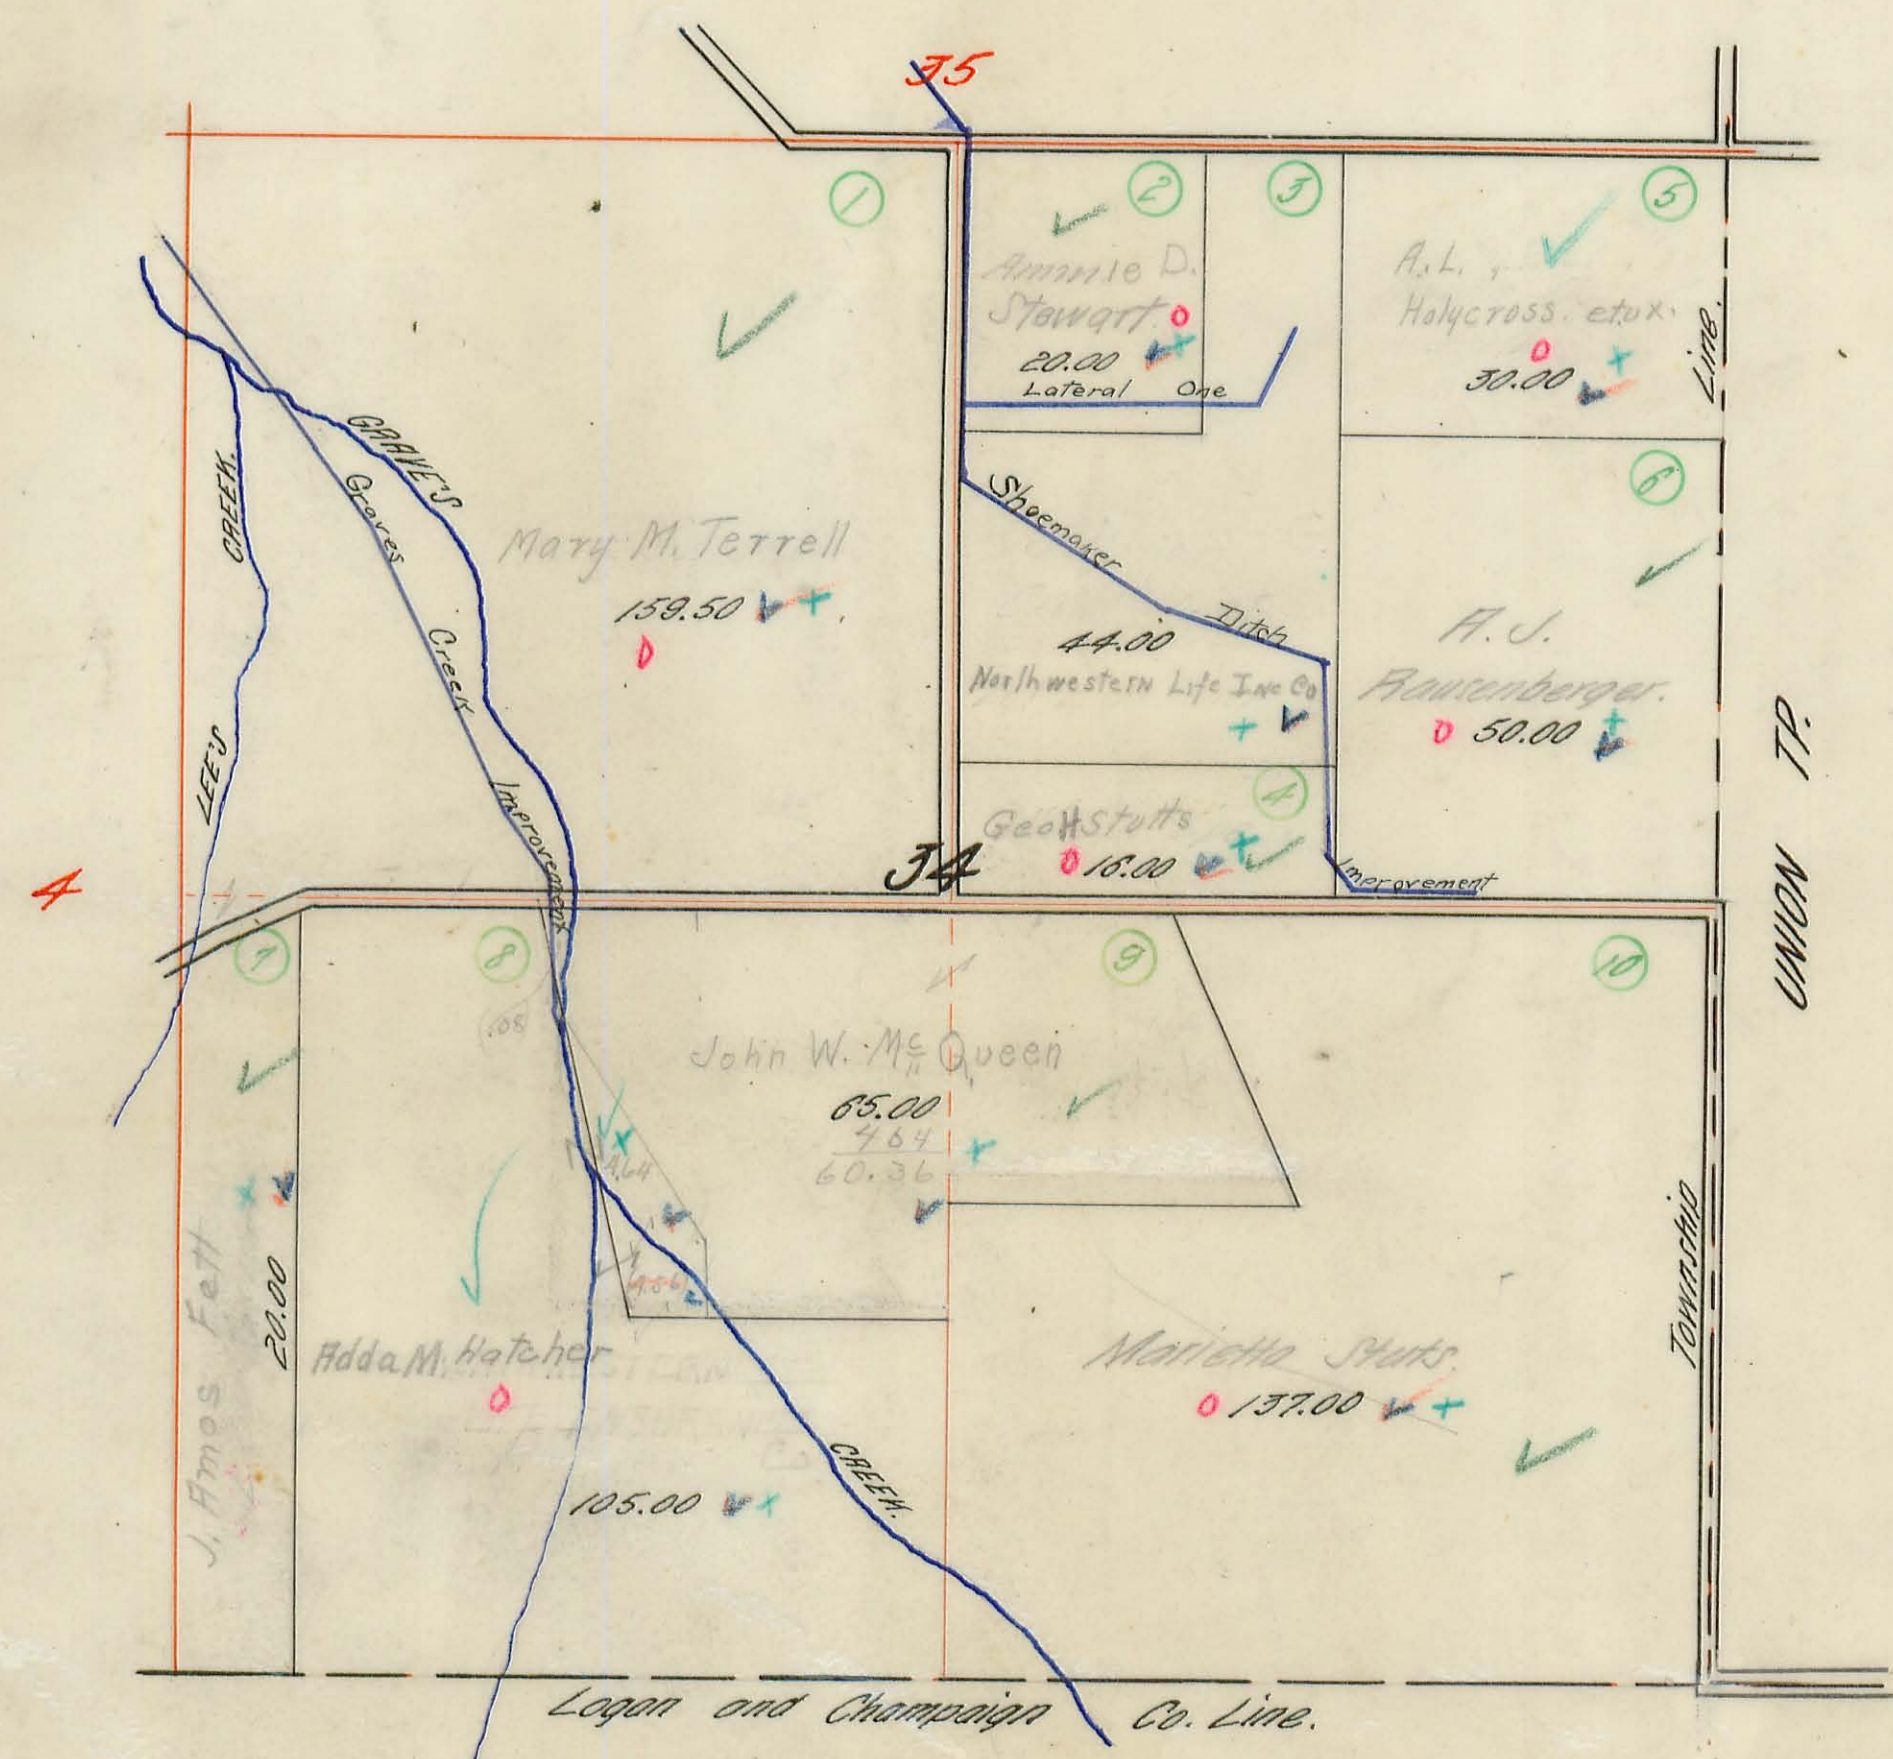

## CHAMPAIGN COUNTY.




# MIAMI TOWNSHIP.

## DE GRAFF.

### N. PART.

Scale: 225 feet = 1 inch.

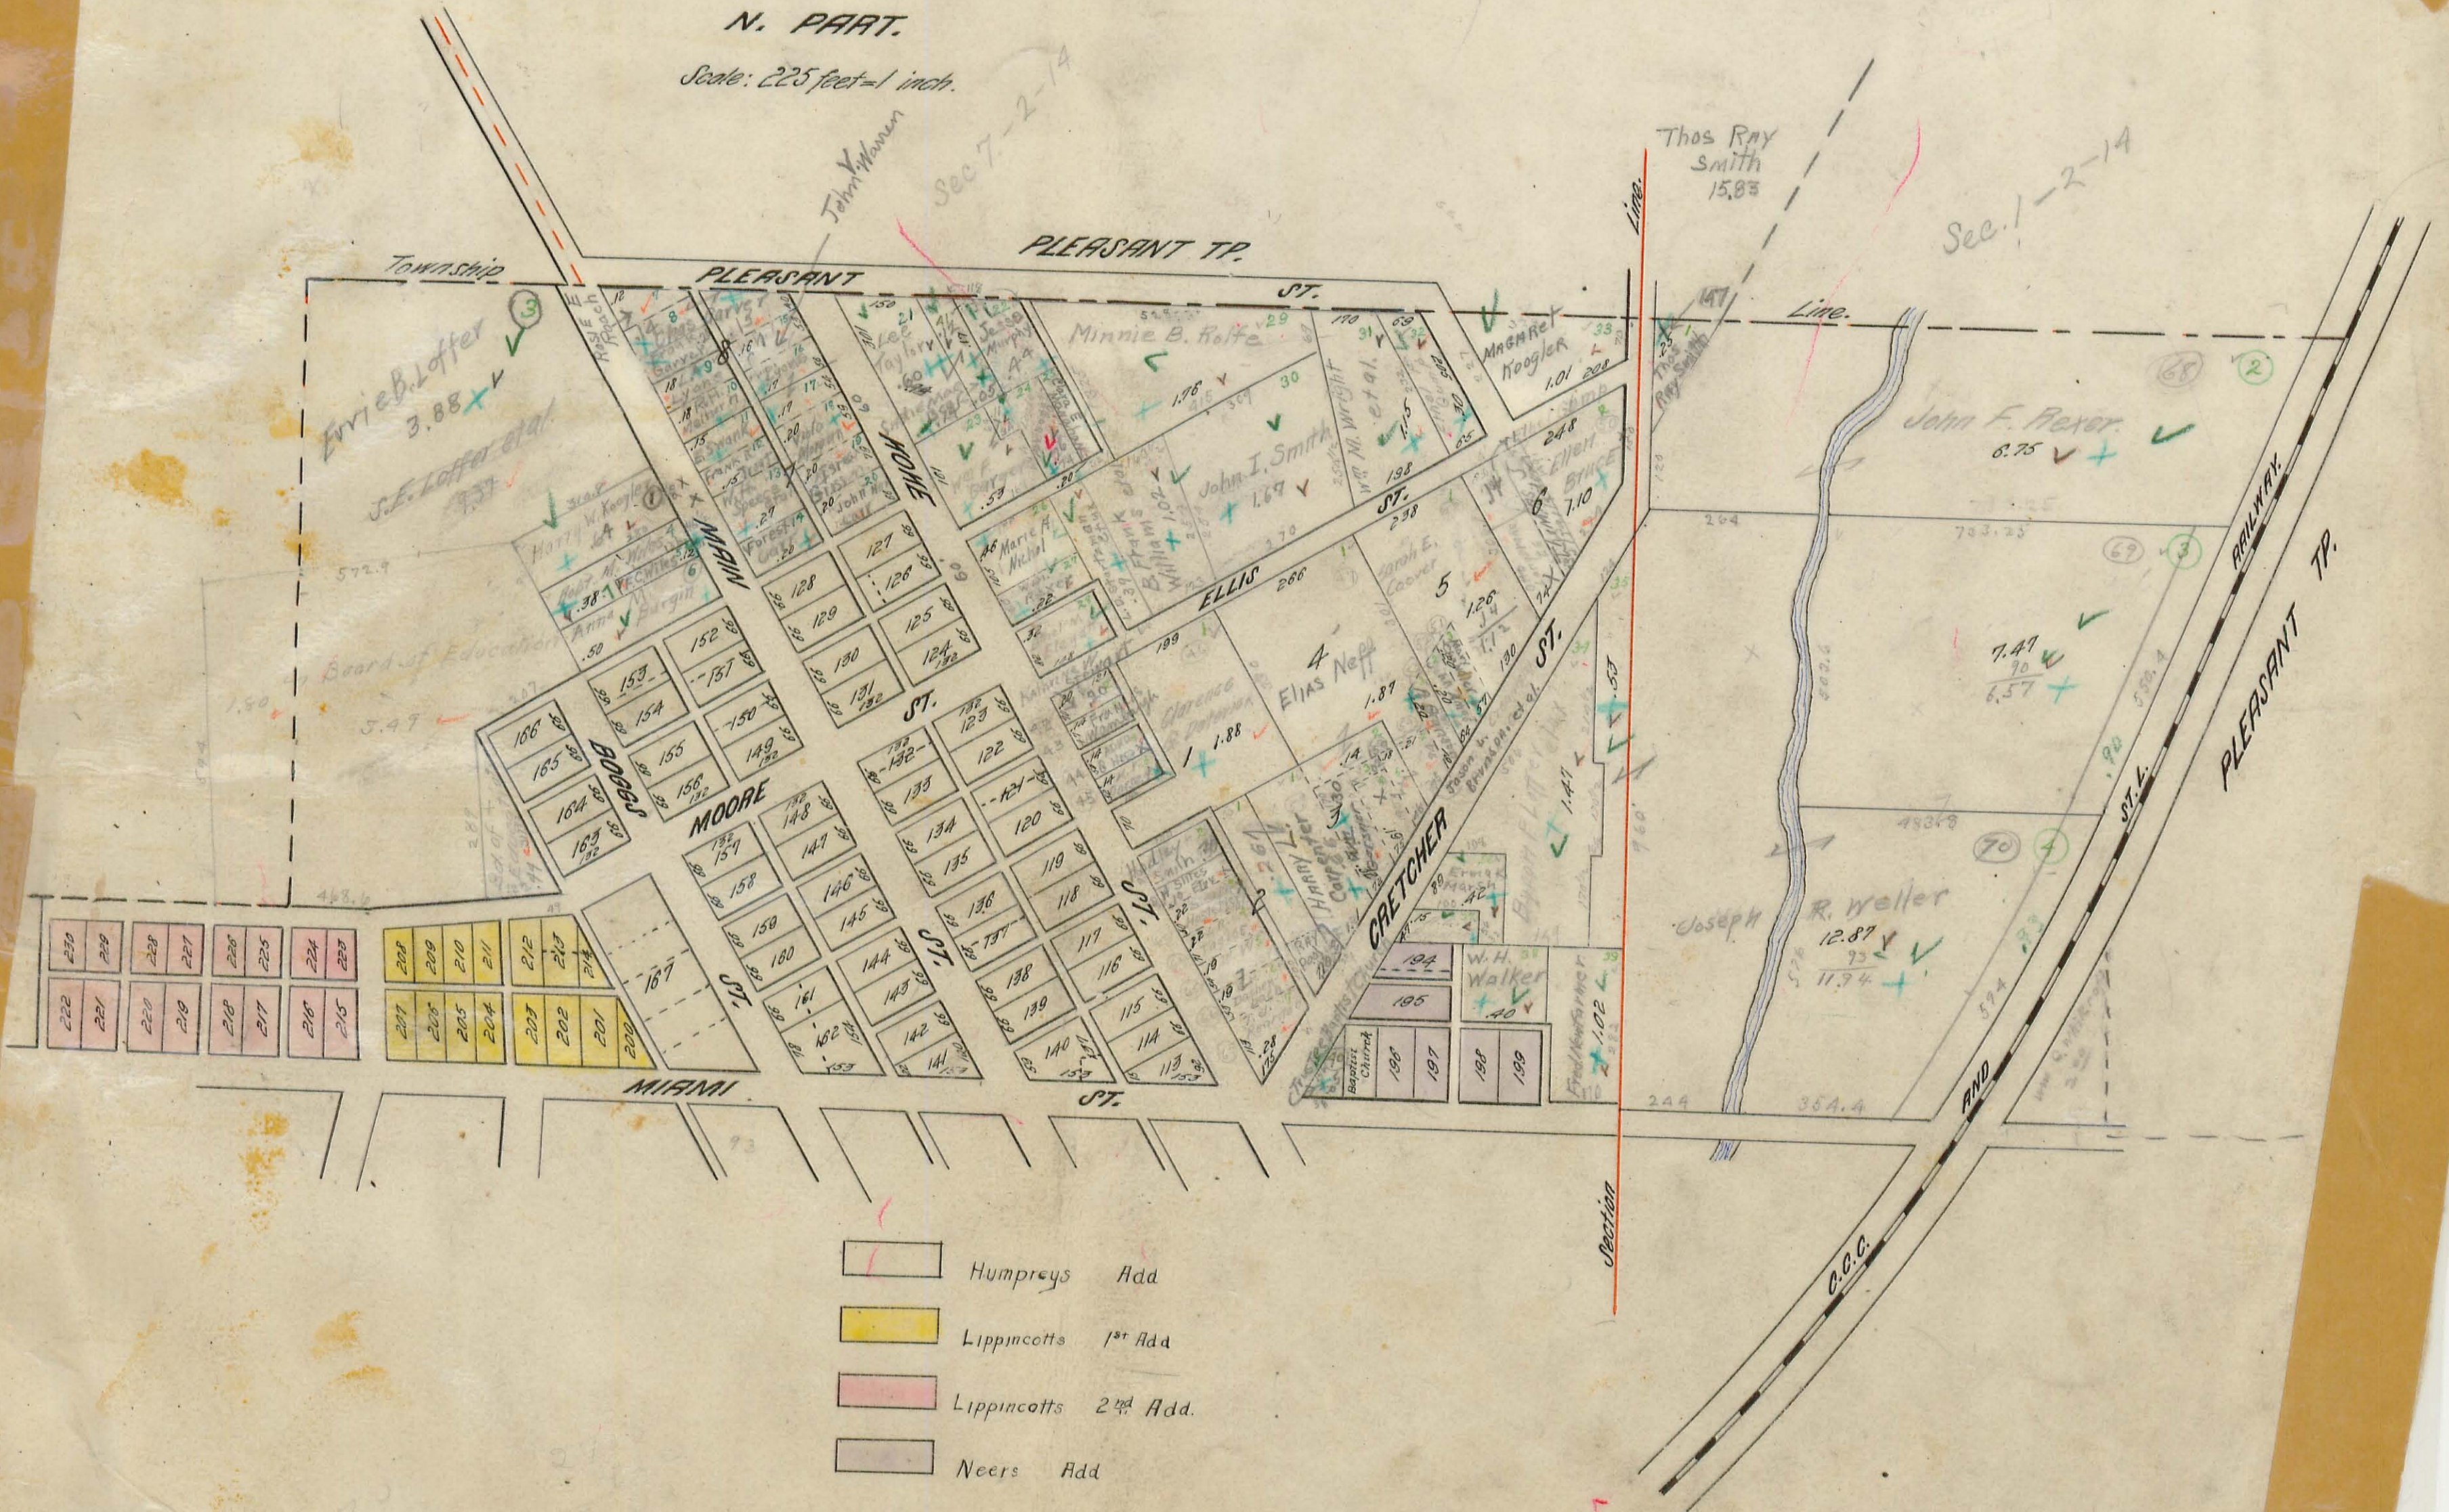

- Humpreys Add
- Lippincotts 1<sup>st</sup> Add
- Lippincotts 2<sup>nd</sup> Add.
- Neers Add



# MIAMI TOWNSHIP.



**DE GRAFF.**

**S. W. PART.**

Scale: 225 feet = 1 inch.

- Melhorns Add.
- Boggs Add.

$$\begin{array}{r} 3.25 \\ 2.25 \\ \hline 6.00 \end{array}$$

$$\begin{array}{r} 5.50 \\ 2.25 \\ \hline 3.25 \end{array}$$

C.C.C. AND ST. L. RY.  
 W.E. Harris  
 18.35  
 13.33  
 2.00  
 1.32  
 1.45  
 2.00  
 4.02







# MIAMI TOWNSHIP.

## QUINCY.

### N. PART.

Scale: 300 feet = 1 inch.

30  
29  
23  
24 } 3-13



- Original Plat
- Blackleys Add.
- Baldwins Add.
- Chambers Western Add.
- Canby's Northern Add.
- Add to Westerns. Add.
- Harrimans Northern Add.
- Costs Add.

Caroline Houlihan.  
28.55  
25 to Ry.  
35.00  
2.77  
31.09 +

Oliver C. Dovel et al. 5.00  
Anna U. Robinson 19.00 +

Chas. S. Davis et al. 10.65  
+ 10.51

B.G. Allinger 7.00  
+ 6.75

Chas. Webb 12.90  
+ 12.90

Jantha. Clark 4.00  
+ 4.00

Anna U. Robinson 42.08

Oram Snapp 5.21

Section 29

Section 30

# MIAMI TOWNSHIP.

## QUINCY.

S. PART.

Scale: 300 feet = 1 inch.

Highest Sub  
87

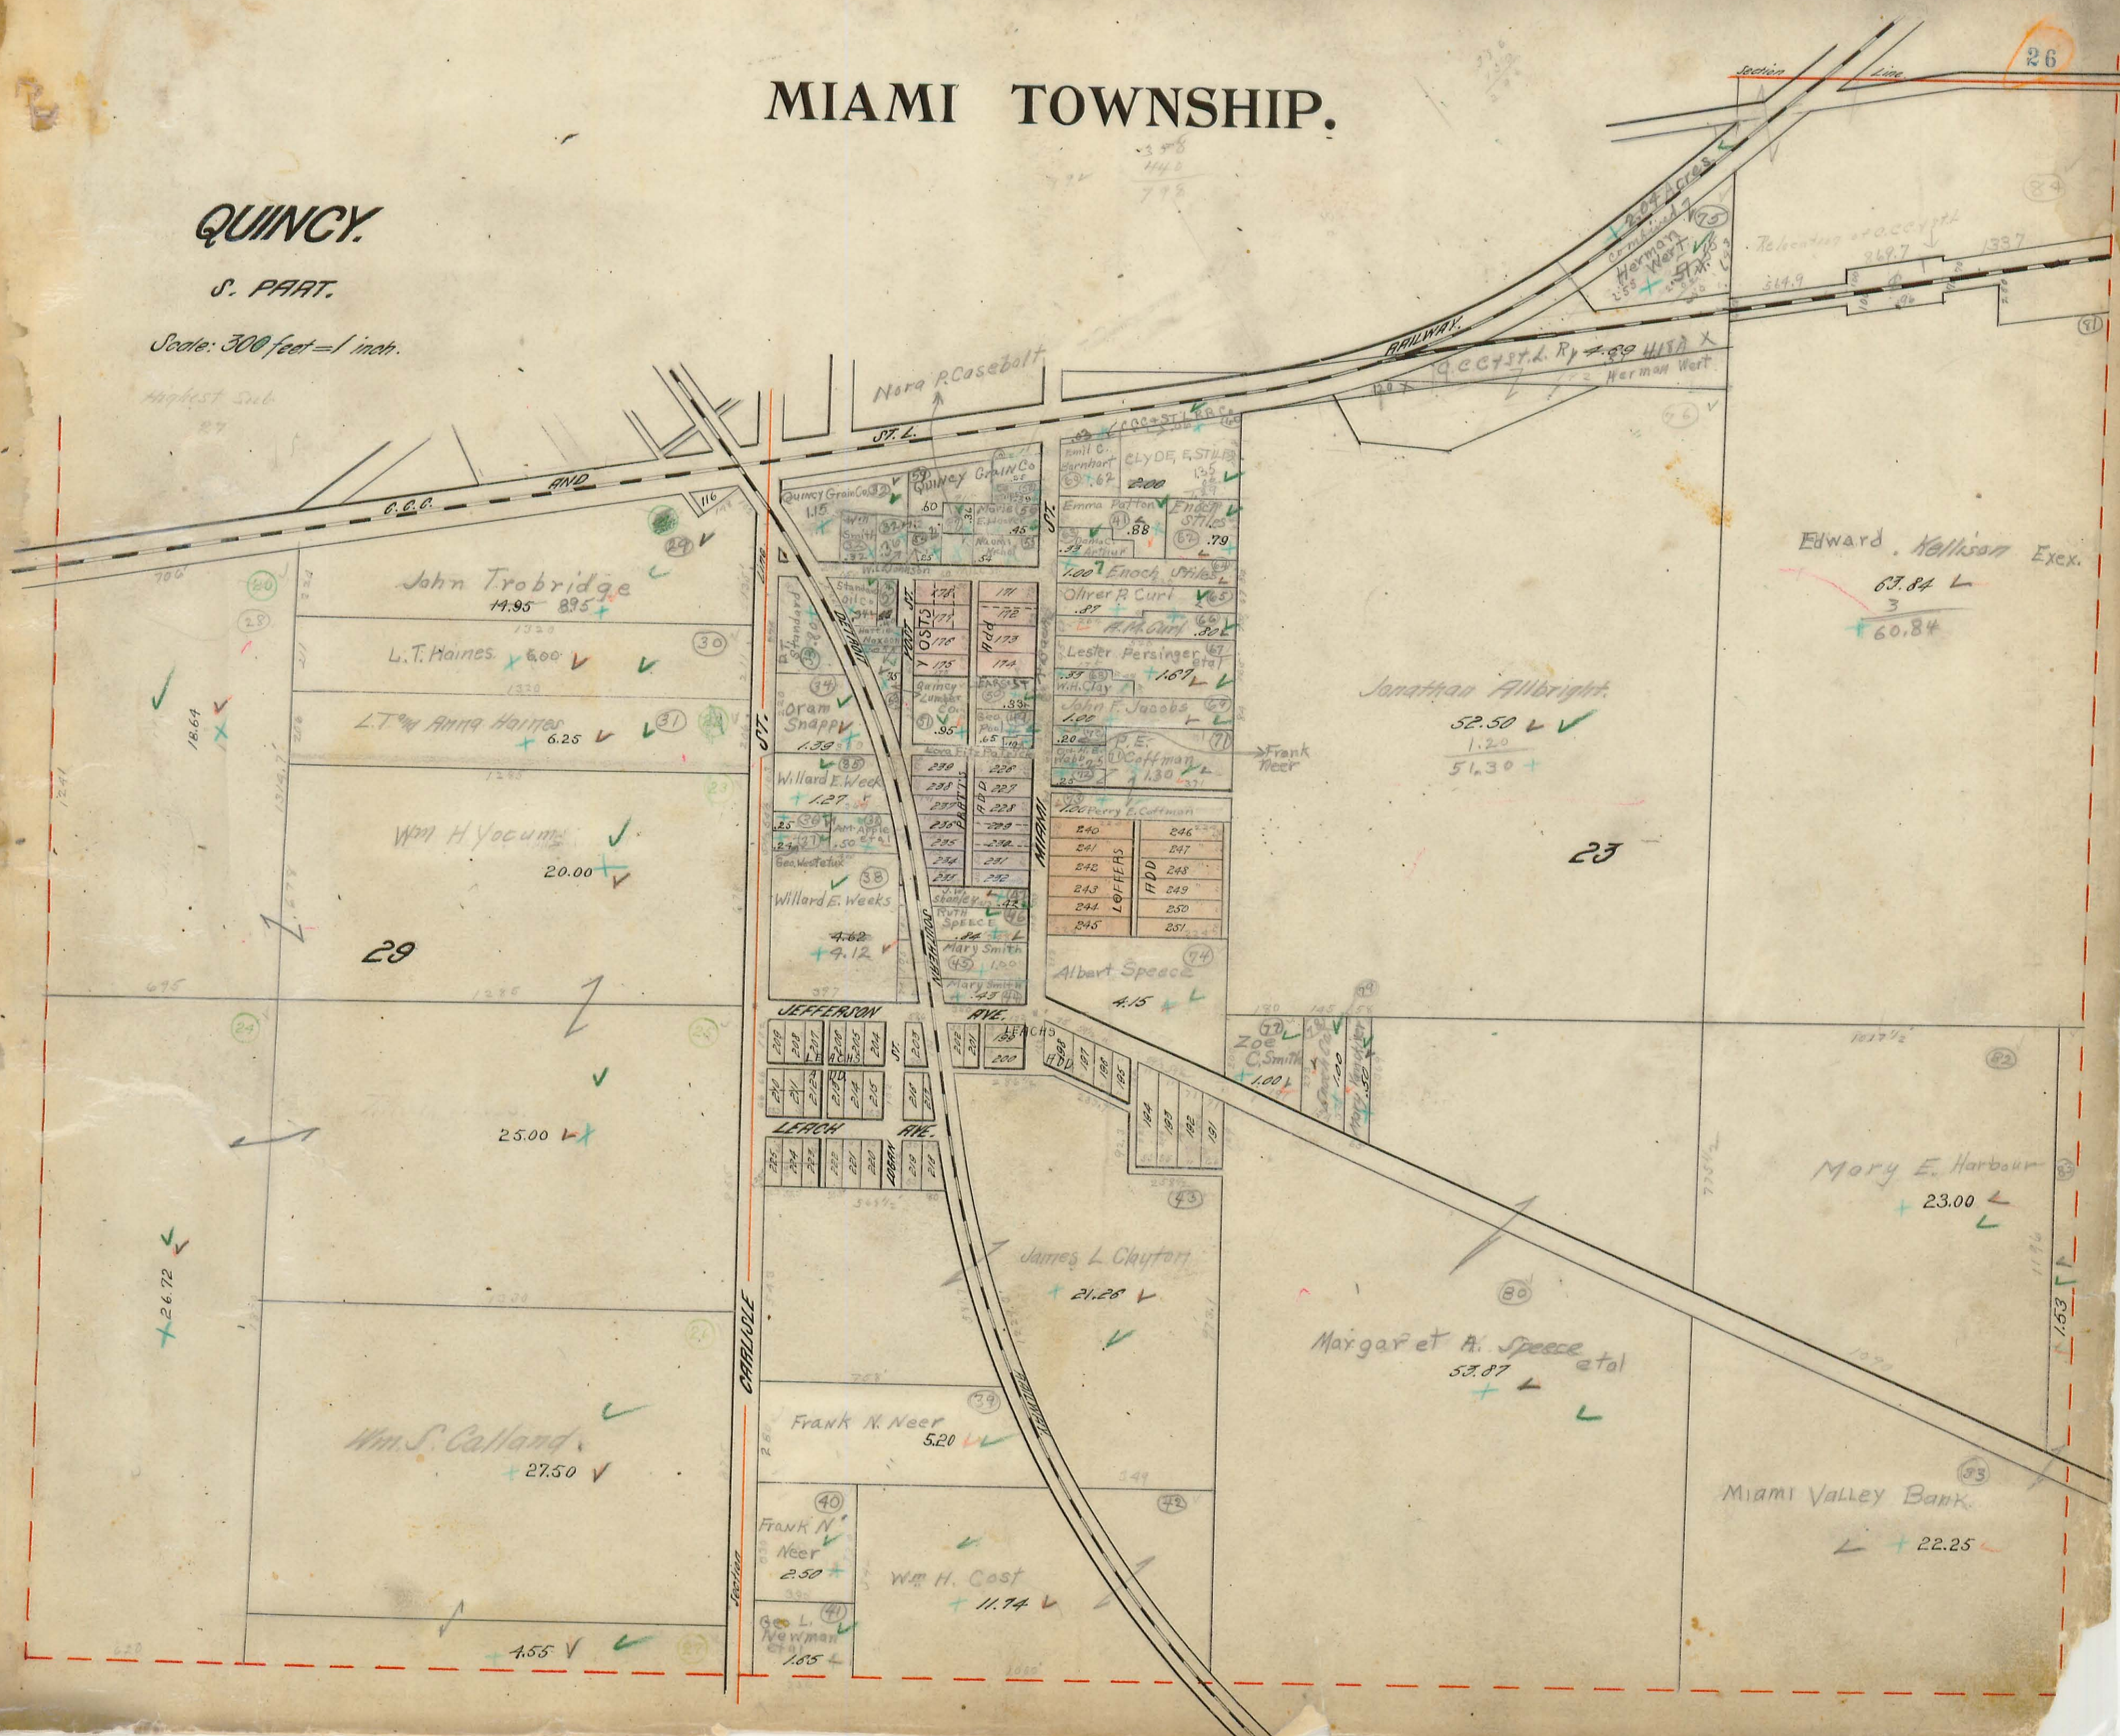

Nora P. Casebolt  
J.T.L.

John Trobridge  
19.95 895 +

L.T. Haines  
6.00

L.T. Anna Haines  
6.25

Wm H. Yocum  
20.00

29

25.00

+ 26.72

Wm S. Calland  
27.50

Frank N. Neer  
2.50

Wm H. Cost  
11.74

Geo L. Newman  
1.85

Quincy Grain Co  
1.15

Oram Snappy  
1.39

Willard E. Week  
1.27

Willard E. Weeks  
4.62

Willard E. Weeks  
4.12

JEFFERSON AVE

LEACH AVE









Quincy Grain Co  
1.15

Quincy Grain Co  
1.15

Emil C. Barnhart  
67.62

Emma Patton  
1.88

Oliver R. Curt  
.87

Lester Persinger  
1.67

John F. Jacobs  
1.00

Frank Neer

Albert Speece  
4.15

JEFFERSON AVE

LEACH AVE









CLYDE R. STILES  
1.35

Enoch Stiles  
1.79

































Edward Kellison Exex.  
67.84  
3  
60.84

Jonathan Albright  
52.50  
1.20  
51.30

Mary E. Harbour  
23.00

Margaret A. Speece et al  
53.87

Miami Valley Bank  
22.25