


UNION TOWNSHIP INDEX MAP

Red Figures Refer to Pages

Collected by John F. ...
Corrected to ...
~~Feb 1 1938~~
April 12 - 1942

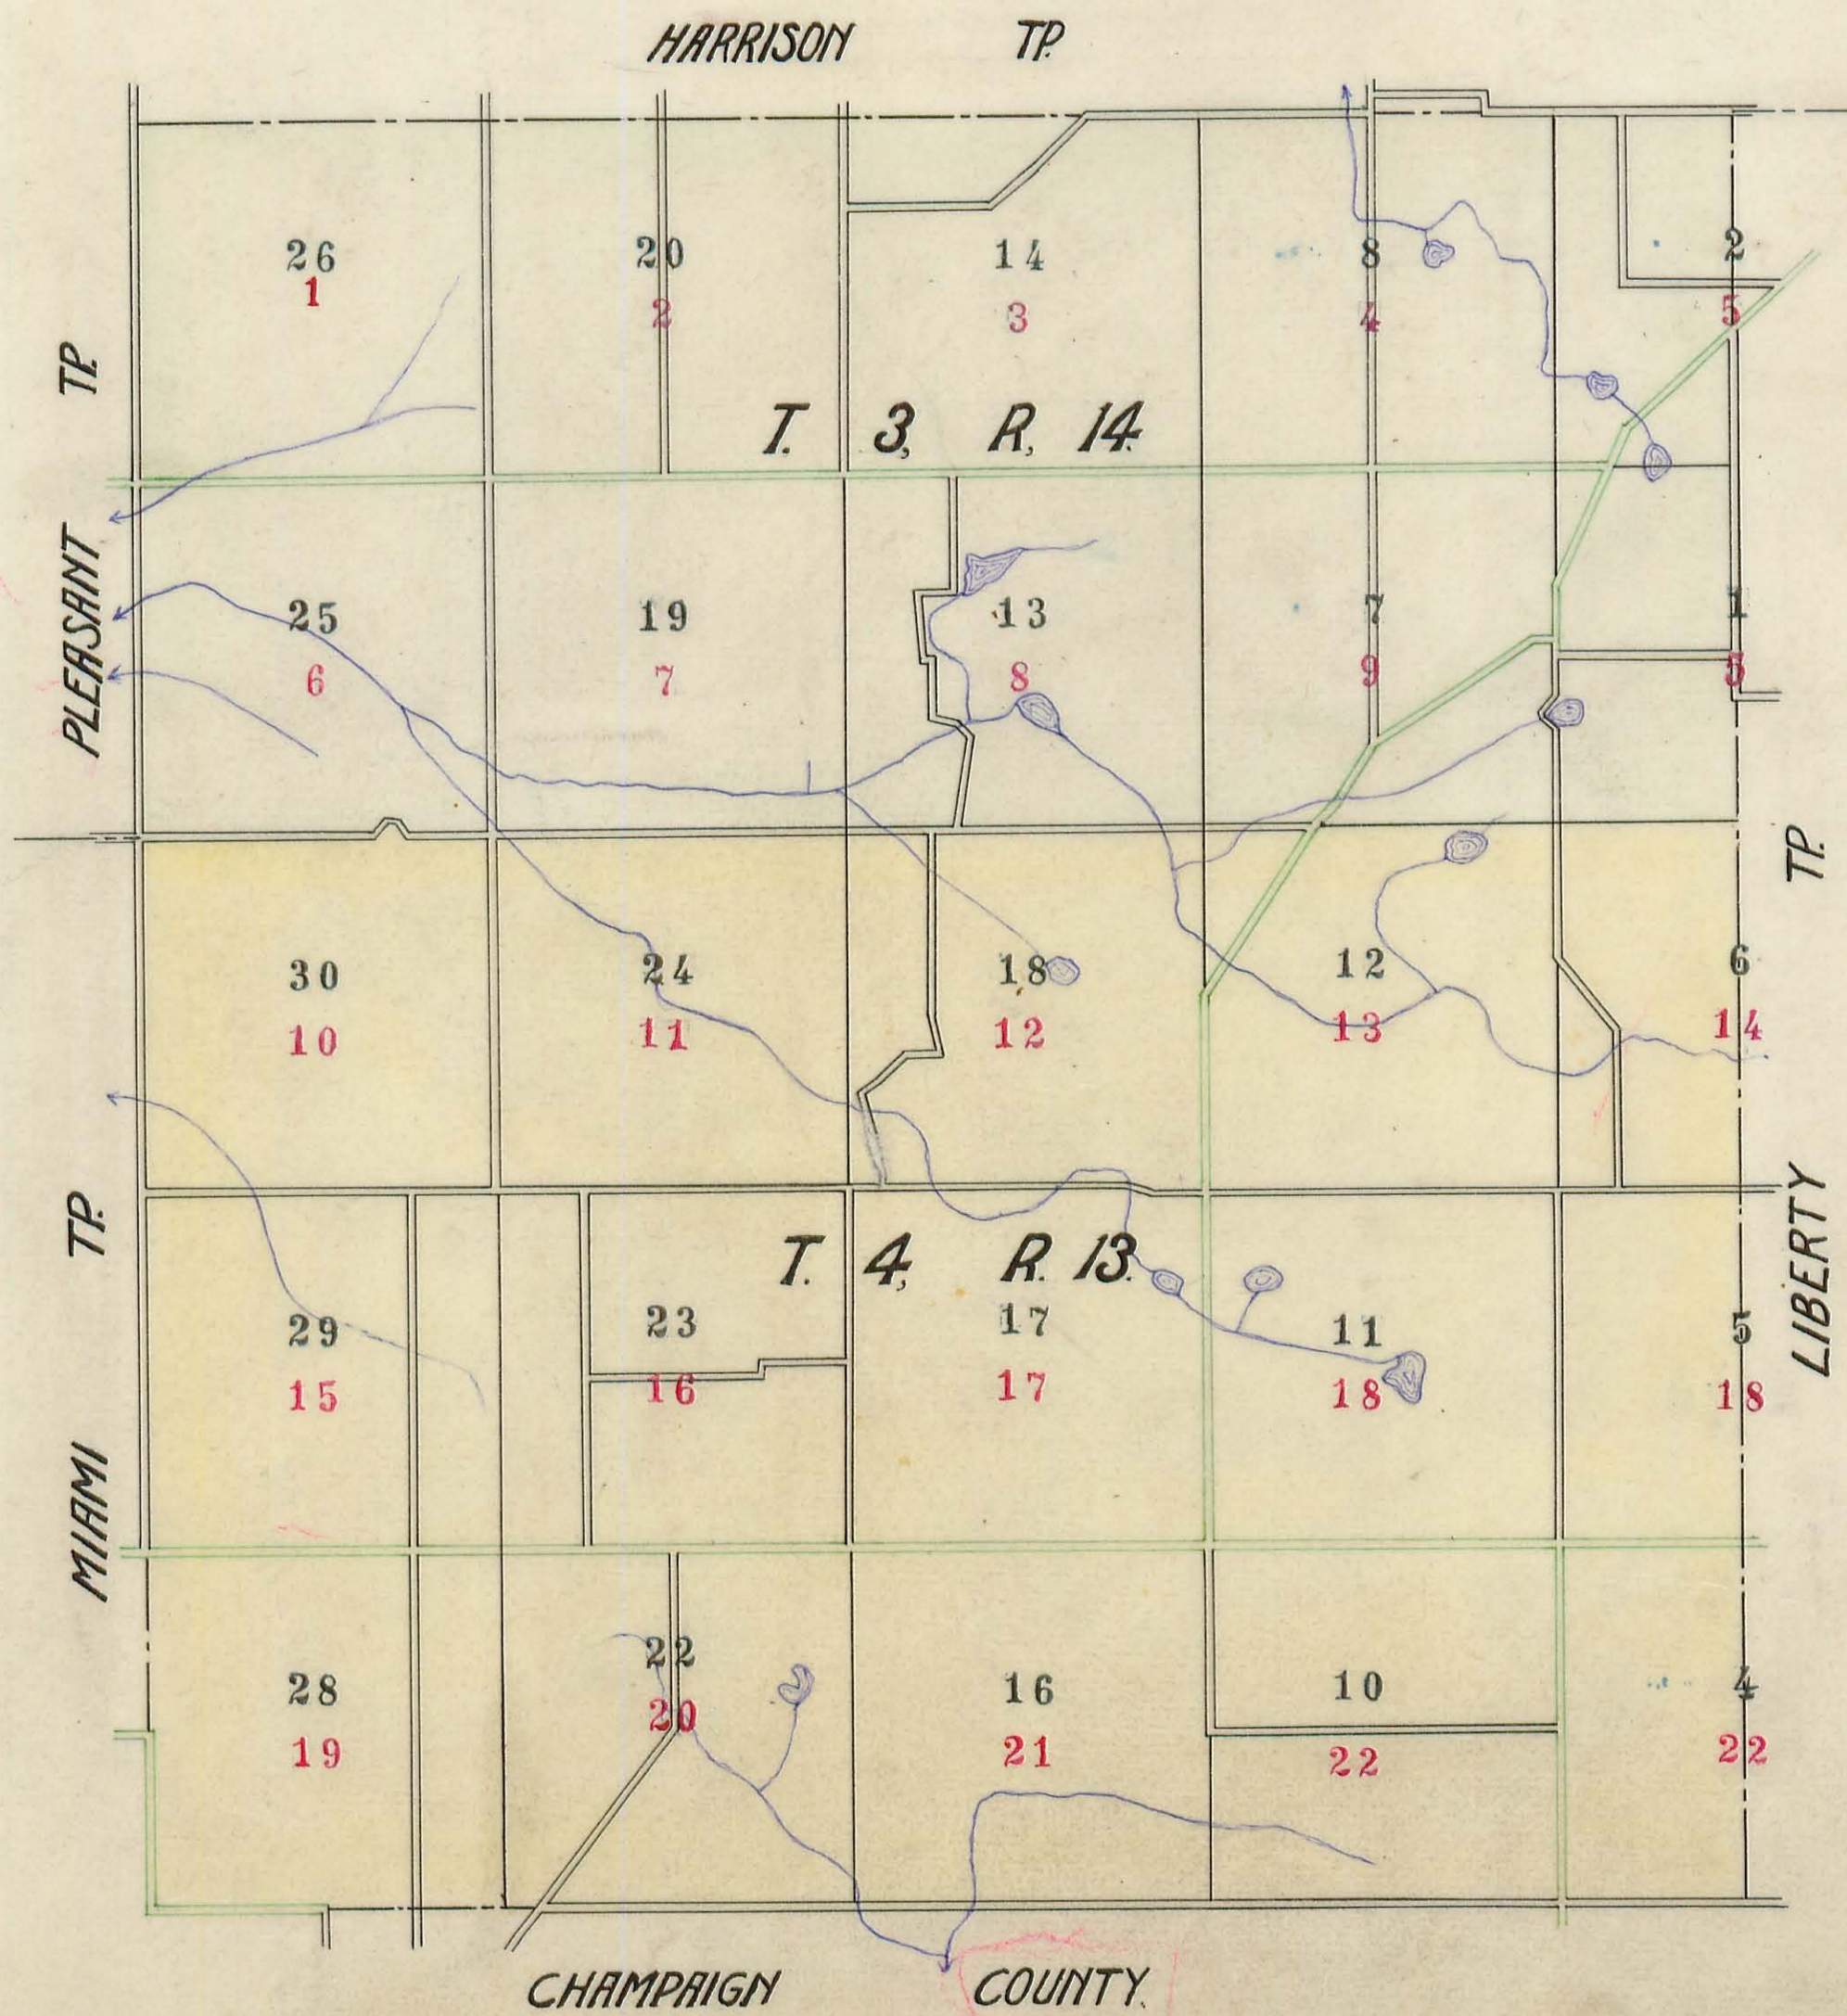


76
60
32.12
178.

UNION TOWNSHIP.

Plat of Section 26, Town 3, Range 14

Scale 10 Chains Per Inch.

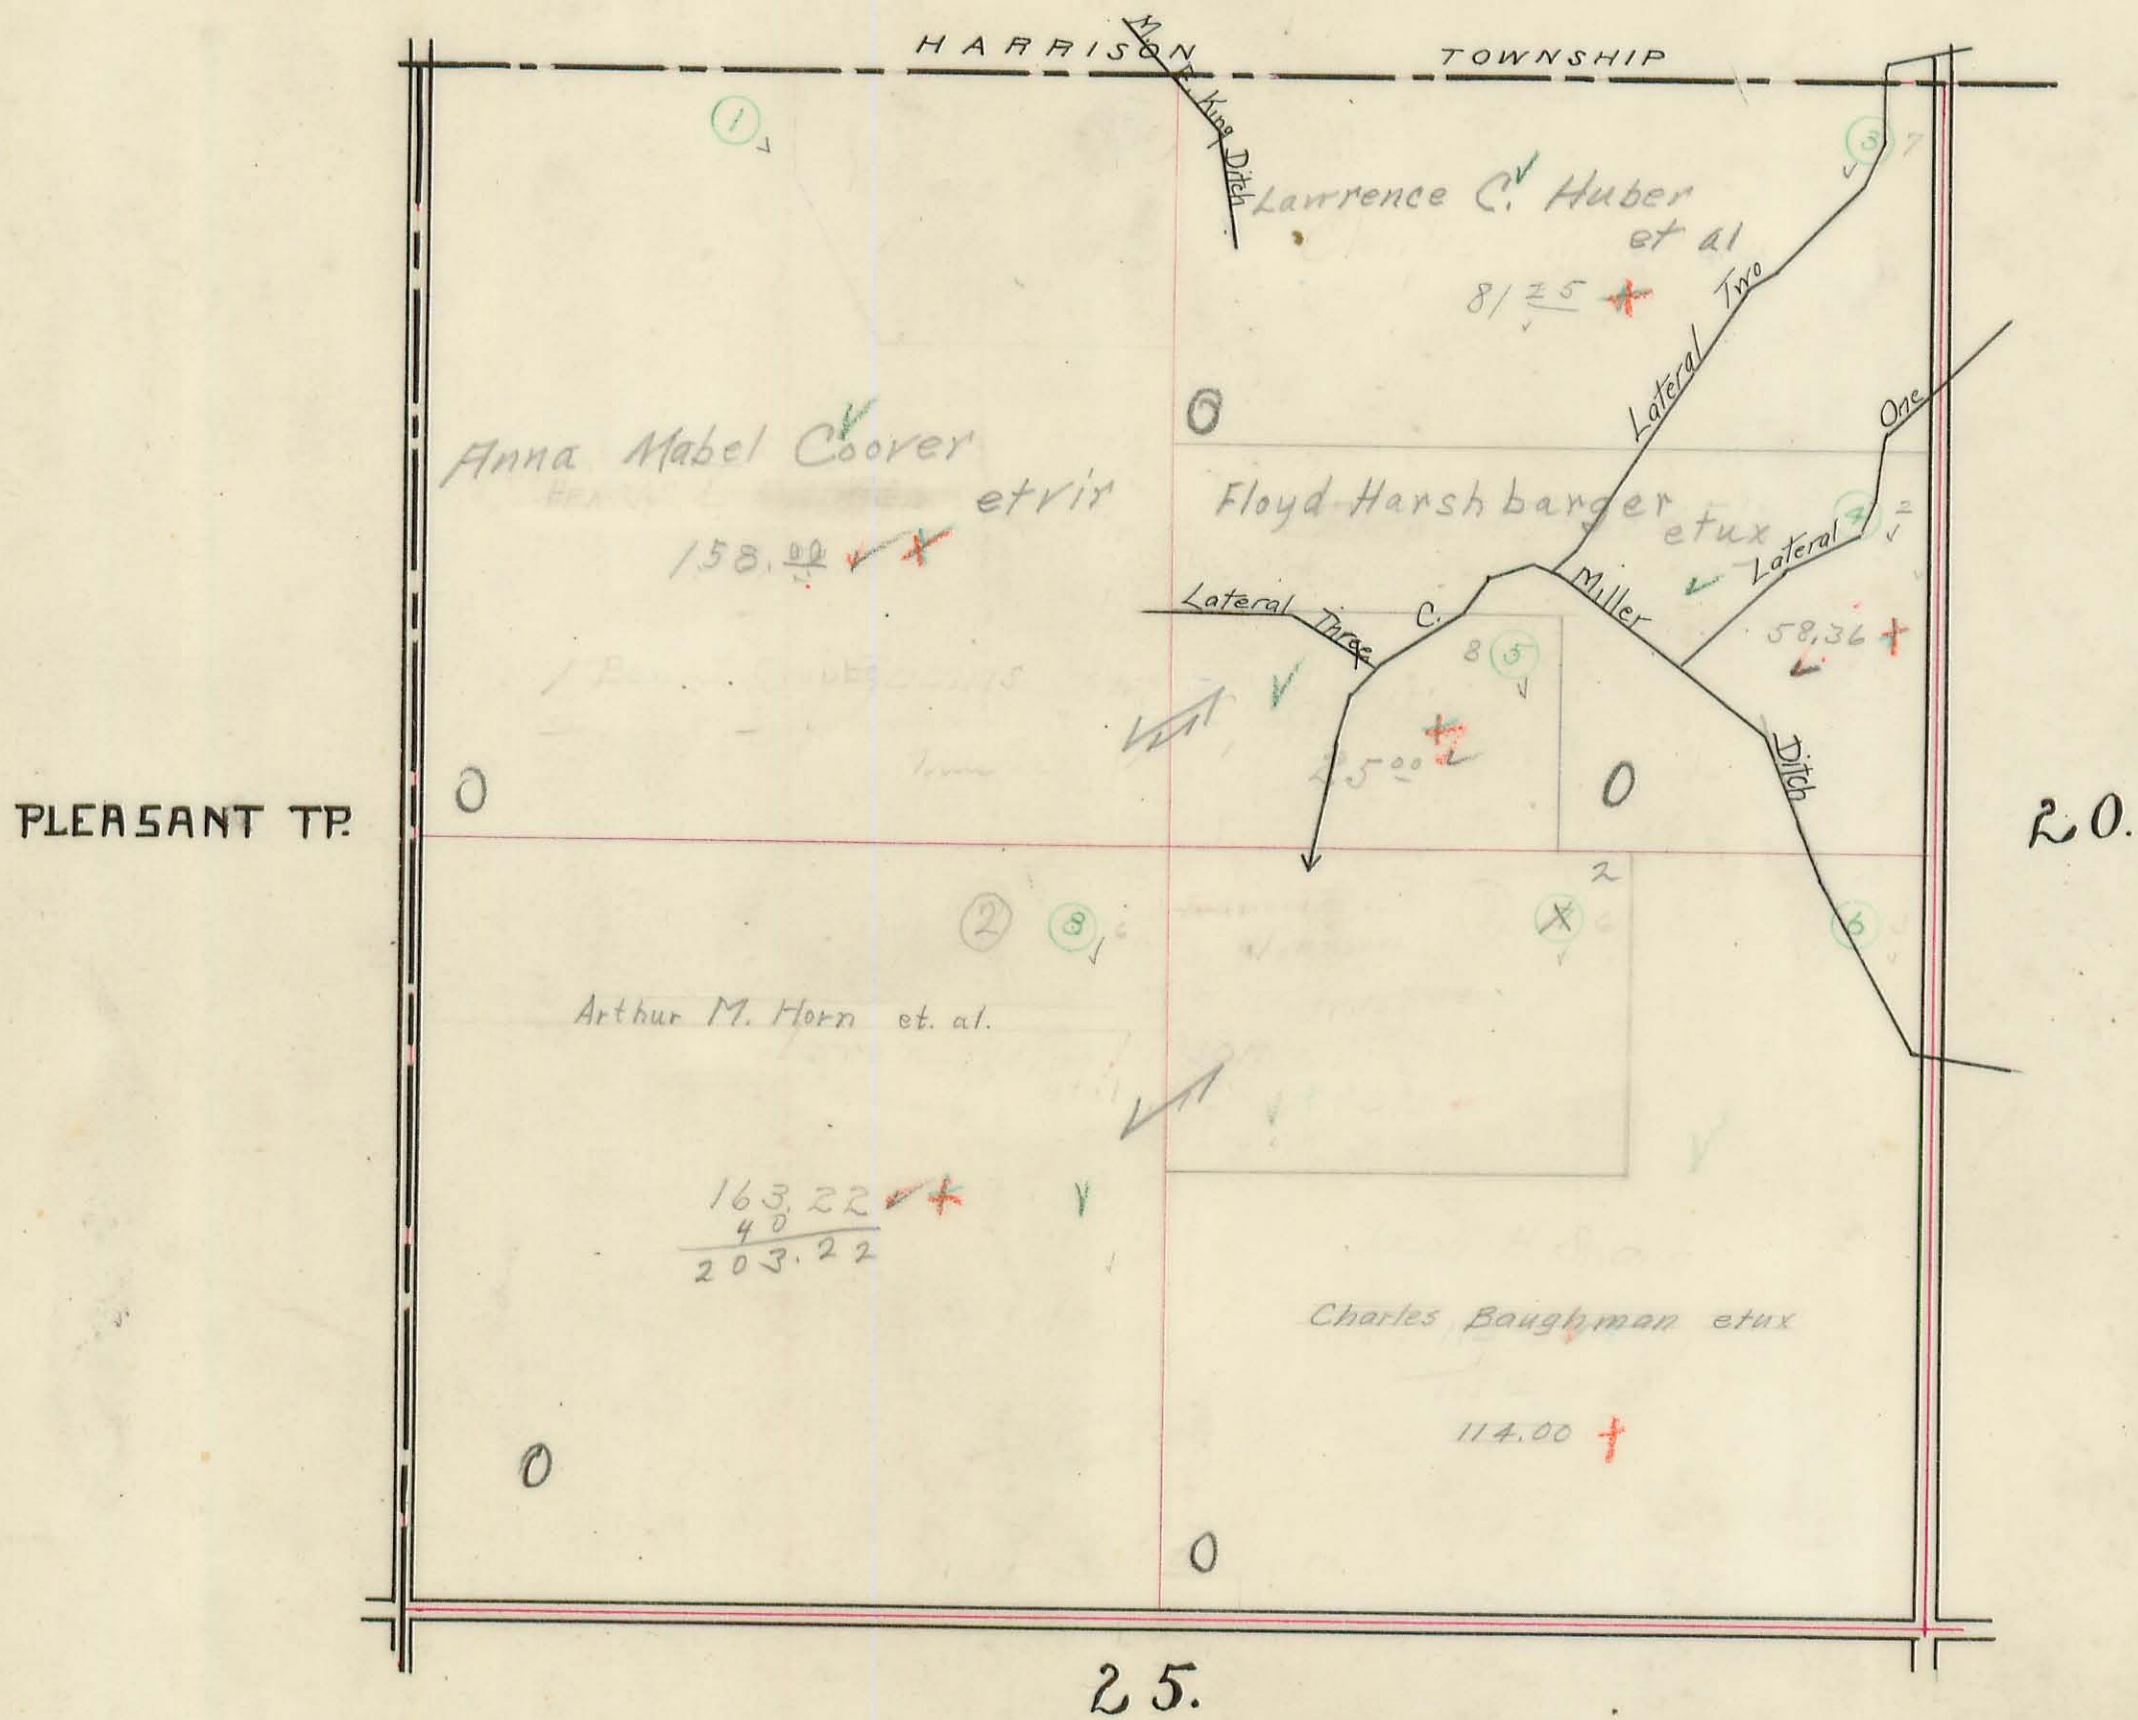

checked


UNION TOWNSHIP.

Plat of Section 20, Town 3, Range 14

Scale 10 Chains Per Inch.

2
A-14

HARRISON TP.

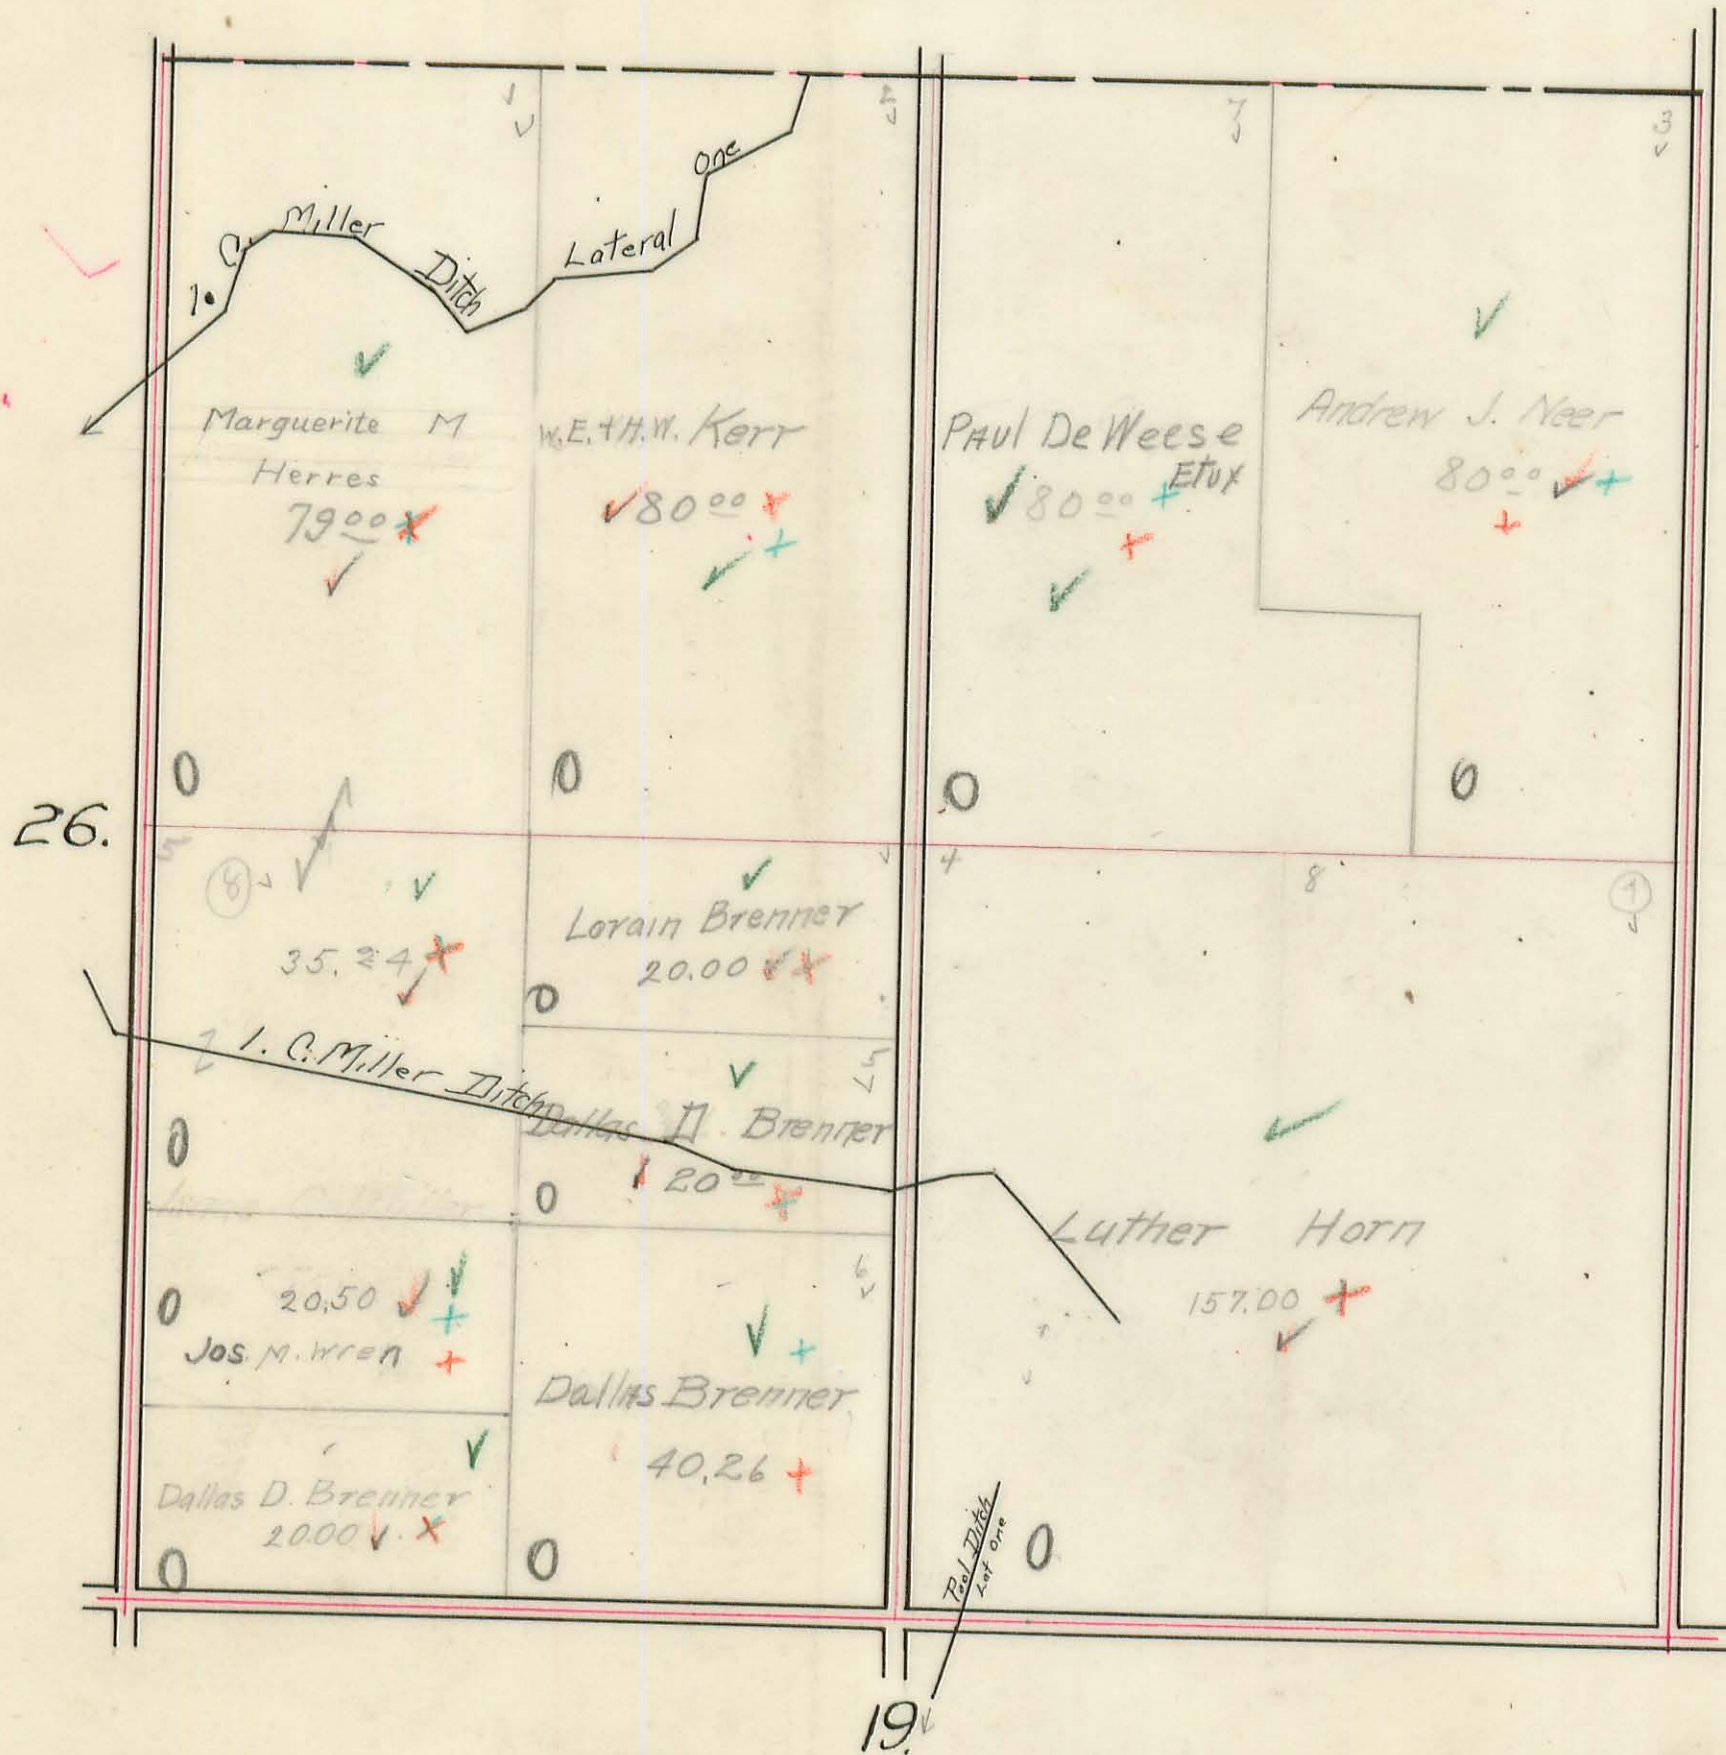

80 26
40 50
120 76
107
120 76
36 26


Checked

UNION TOWNSHIP.

Plat of Section 14, Town 3, Range 14.

Scale 10 Chains Per Inch.

HARRISON TP.

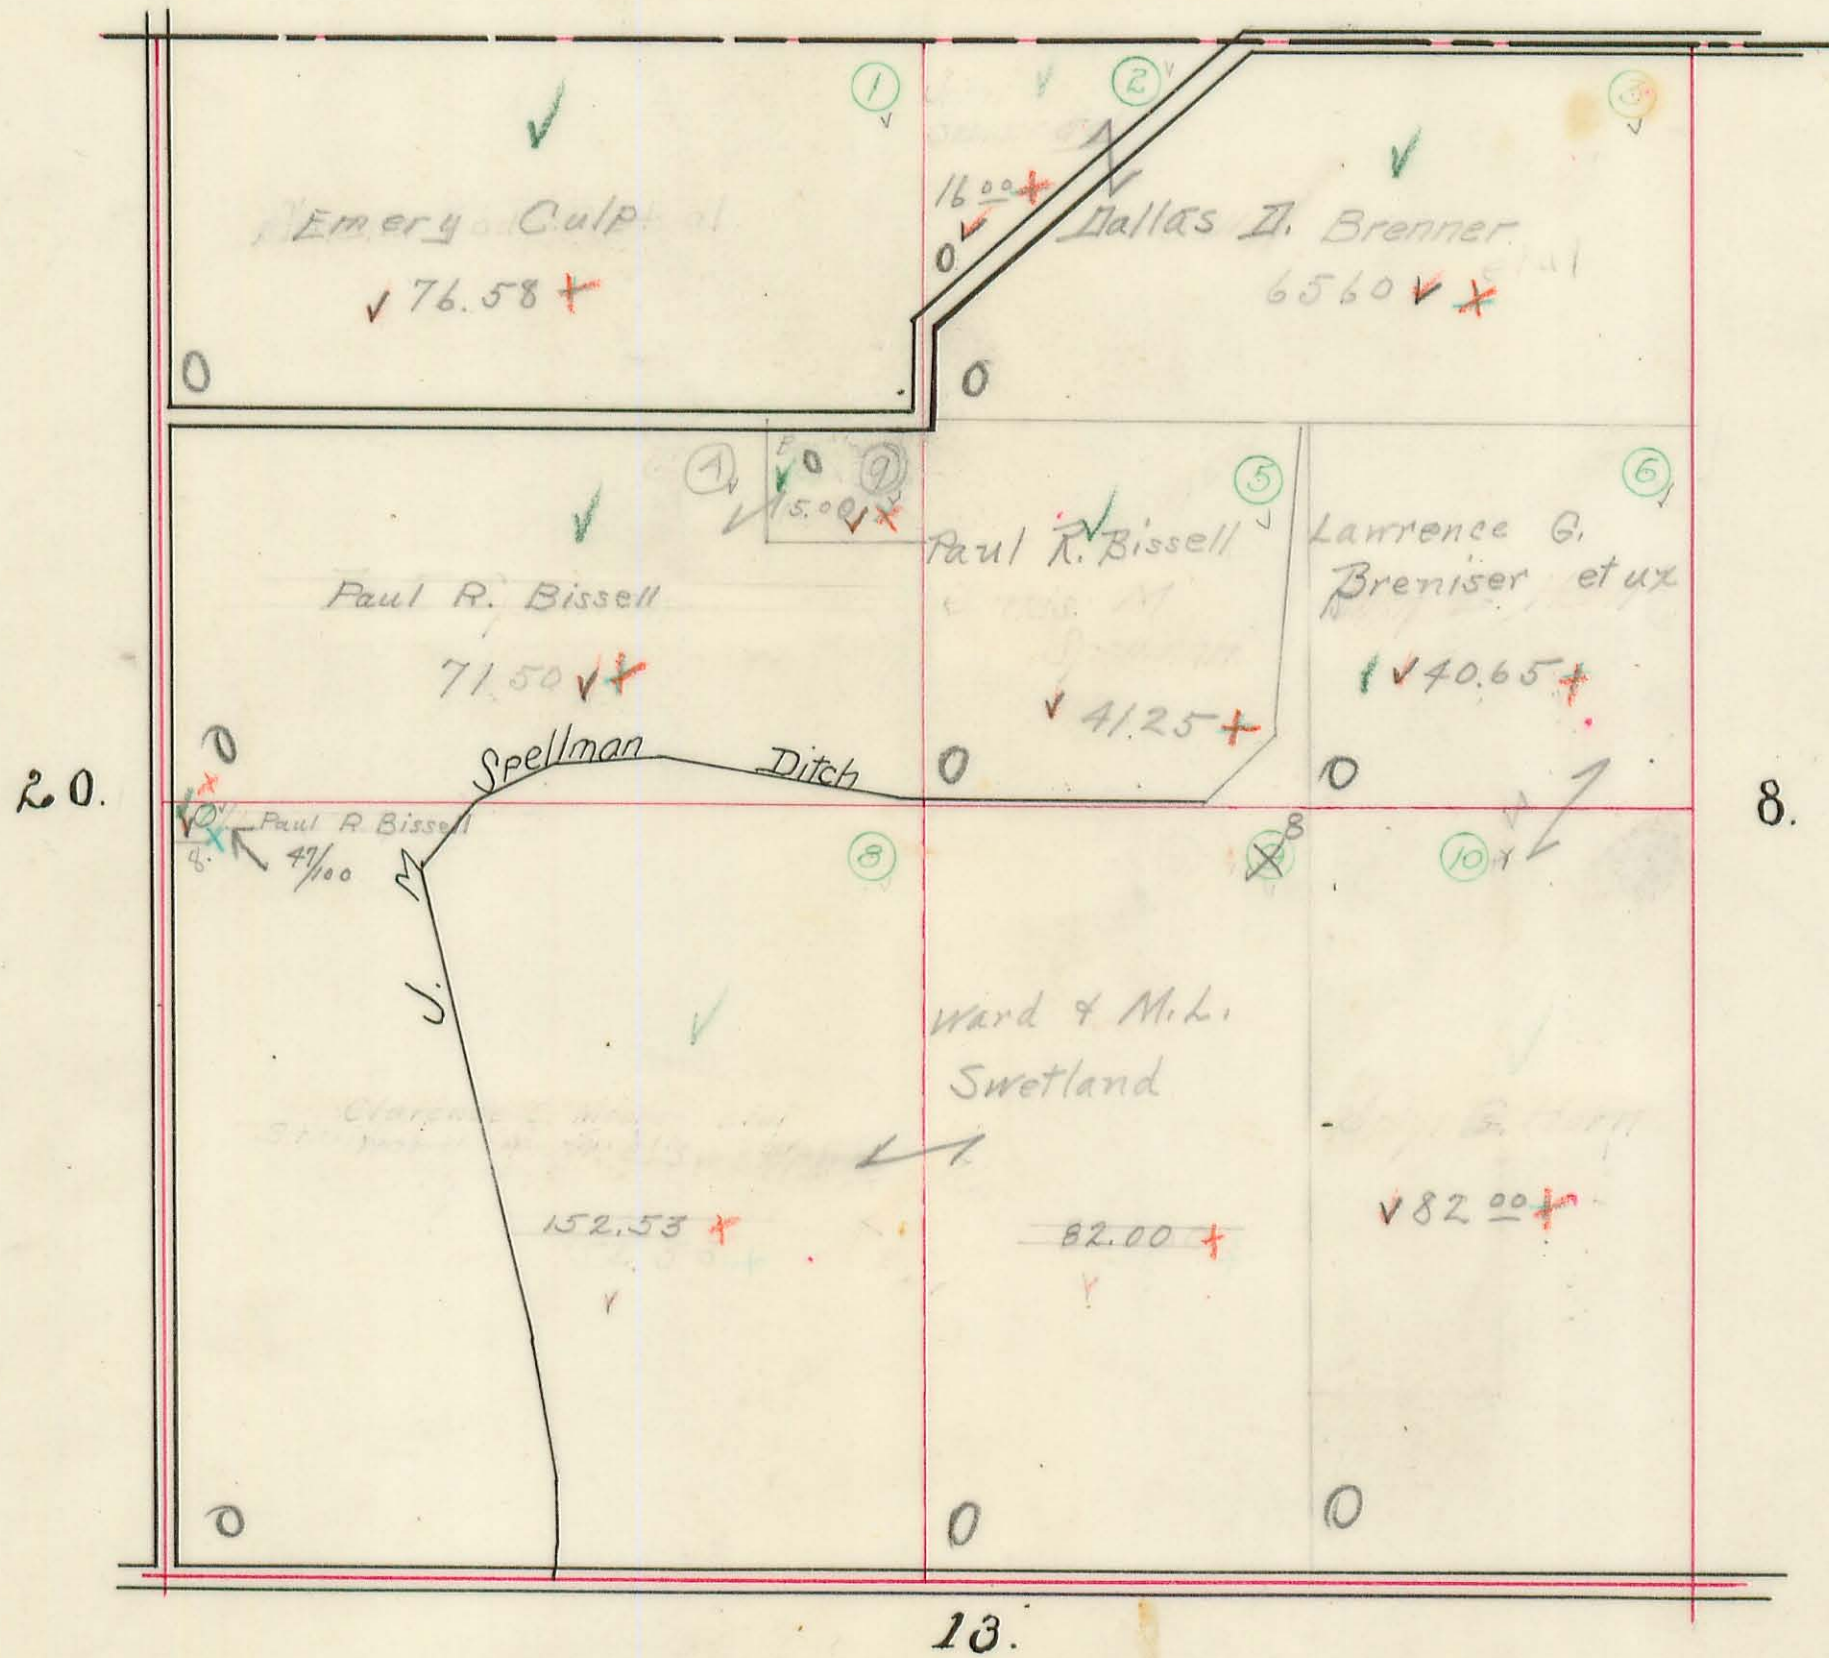


Checked

UNION TOWNSHIP.

Plat of Section 8, Town 3, Range 14.

Scale 10 Chains Per Inch.

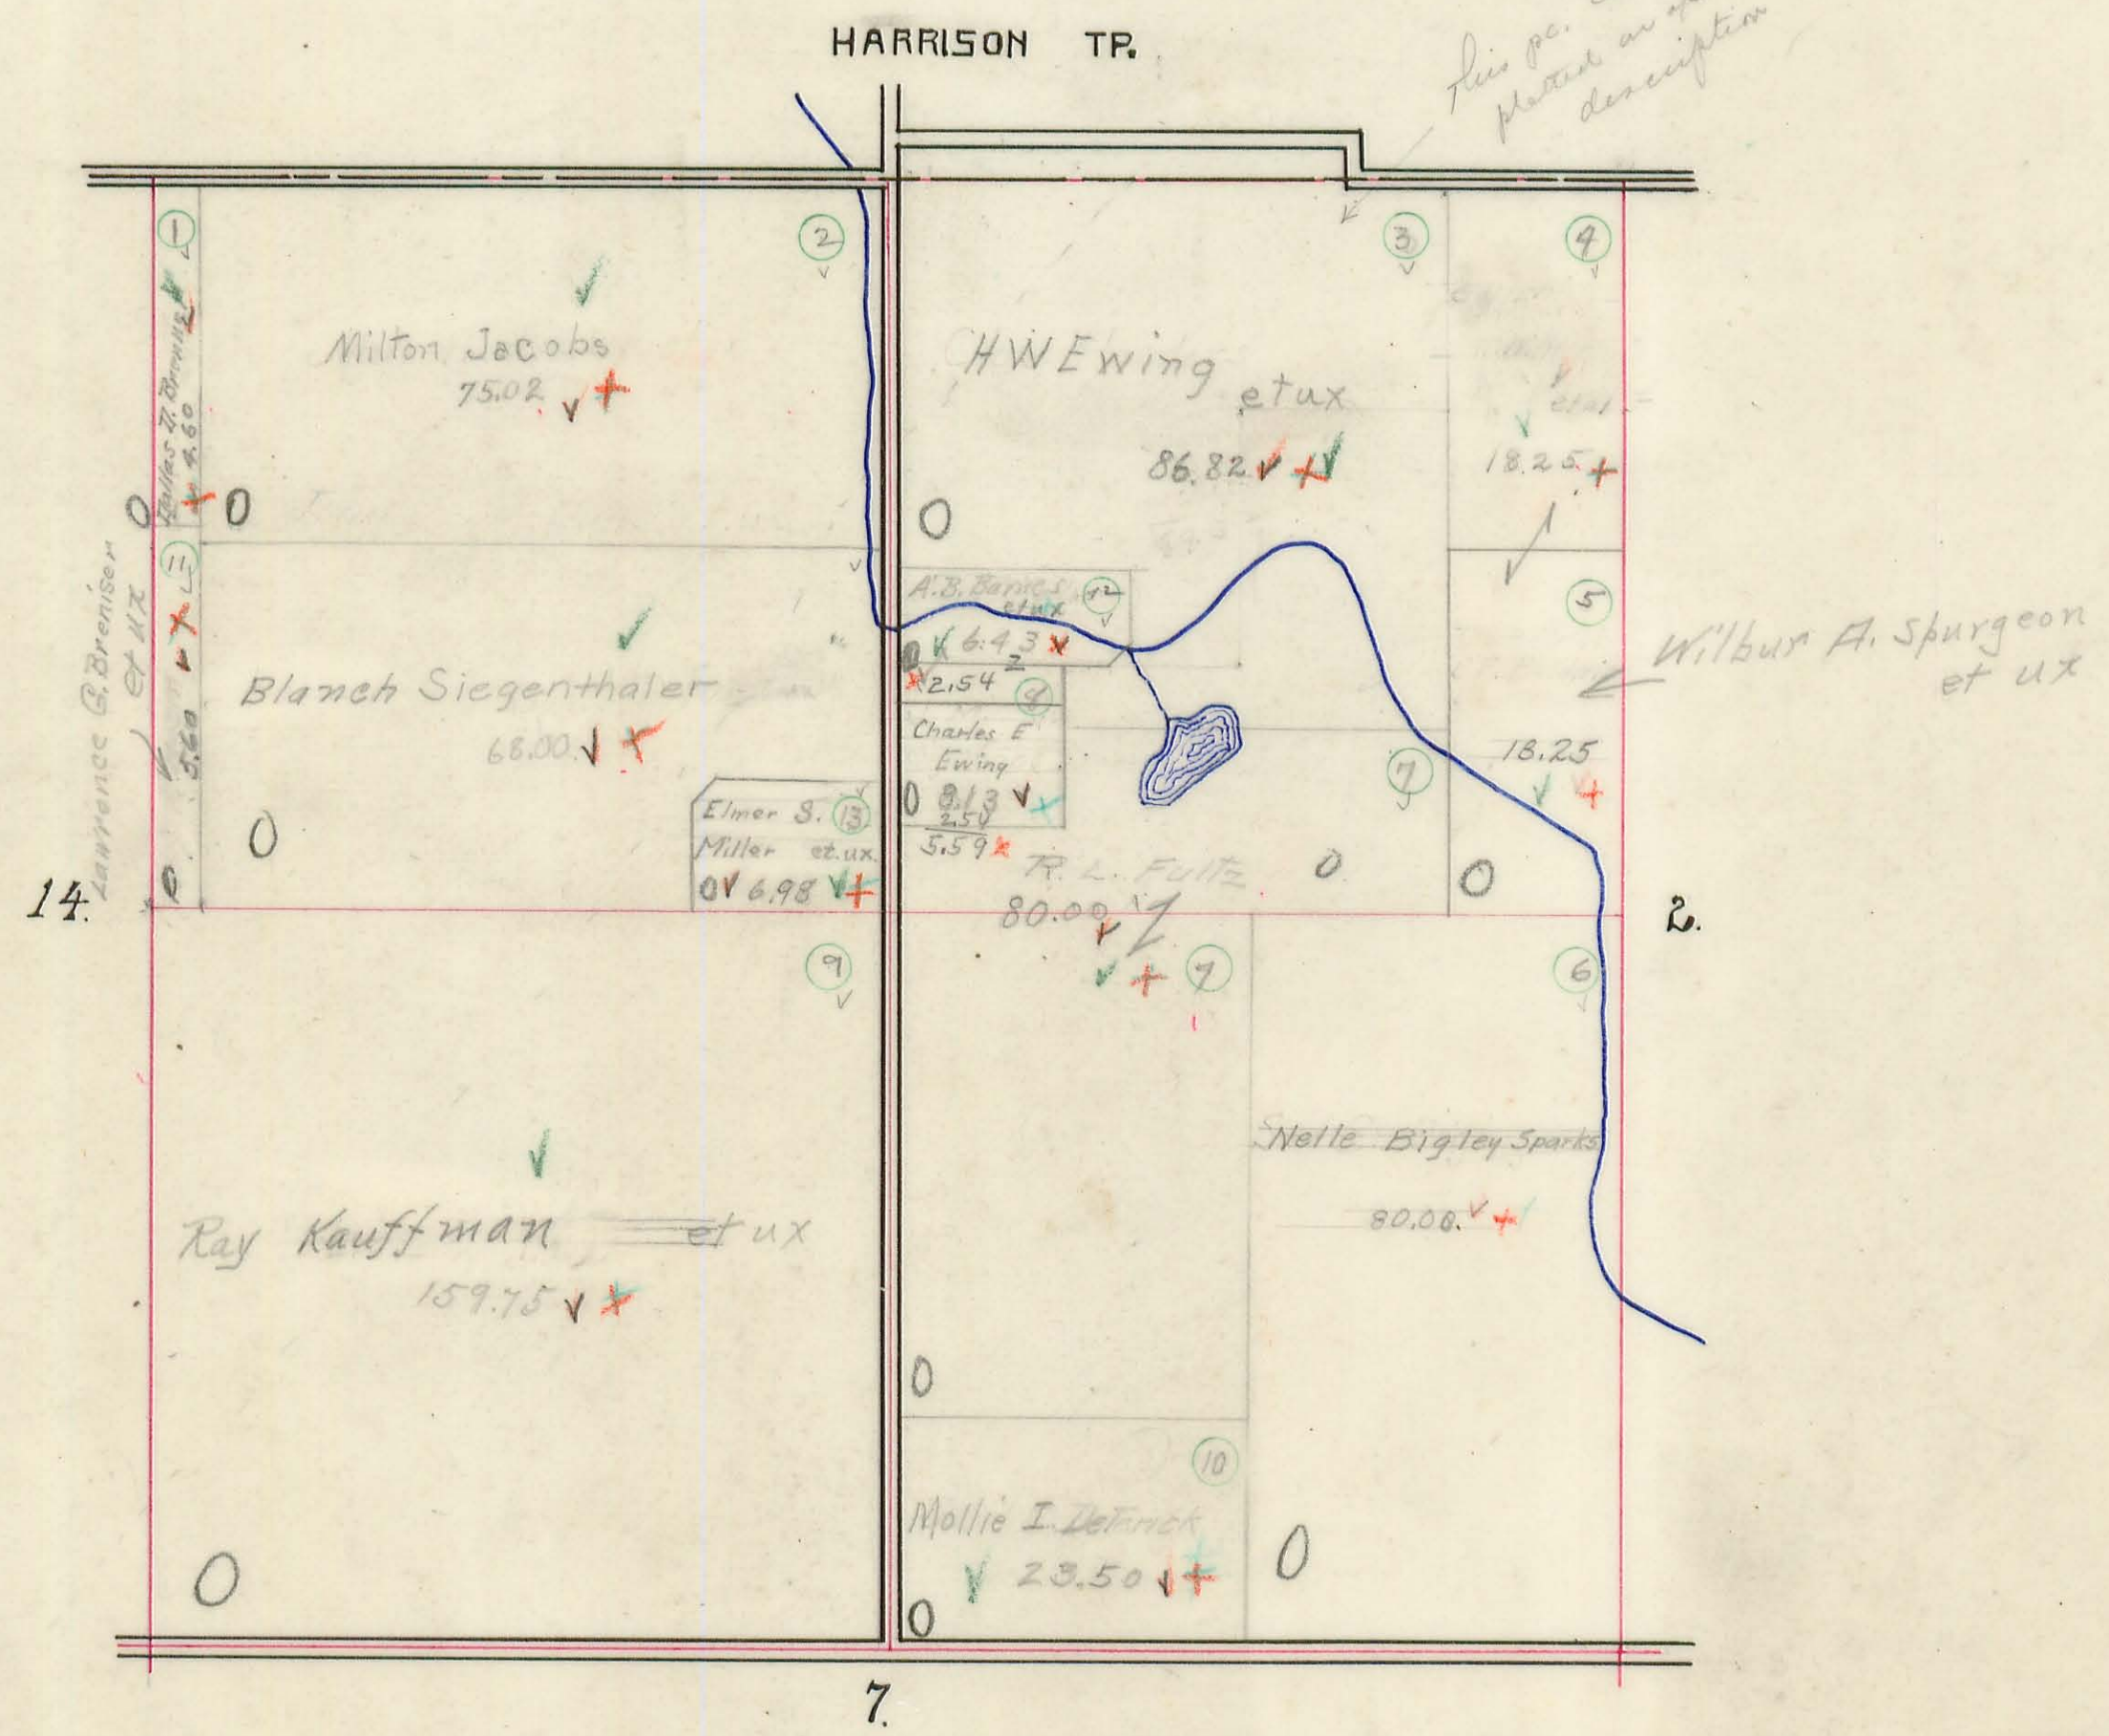


checked

UNION TOWNSHIP.

5
A-14

Plat of Section 1 & 2, Town 3, Range 14.

Scale 10 Chains Per Inch.

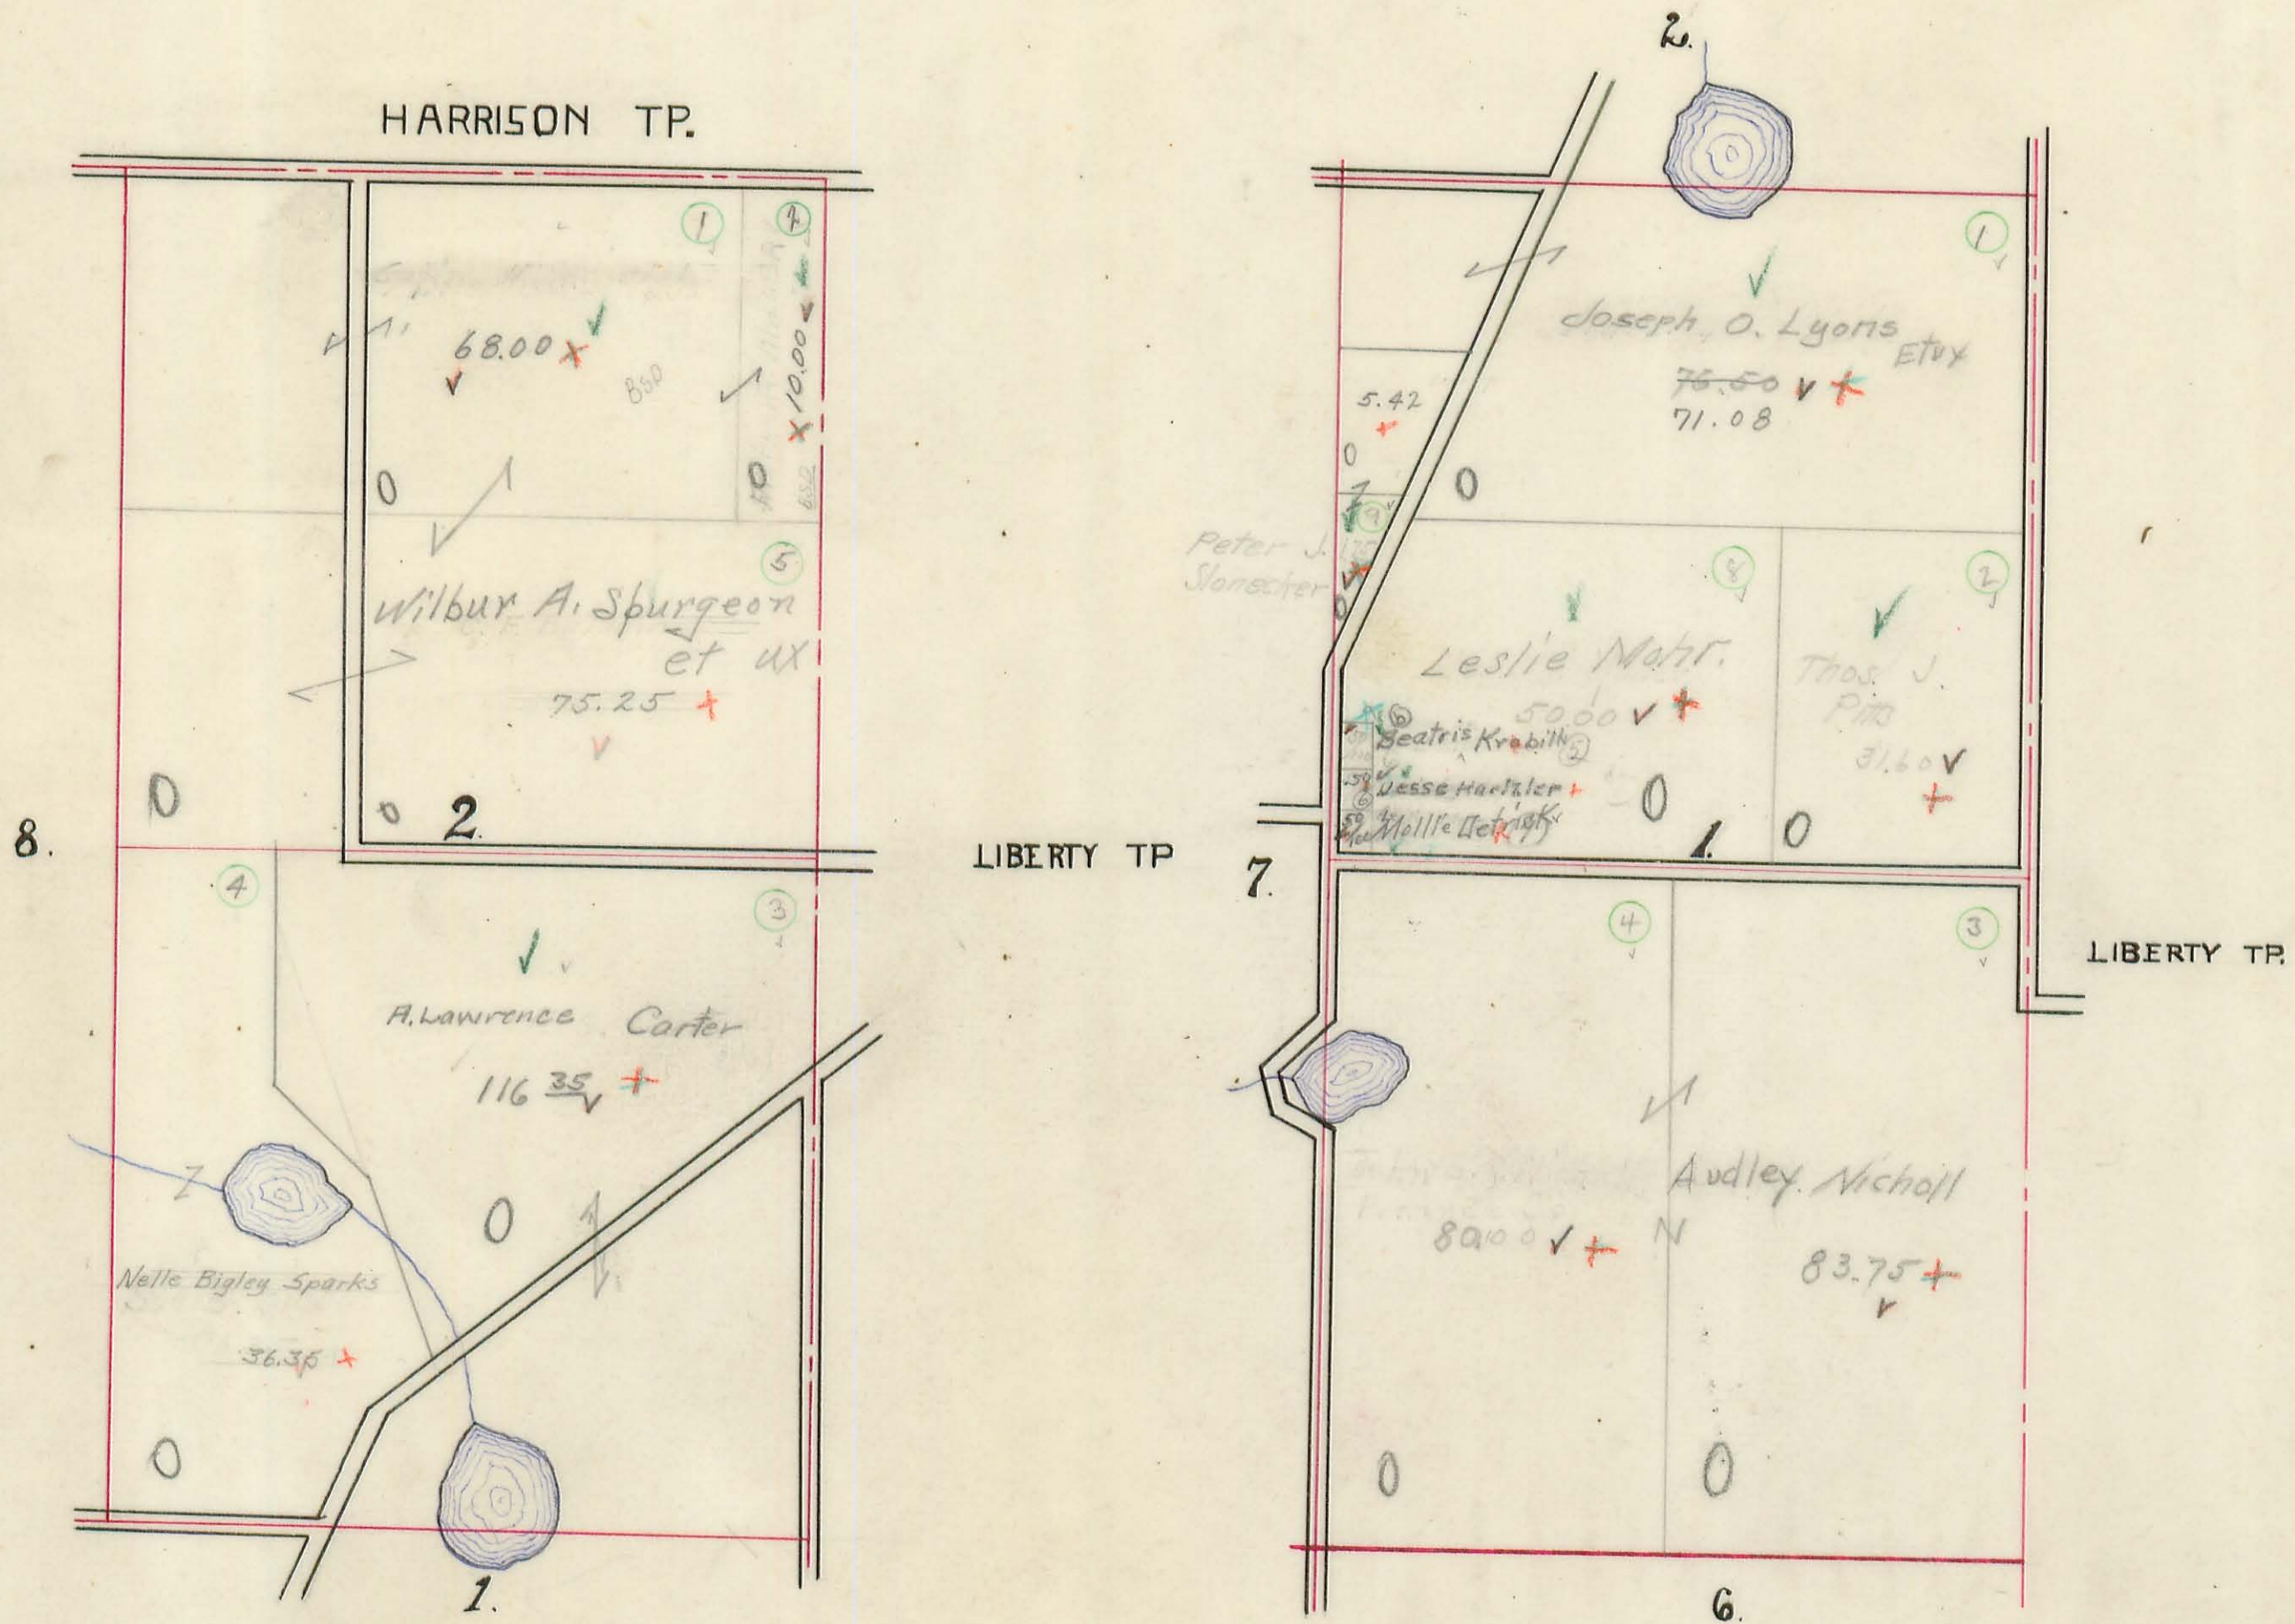


Checked

UNION TOWNSHIP.

Plat of Section 25, Town 3, Range 14.

Scale 10 Chains Per Inch.

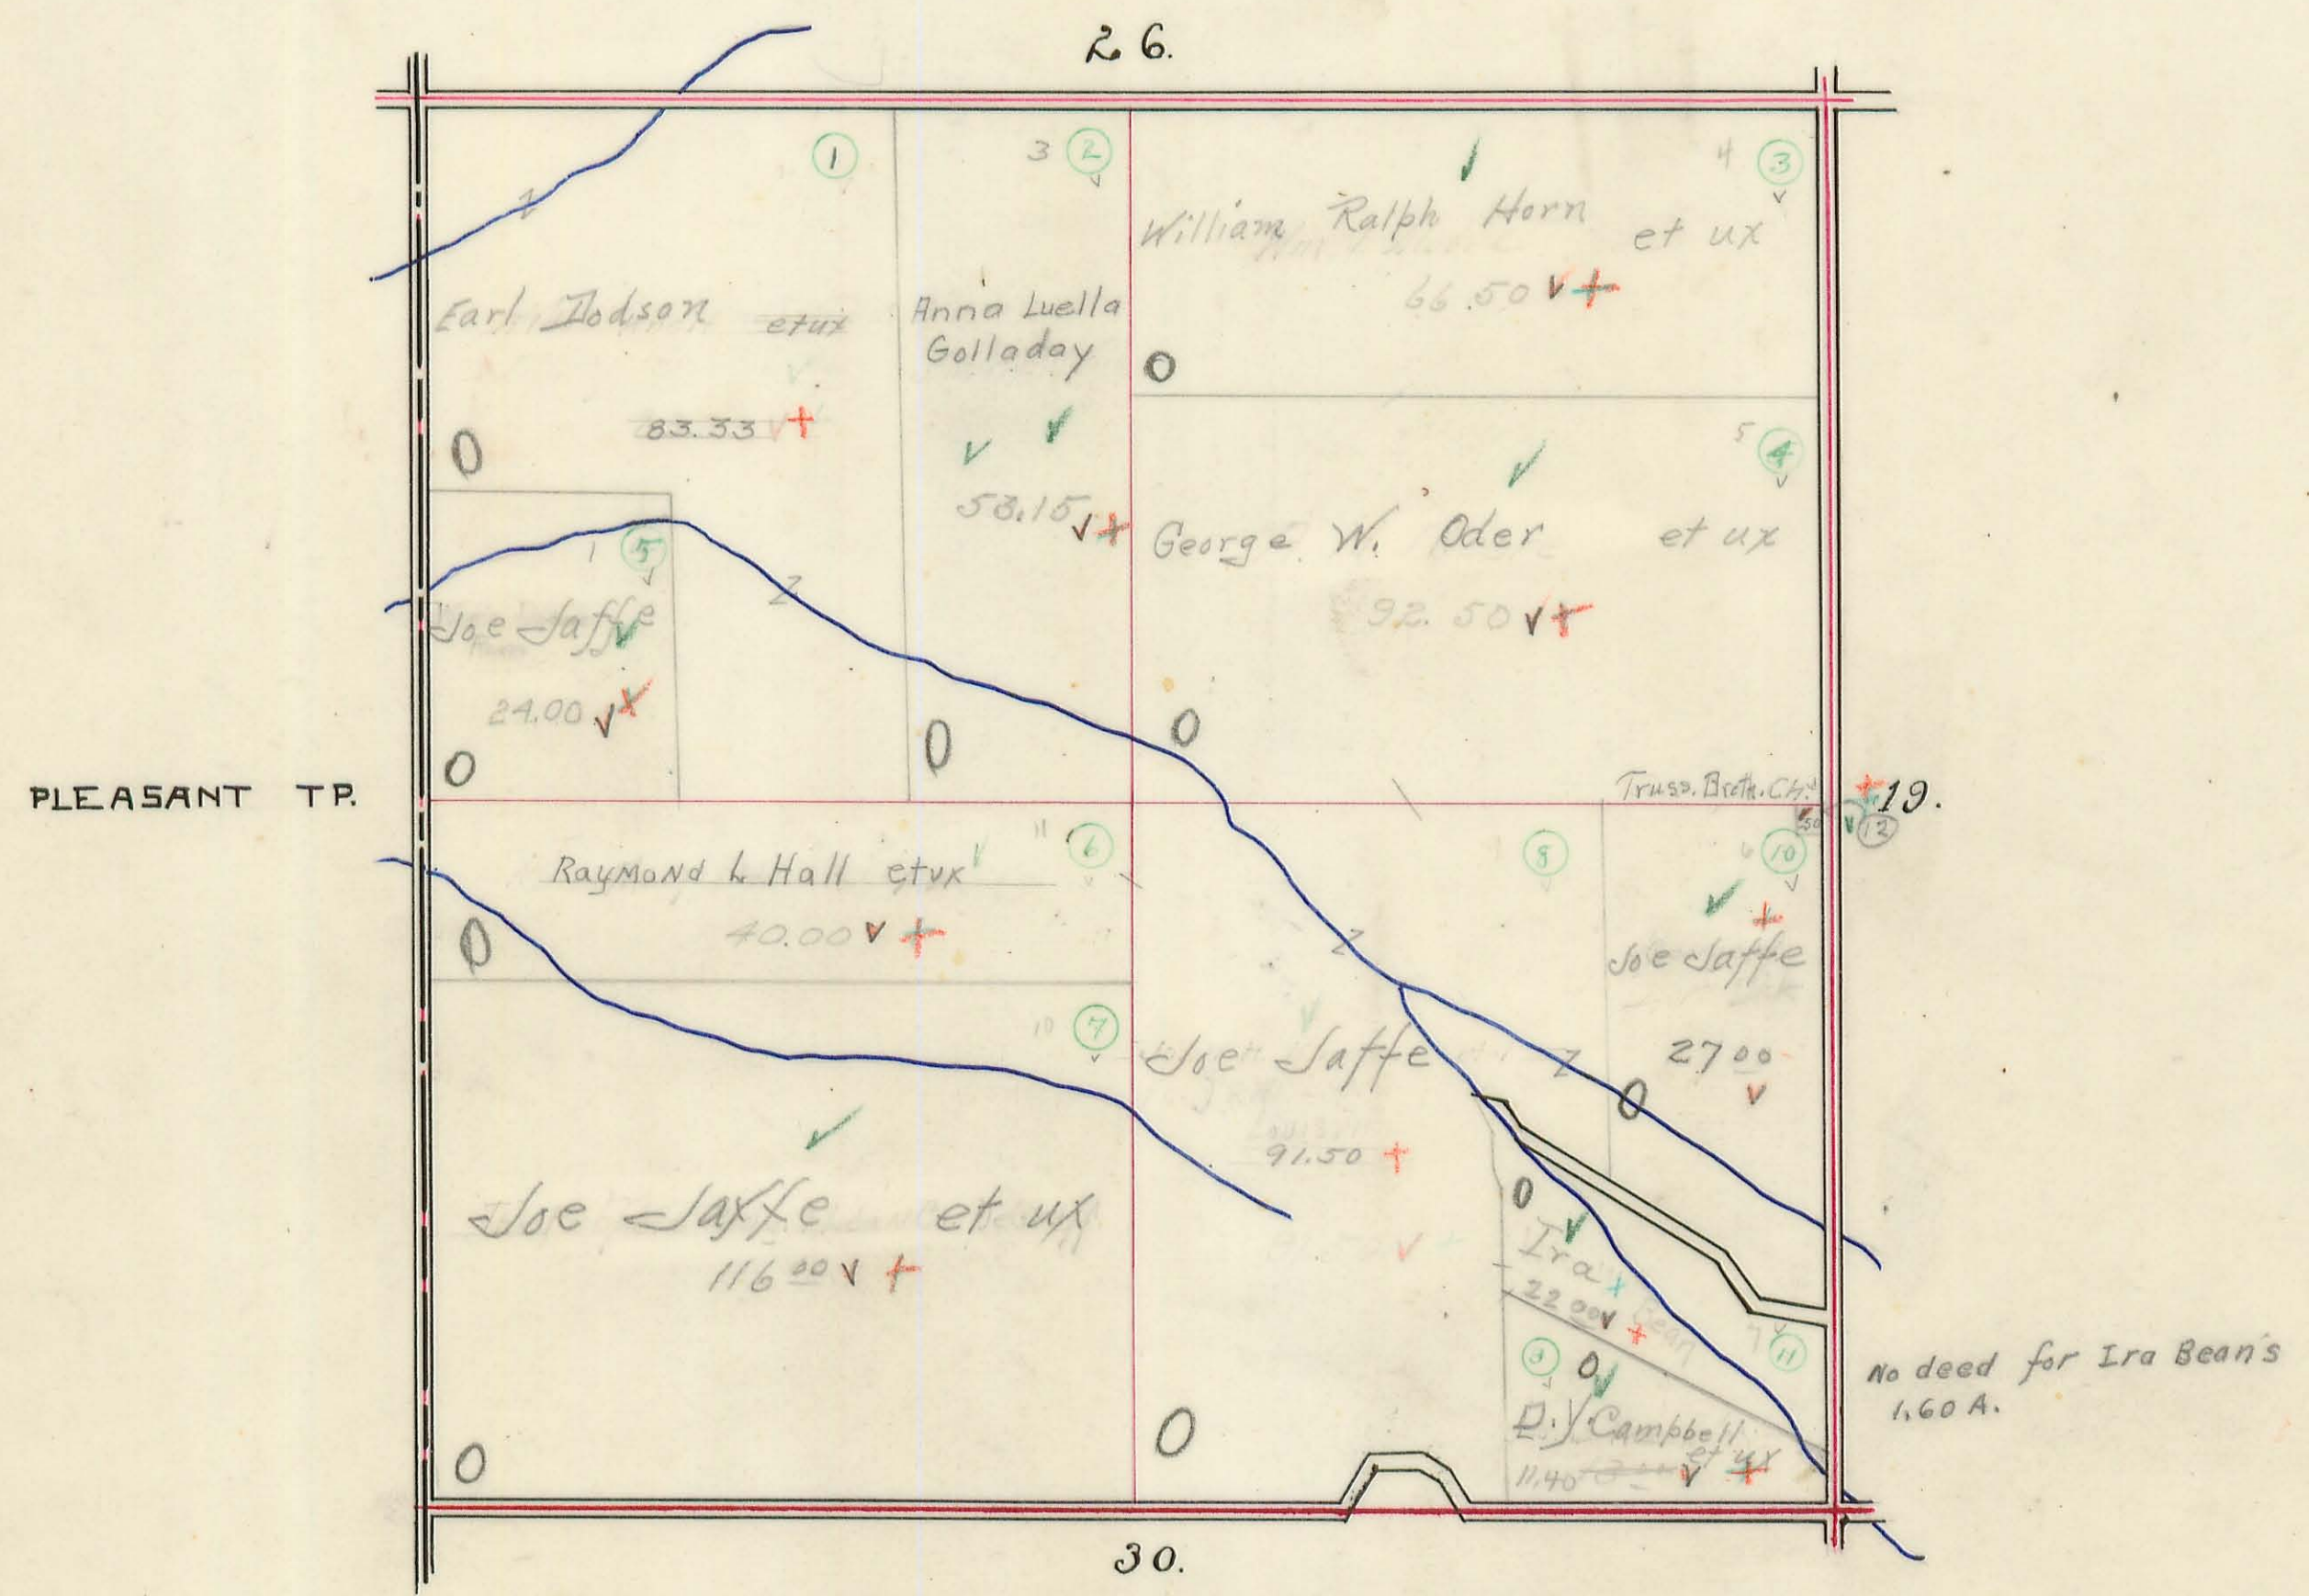


Checked

UNION TOWNSHIP.

Plat of Section 13, Town 3, Range 14.

Scale 10 Chains Per Inch.

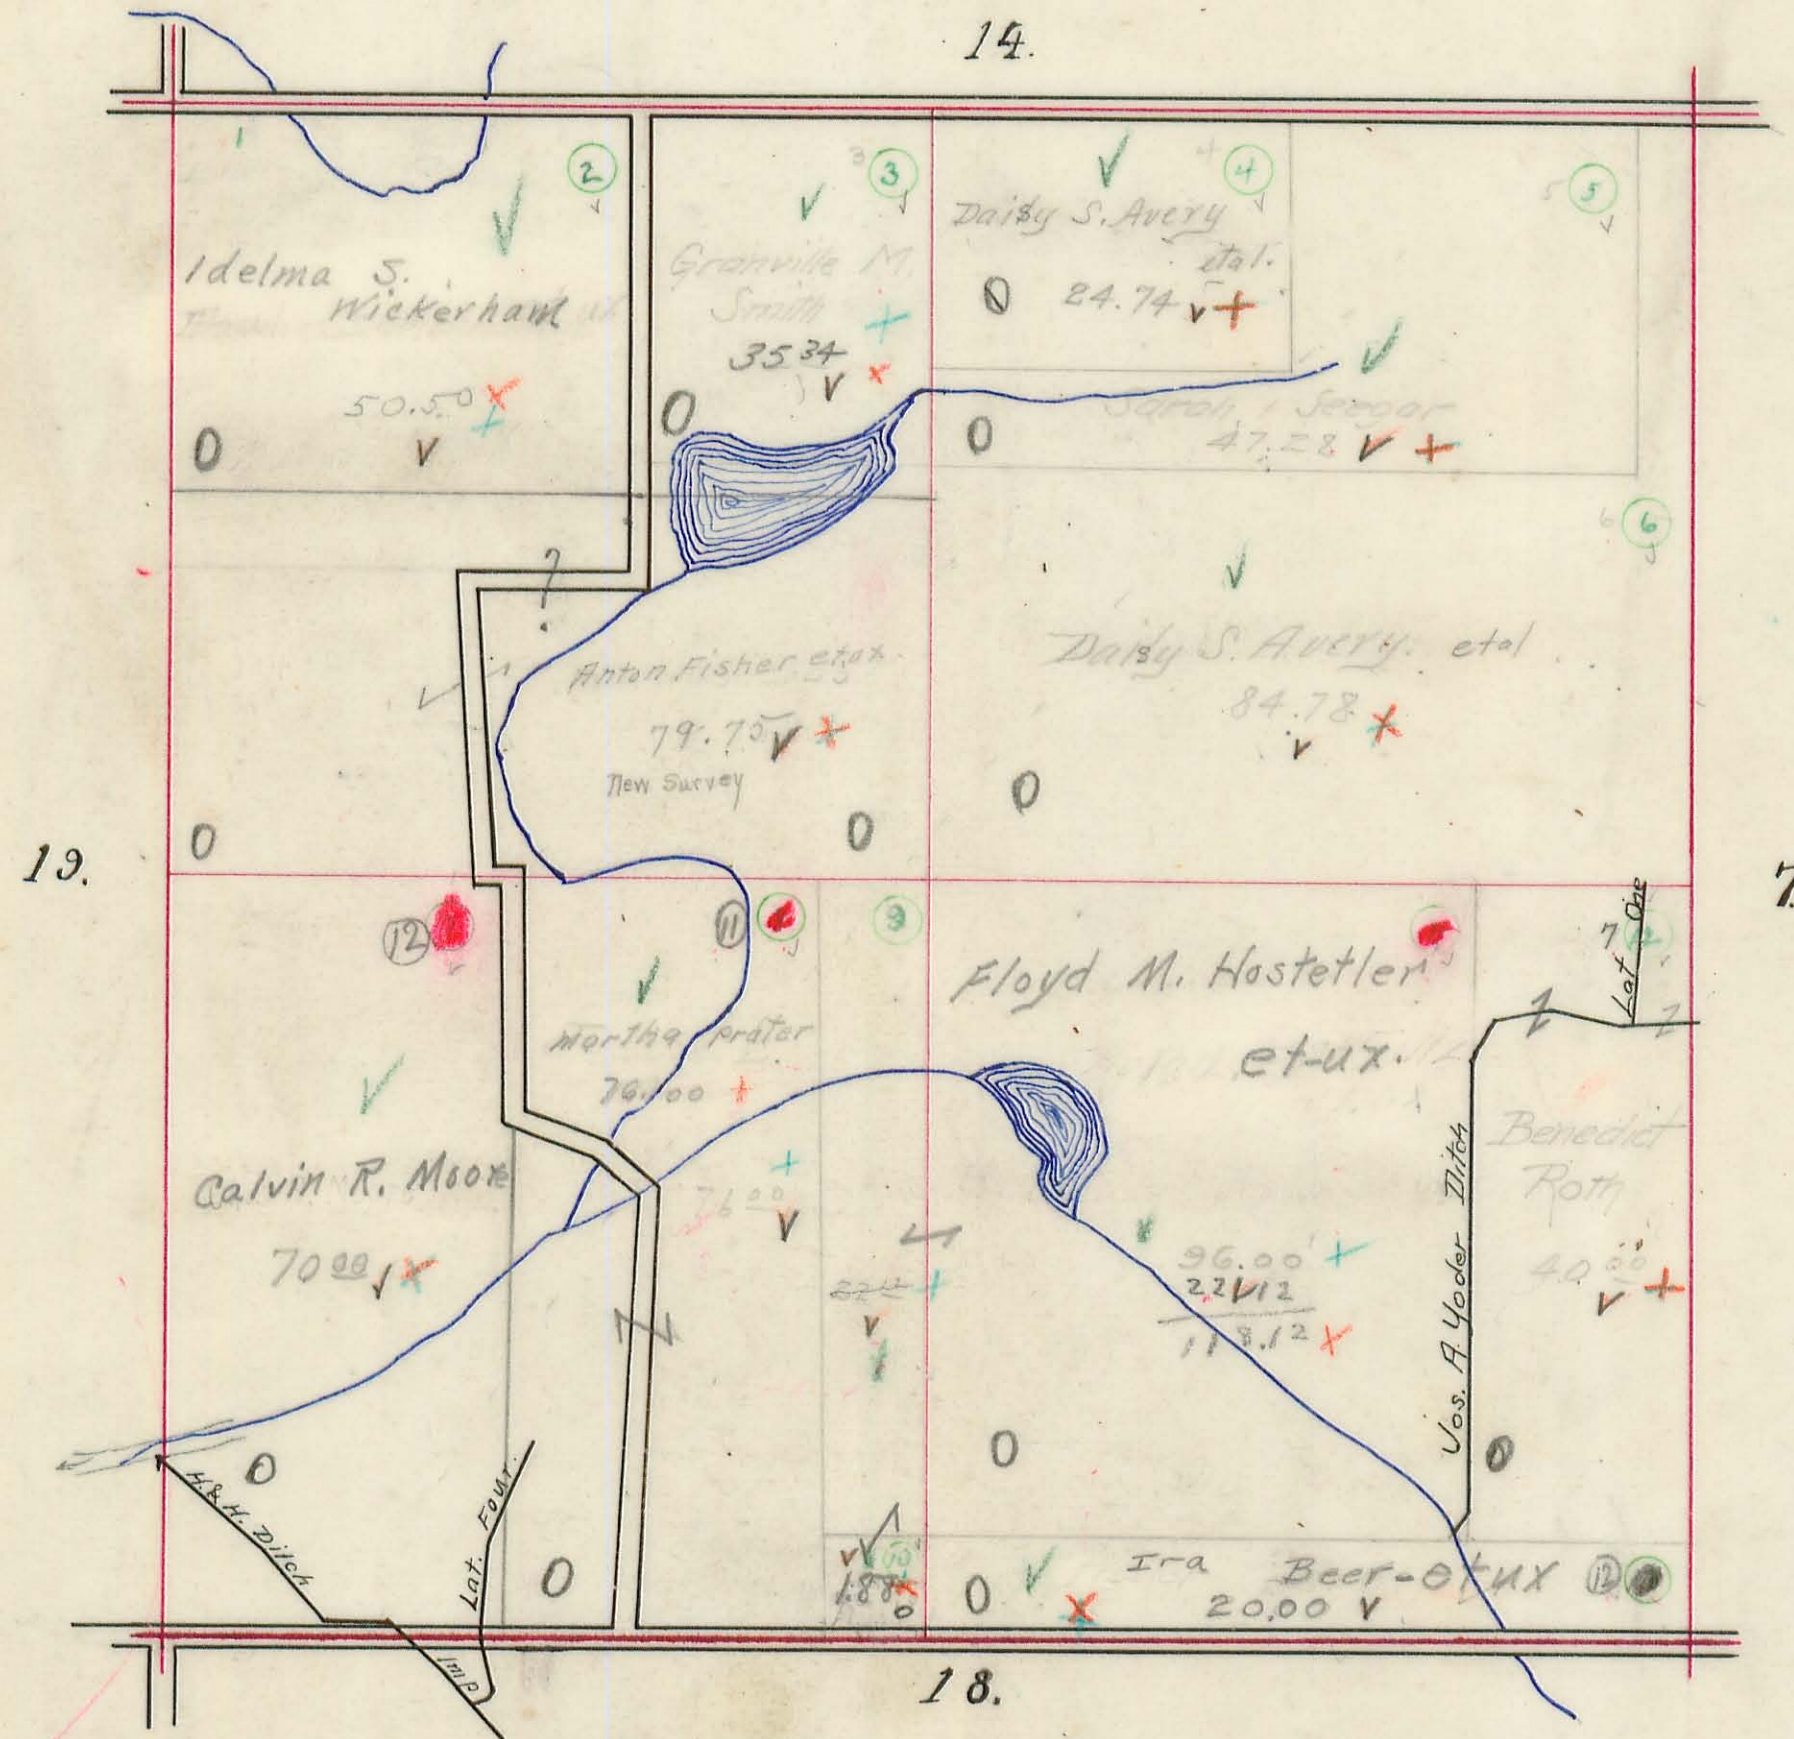


checked

UNION TOWNSHIP.

Plat of Section 7, Town 3, Range 14.

Scale 10 Chains Per Inch.

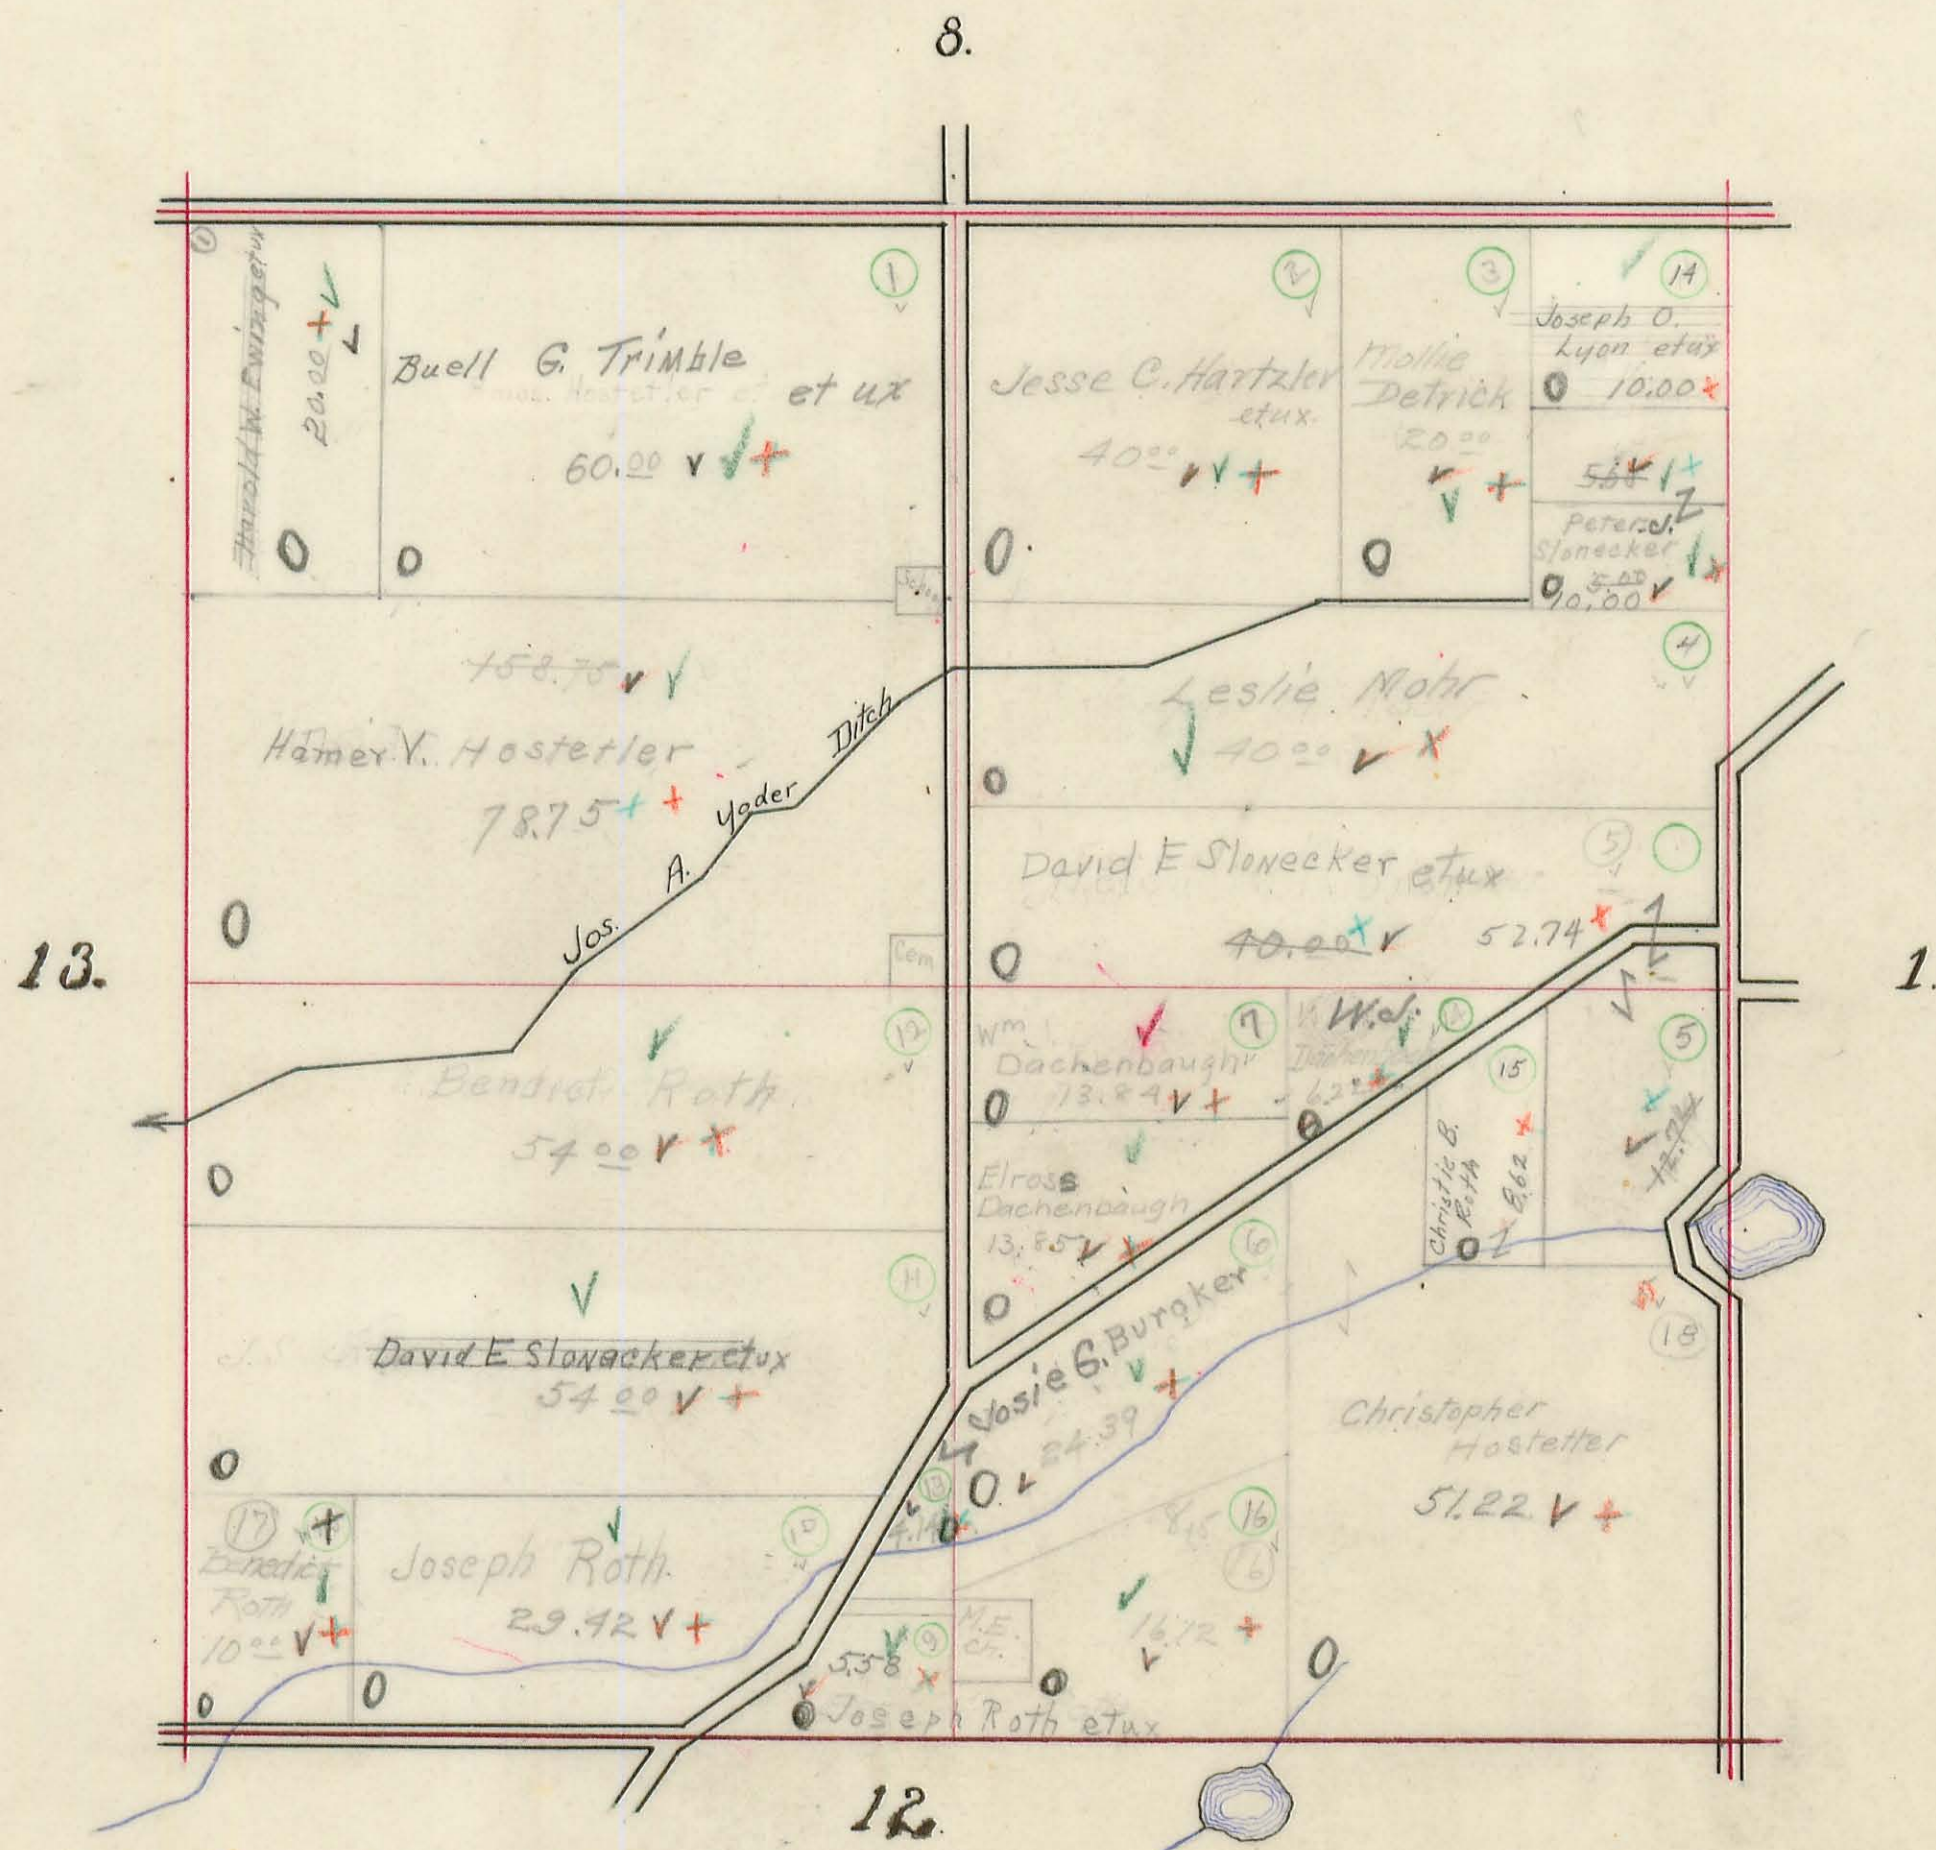


Checked

UNION TOWNSHIP.

Plat of Section 30, Town 4, Range 13.

Scale 10 Chains Per Inch.

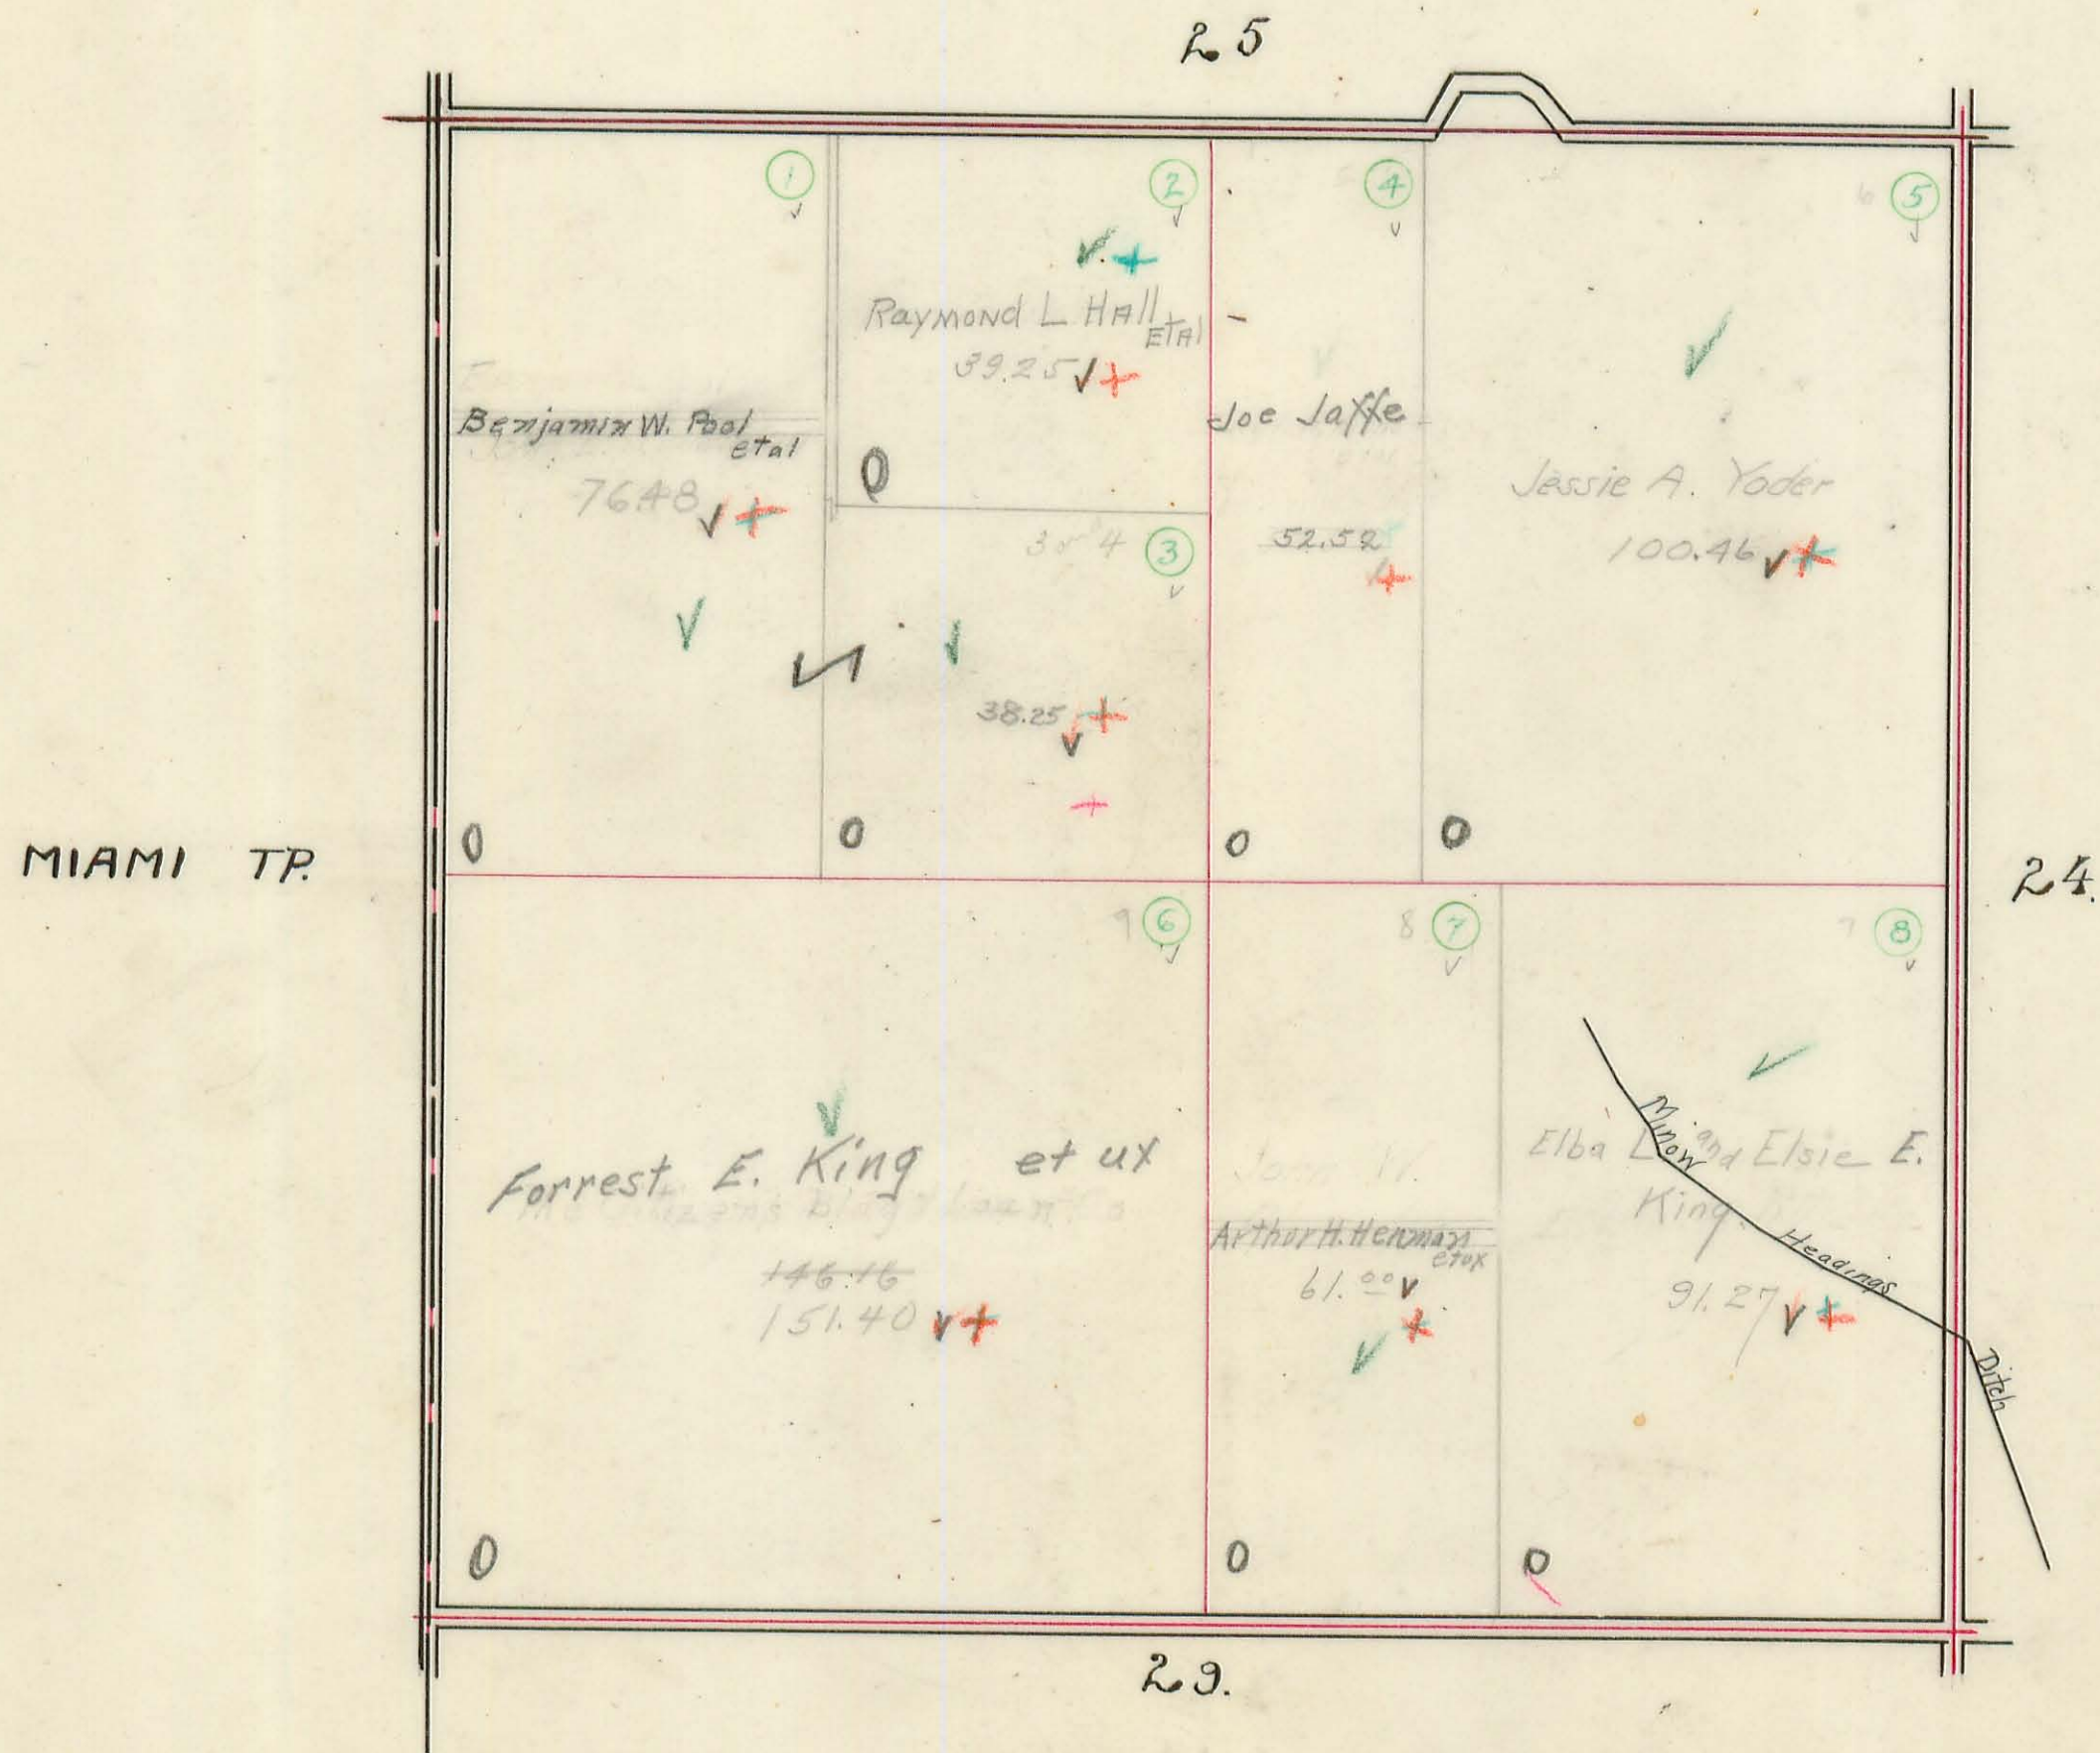


Checked

UNION TOWNSHIP.

Plat of Section 24 Town 4 Range 13

Scale 10 Chains Per Inch.

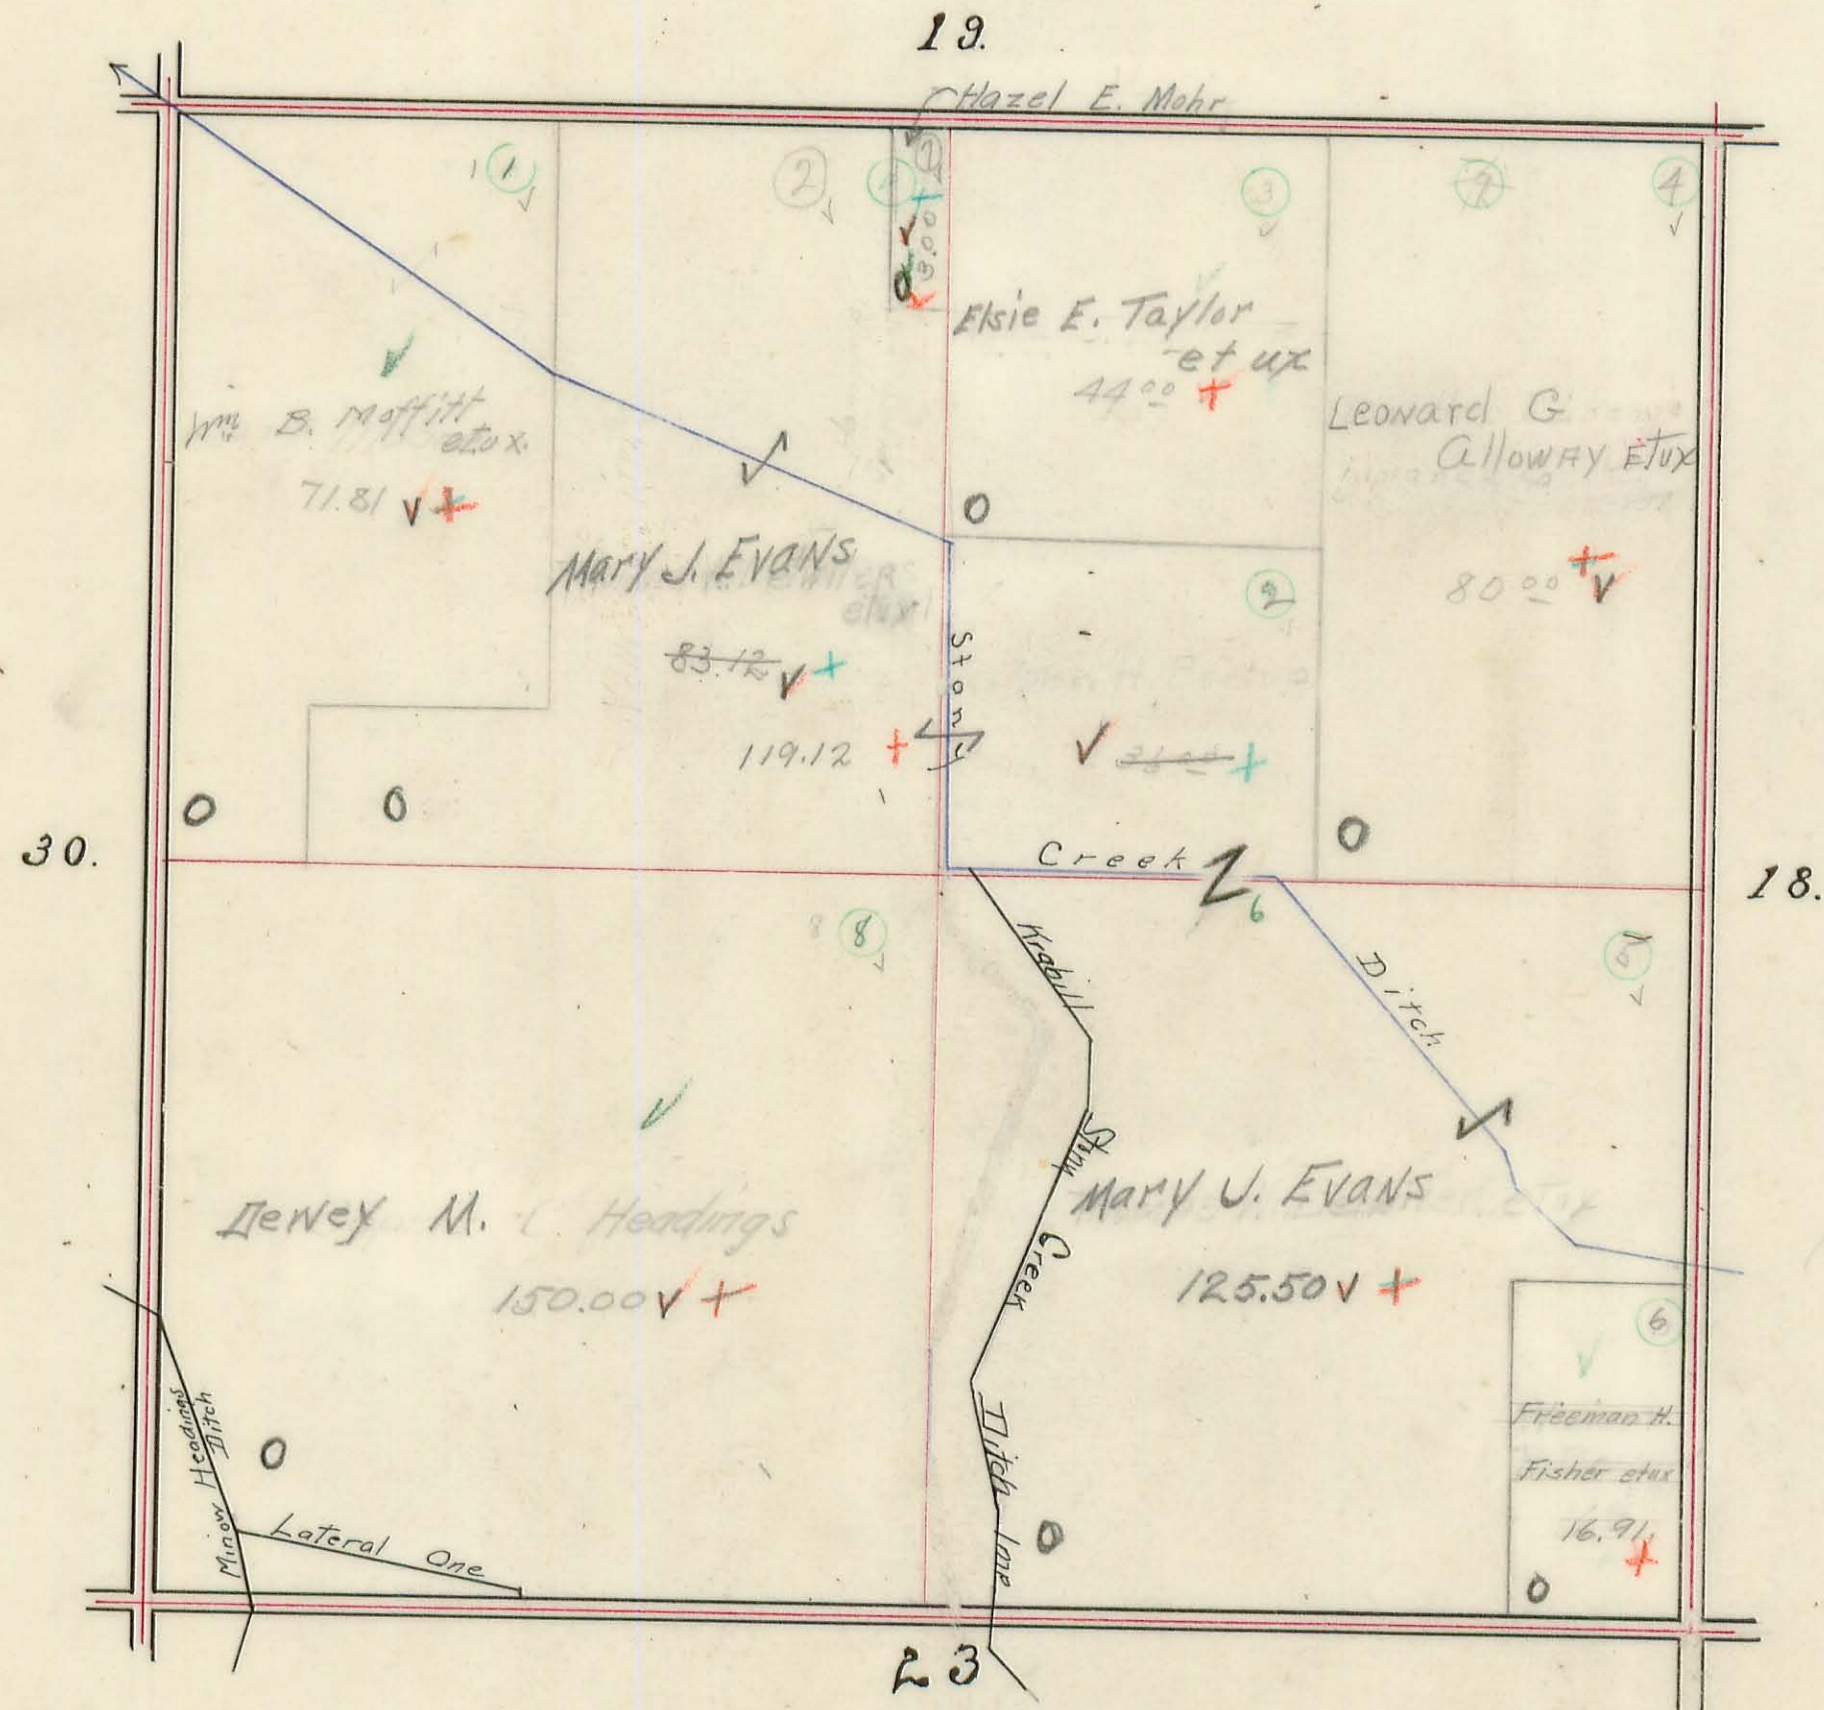


Checked

UNION TOWNSHIP.

Plat of Section 18, Town 4, Range 13.

Scale 10 Chains Per Inch.

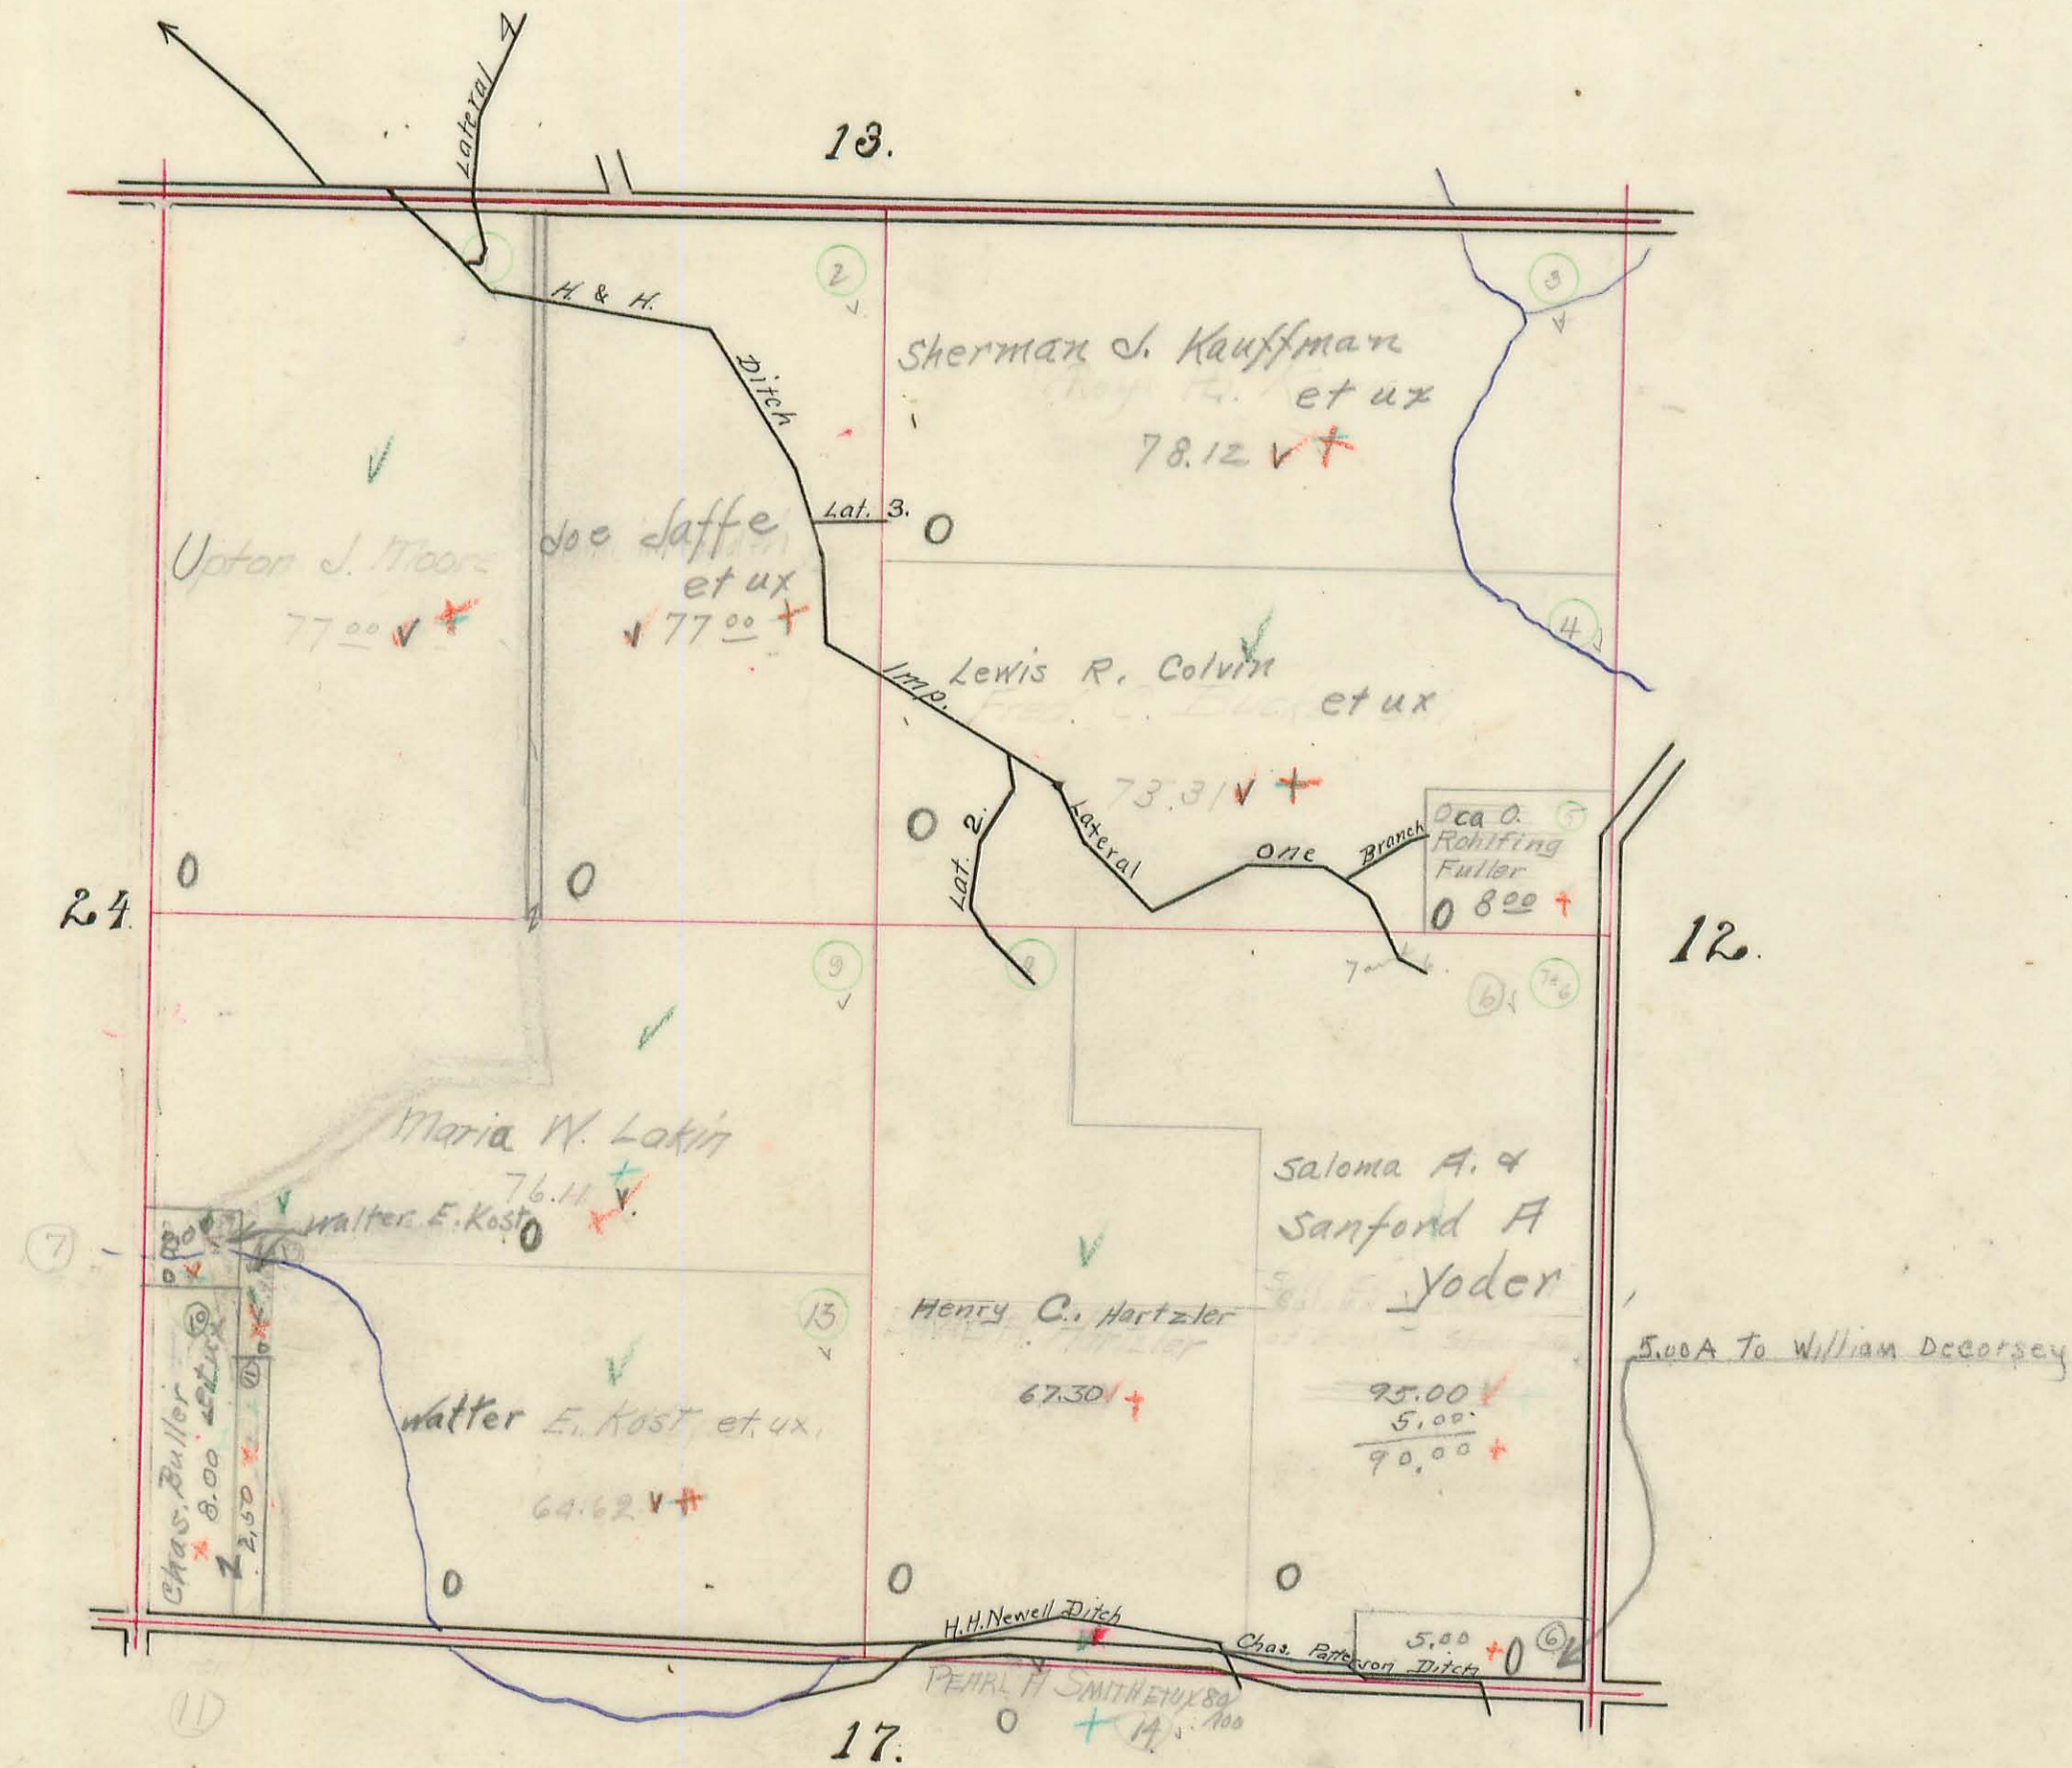


Checked

UNION TOWNSHIP.

Plat of Section 12 Town 4 Range 13

Scale 10 Chains Per Inch.

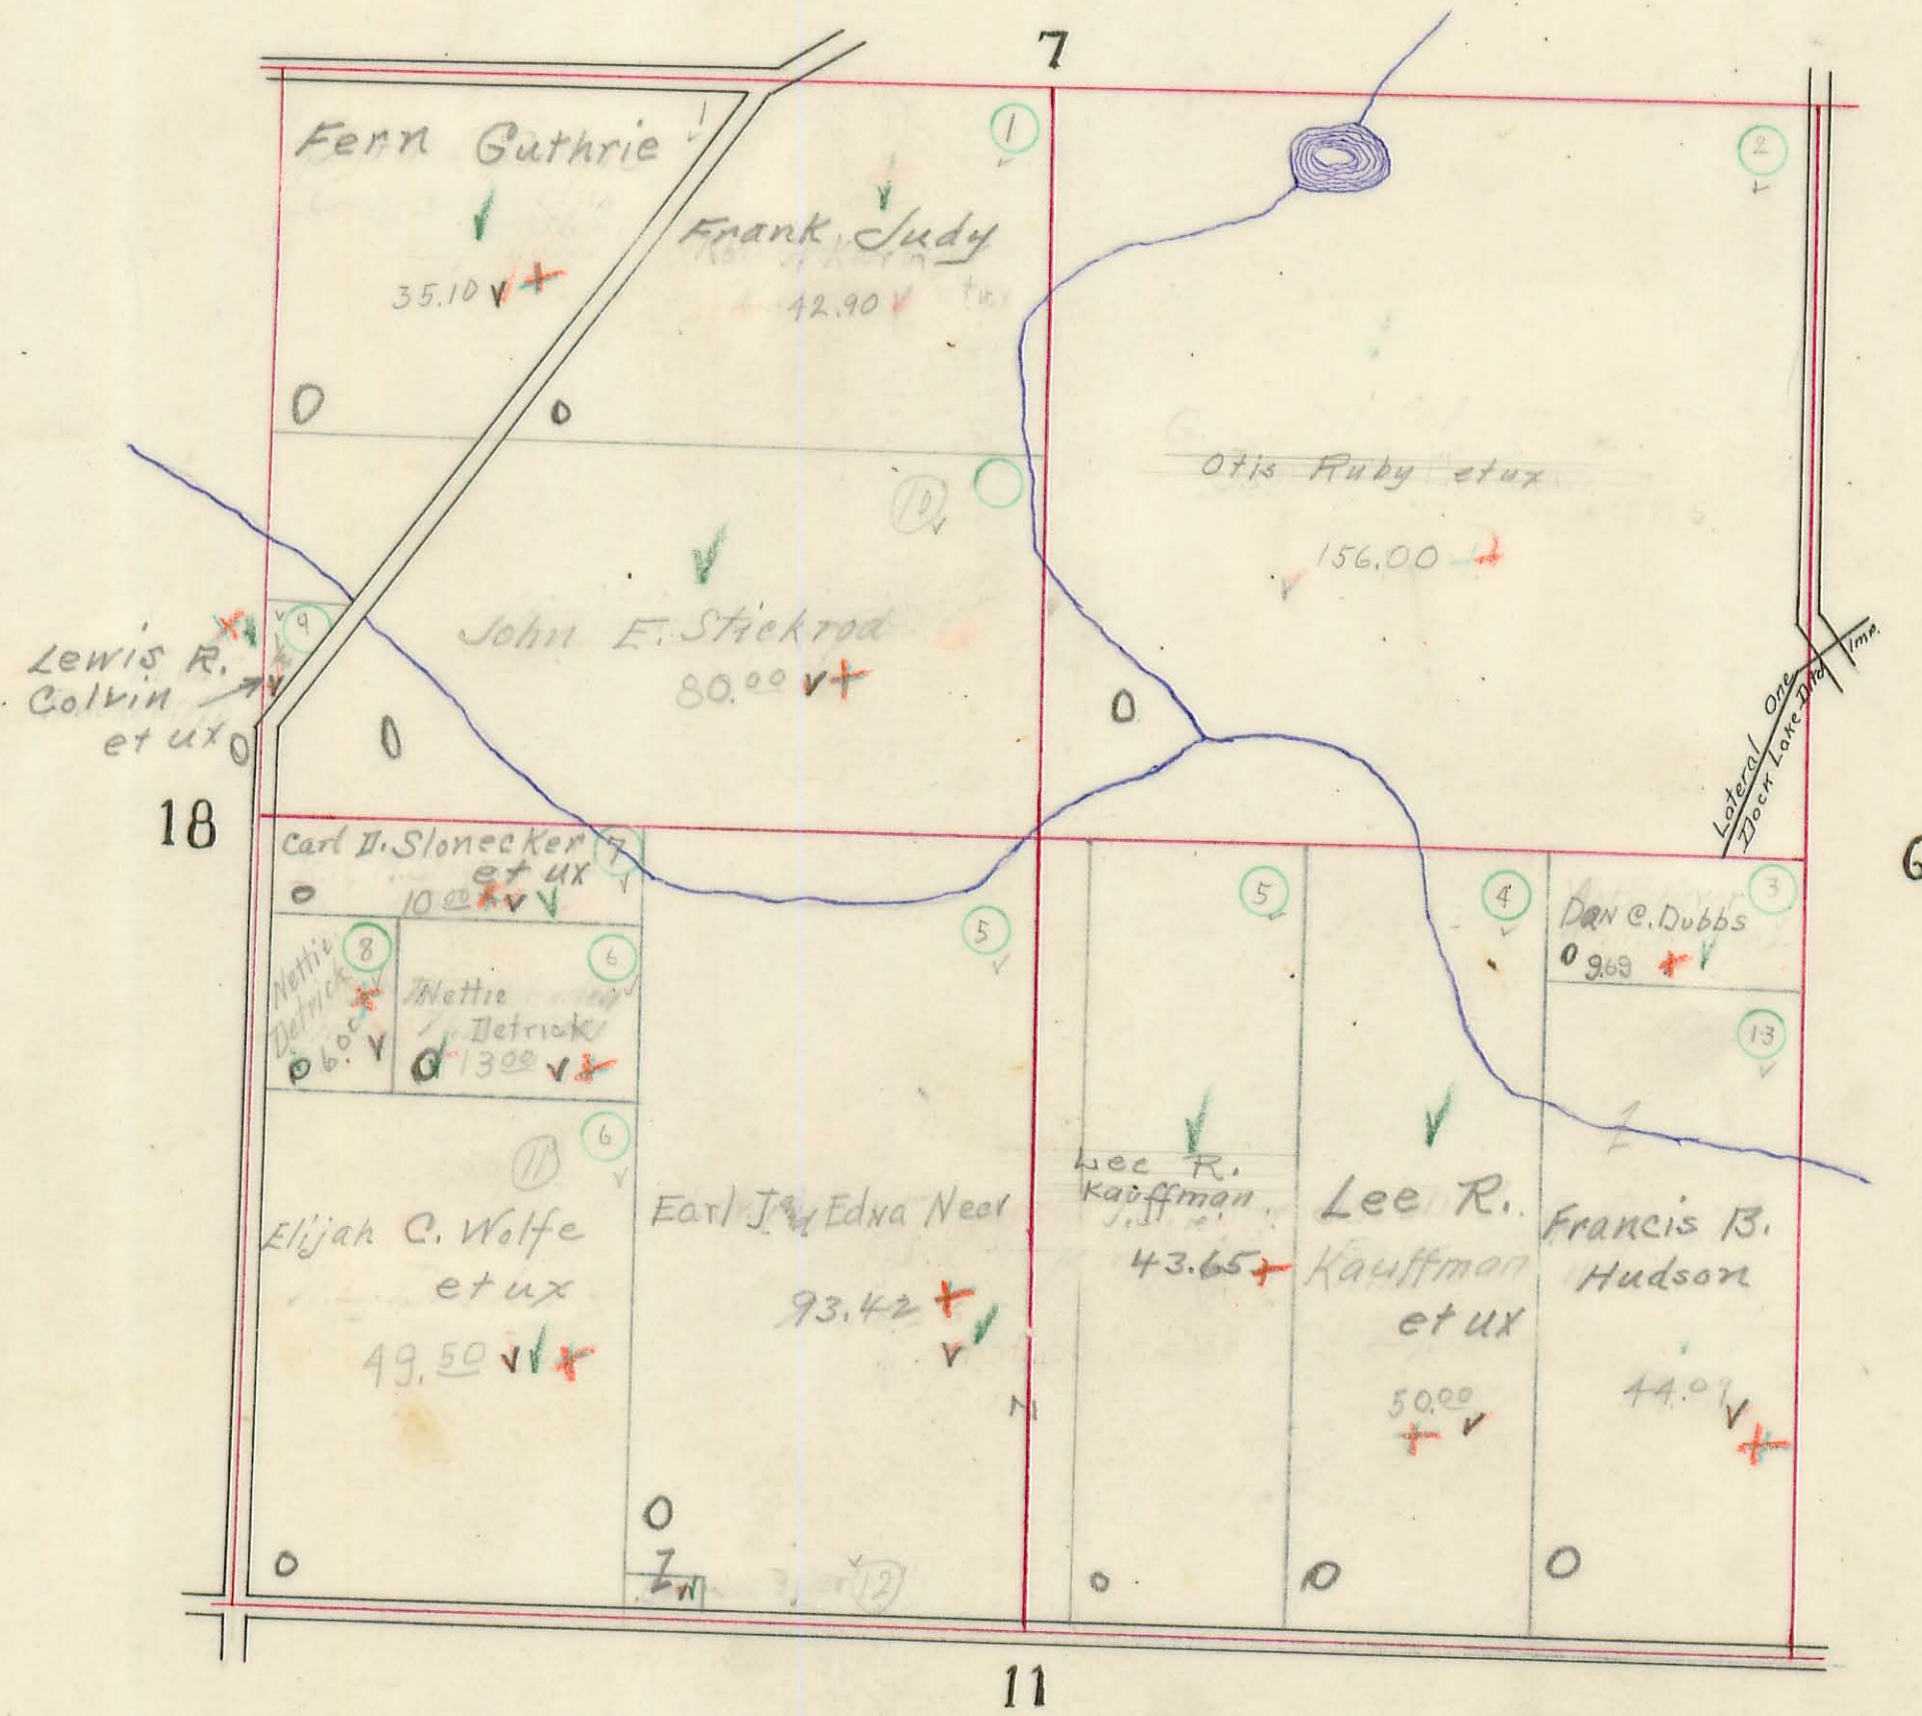

43.65
93.42
137.07

Checked

UNION TOWNSHIP.

Plat of Section 29, Town 4, Range 13.


Scale 10 Chains Per Inch.

30.

MIAMI TR.

23.

28.

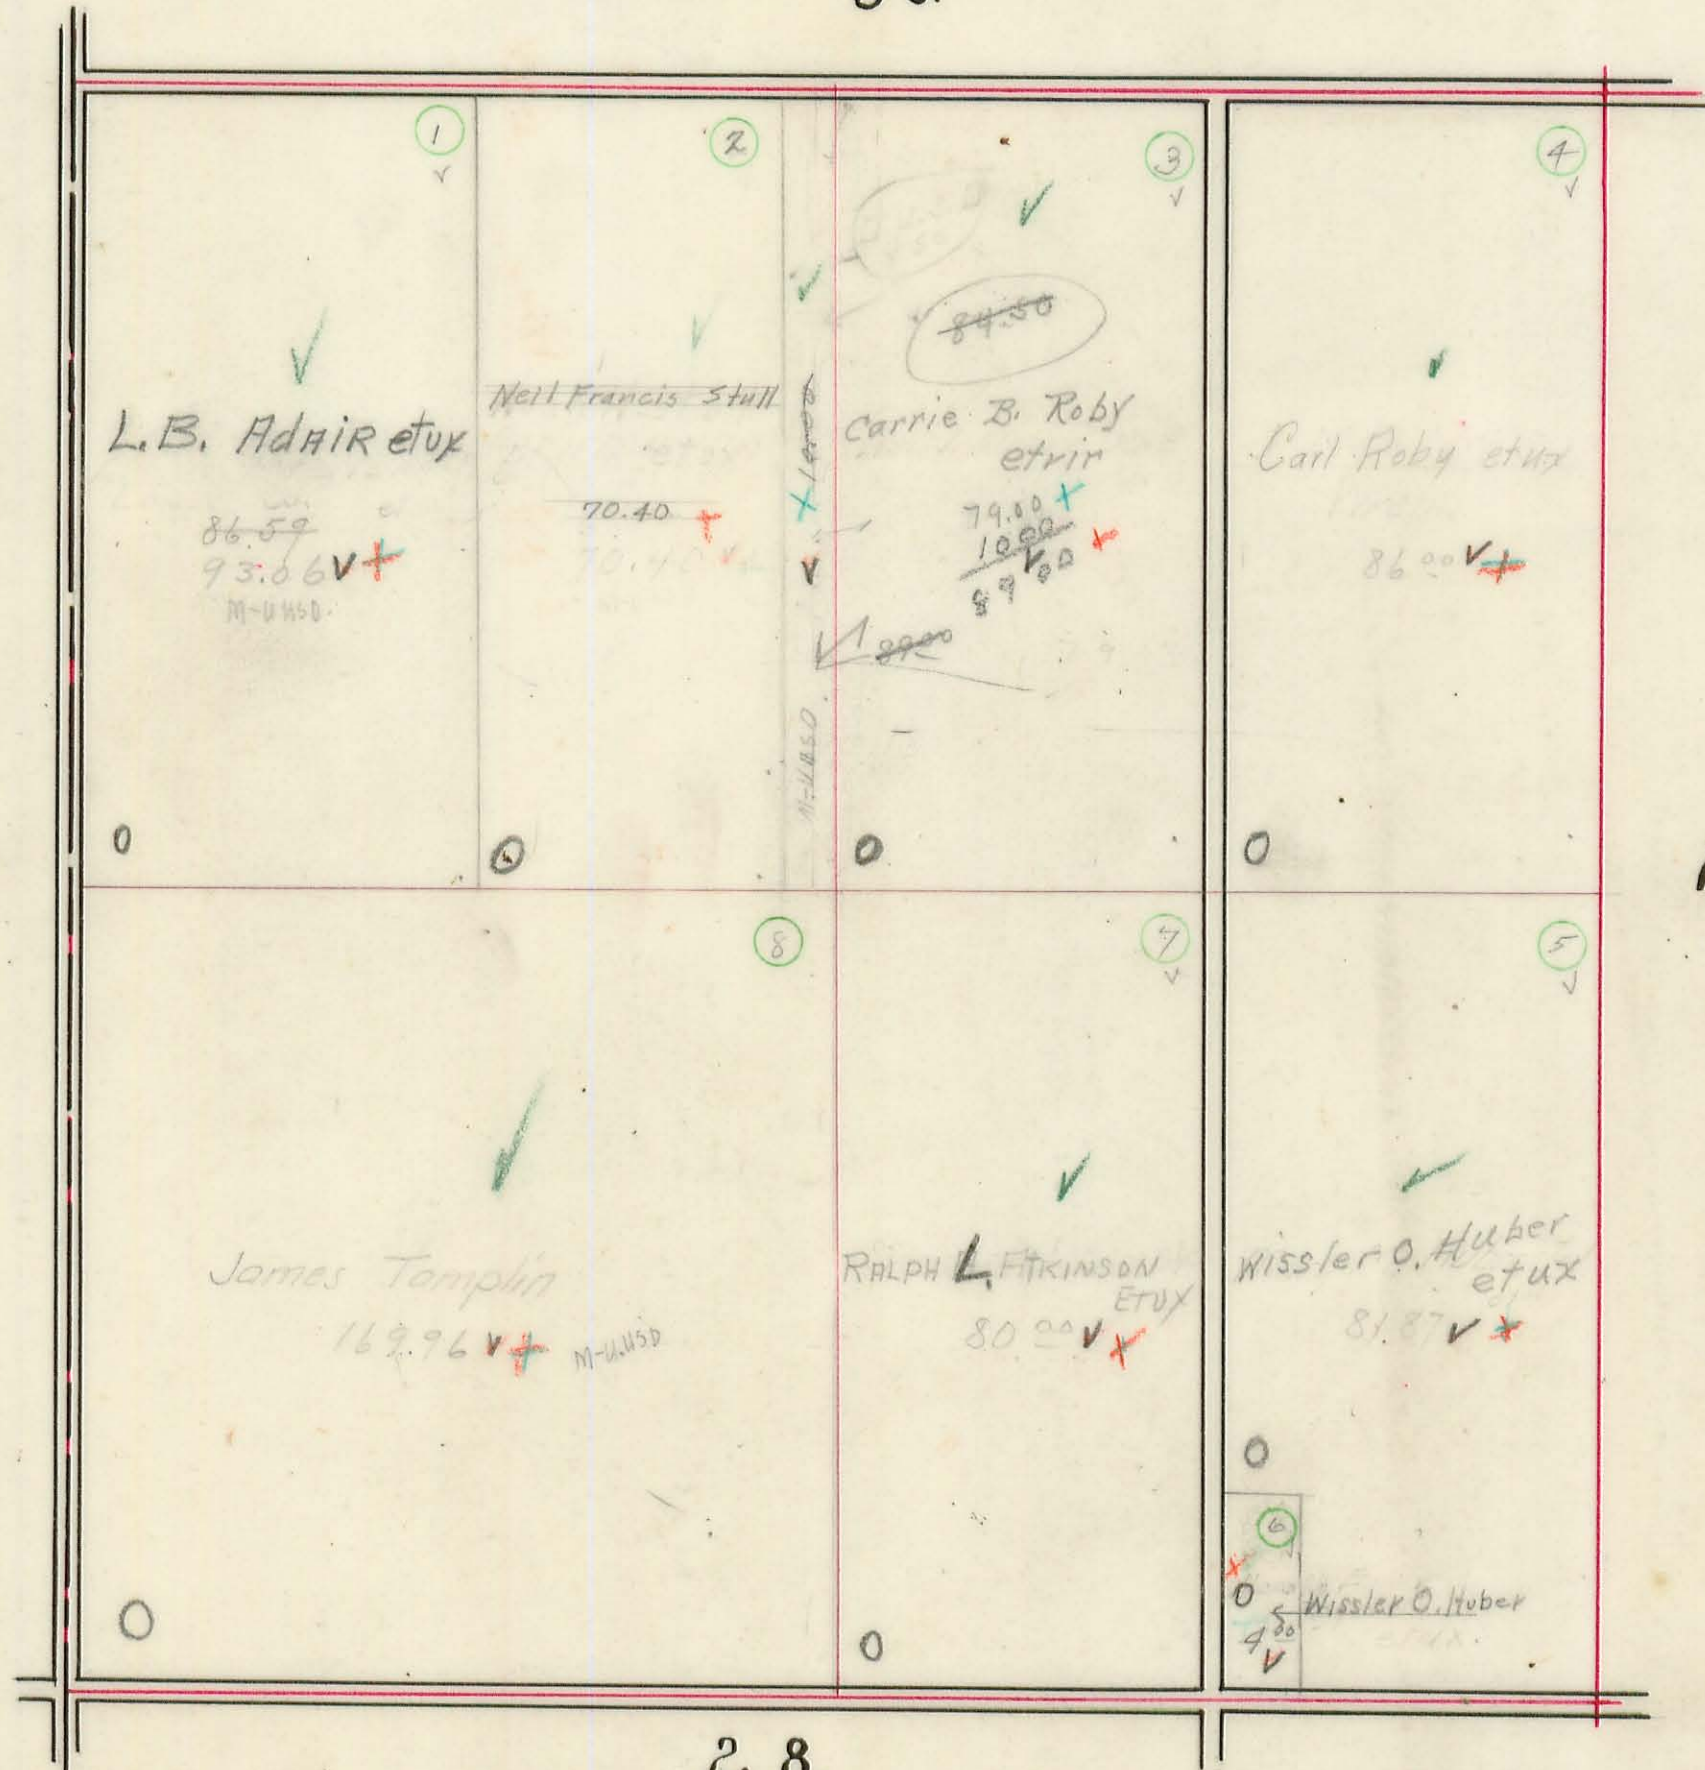


Checked

UNION TOWNSHIP.

Plat of Section 23, Town 4, Range 13

Scale 10 Chains Per Inch.

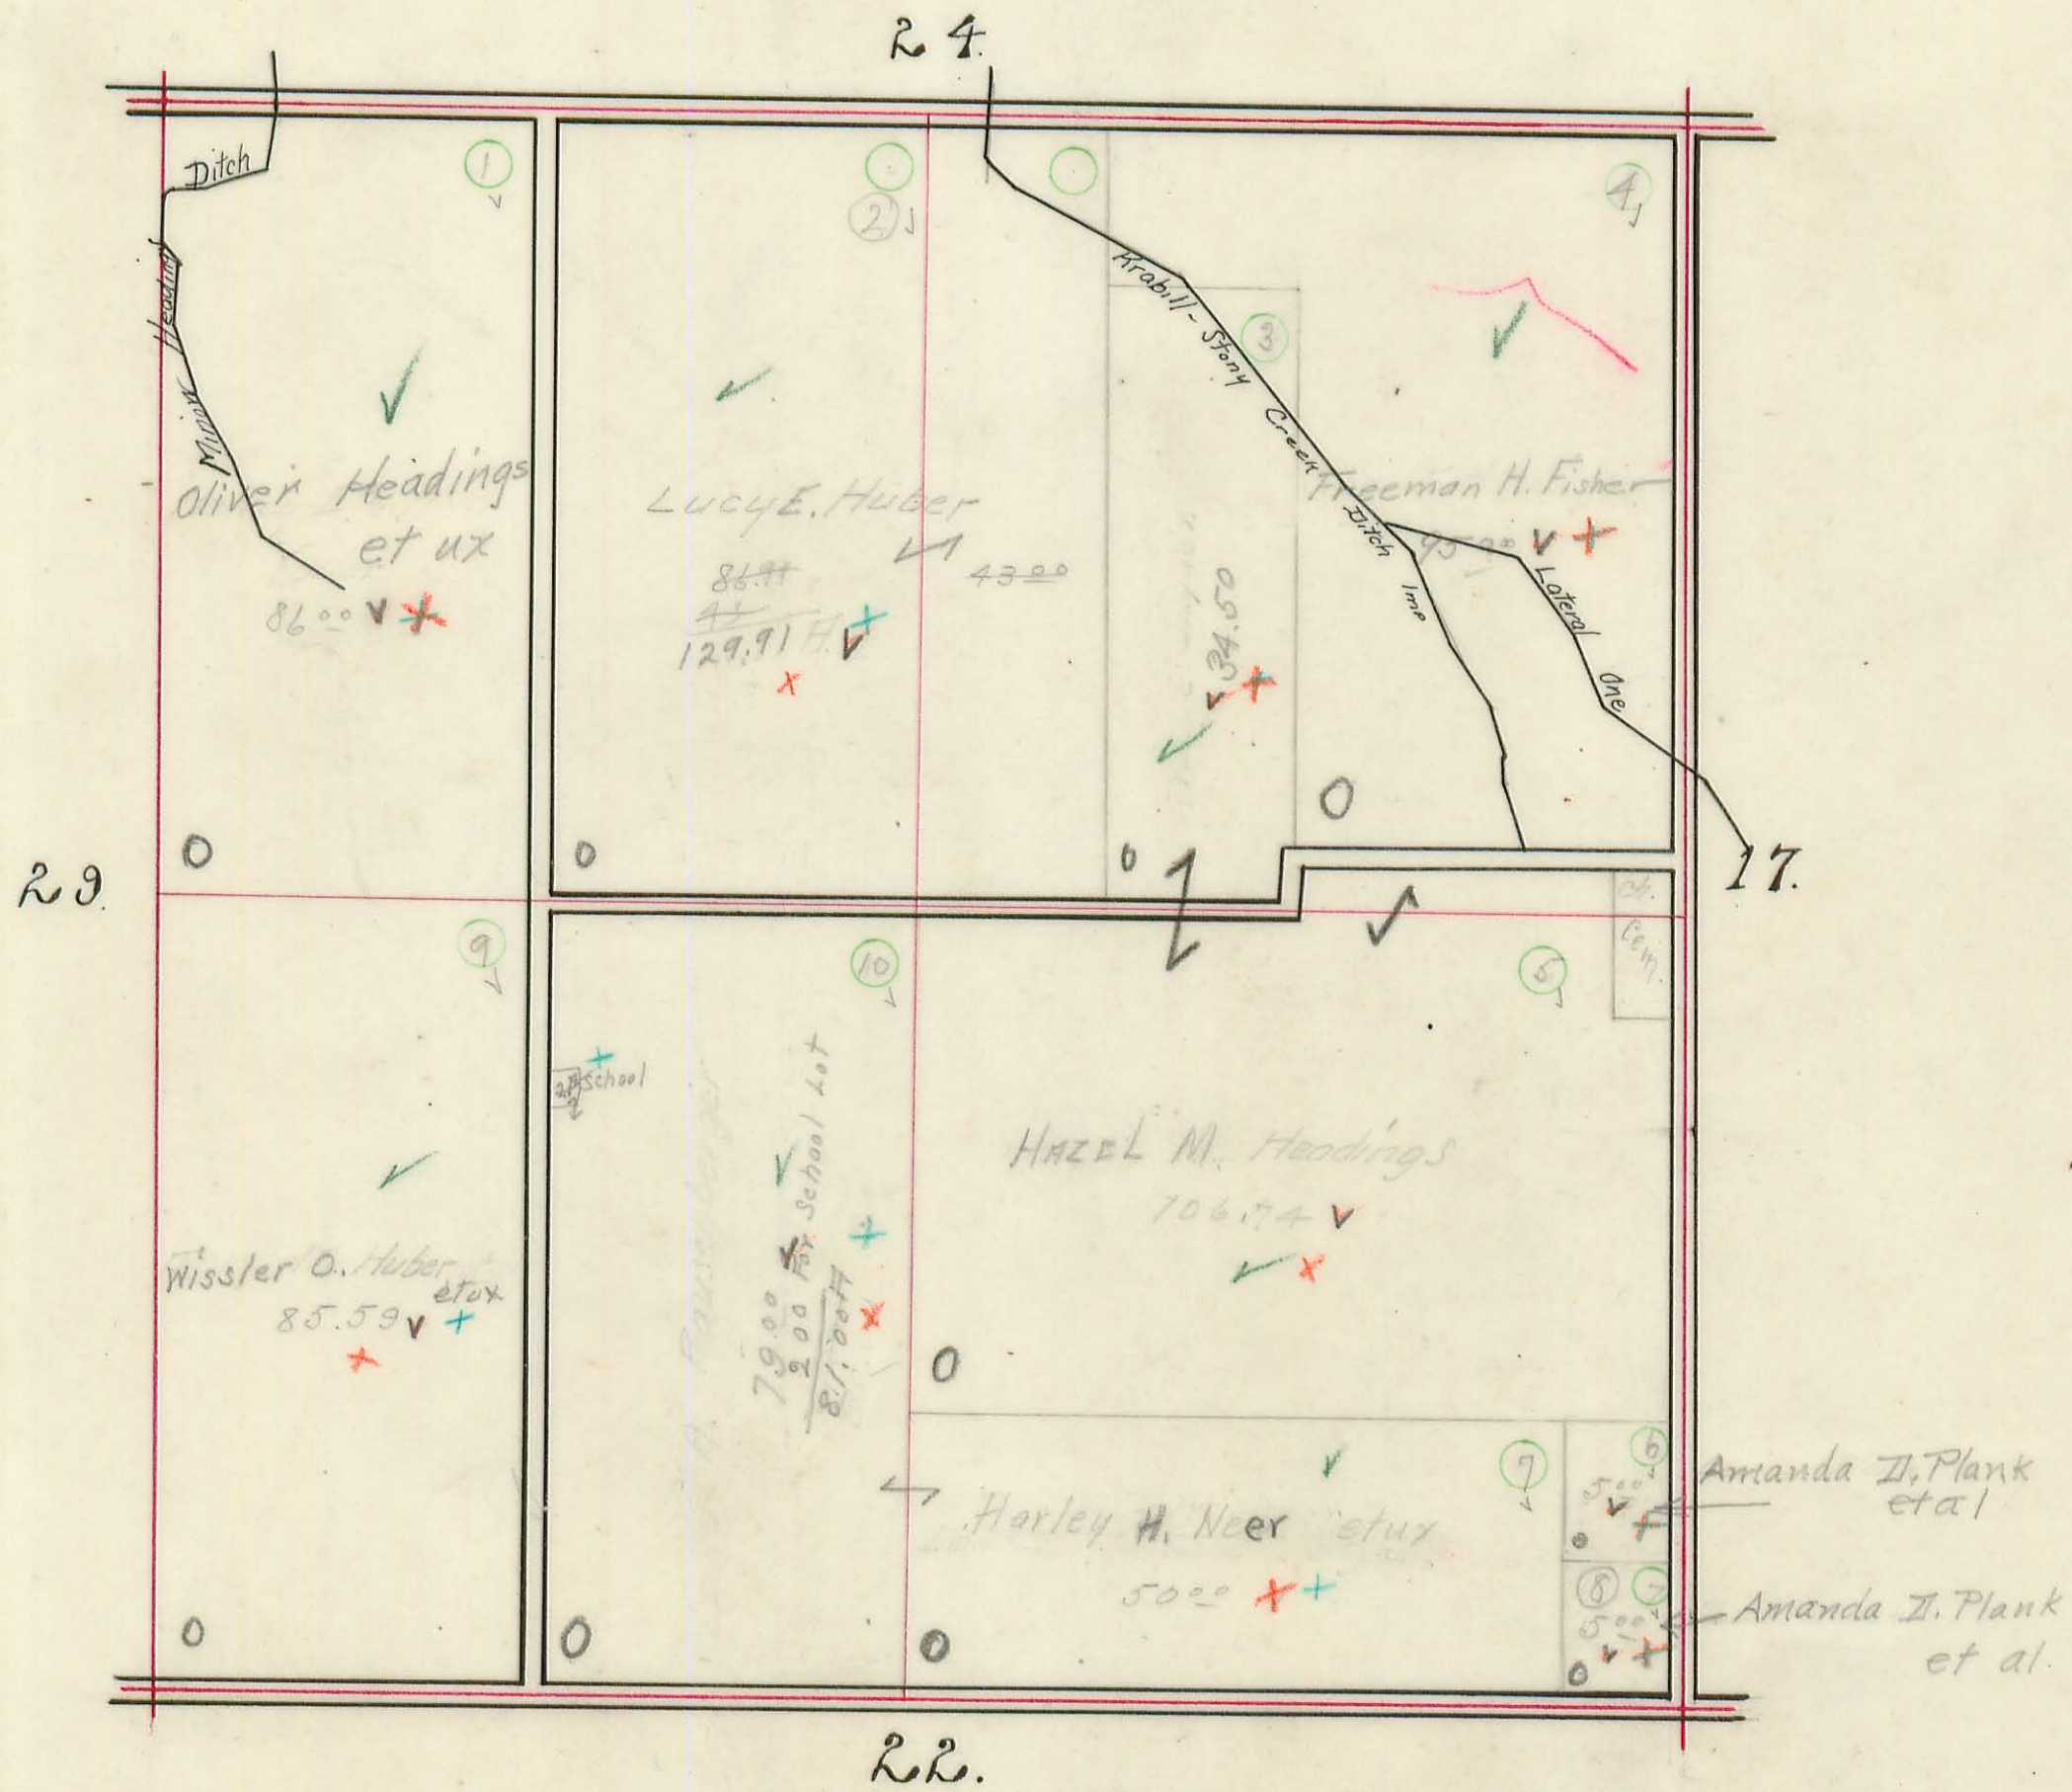


Checked

UNION TOWNSHIP.

Plat of Section 17, Town 4, Range 13.

Scale 10 Chains Per Inch.


18.

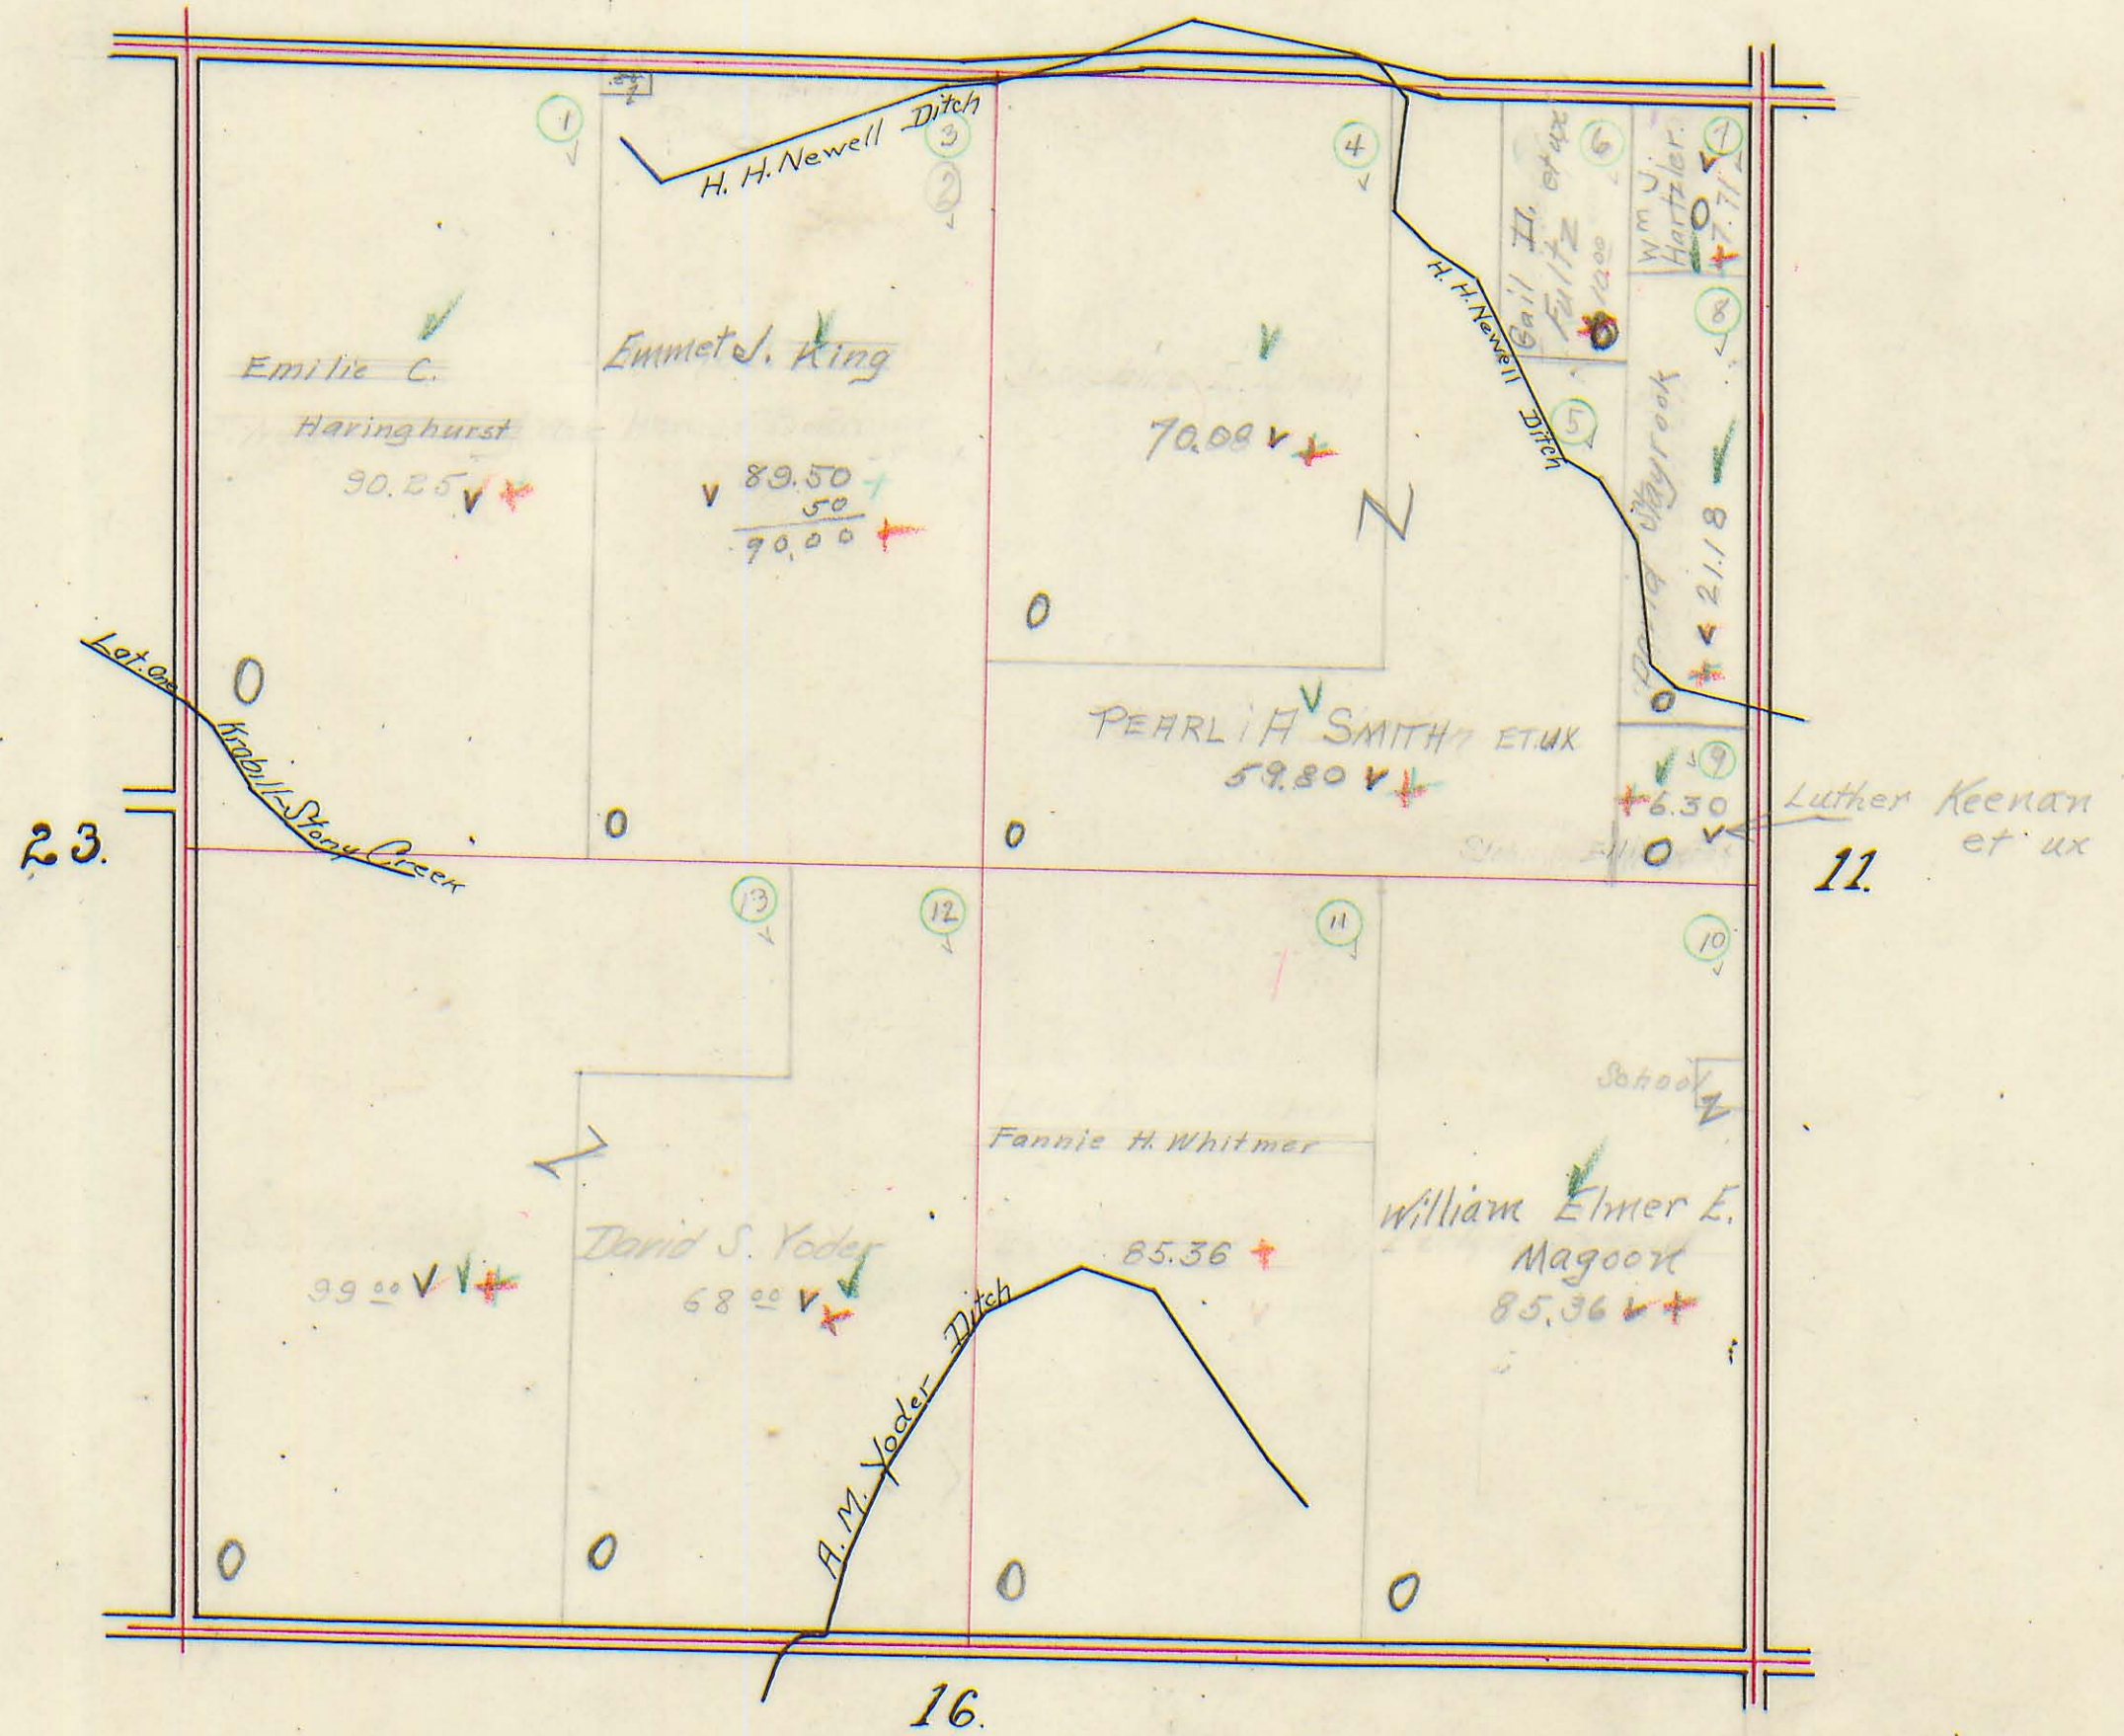

UNION TOWNSHIP.

Plat of Section 11 & 5, Town 4, Range 13

Scale 10 Chains Per Inch.

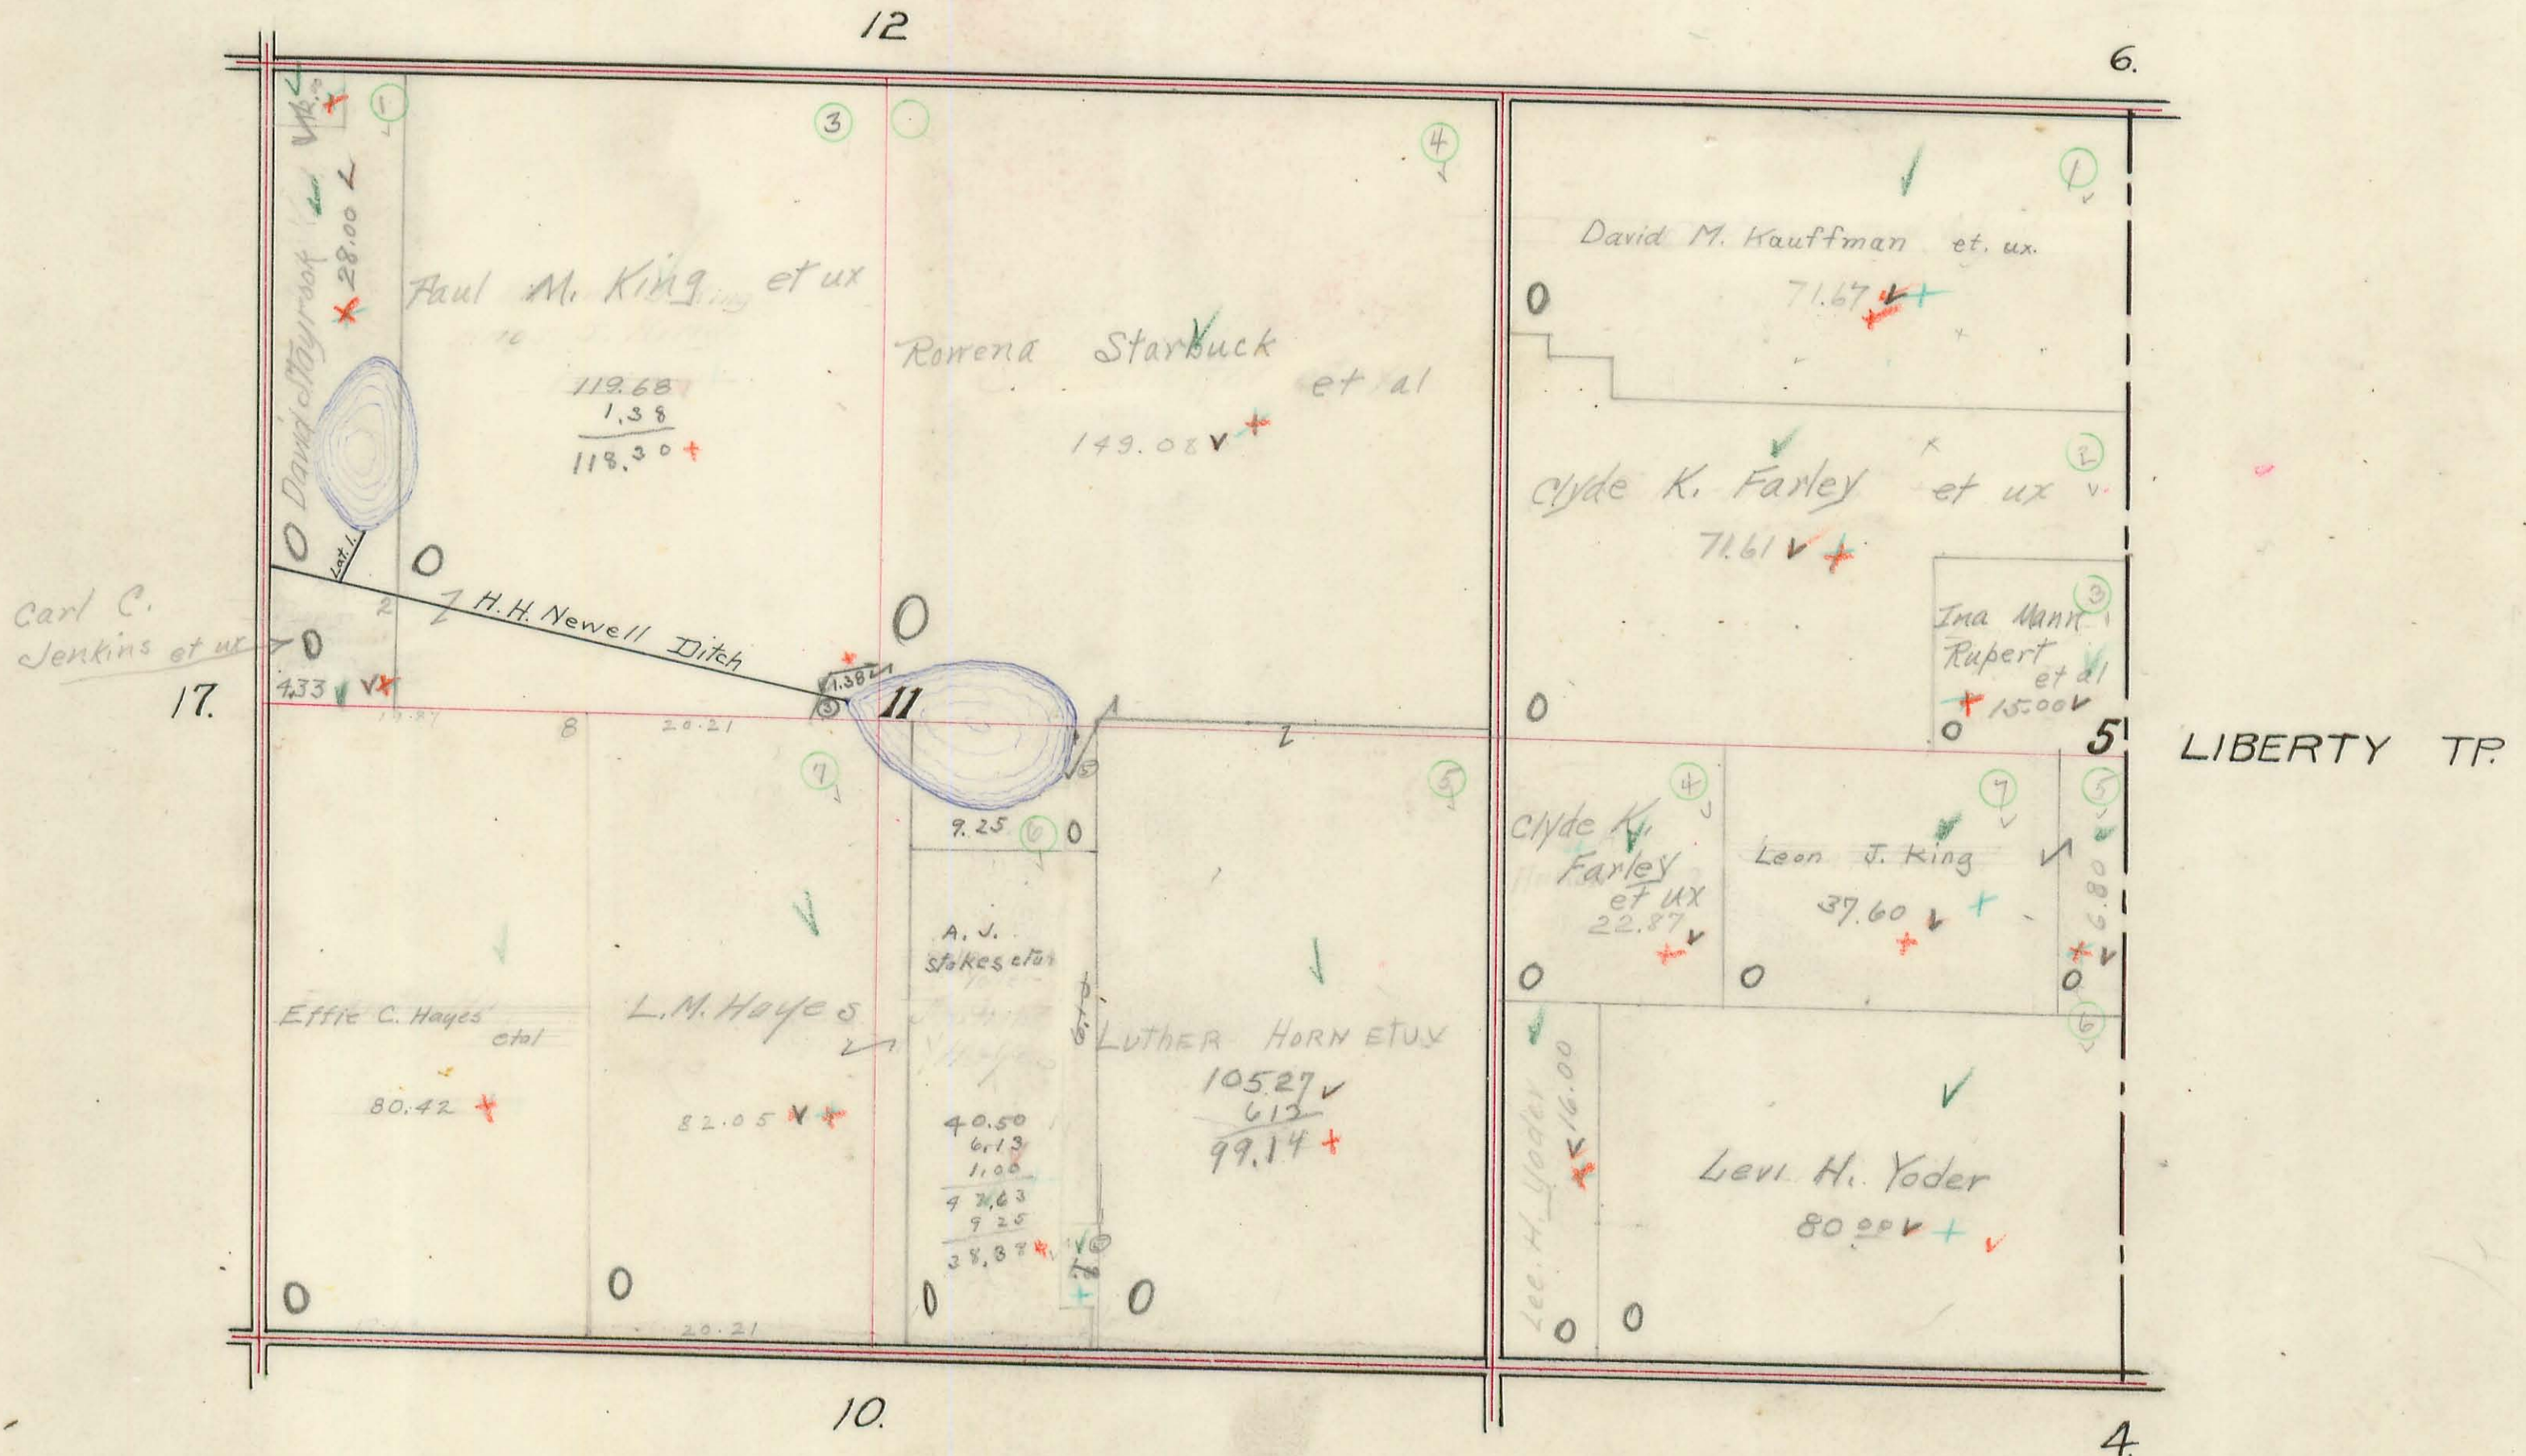


UNION TOWNSHIP.

Plat of Section 28, Town 4, Range 13

Scale 10 Chains Per Inch.

28.

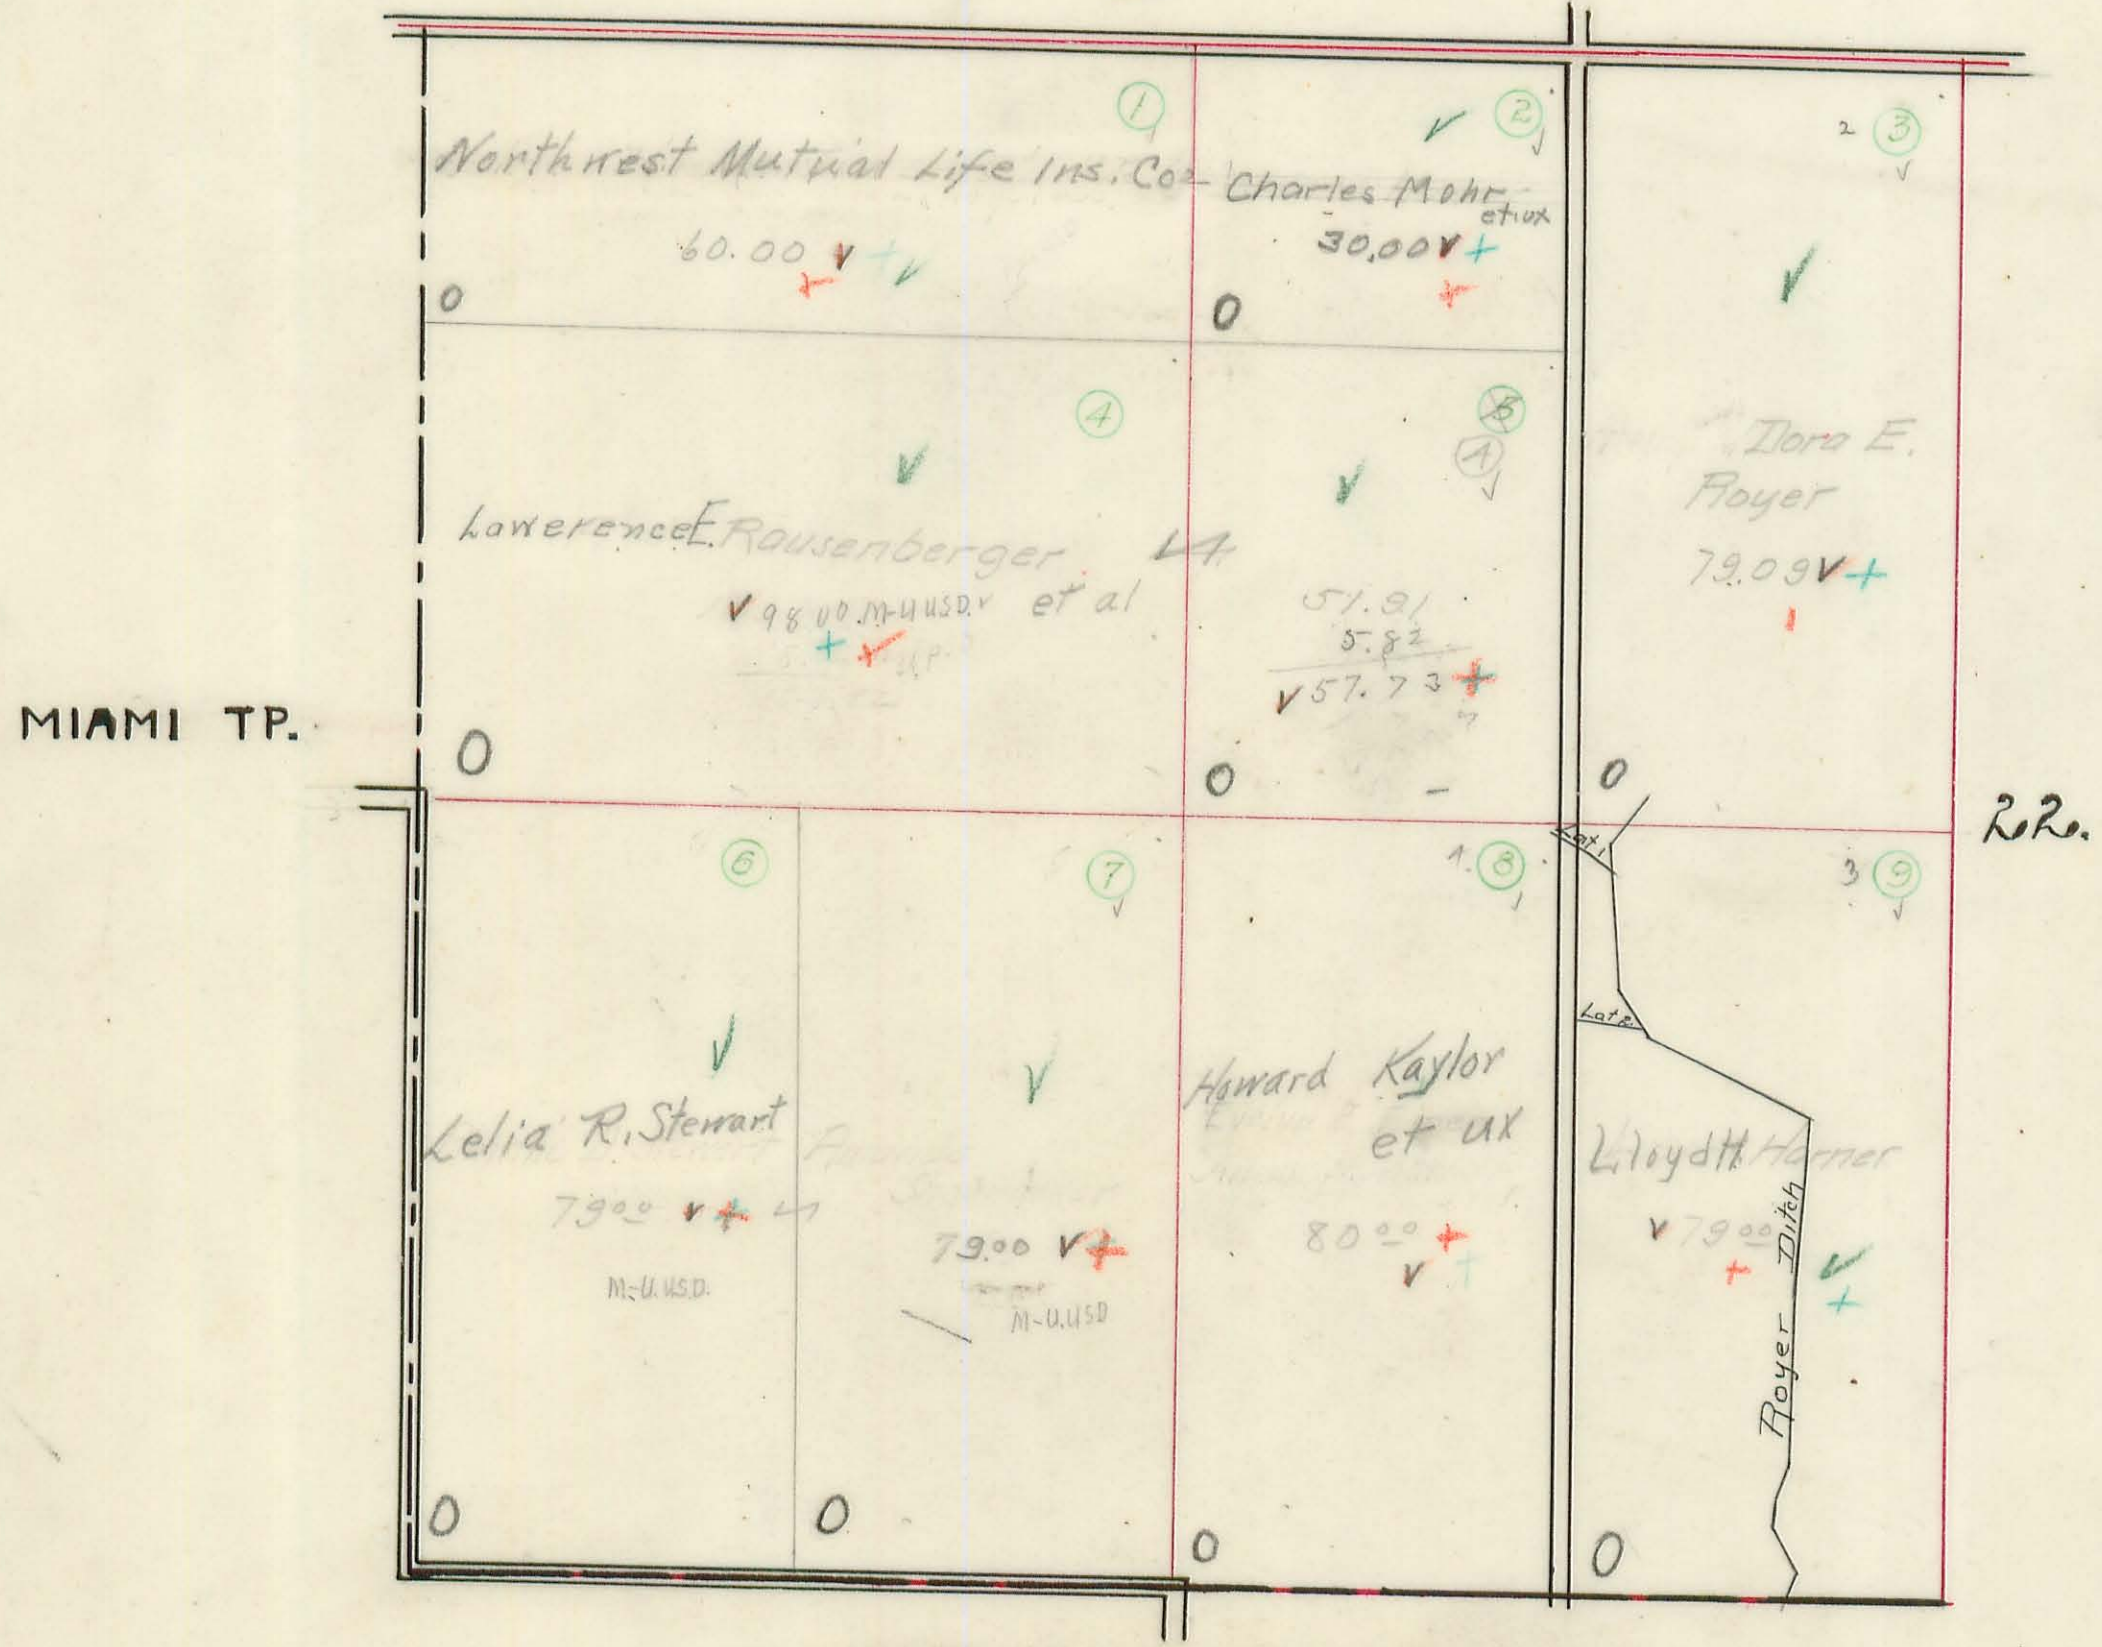


CHAMPAIGN COUNTY

UNION TOWNSHIP.

Plat of Section 22, Town 4, Range 13

Scale 10 Chains Per Inch.

1320
403
710

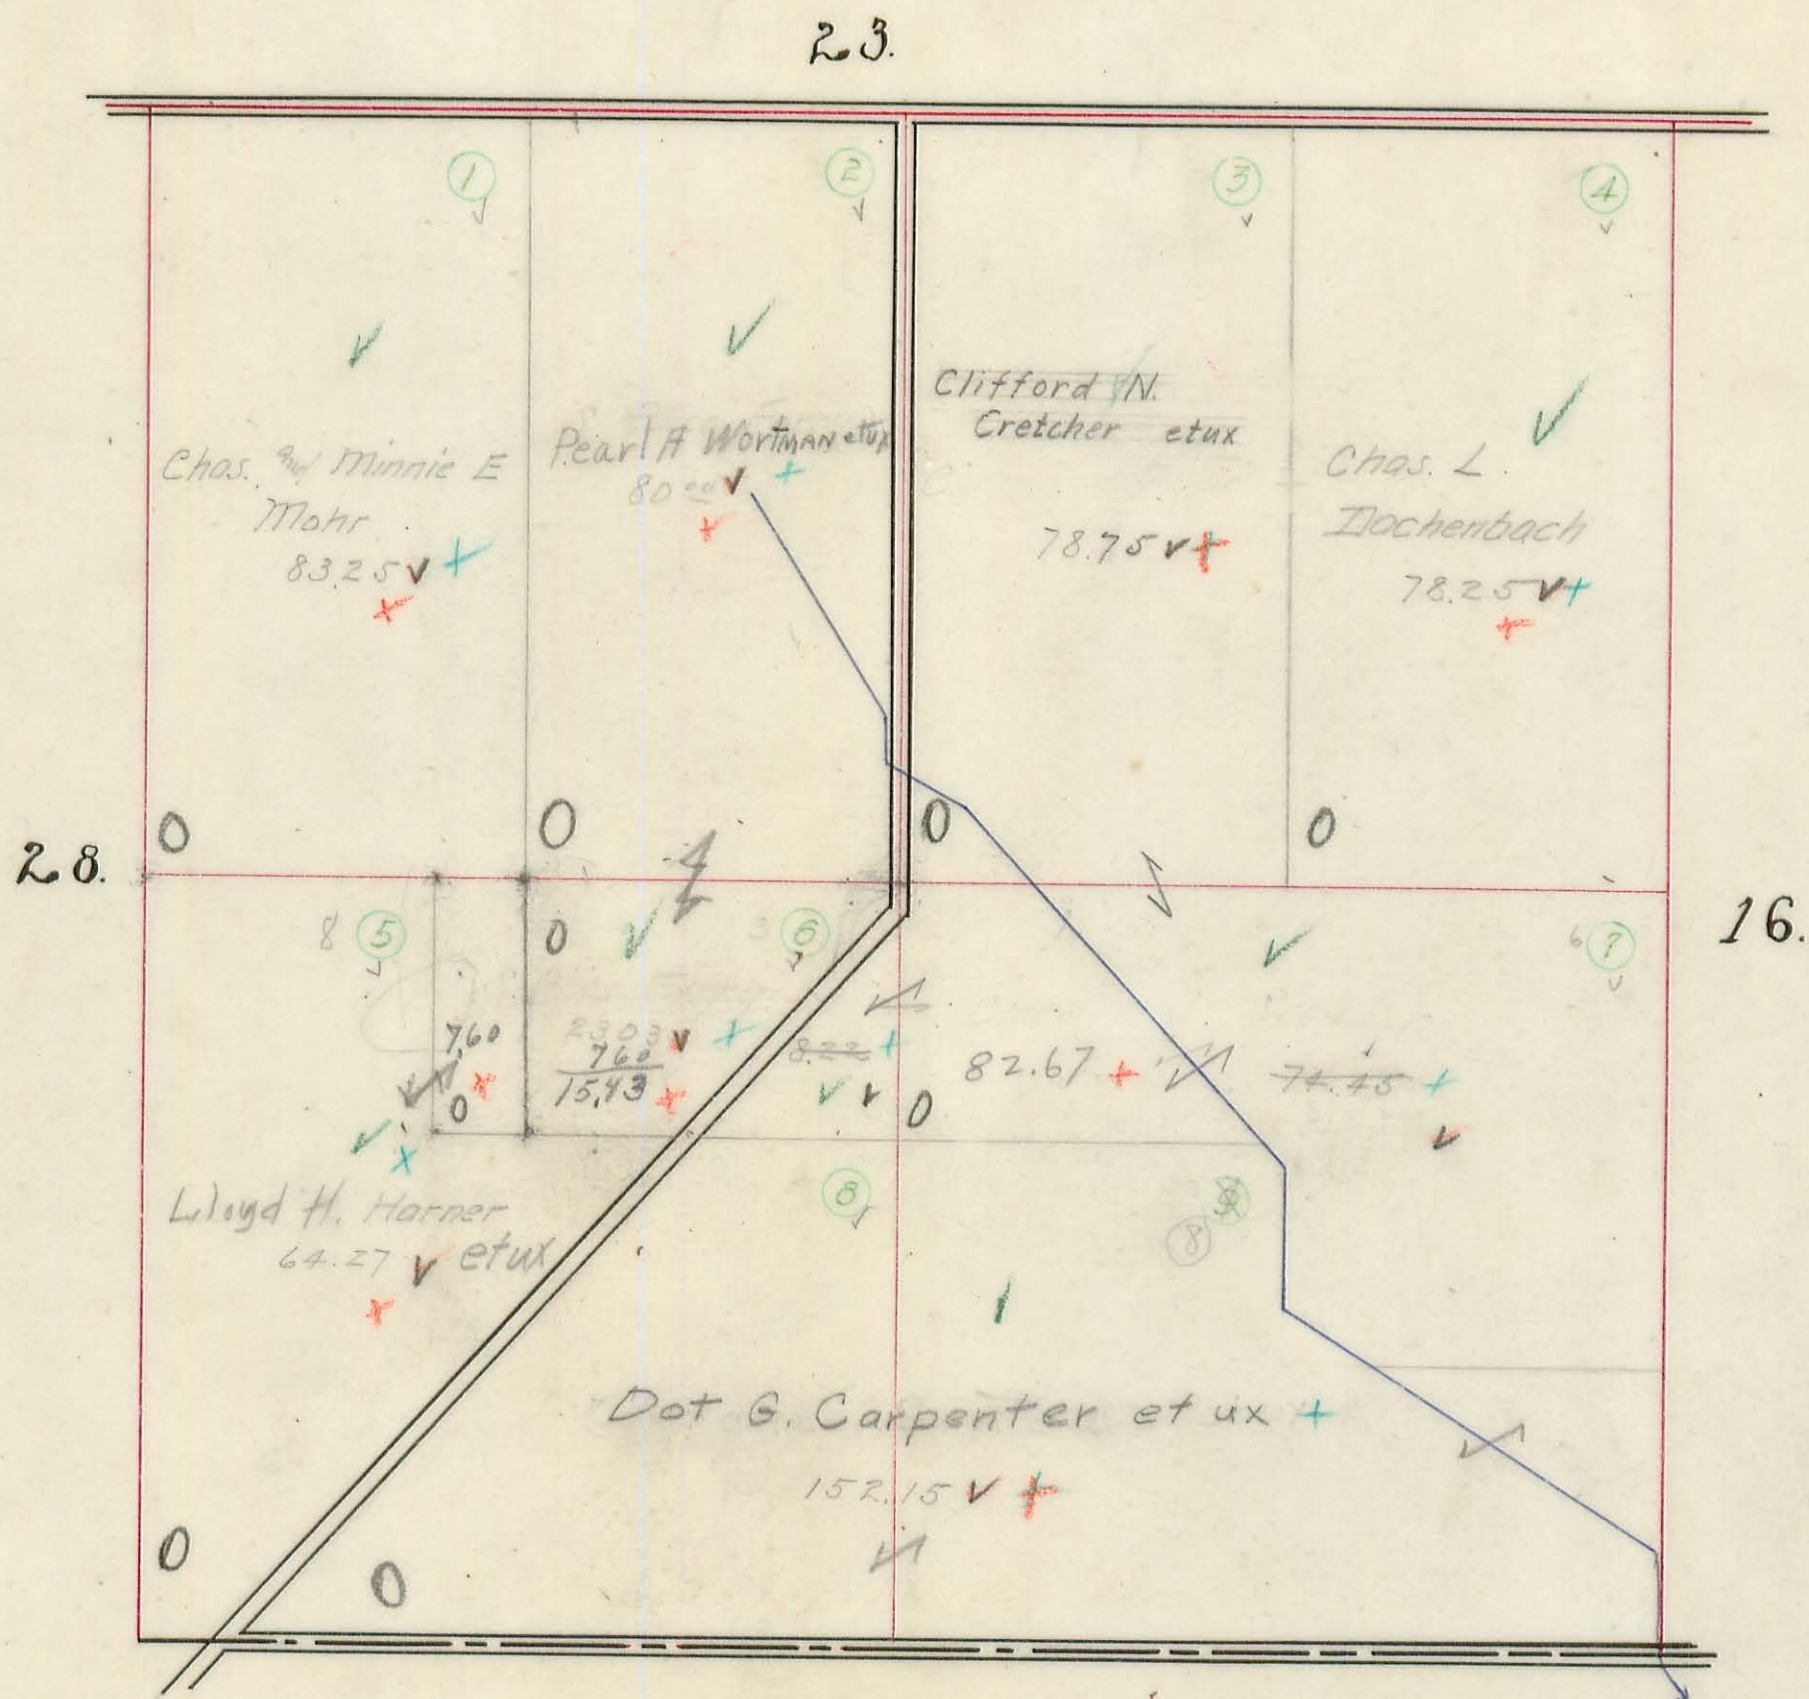


CHAMPAIGN COUNTY.

UNION TOWNSHIP.

Plat of Section 16, Town 4, Range 13

Scale 10 Chains Per Inch.

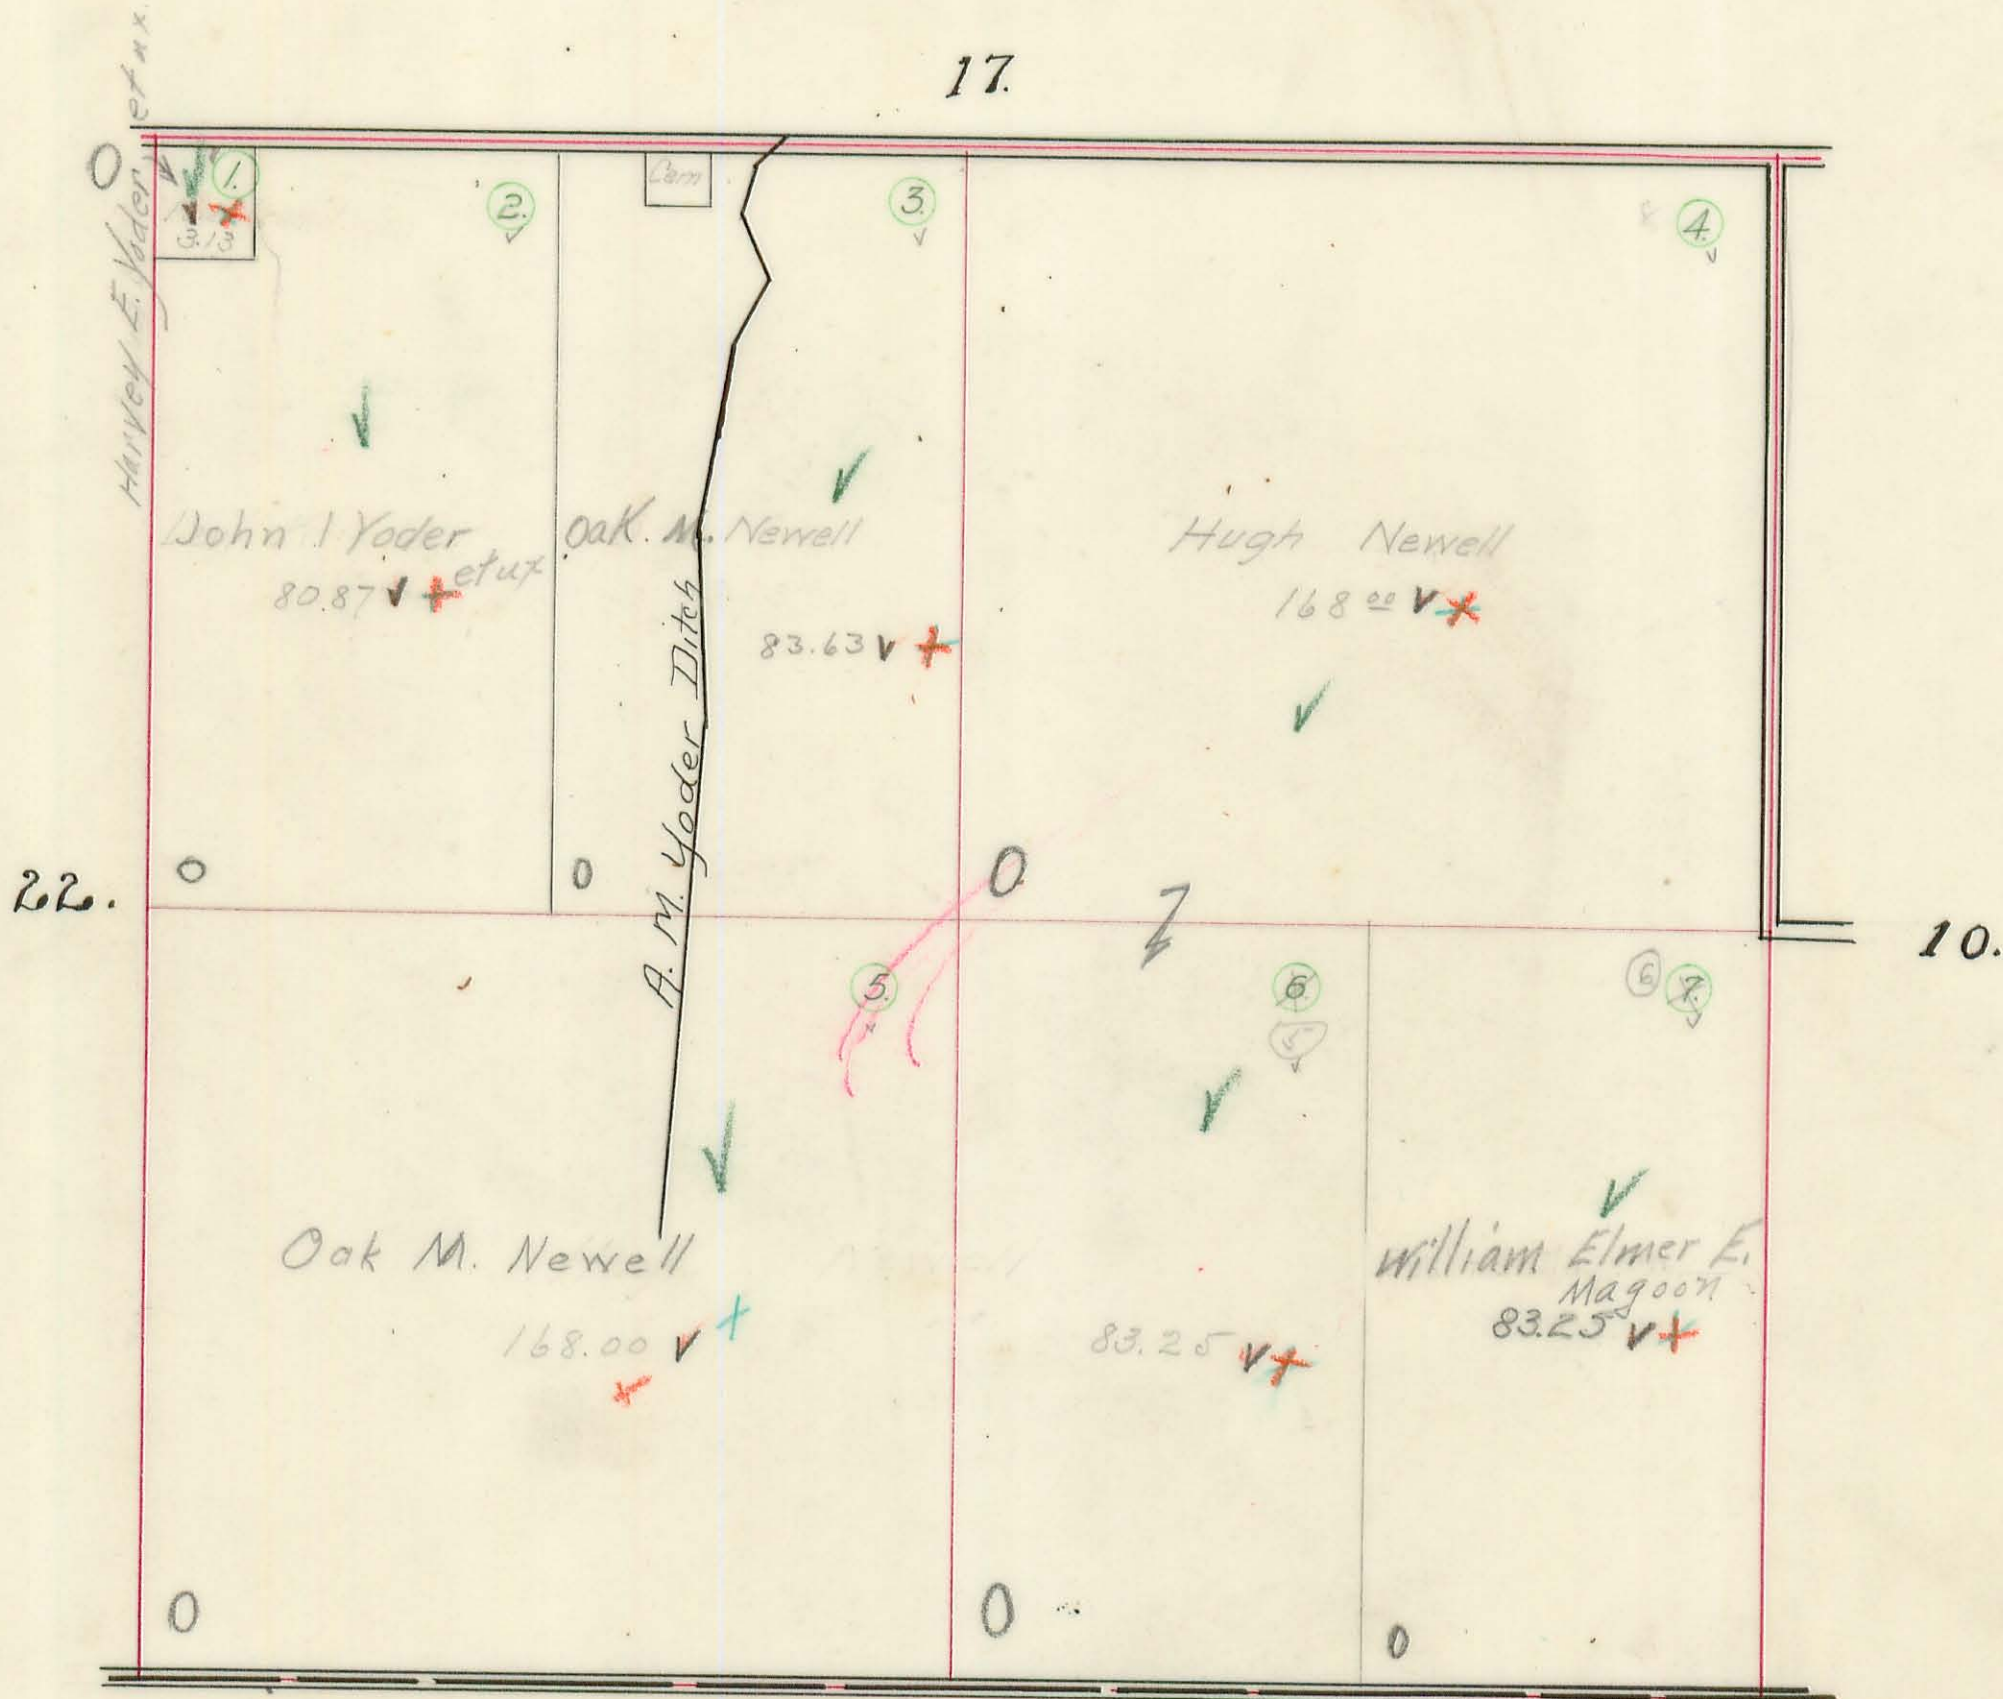

CHAMPAIGN COUNTY.


80.87
83.63
168.00
83.25
83.25
873.76

Checked

UNION TOWNSHIP.

Plat of Section 4 & 10, Town 4, Range 13

Scale 10 Chains Per Inch.

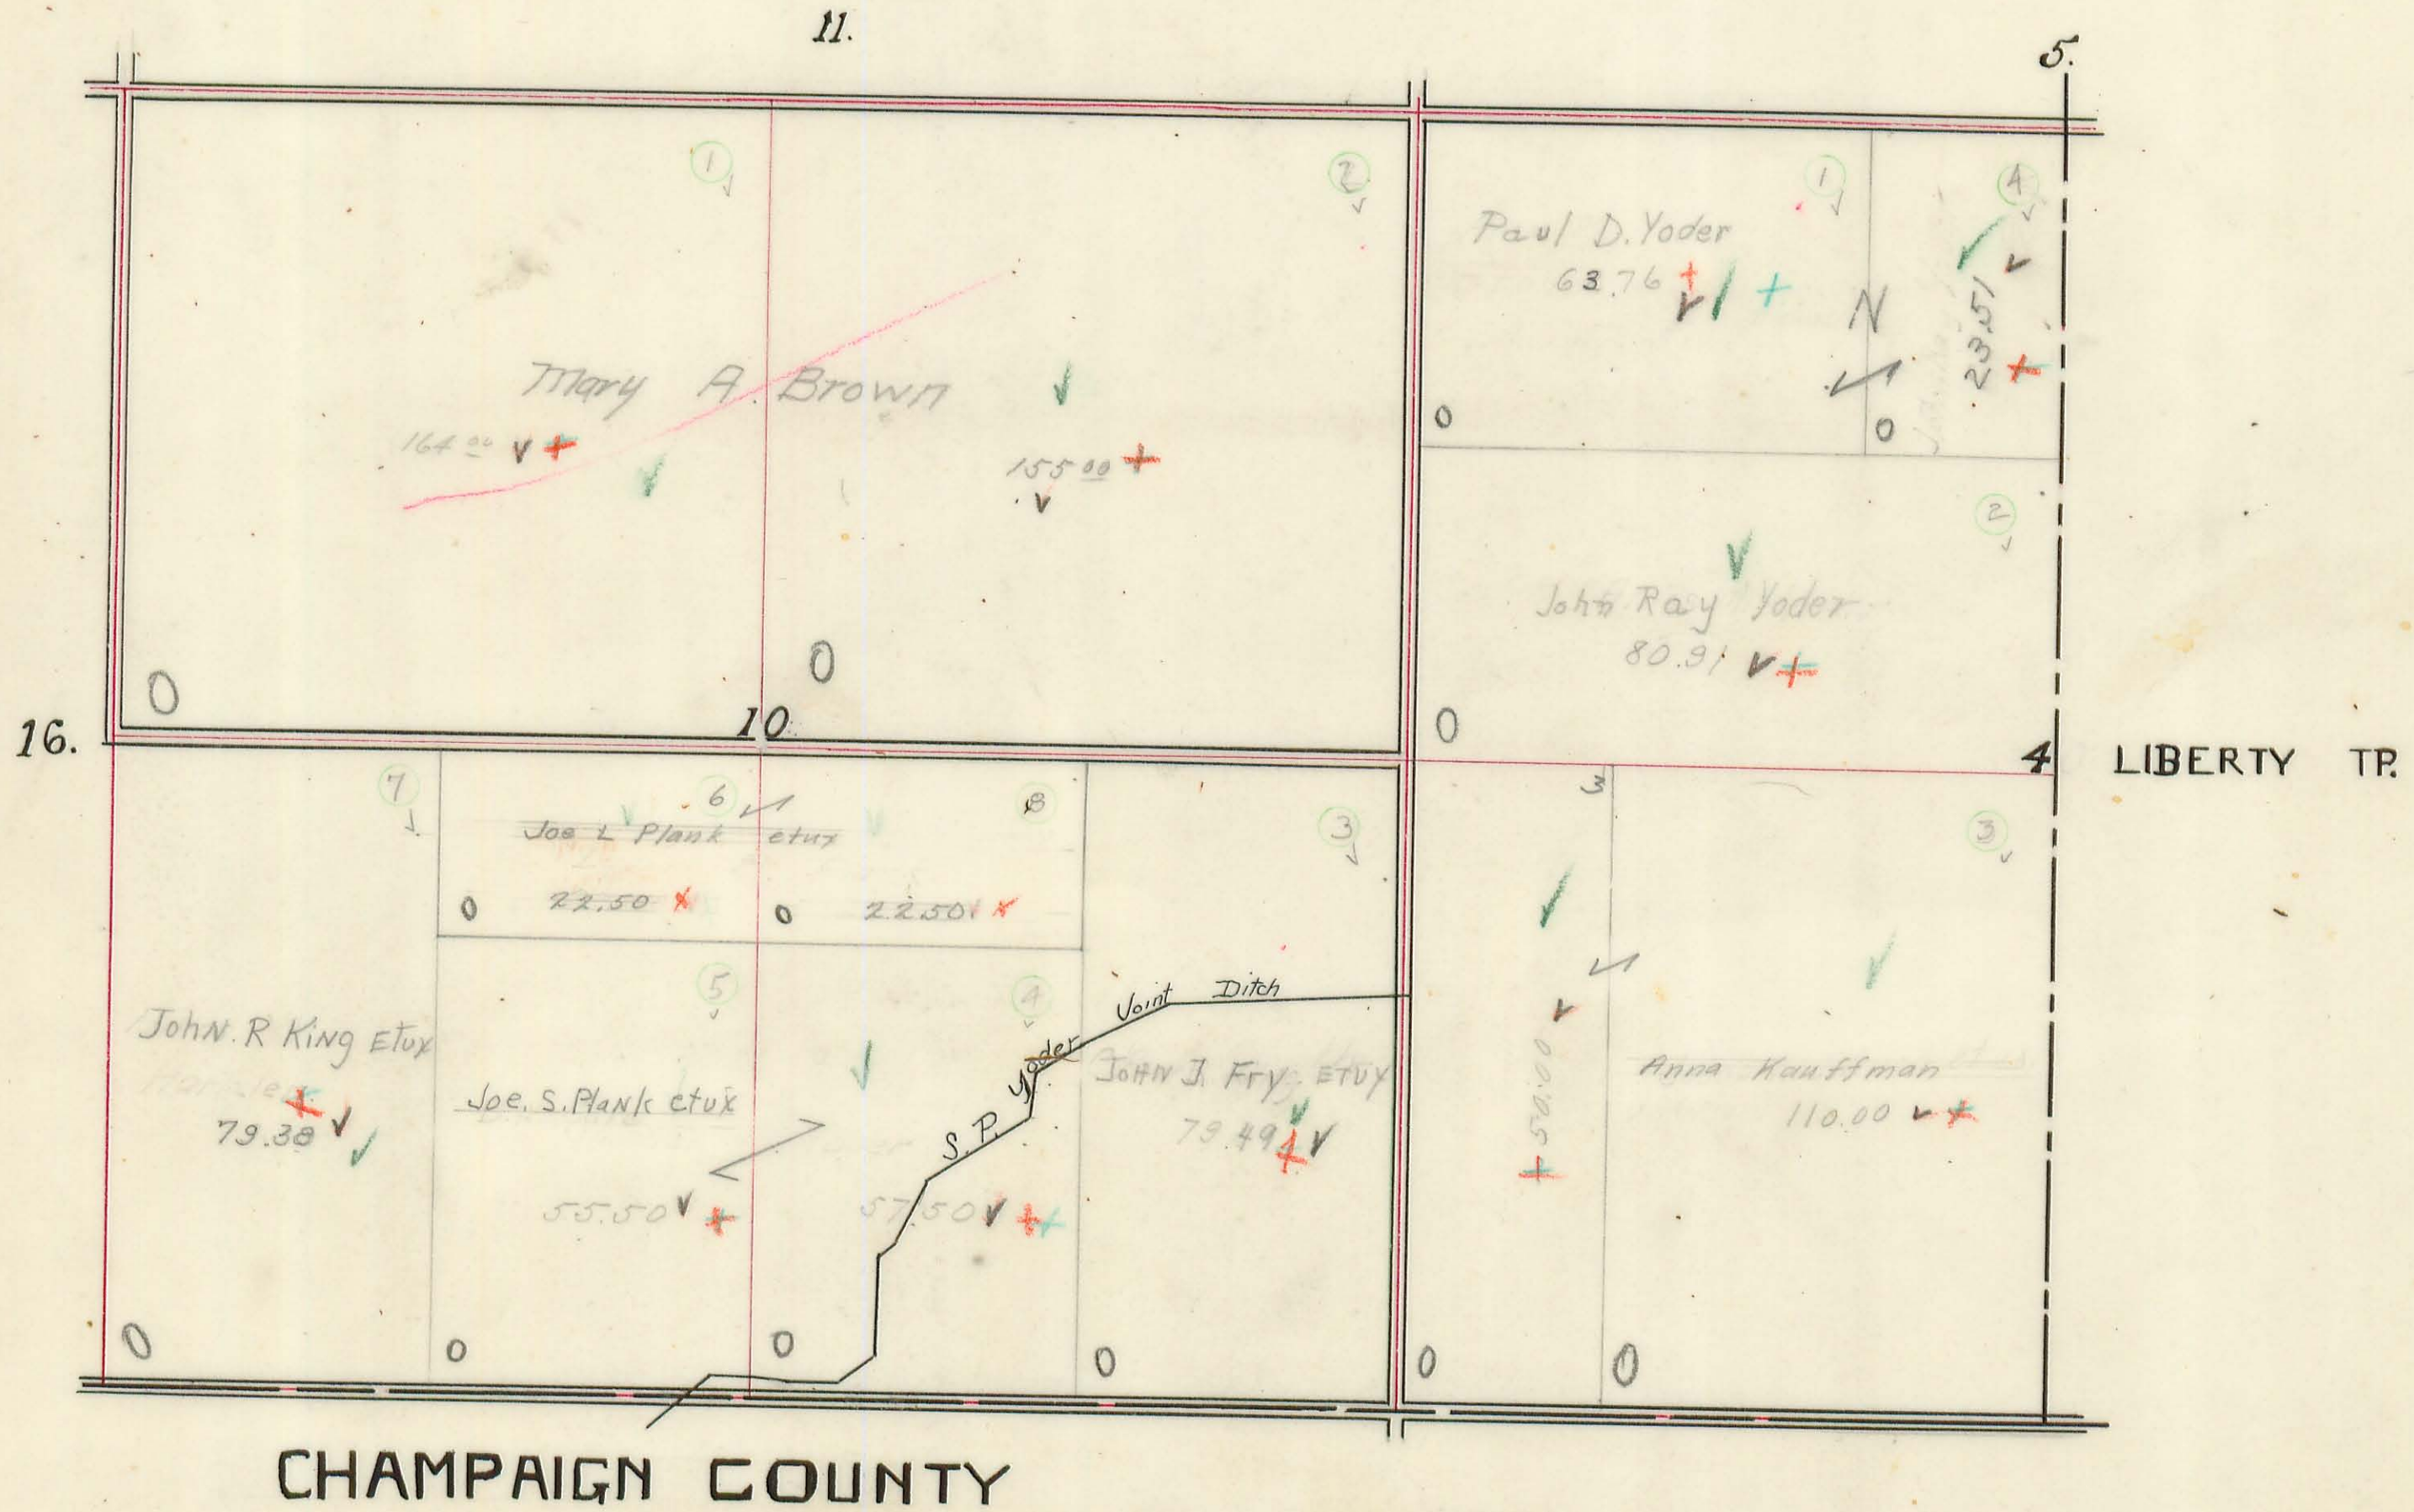

Checked