

**UNION  
TOWNSHIP  
1951**

INDEX

	SECTION	TOWN	RANGE	PAGE
MIAMI RIVERS SURVEY	26	3	14	1
	20	3	14	2
	14	3	14	3
	8	3	14	4
	2	3	14	4
	25	3	14	5
	19	3	14	6
	13	3	14	7
	7	3	14	8
	1	3	14	8
	30	4	13	9
	24	4	13	10
	18	4	13	11
	12	4	13	12
	6	4	13	12
	29	4	13	13
	23	4	13	14
	17	4	13	15
	11	4	13	16
	5	4	13	16
28	4	13	17	
22	4	13	18	
16	4	13	19	
10	4	13	20	
4	4	13	20	

# UNION TOWNSHIP

## INDEX MAP

ORDER OF NUMBER SECTION TOWN RANGE

SCALE 40 CHAINS TO THE INCH

CORRECTED TO

January 1, 1955

January 1, 1956

January 1, 1957

January 1, 1958

		HARRISON		TOWNSHIP				
PLEASANT	TOWNSHIP	26-3-14 PAGE 1	20-3-14 PAGE 2	14-3-14 PAGE 3	8-3-14 PAGE 4	2-3-14 PAGE 4	TOWNSHIP	
	25-3-14 PAGE 5	19-3-14 PAGE 6	13-3-14 PAGE 7	7-3-14 PAGE 8	1-3-14 PAGE 8			
TOWNSHIP	TOWNSHIP	30-4-13 PAGE 9	24-4-13 PAGE 10	18-4-13 PAGE 11	12-4-13 PAGE 12	6-4-13 PAGE 12	LIBERTY	
	29-4-14 PAGE 13	23-4-13 PAGE 14	17-4-13 PAGE 15	11-4-13 PAGE 16	5-4-13 PAGE 16			
MIAMI	TOWNSHIP	28-4-13 PAGE 17	22-4-13 PAGE 18	16-4-13 PAGE 19	10-4-13 PAGE 20	4-4-13 PAGE 20		
		CHAMPAIGN		COUNTY				

UNION TOWNSHIP  
SECTION 26 TOWN 3 RANGE 14


SCALE 10 CHAINS TO THE INCH






UNION TOWNSHIP  
SECTION 20 TOWN 3 RANGE 14

SCALE 10 CHAINS TO THE INCH

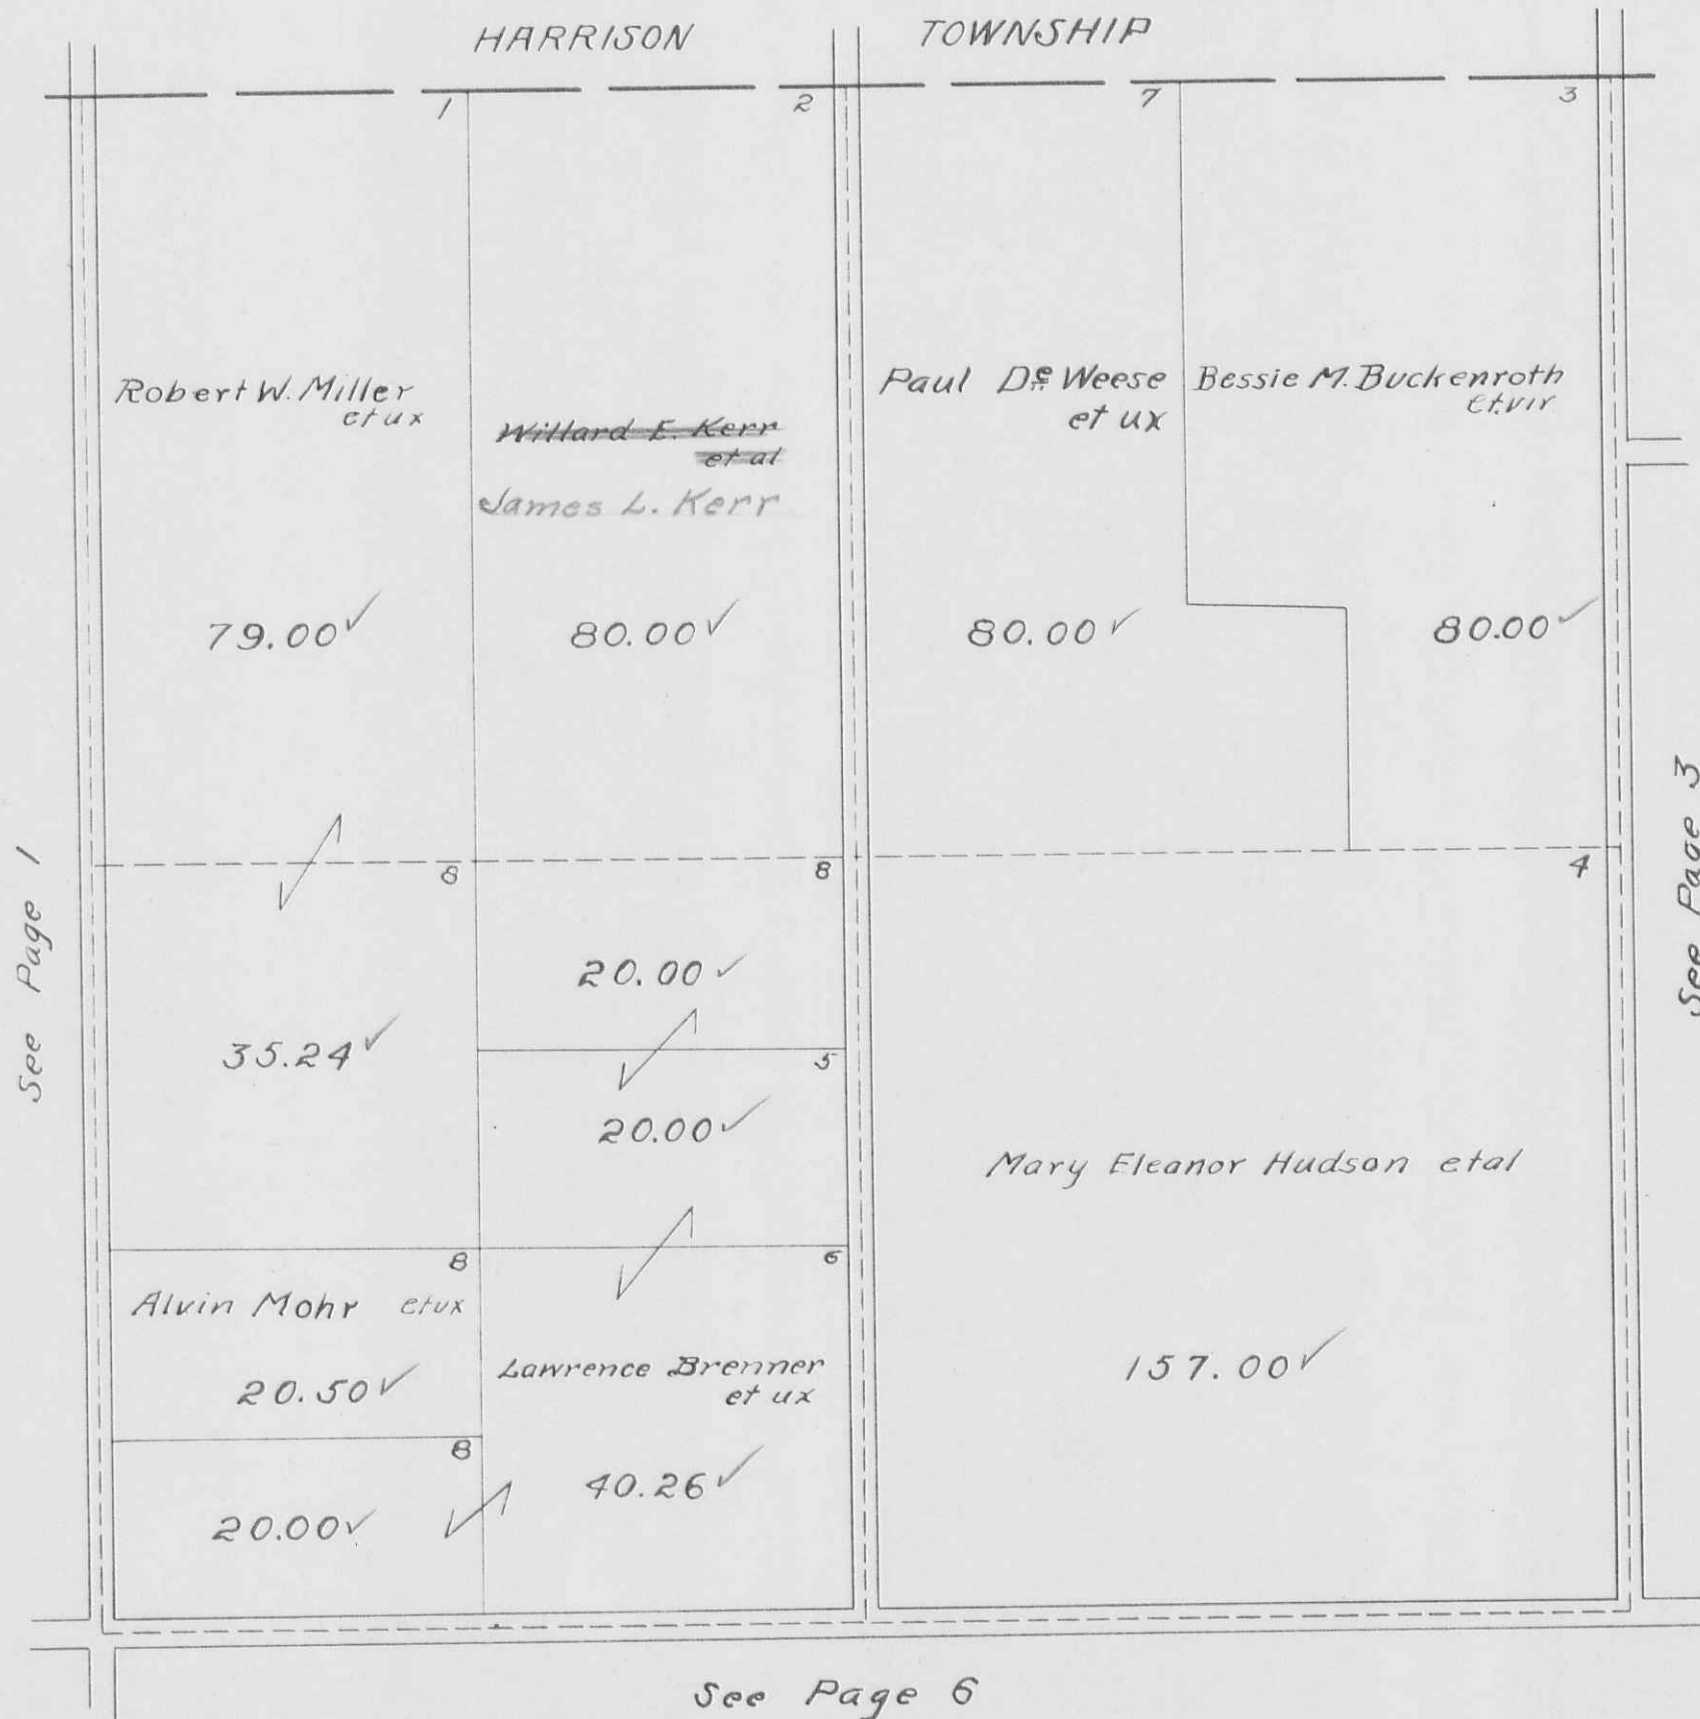

UNION TOWNSHIP  
SECTION 14 TOWN 3 RANGE 14

SCALE 10 CHAINS TO THE INCH

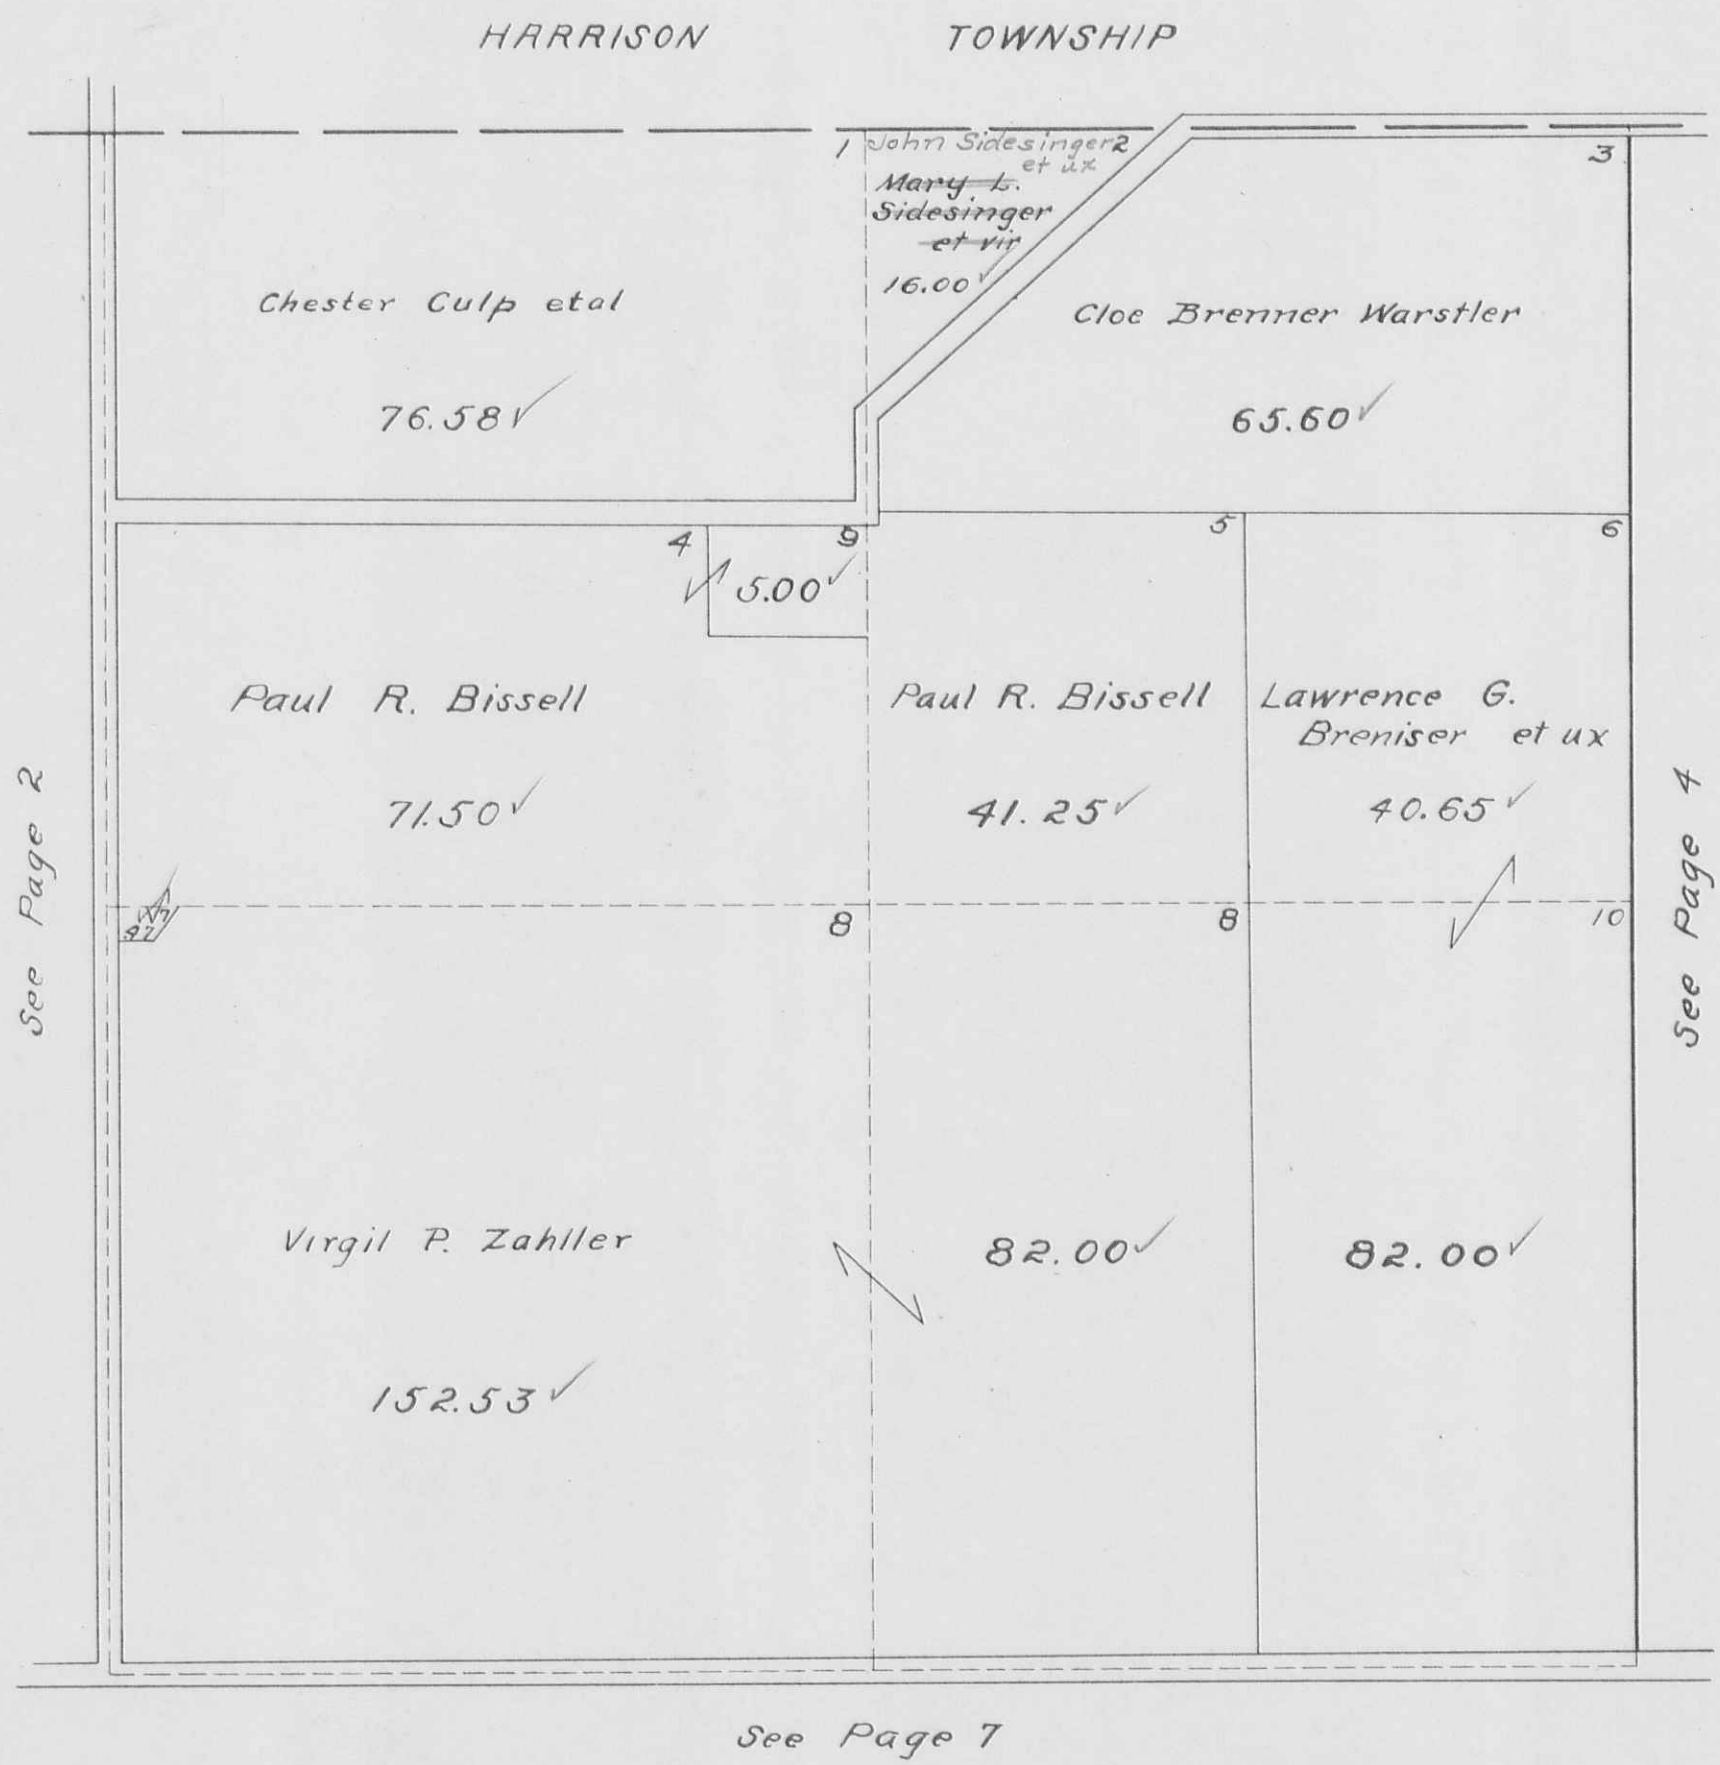


SECTION 8 TOWN 3 RANGE 14

SECTION 2 TOWN 3 RANGE 14

SCALE 10 CHAINS TO THE INCH

HARRISON

TOWNSHIP

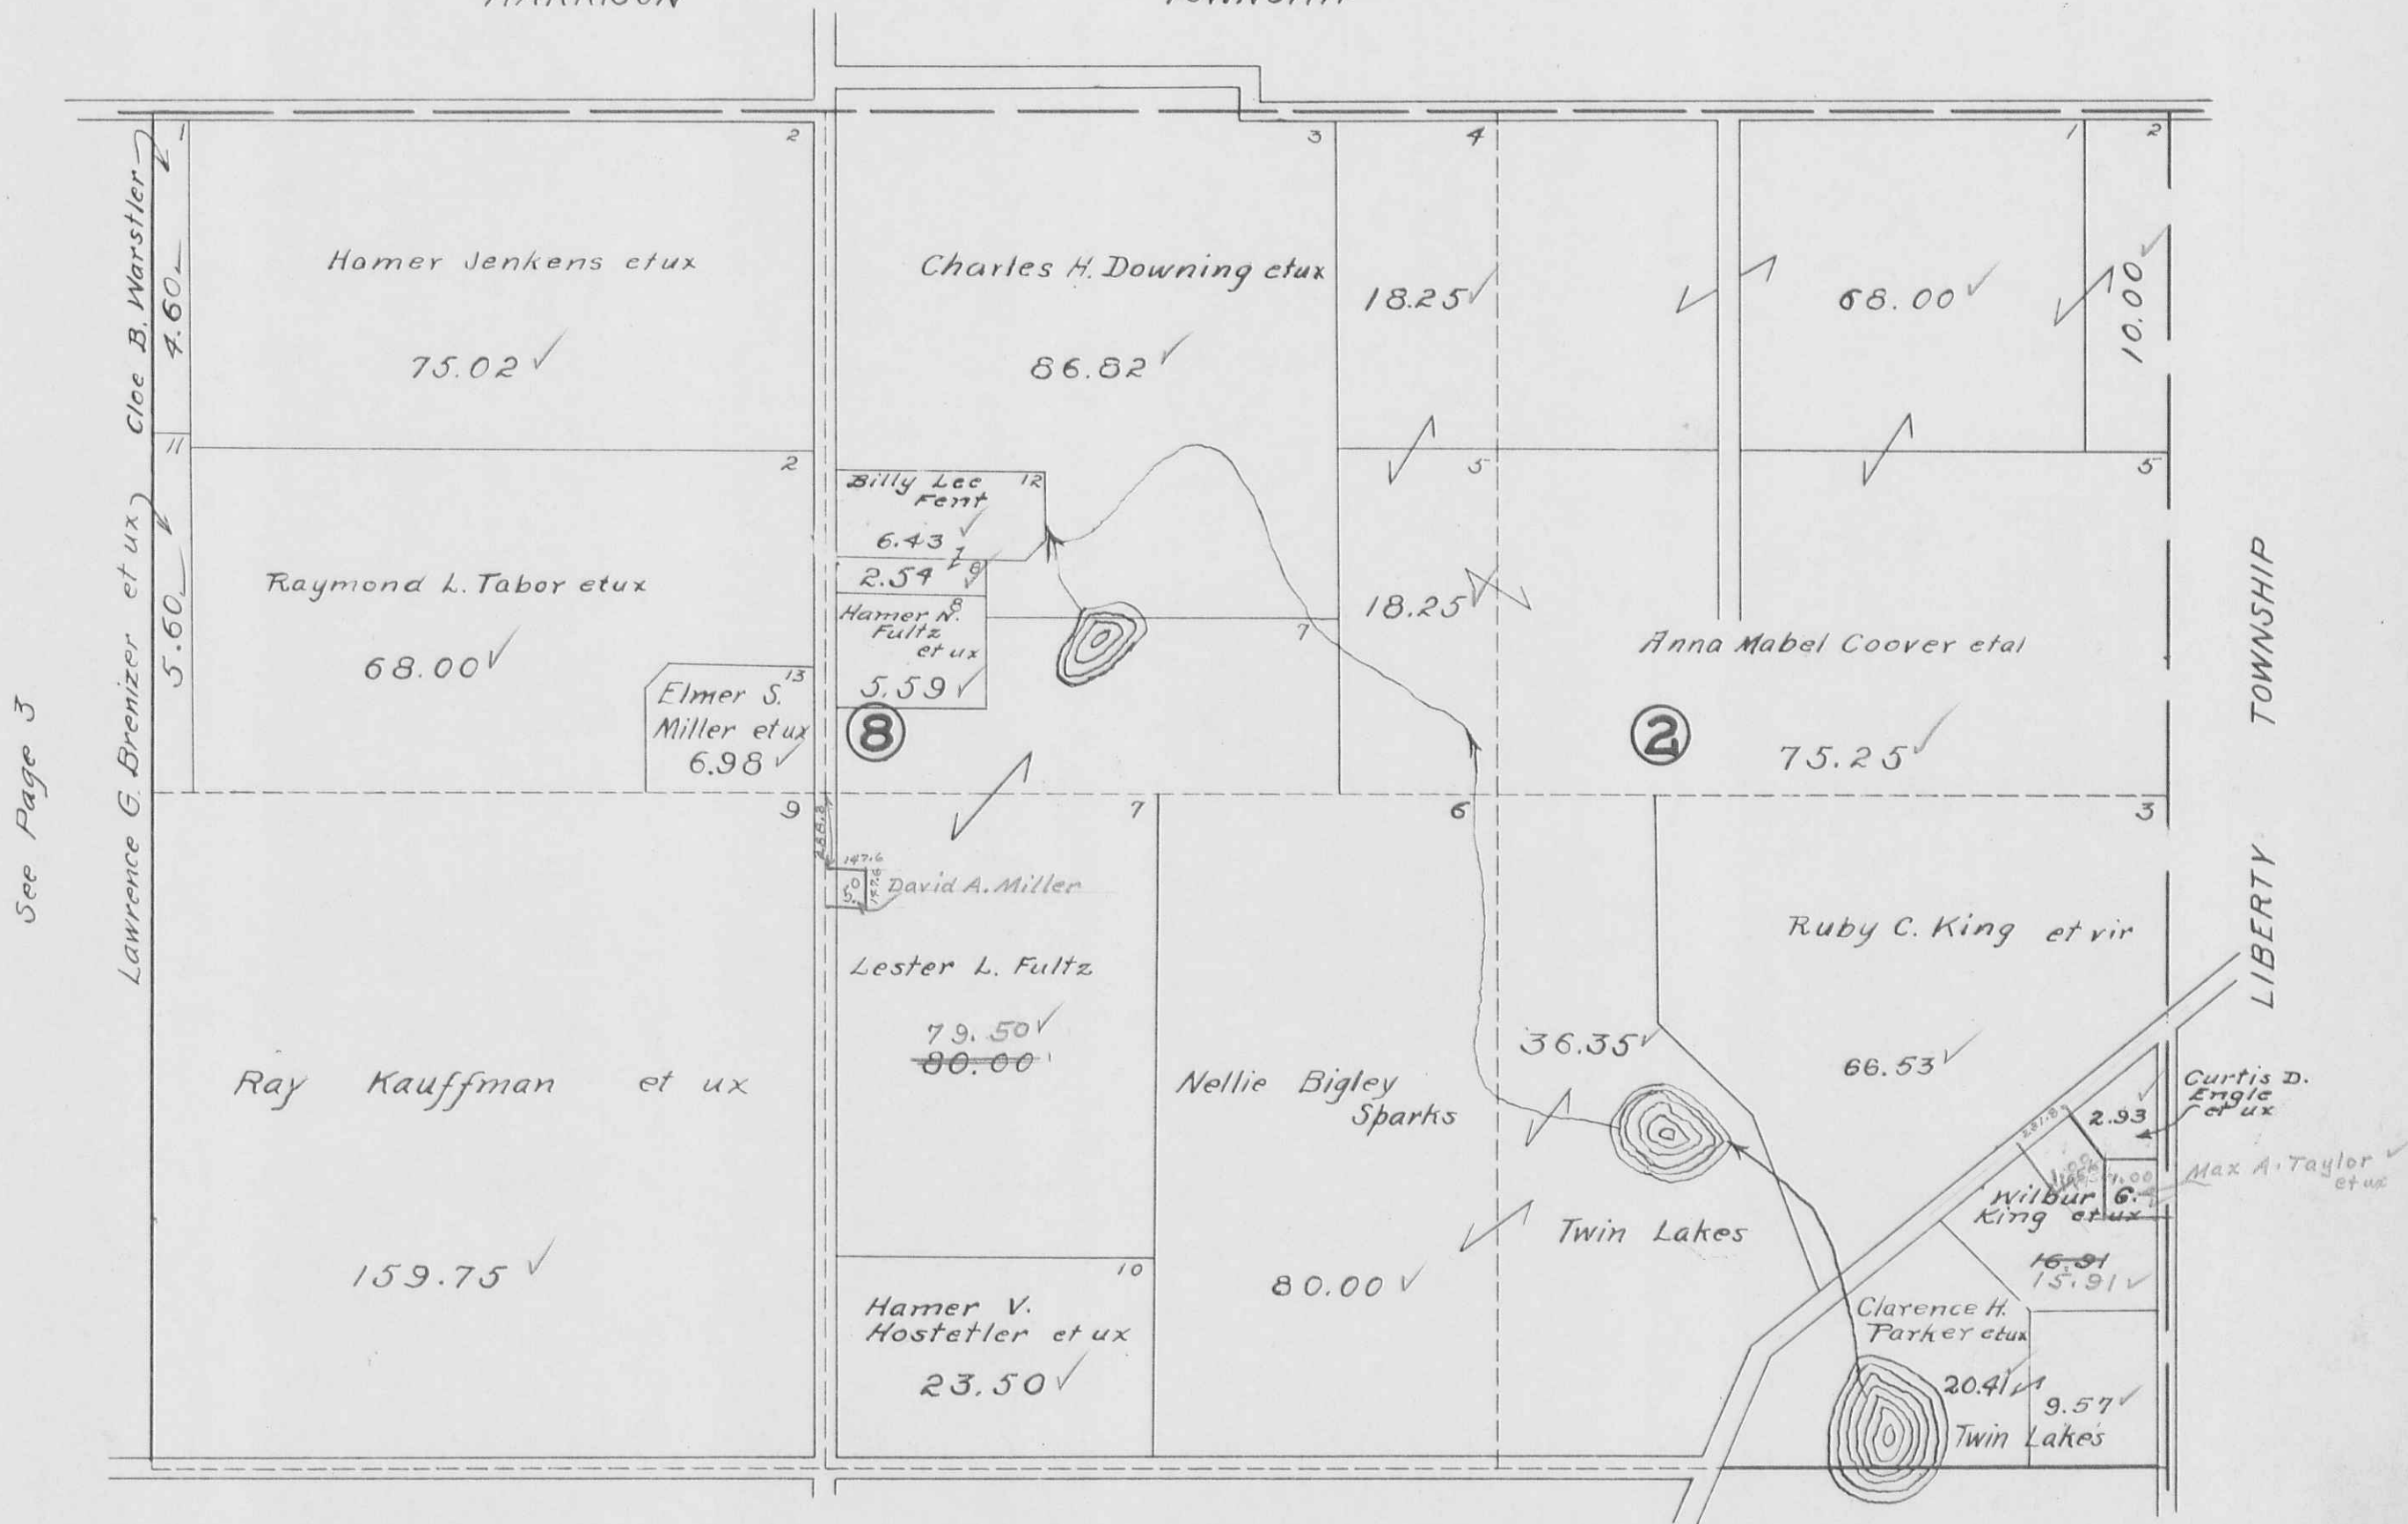


See Page 3

See Page 8

UNION TOWNSHIP  
SECTION 25 TOWN 3 RANGE 14


SCALE 10 CHAINS TO THE INCH

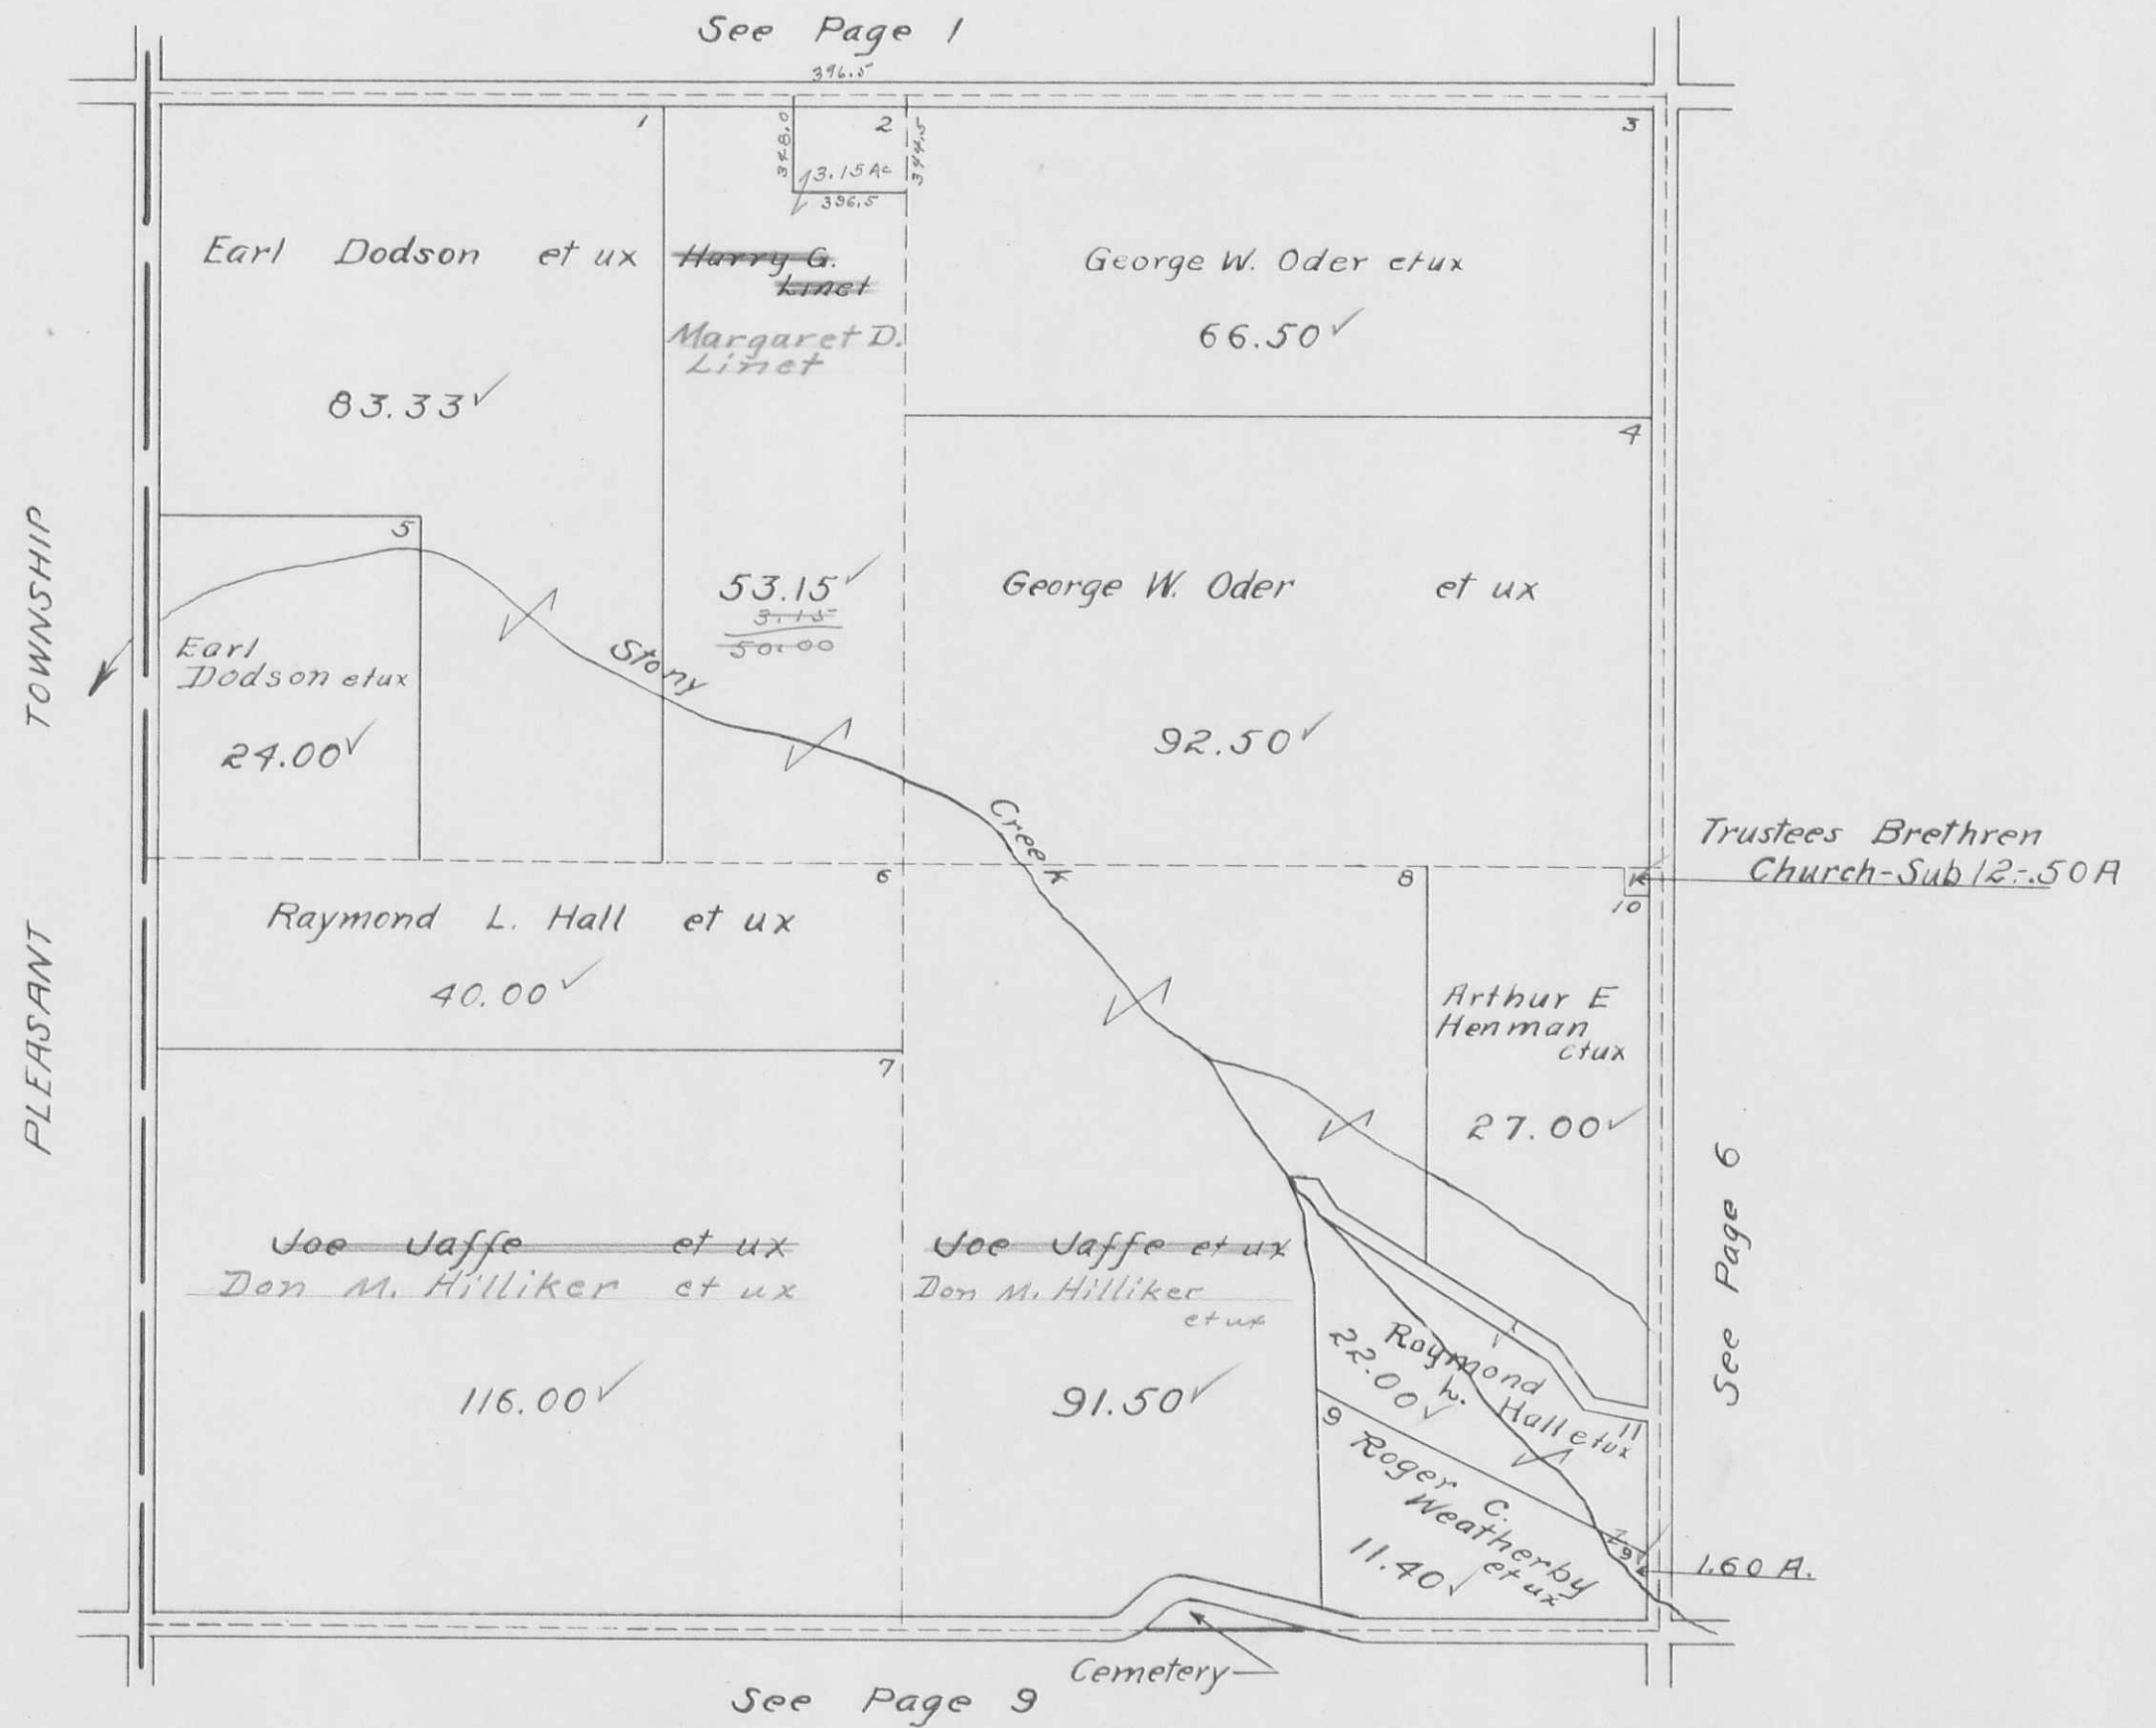



UNION TOWNSHIP  
SECTION 19 TOWN 3 RANGE 14


SCALE 10 CHAINS TO THE INCH

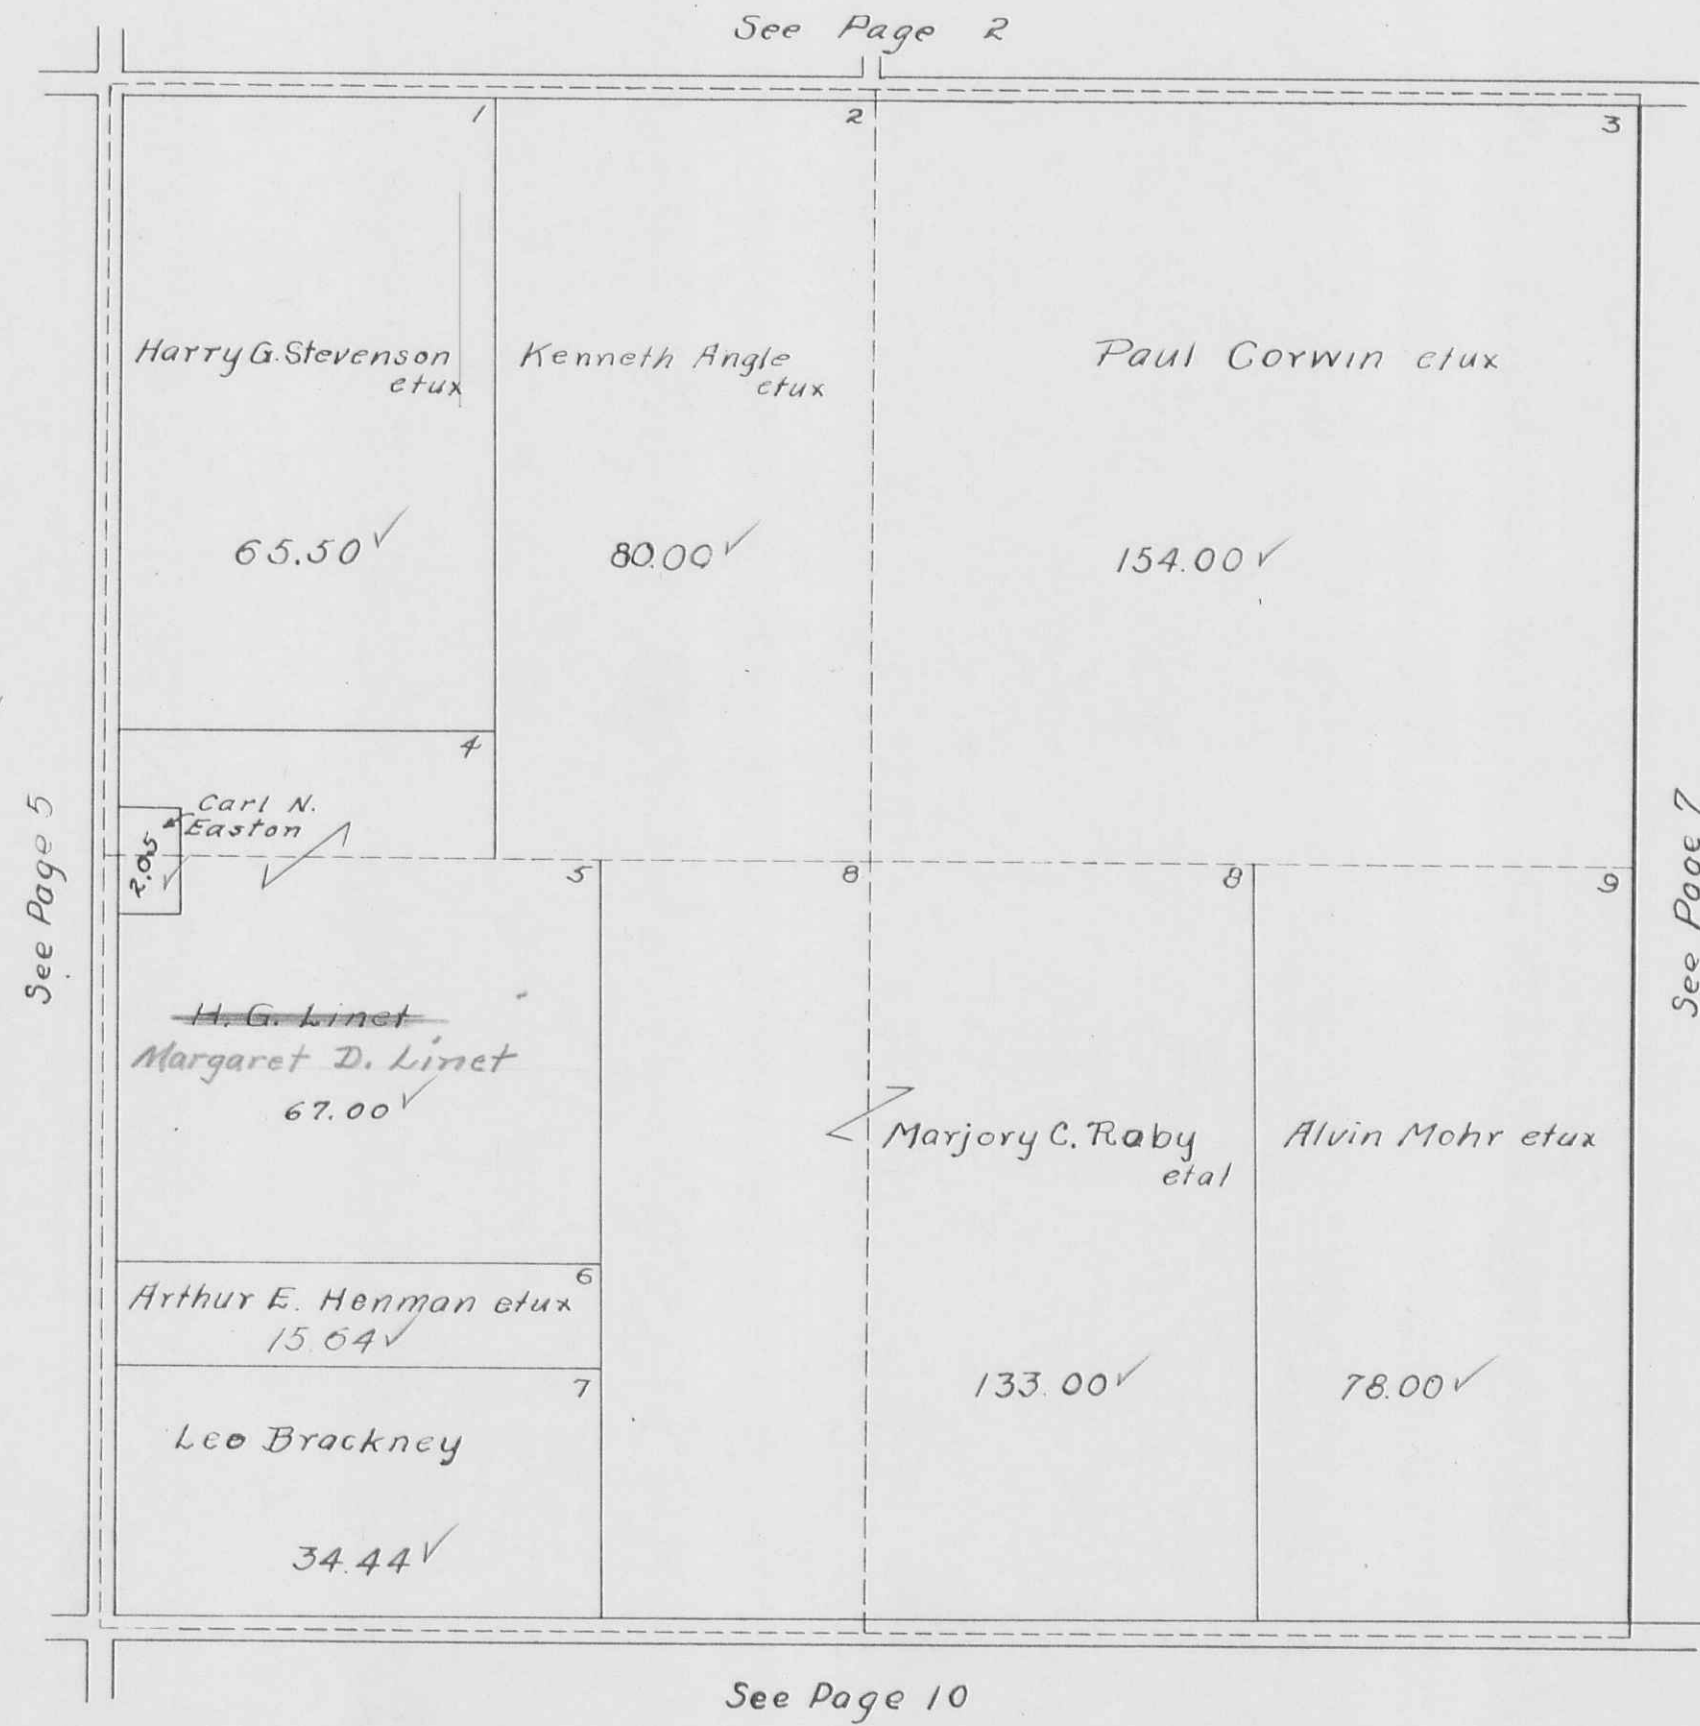

UNION TOWNSHIP  
SECTION 13 TOWN 3 RANGE 14

SCALE 10 CHAINS TO THE INCH

See Page 3

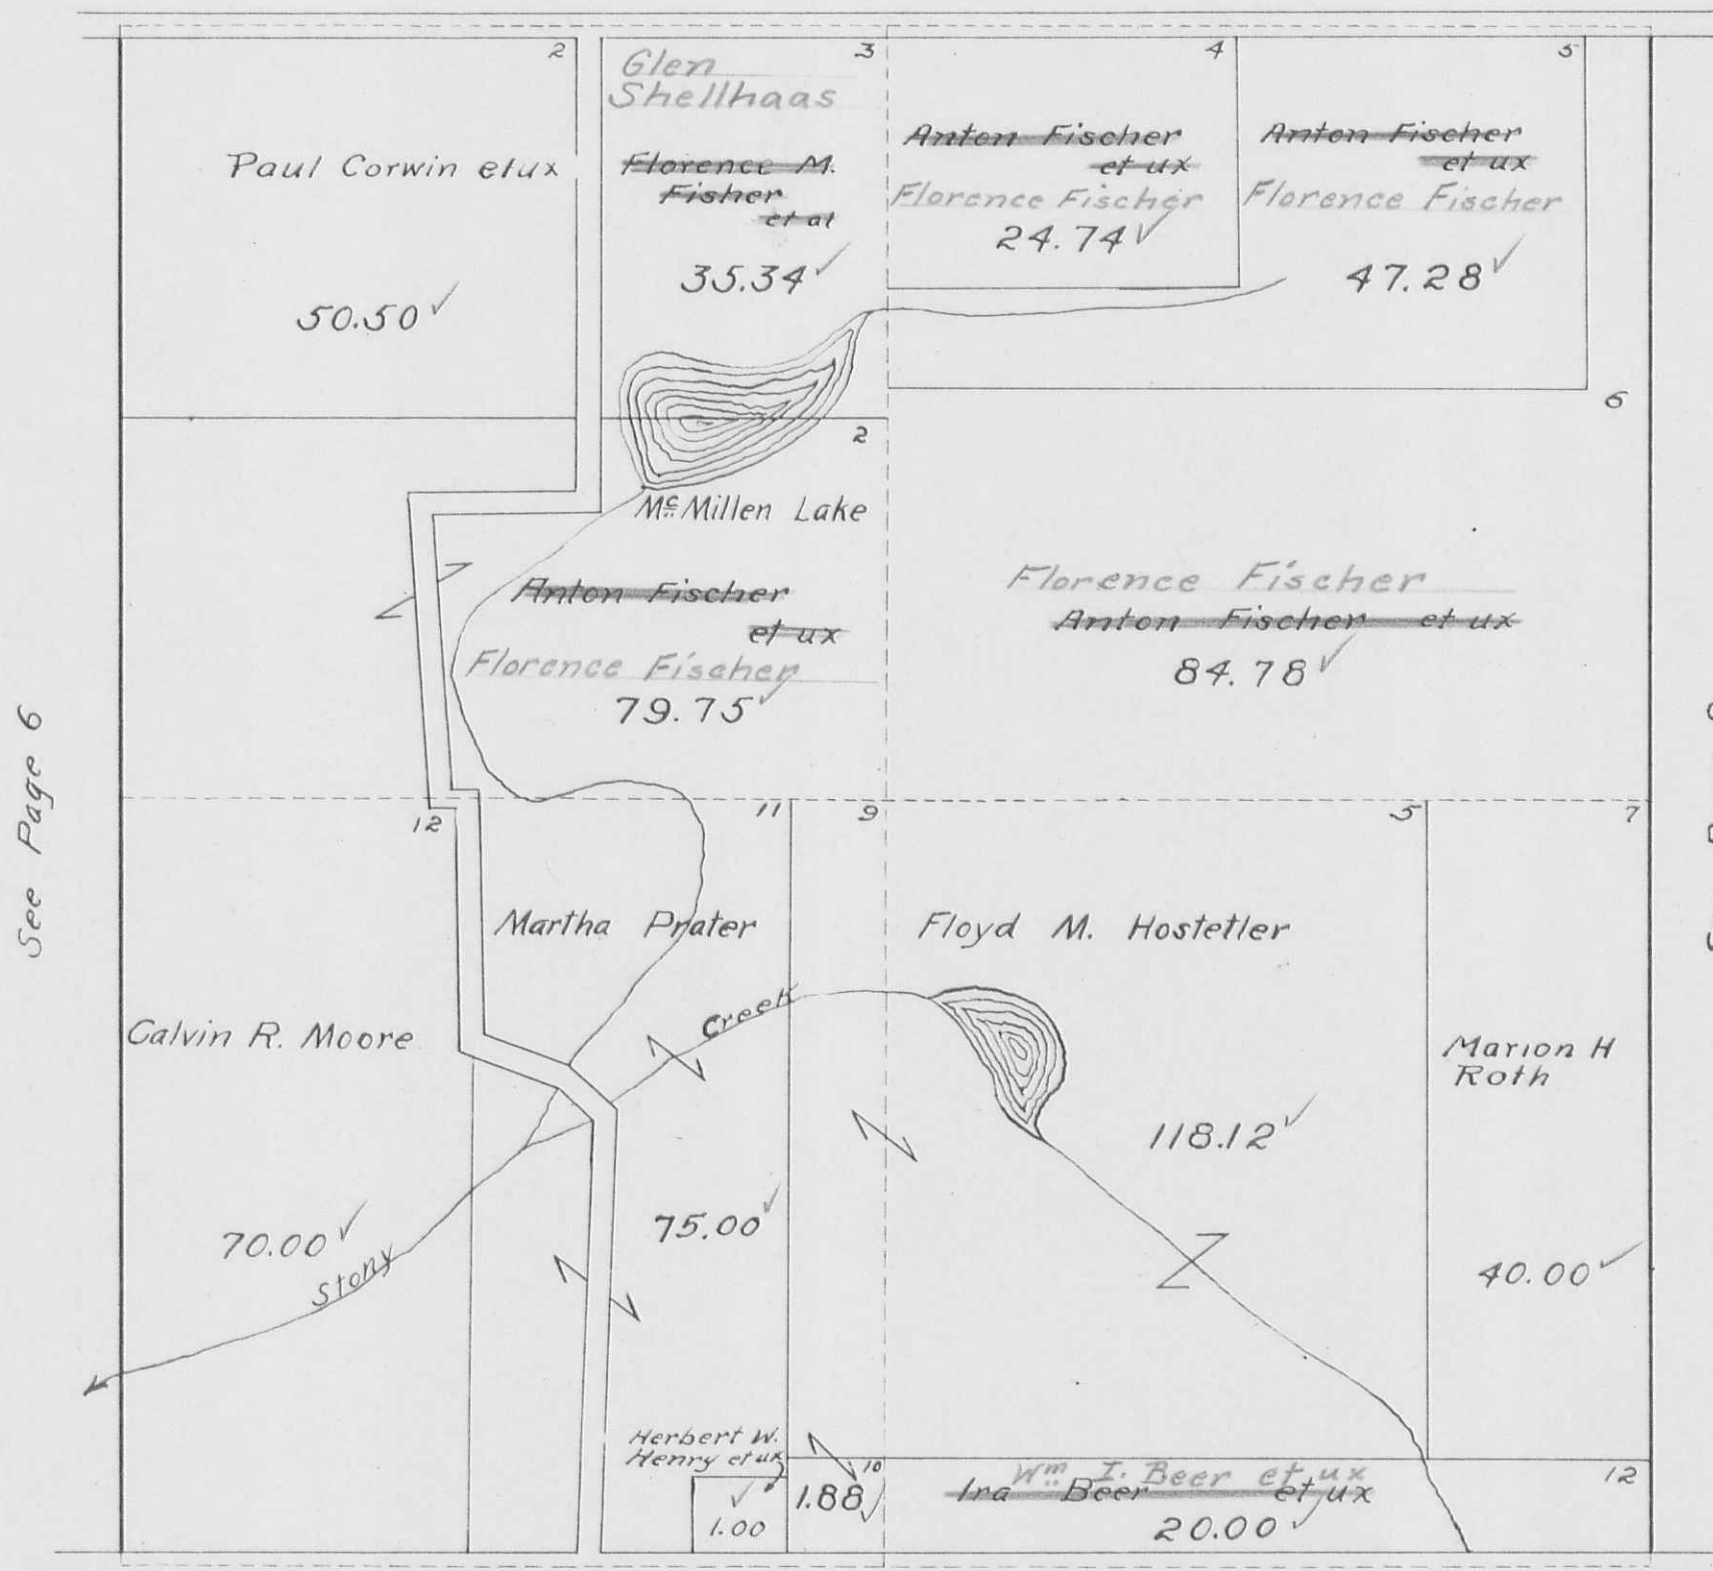


See Page 11

SECTION 7 TOWN 3 RANGE 14

SECTION 1 TOWN 3 RANGE 14

SCALE 10 CHAINS TO THE INCH

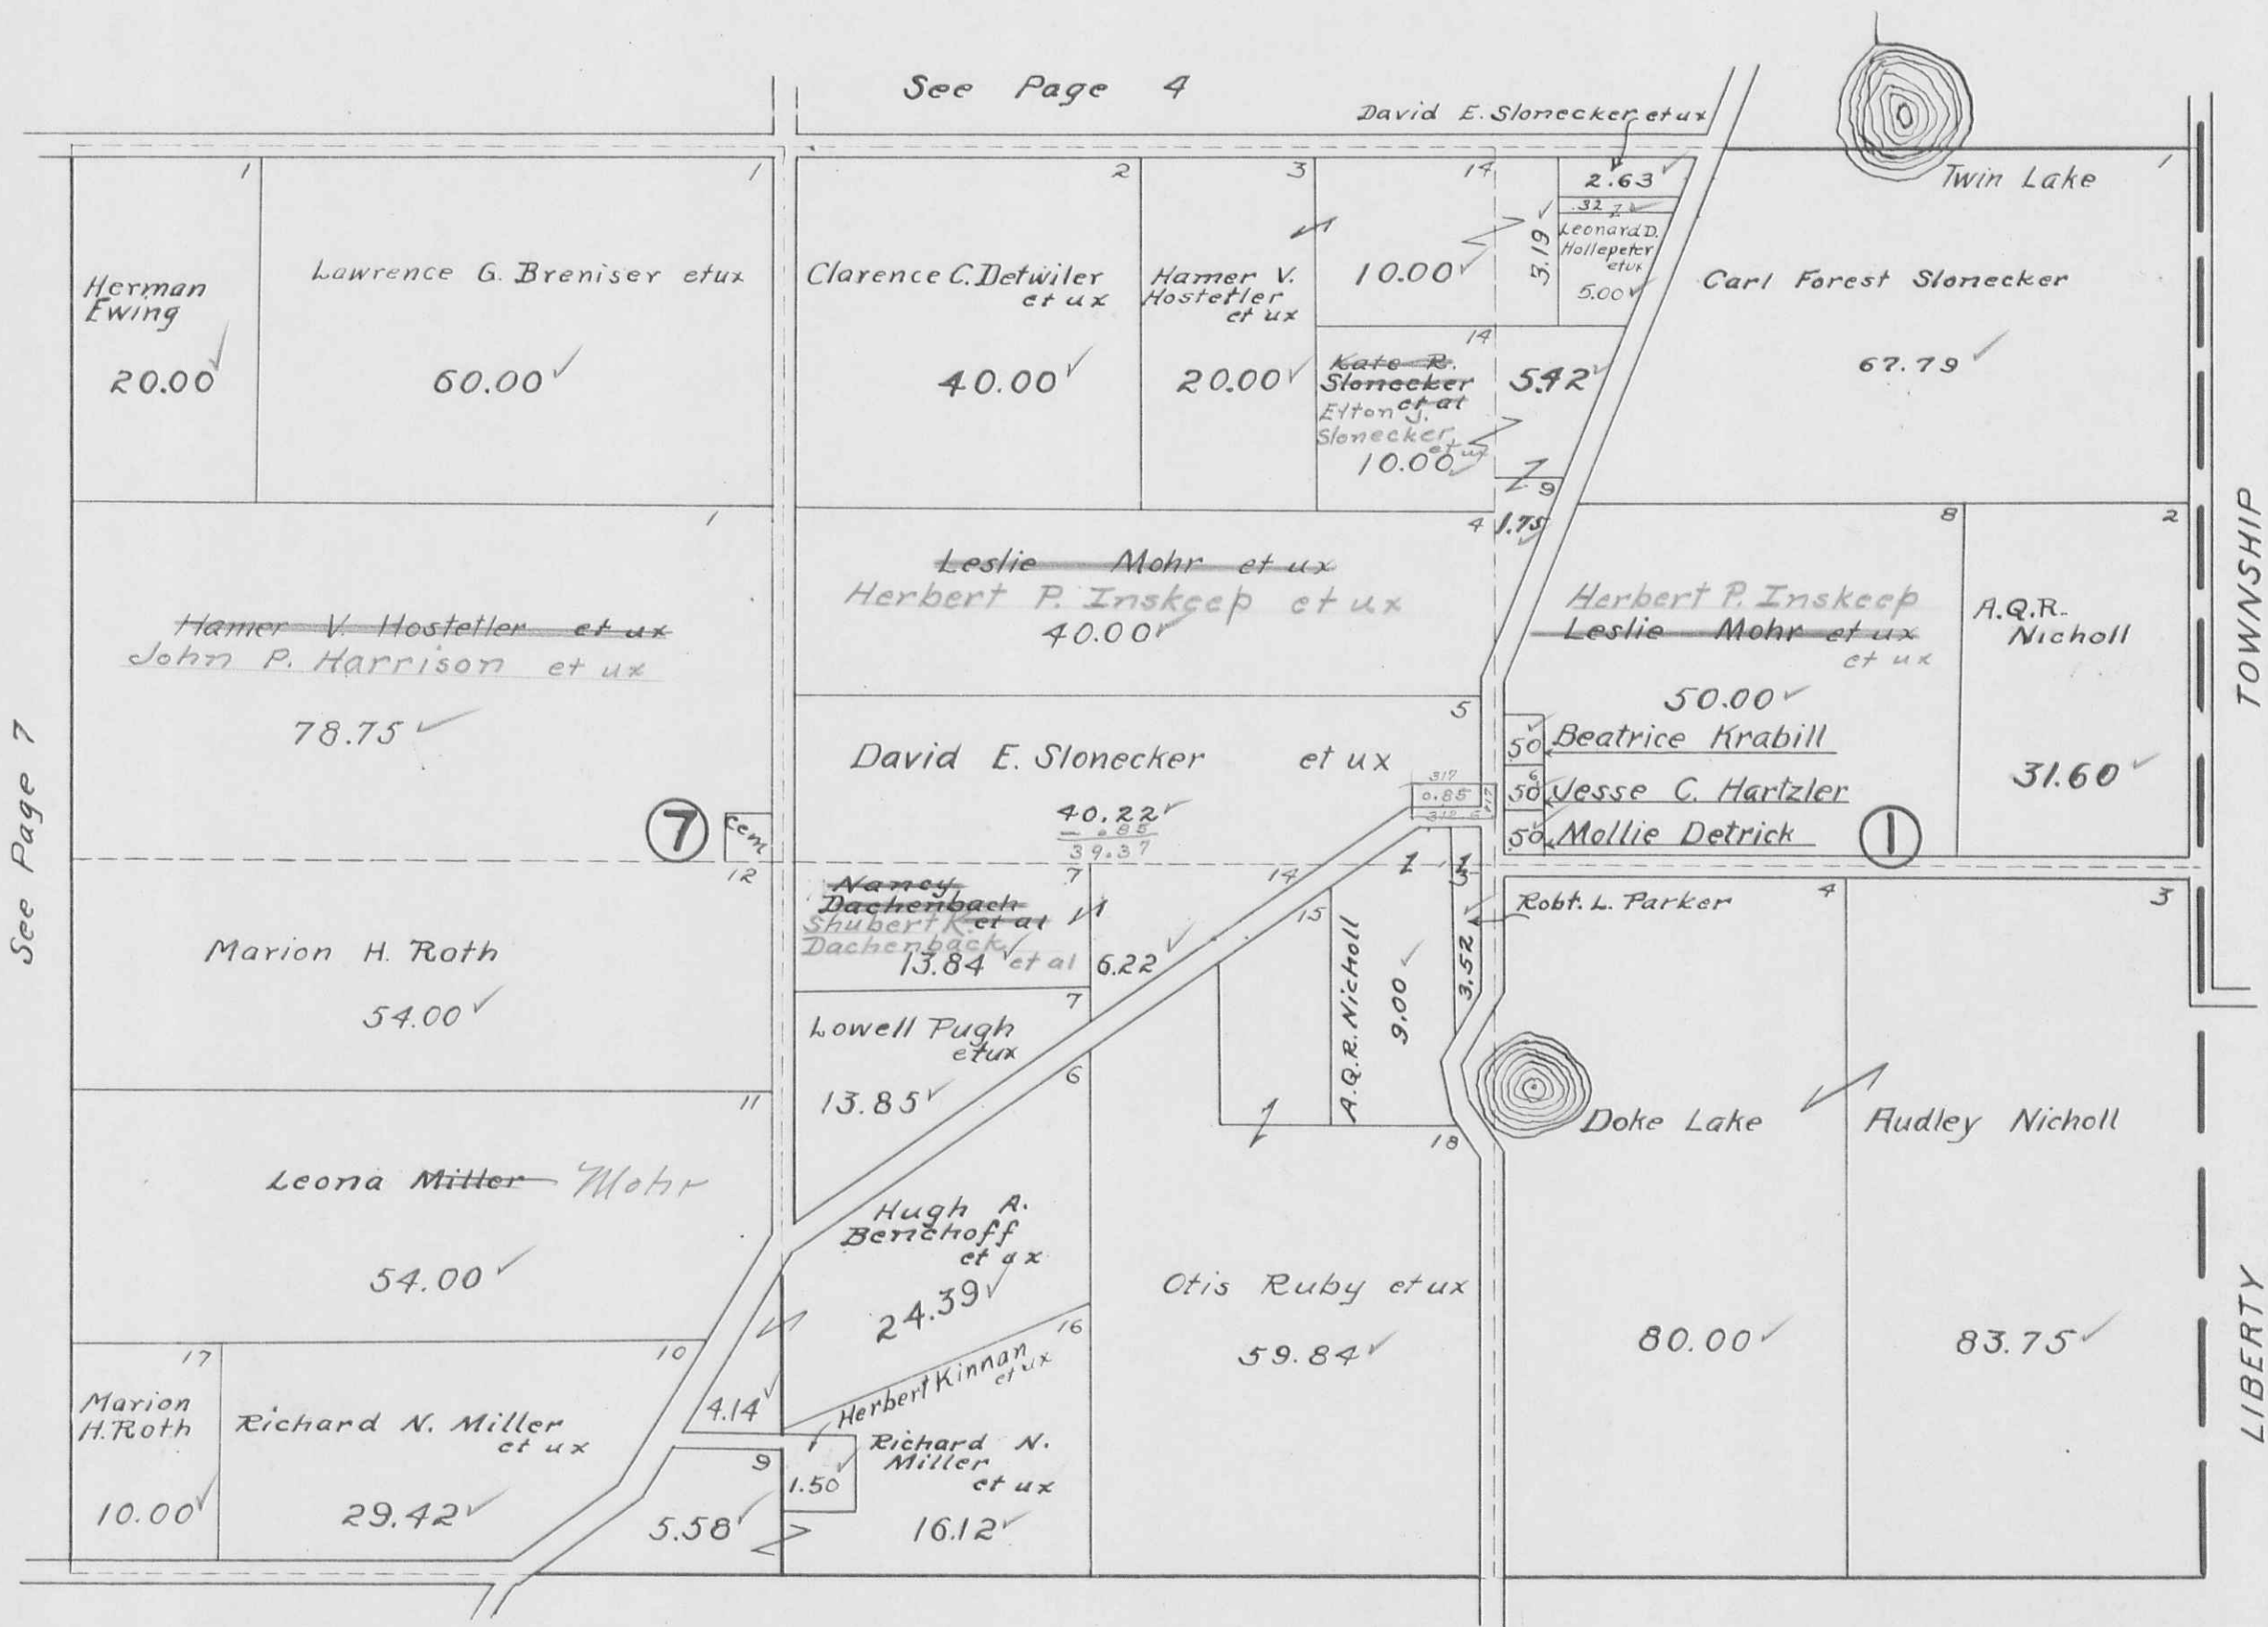


See Page 4

See Page 7

See Page 12

UNION TOWNSHIP  
SECTION 30 TOWN 4 RANGE 13


SCALE 10 CHAINS TO THE INCH

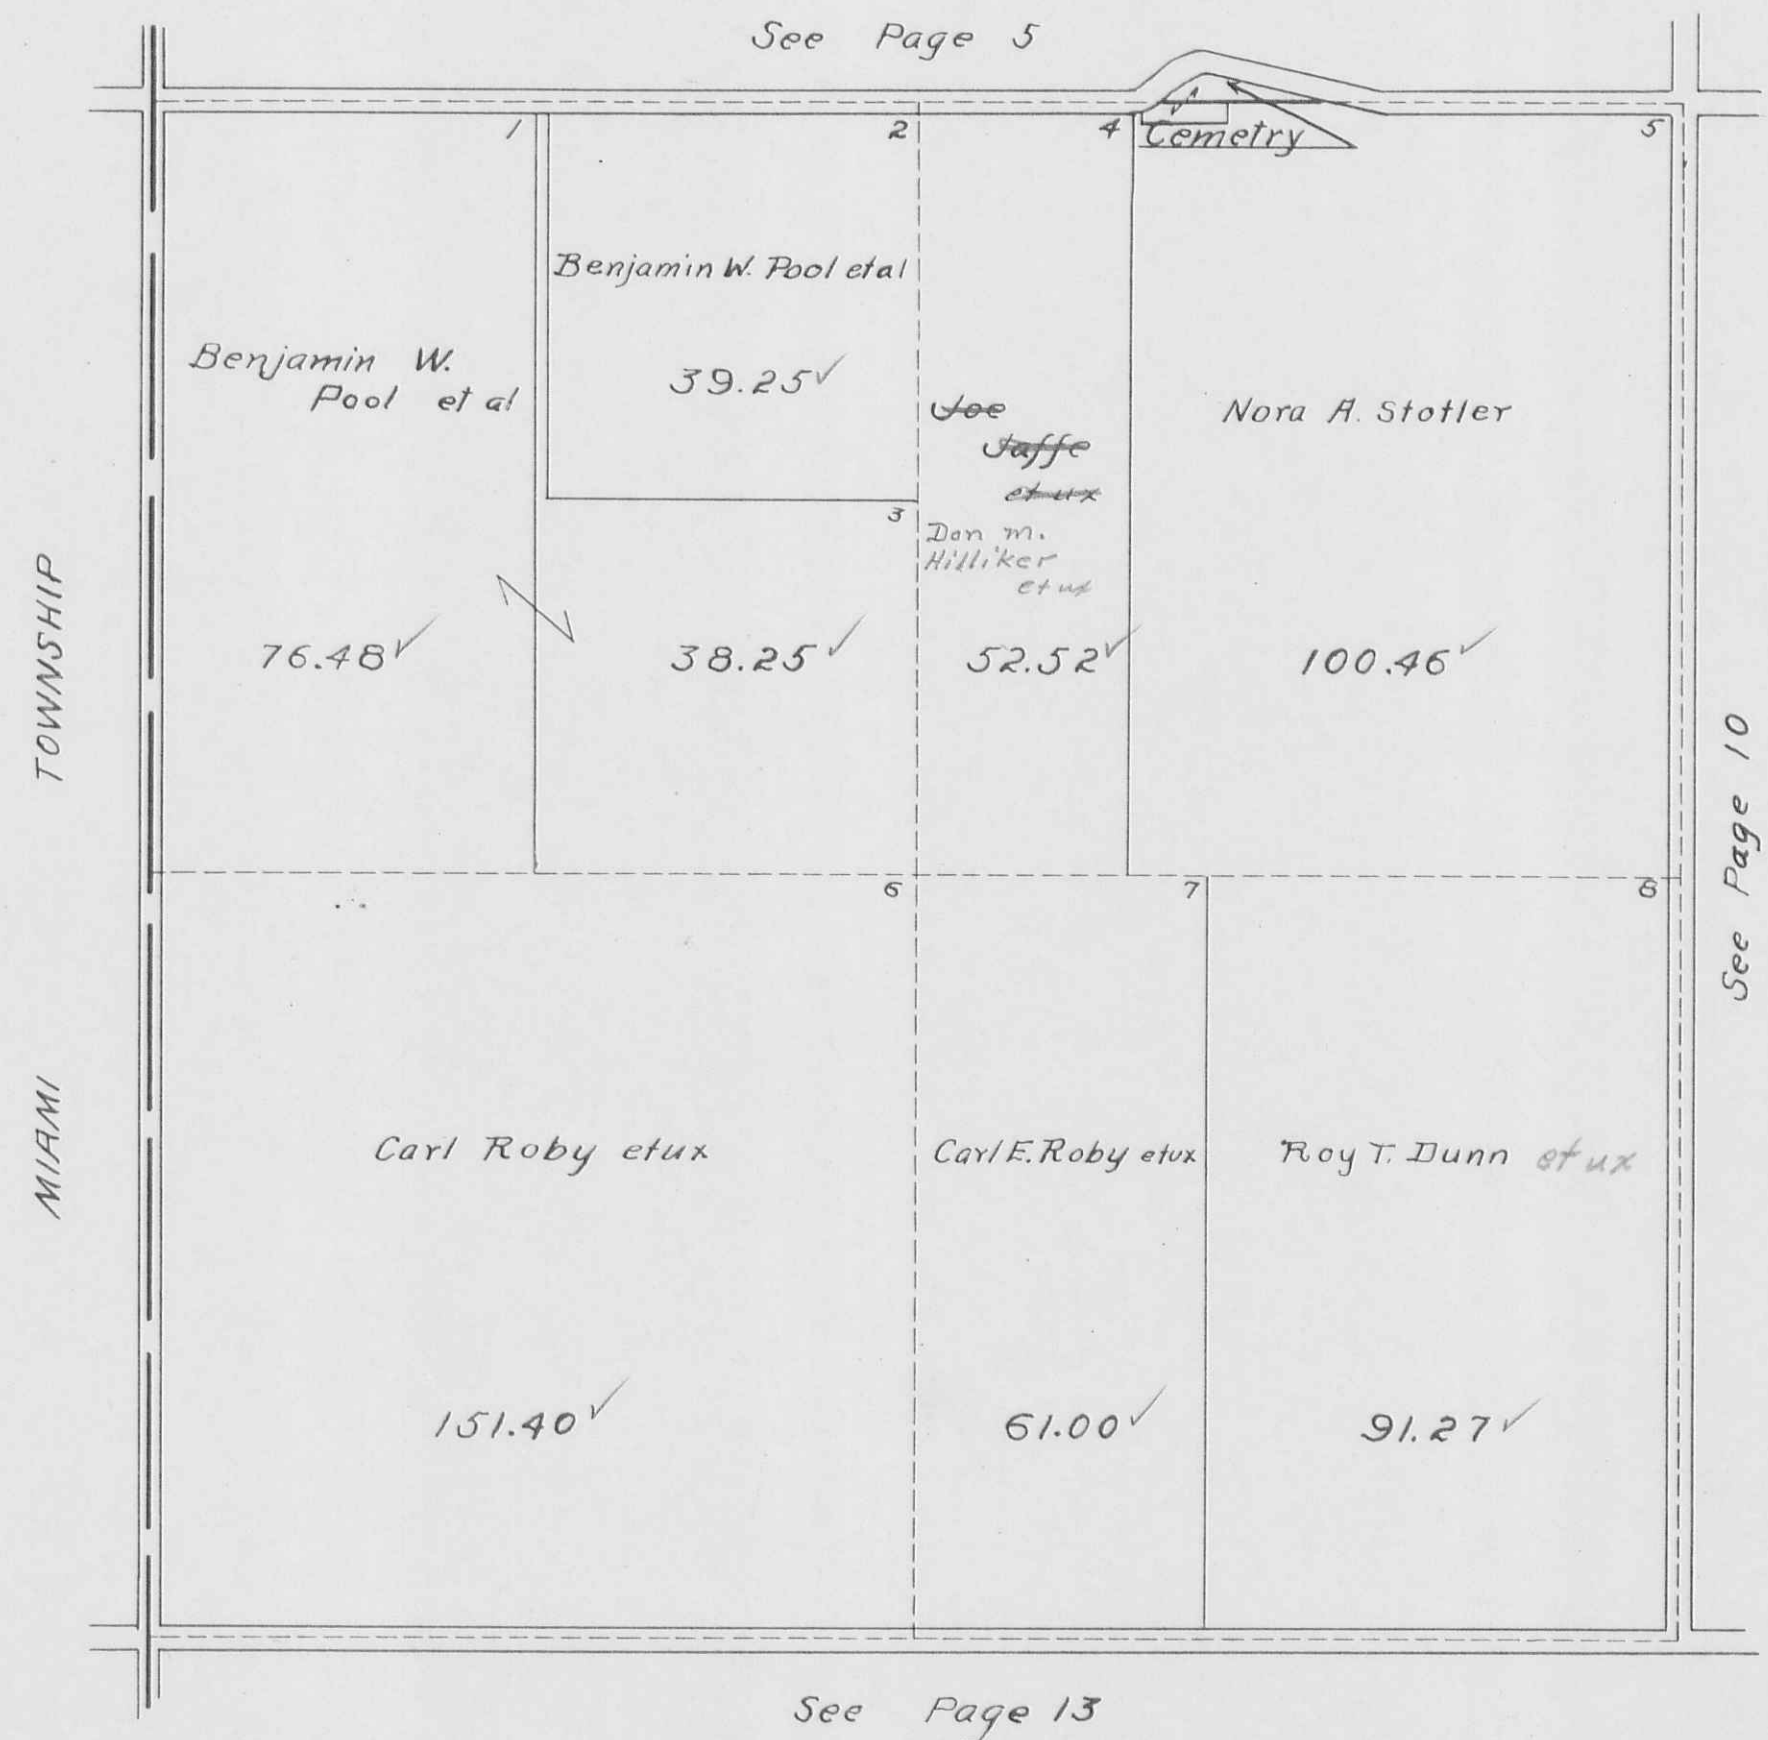



UNION TOWNSHIP  
SECTION 24 TOWN 4 RANGE 13


SCALE 10 CHAINS TO THE INCH

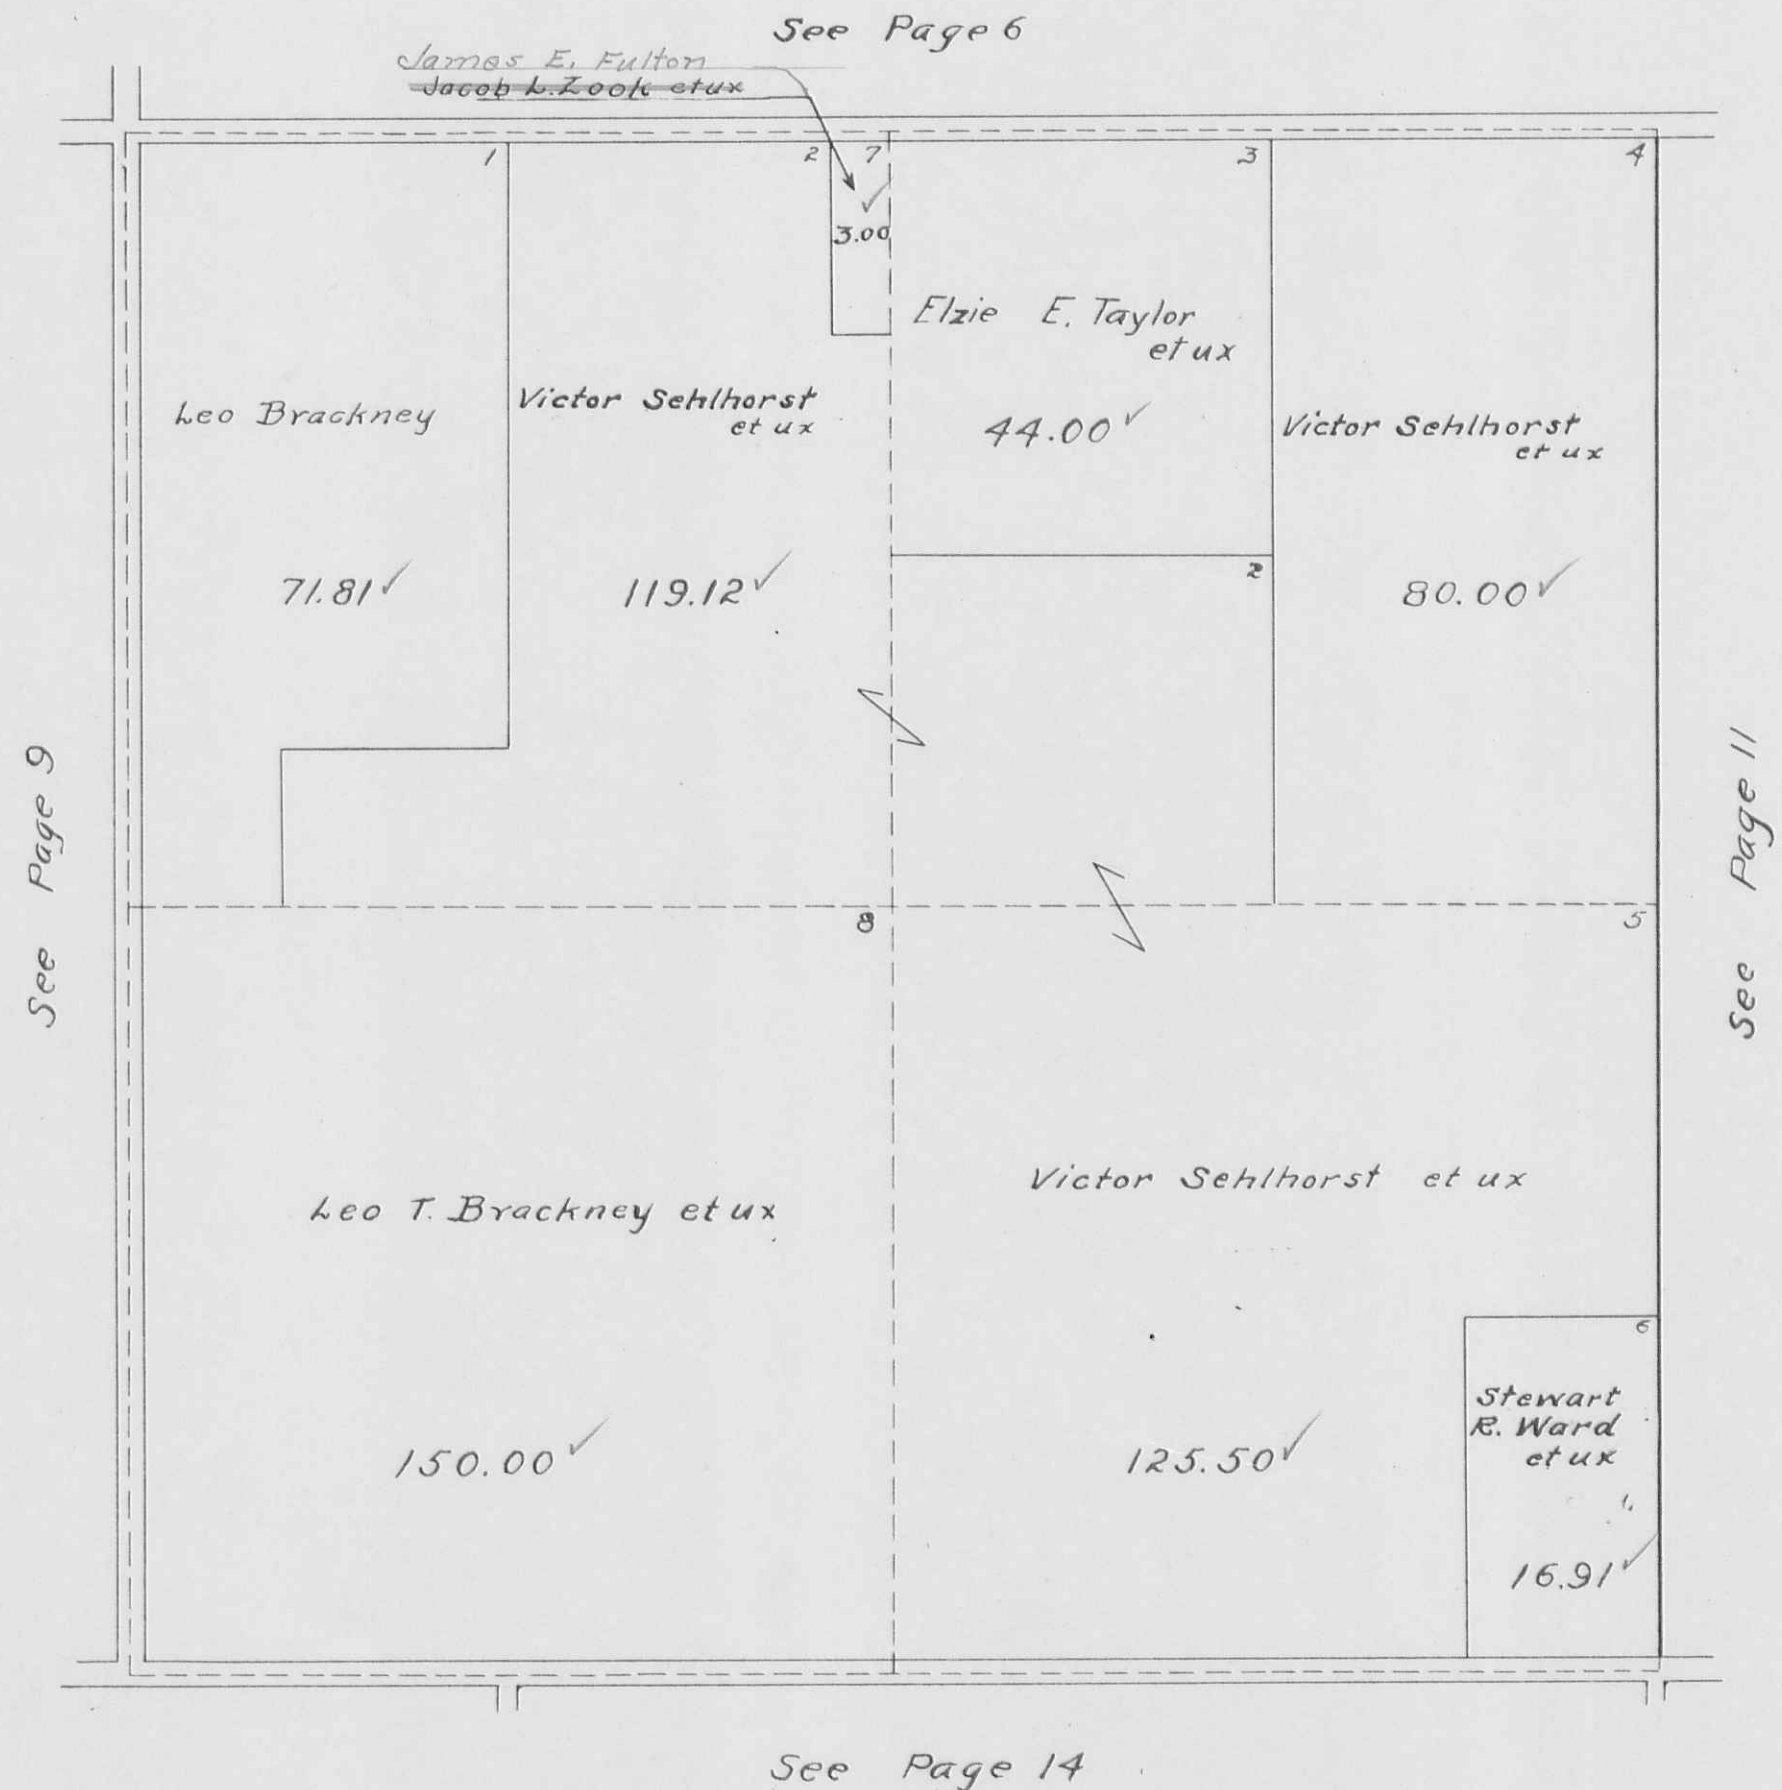

UNION TOWNSHIP  
SECTION 18 TOWN 4 RANGE 13

SCALE 10 CHAINS TO THE INCH

See Page 7

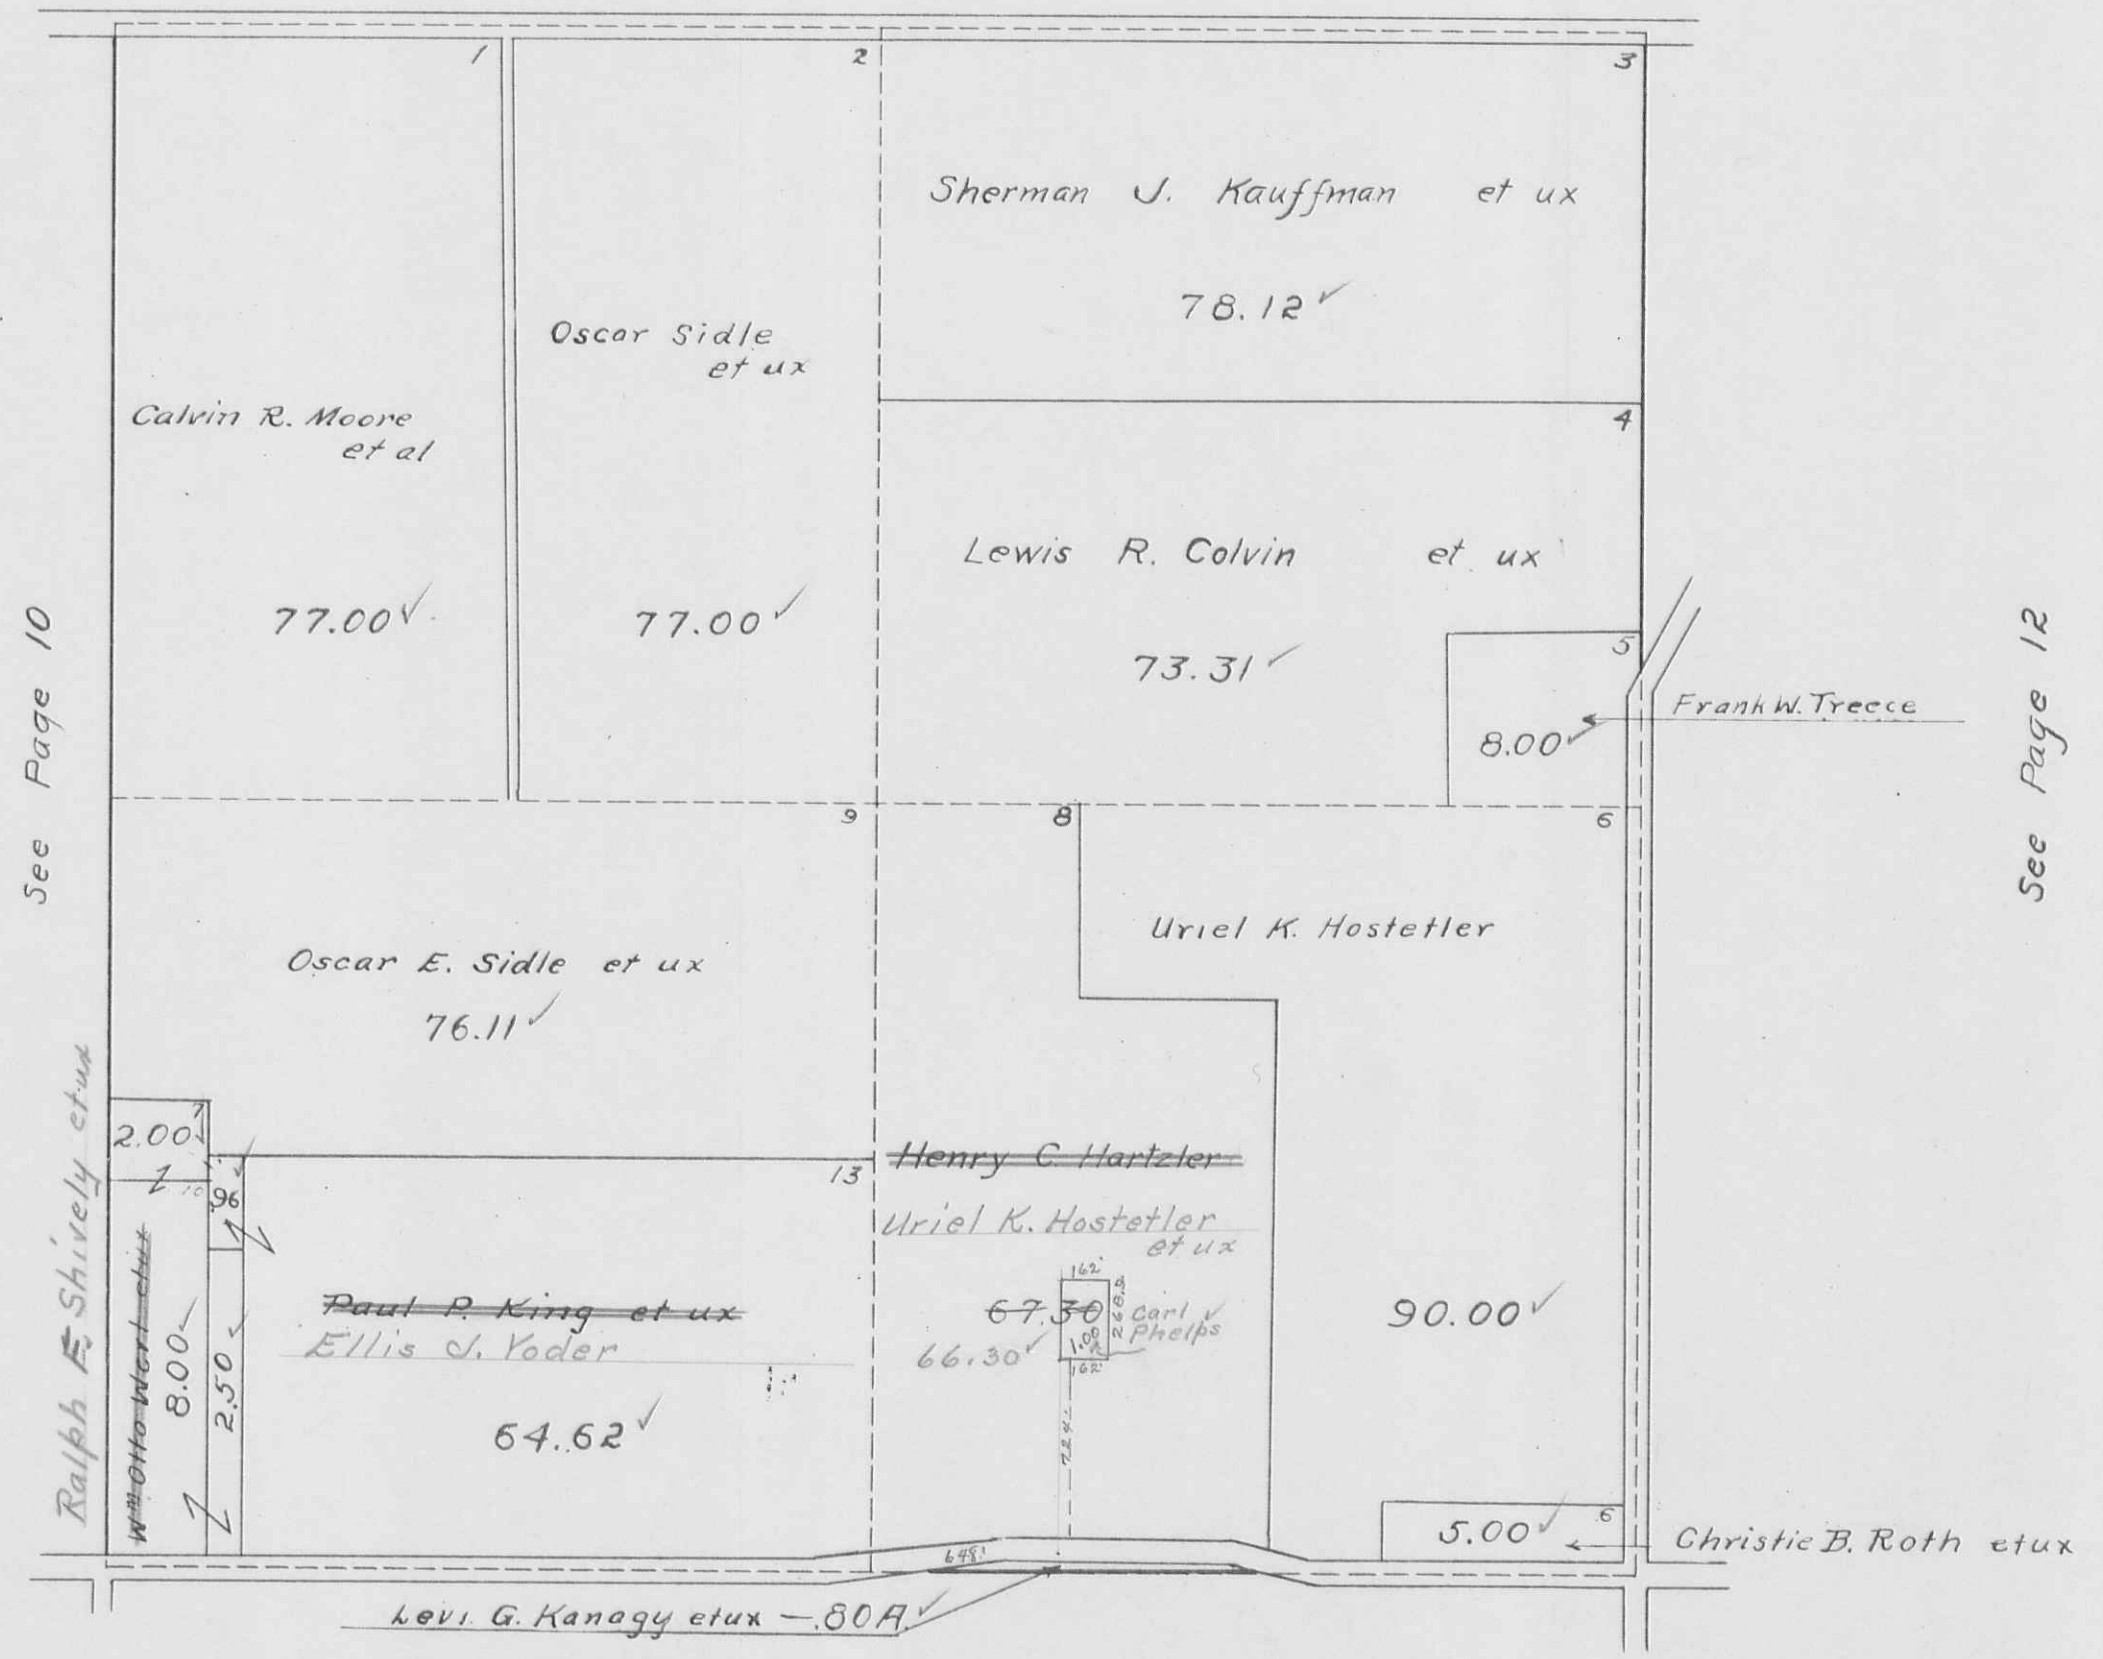

See Page 10


See Page 12

See Page 15

SECTION 12 TOWN 4 RANGE 13


SECTION 6 TOWN 4 RANGE 13

SCALE 10 CHAINS TO THE INCH

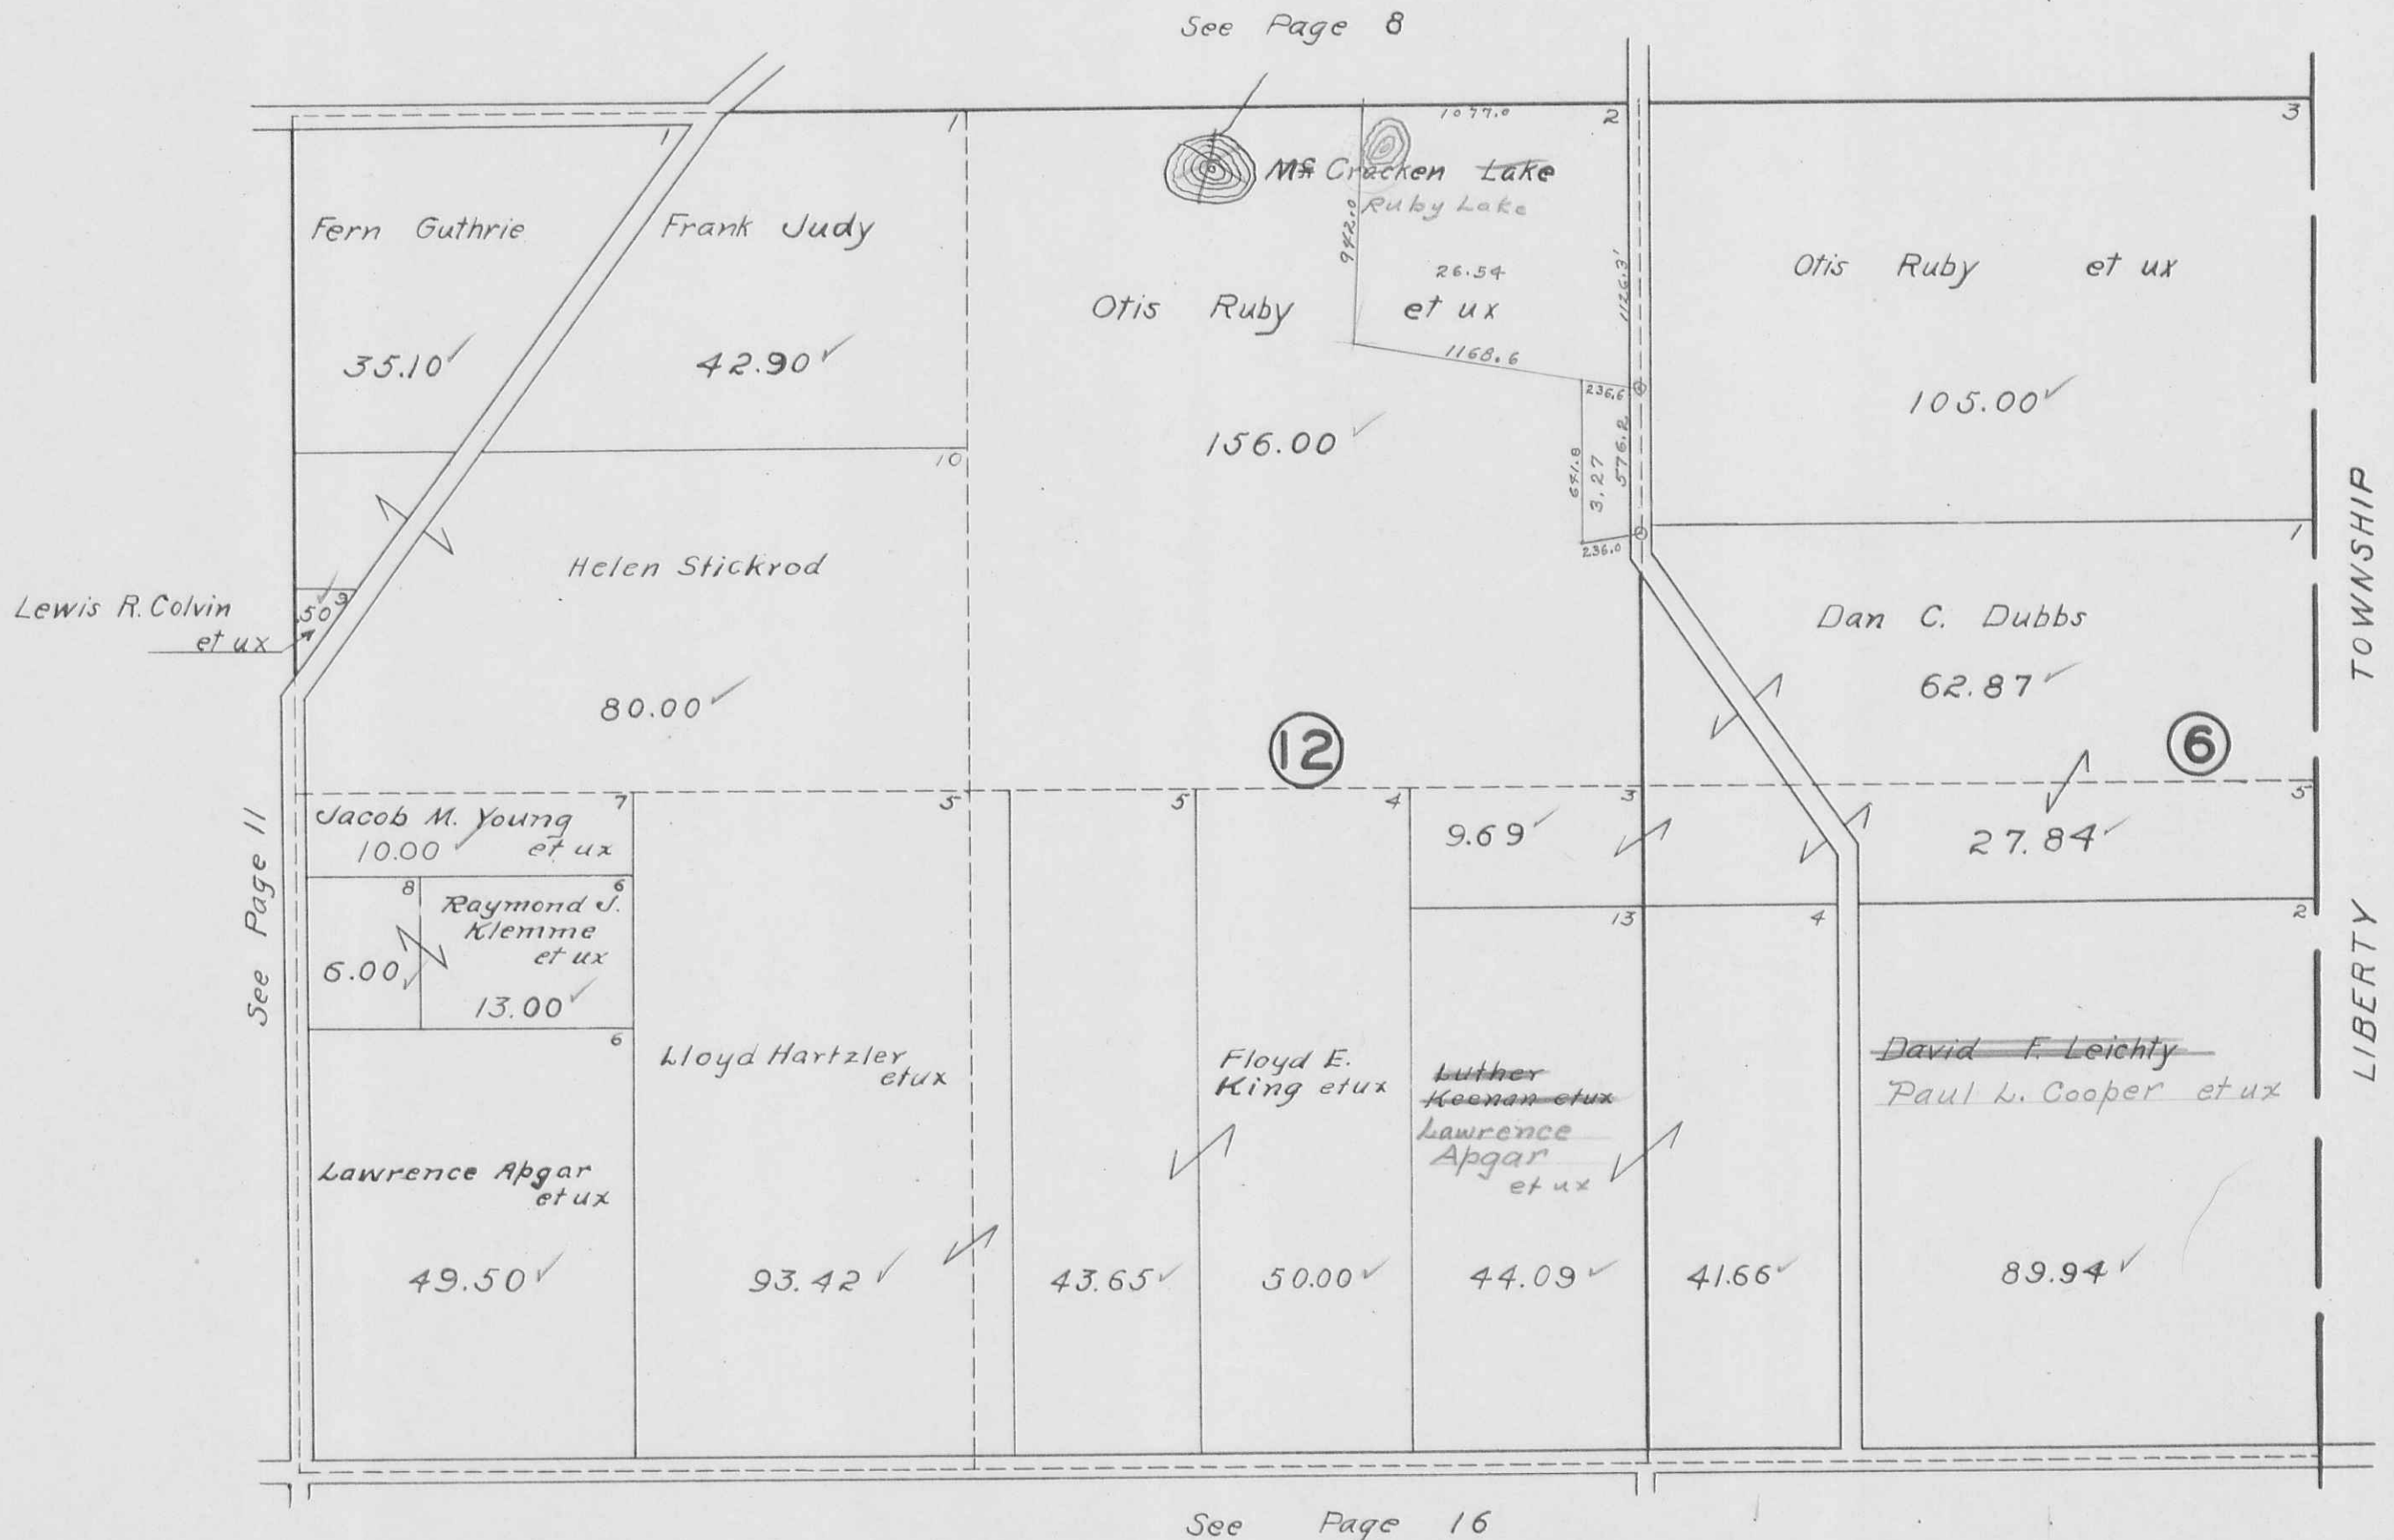

UNION TOWNSHIP  
SECTION 29 TOWN 4 RANGE 13

SCALE 10 CHAINS TO THE INCH

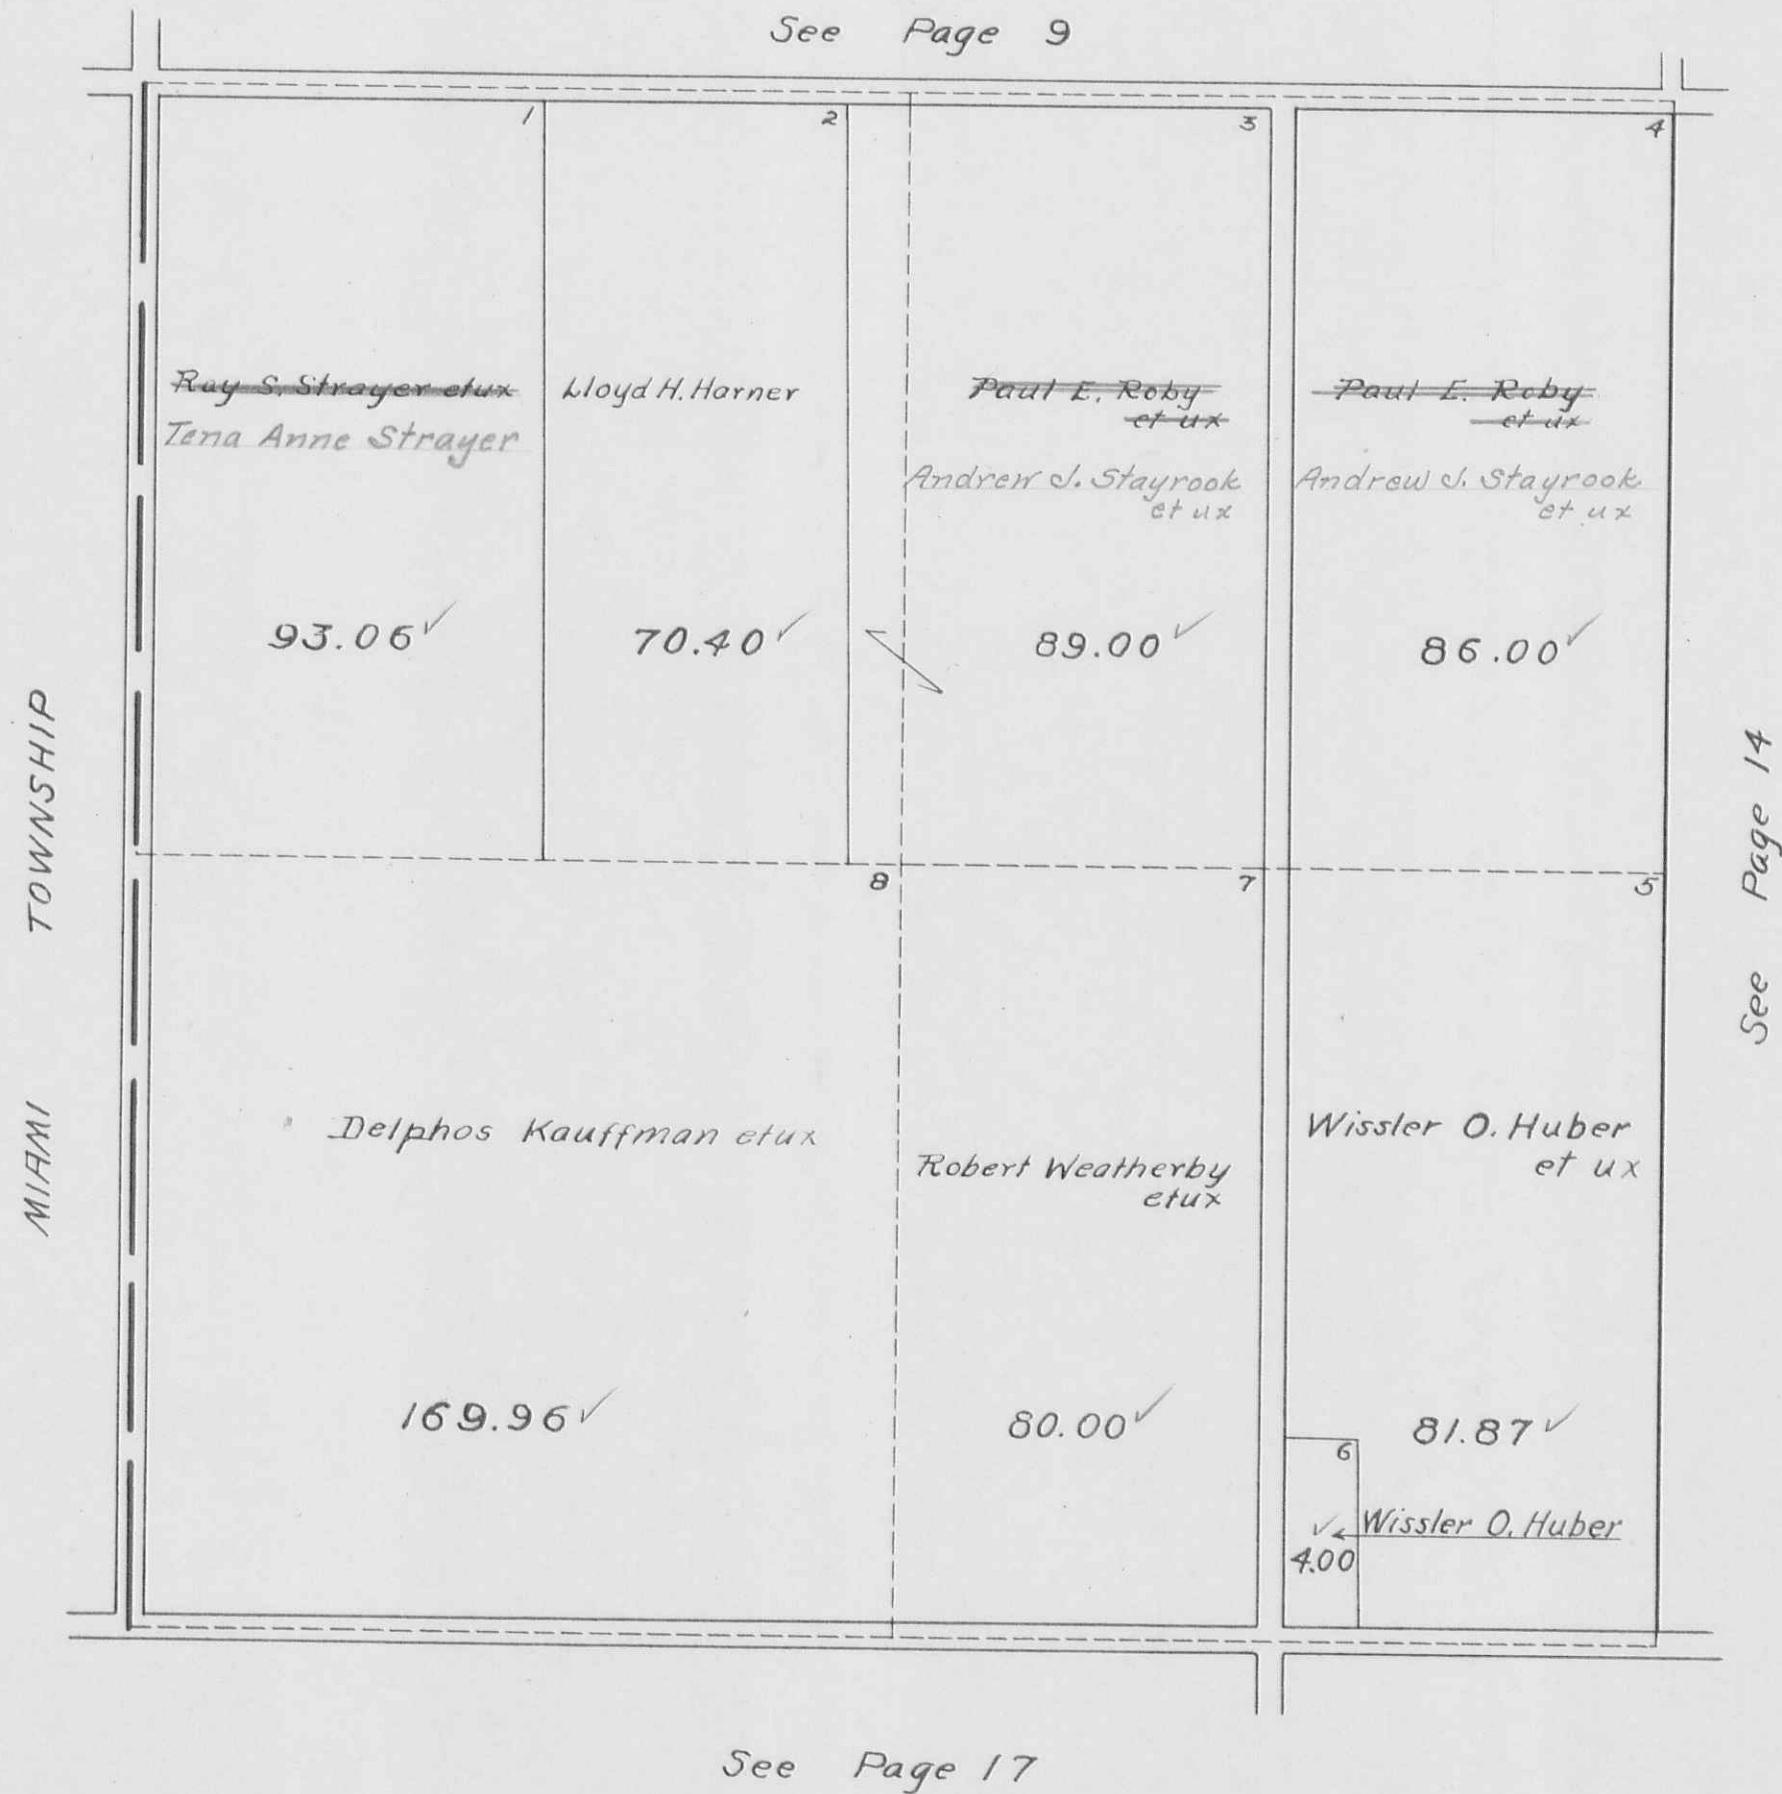




UNION TOWNSHIP  
SECTION 23 TOWN 4 RANGE 13


SCALE 10 CHAINS TO THE INCH

See Page 10

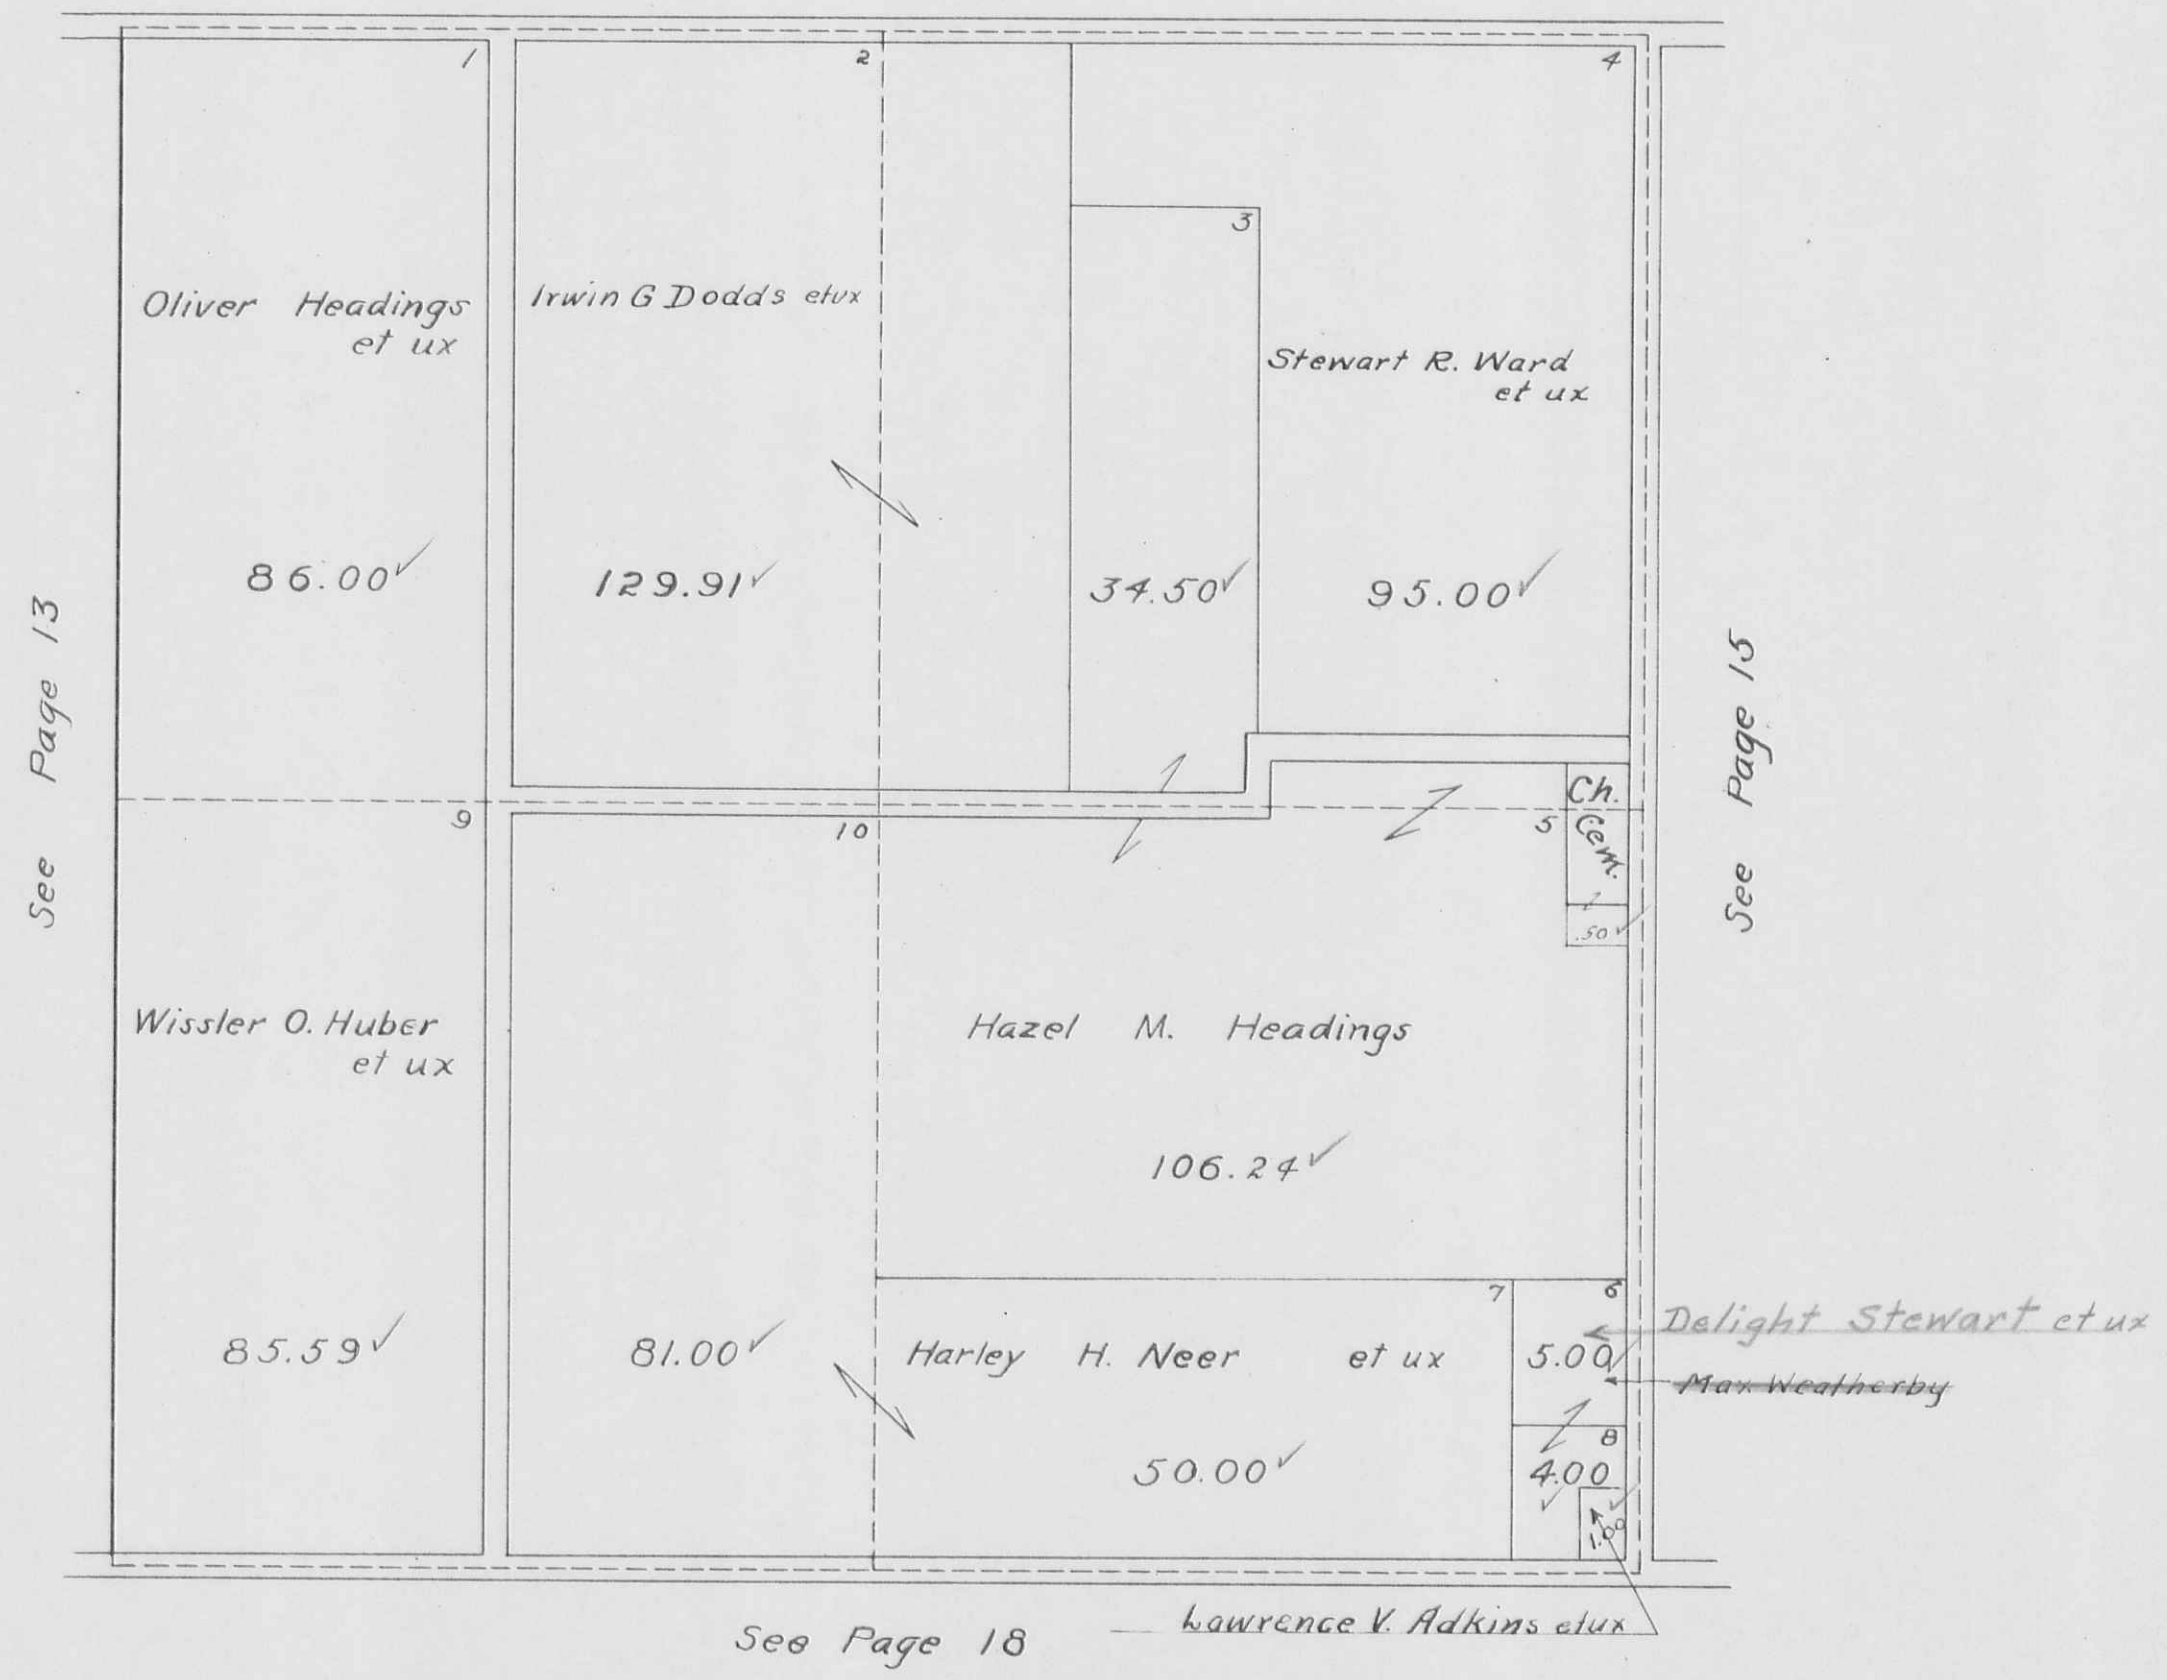

SECTION 17 TOWN 4 RANGE 13

SCALE 10 CHAINS TO THE INCH

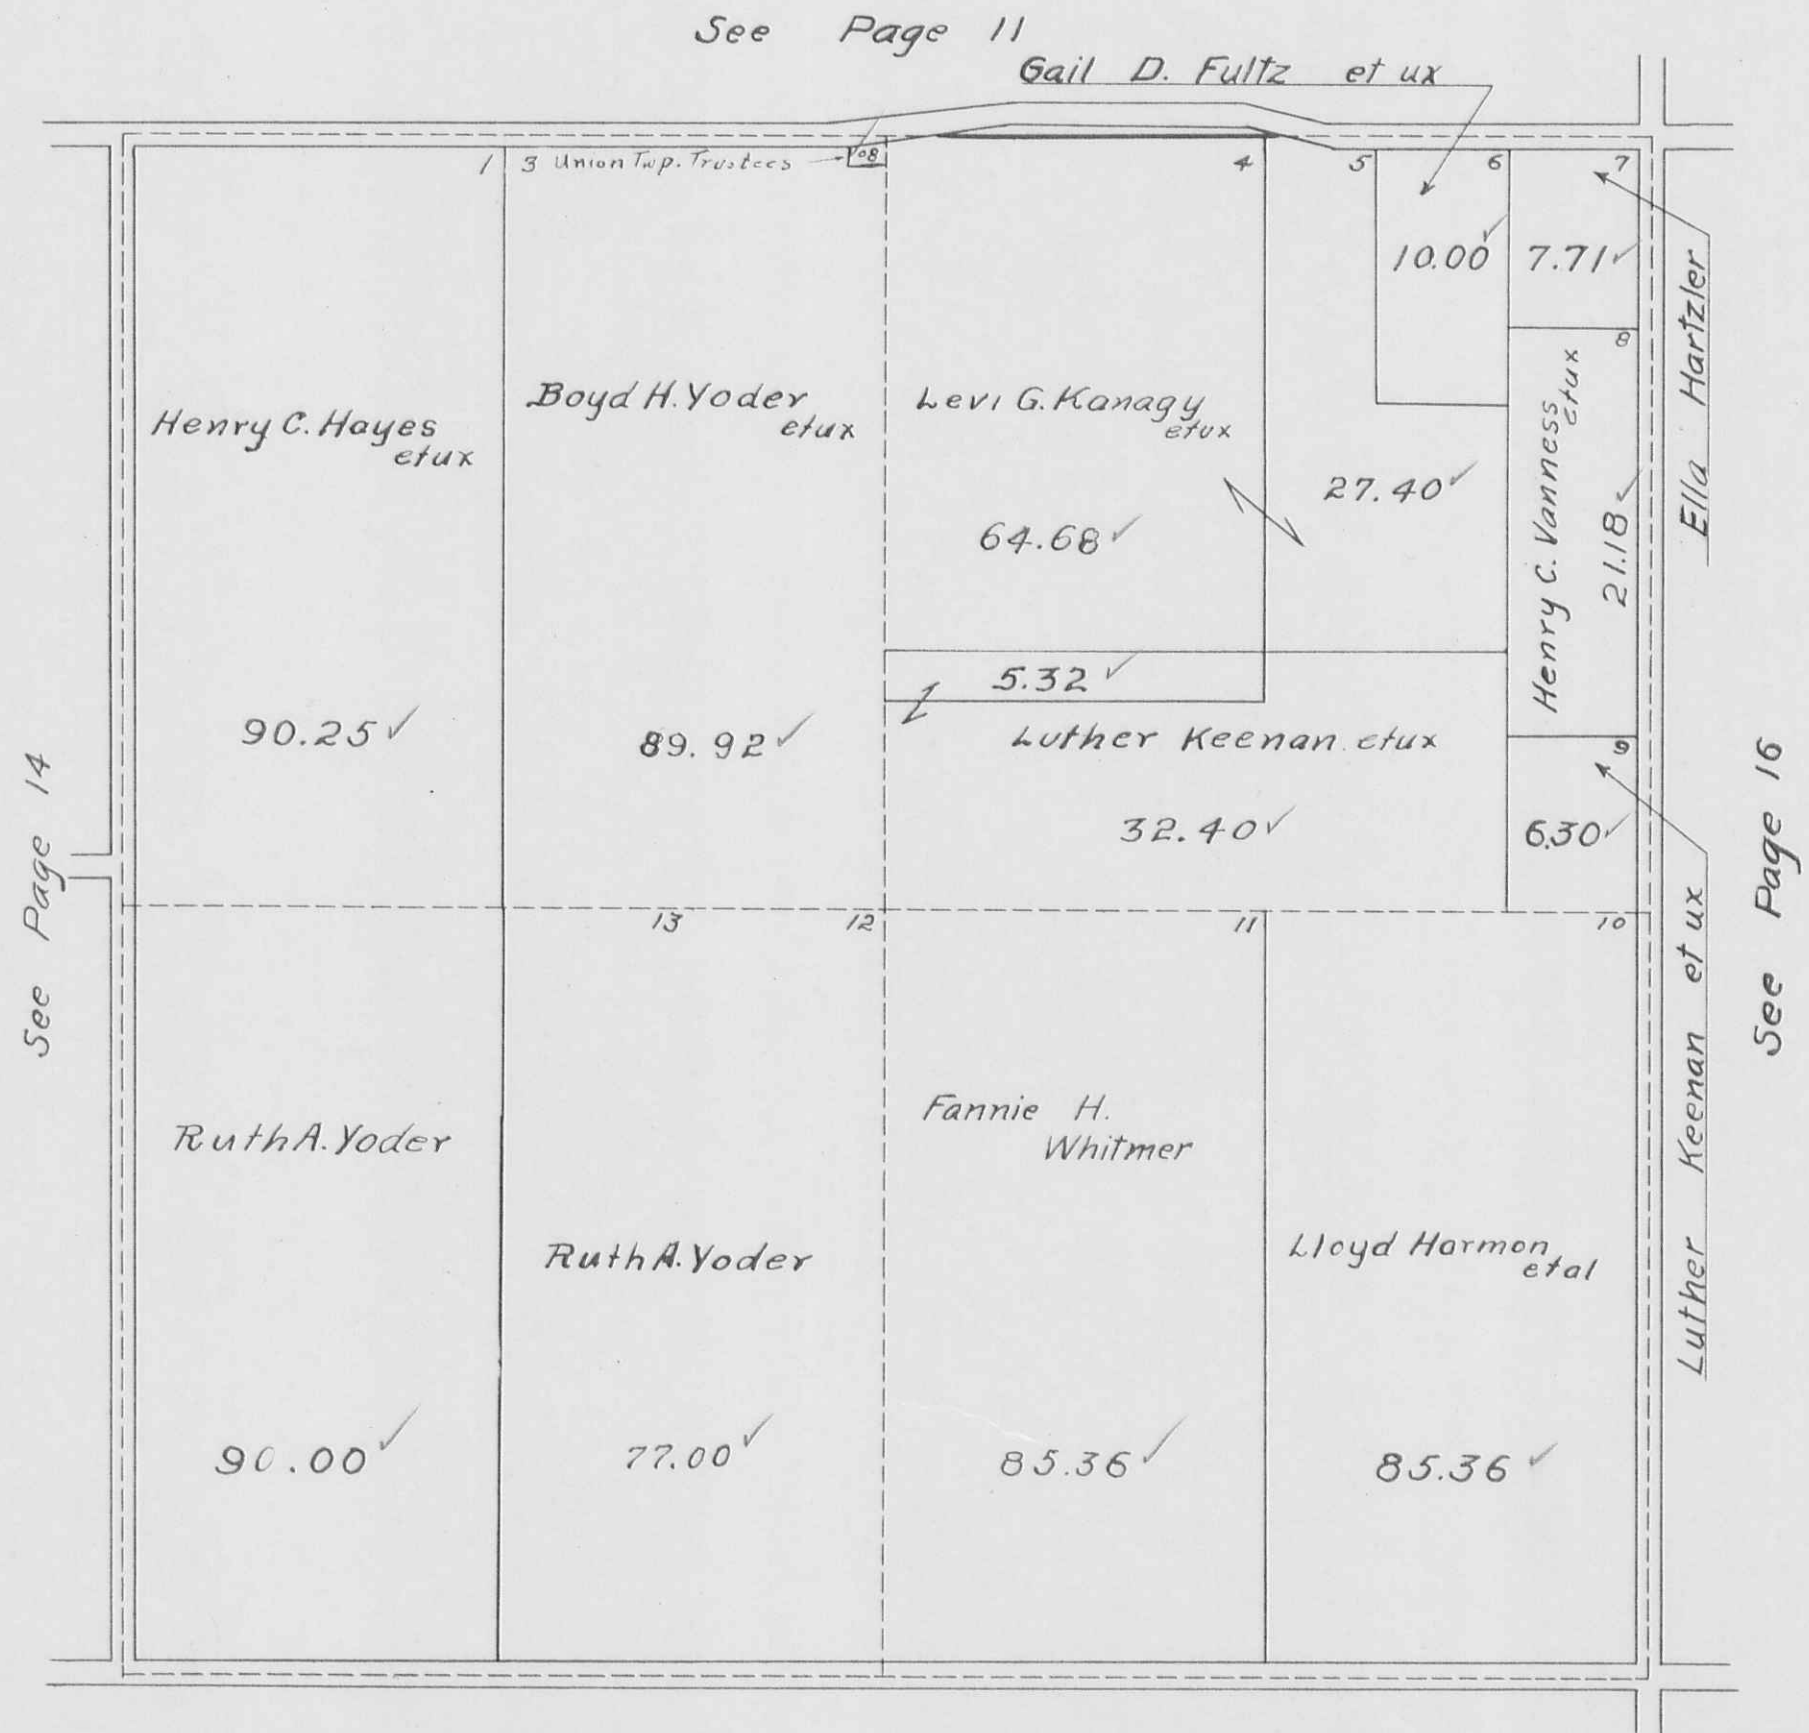


SECTION 11 TOWN 4 RANGE 13

SECTION 5 TOWN 4 RANGE 13

SCALE 10 CHAINS TO THE INCH

See Page 12

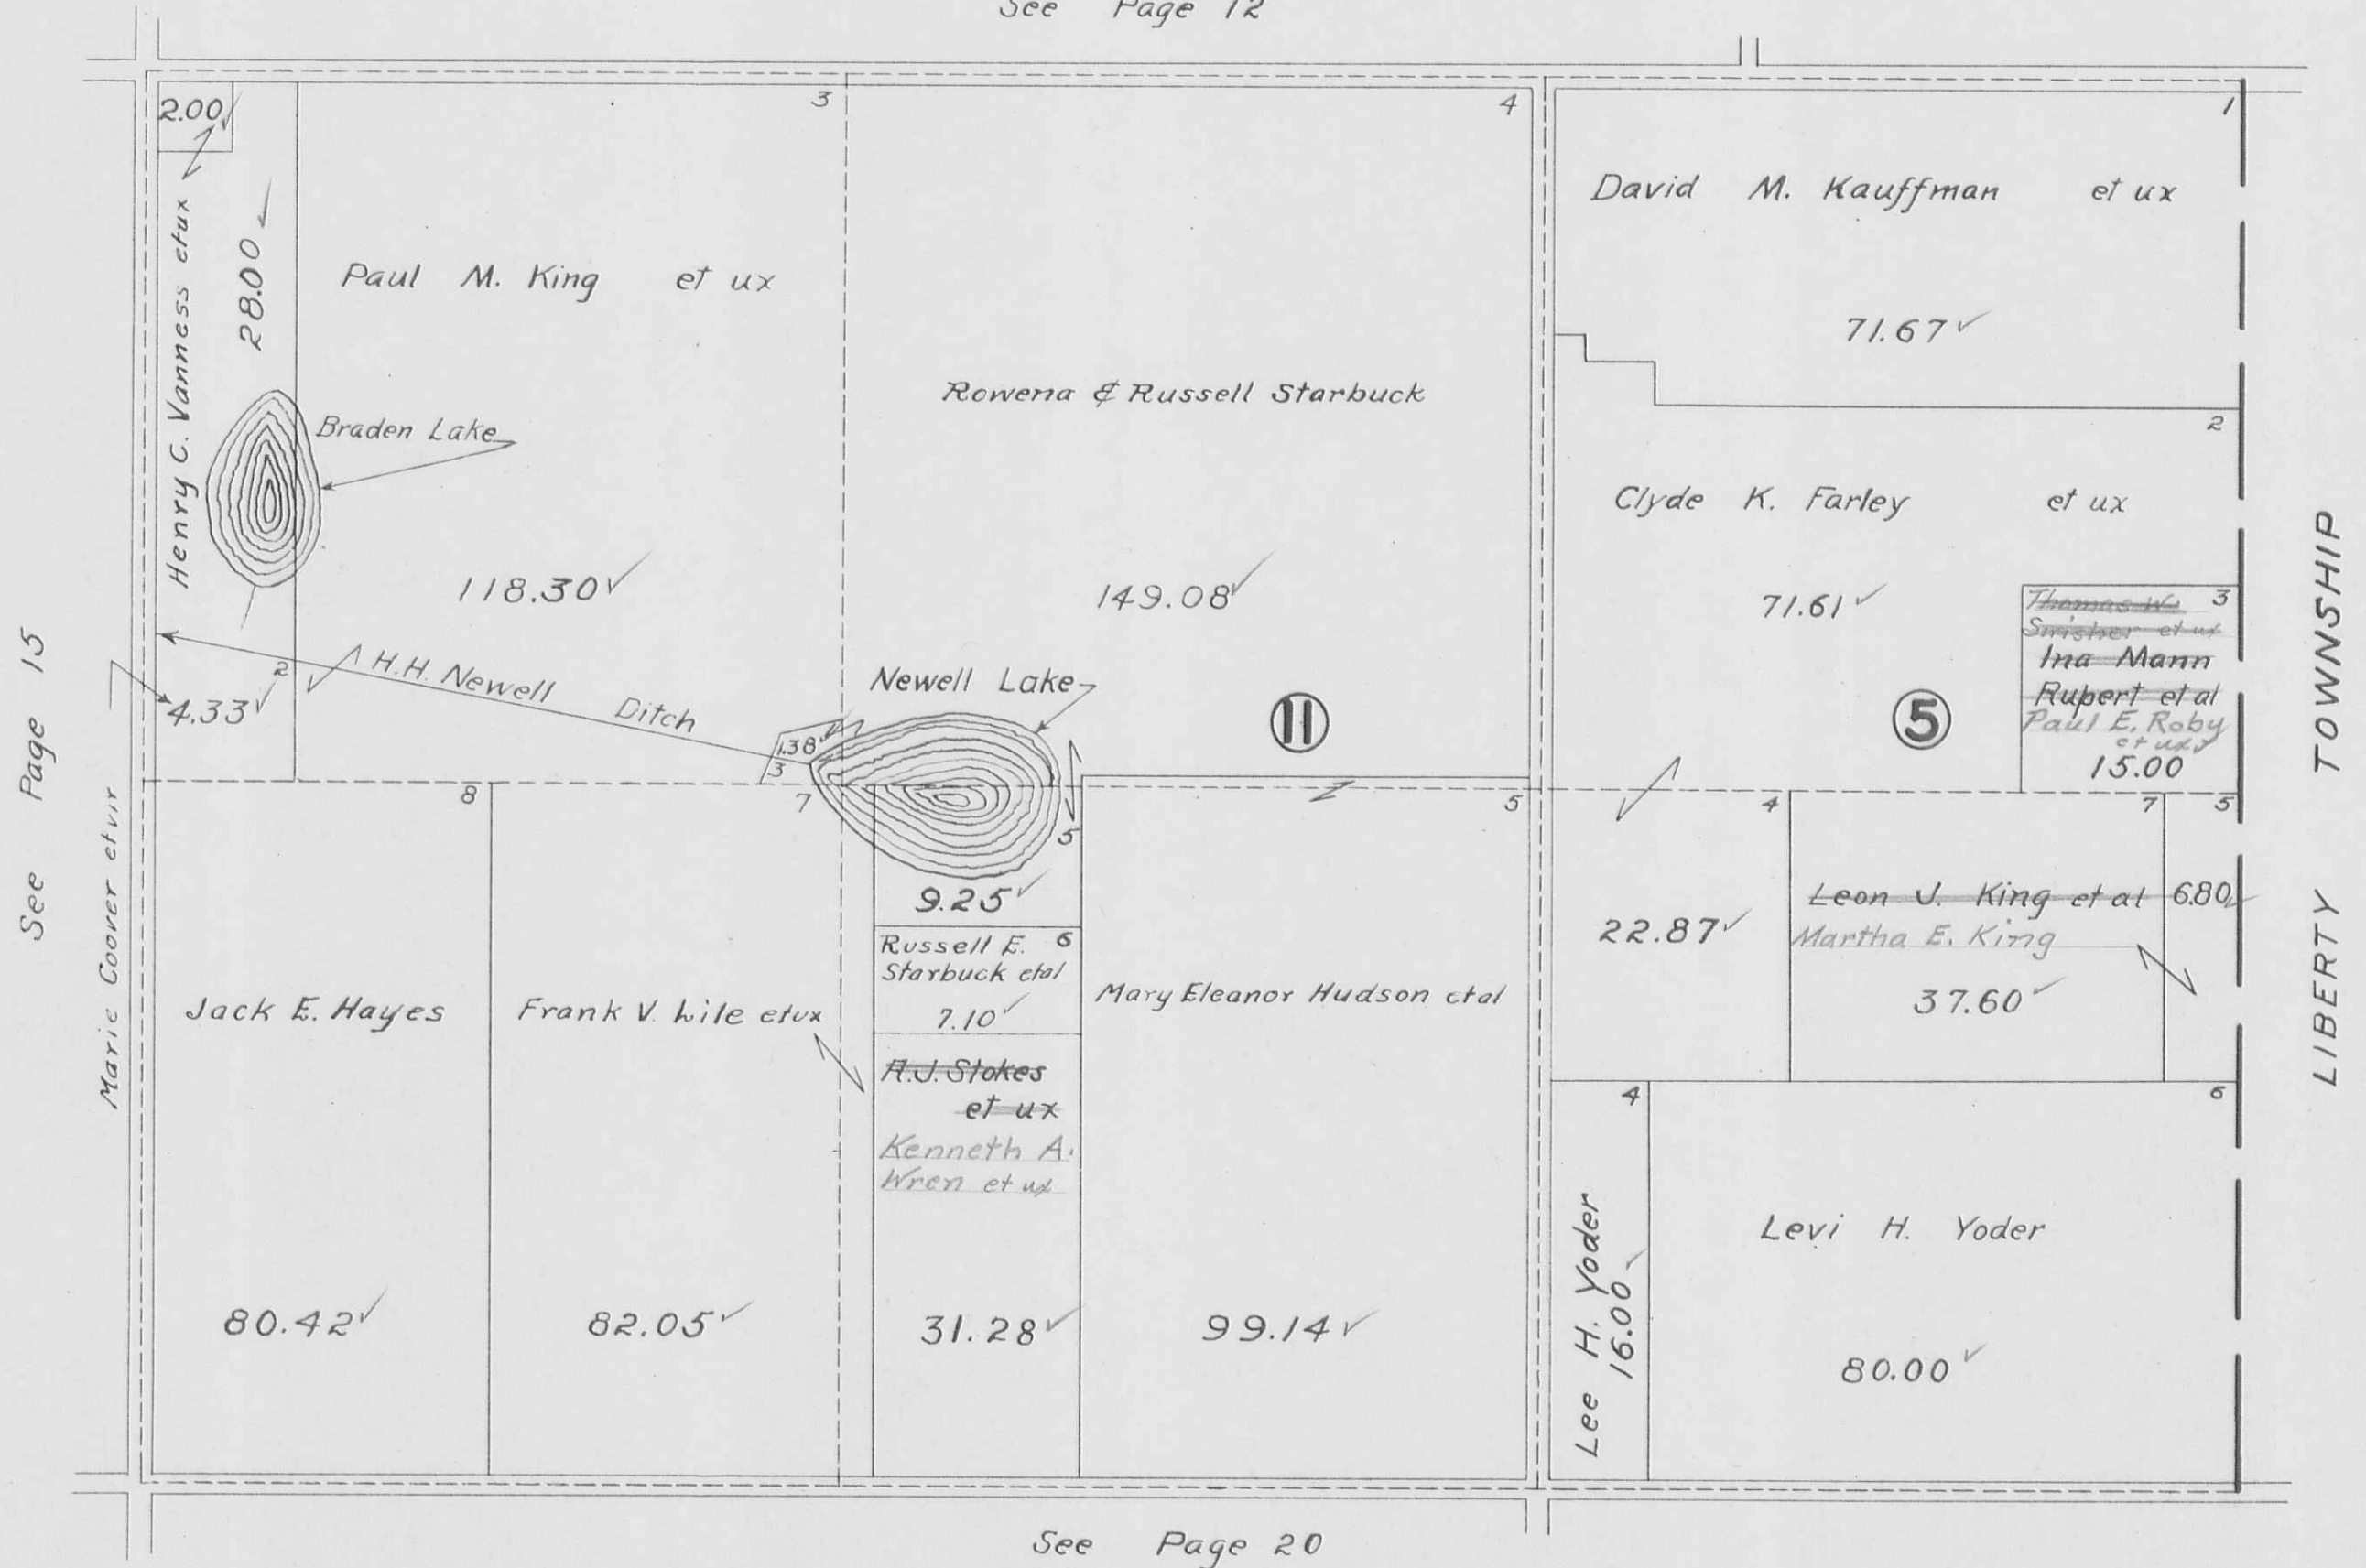

See Page 15

Marie Coover et ux


LIBERTY TOWNSHIP

See Page 20

UNION TOWNSHIP  
SECTION 28 TOWN 4 RANGE 13

SCALE 10 CHAINS TO THE INCH

See Page 13

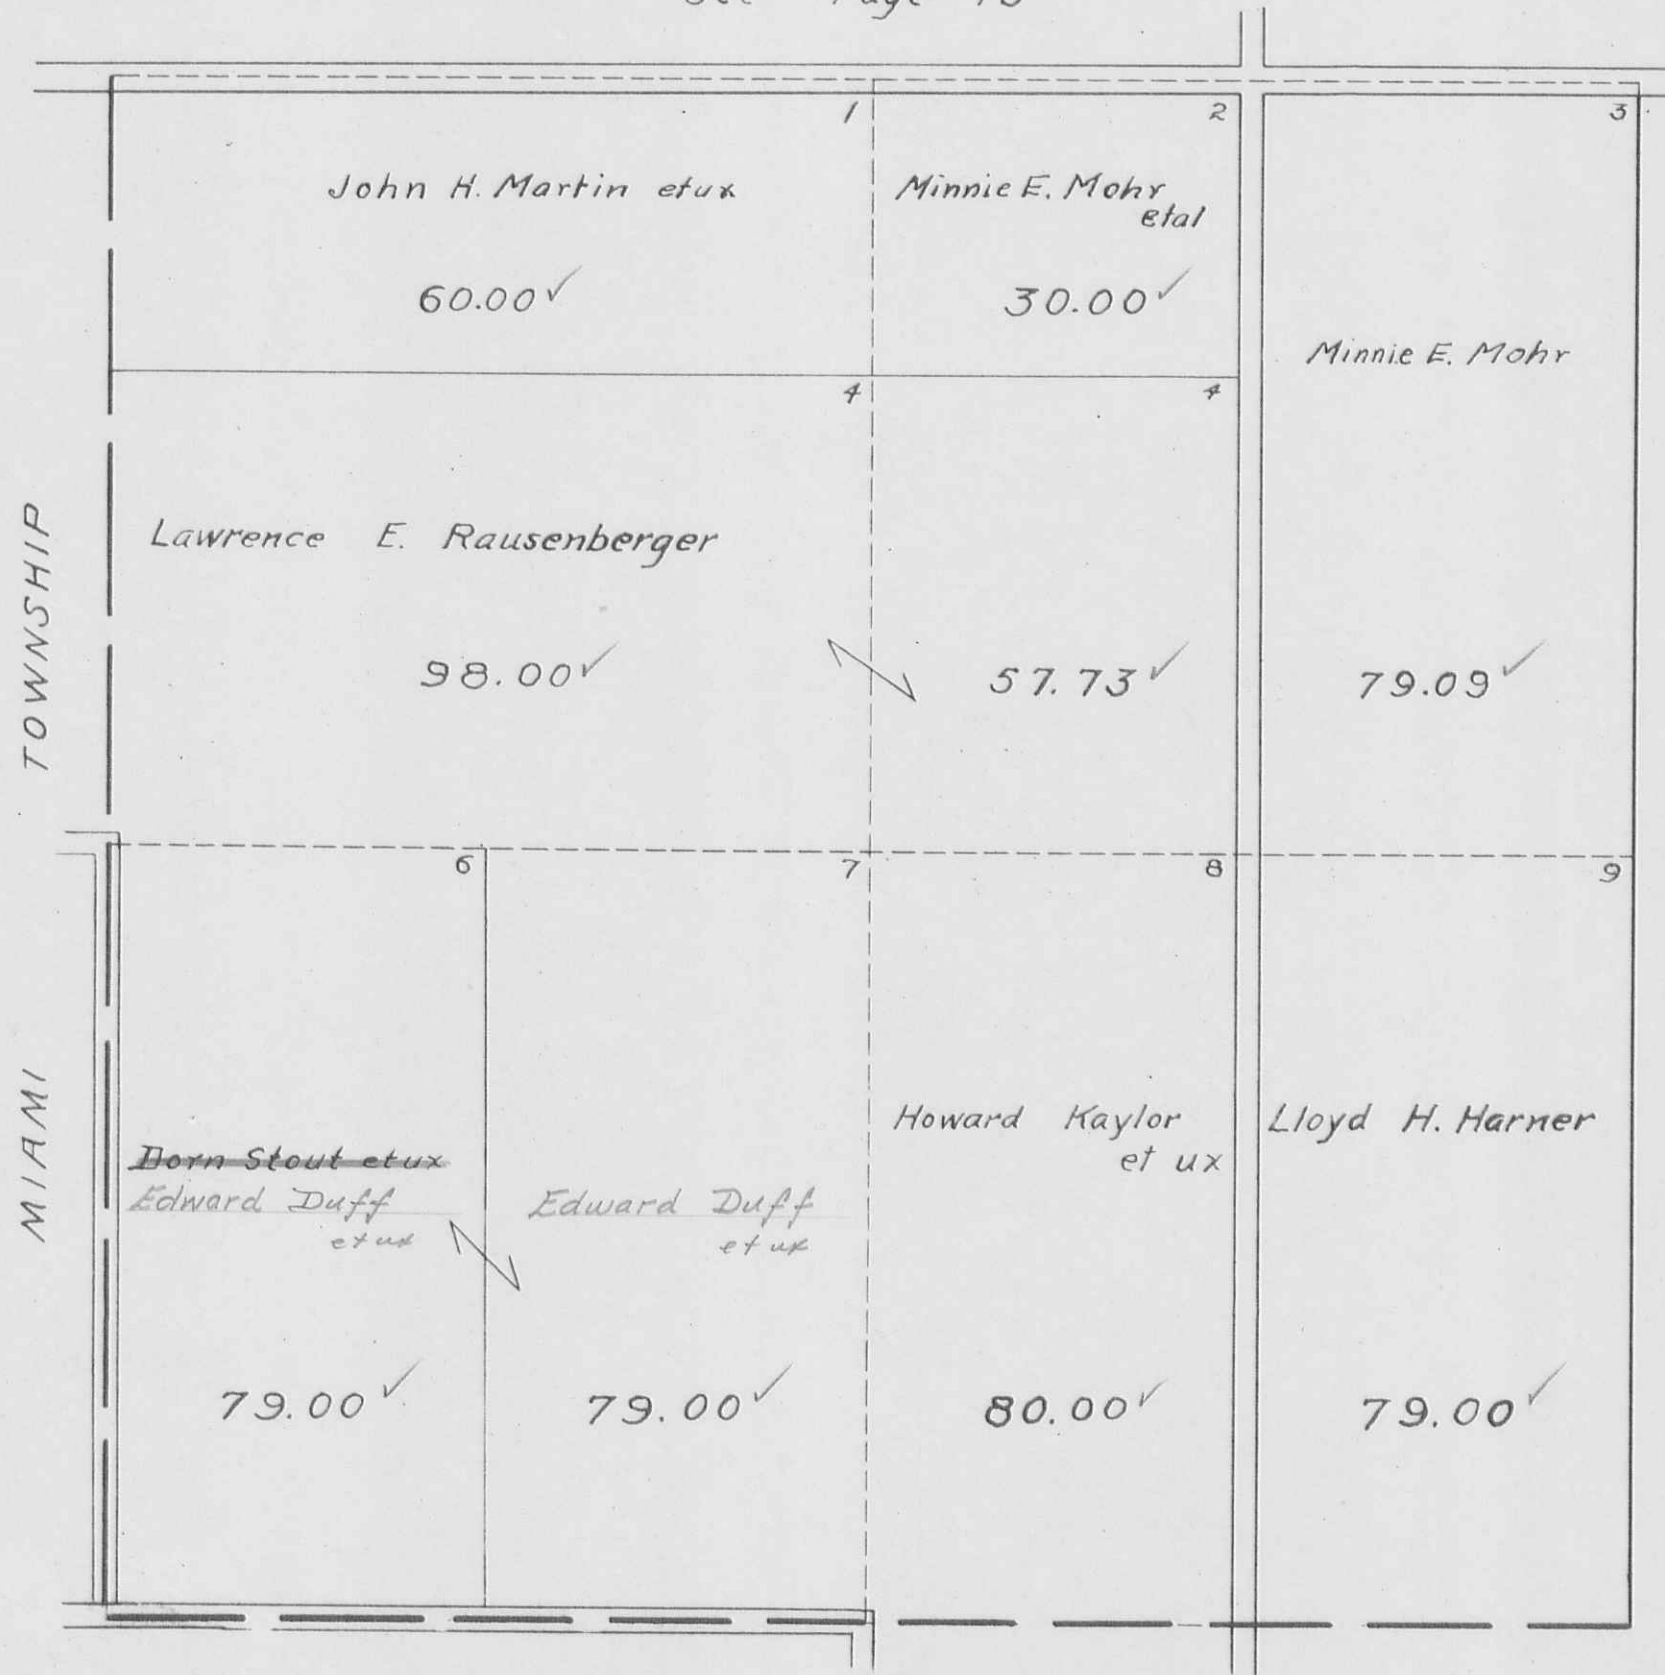

See Page 18.


CHAMPAIGN COUNTY



UNION TOWNSHIP  
SECTION 22 TOWN 4 RANGE 13


SCALE 10 CHAINS TO THE INCH

See Page 14

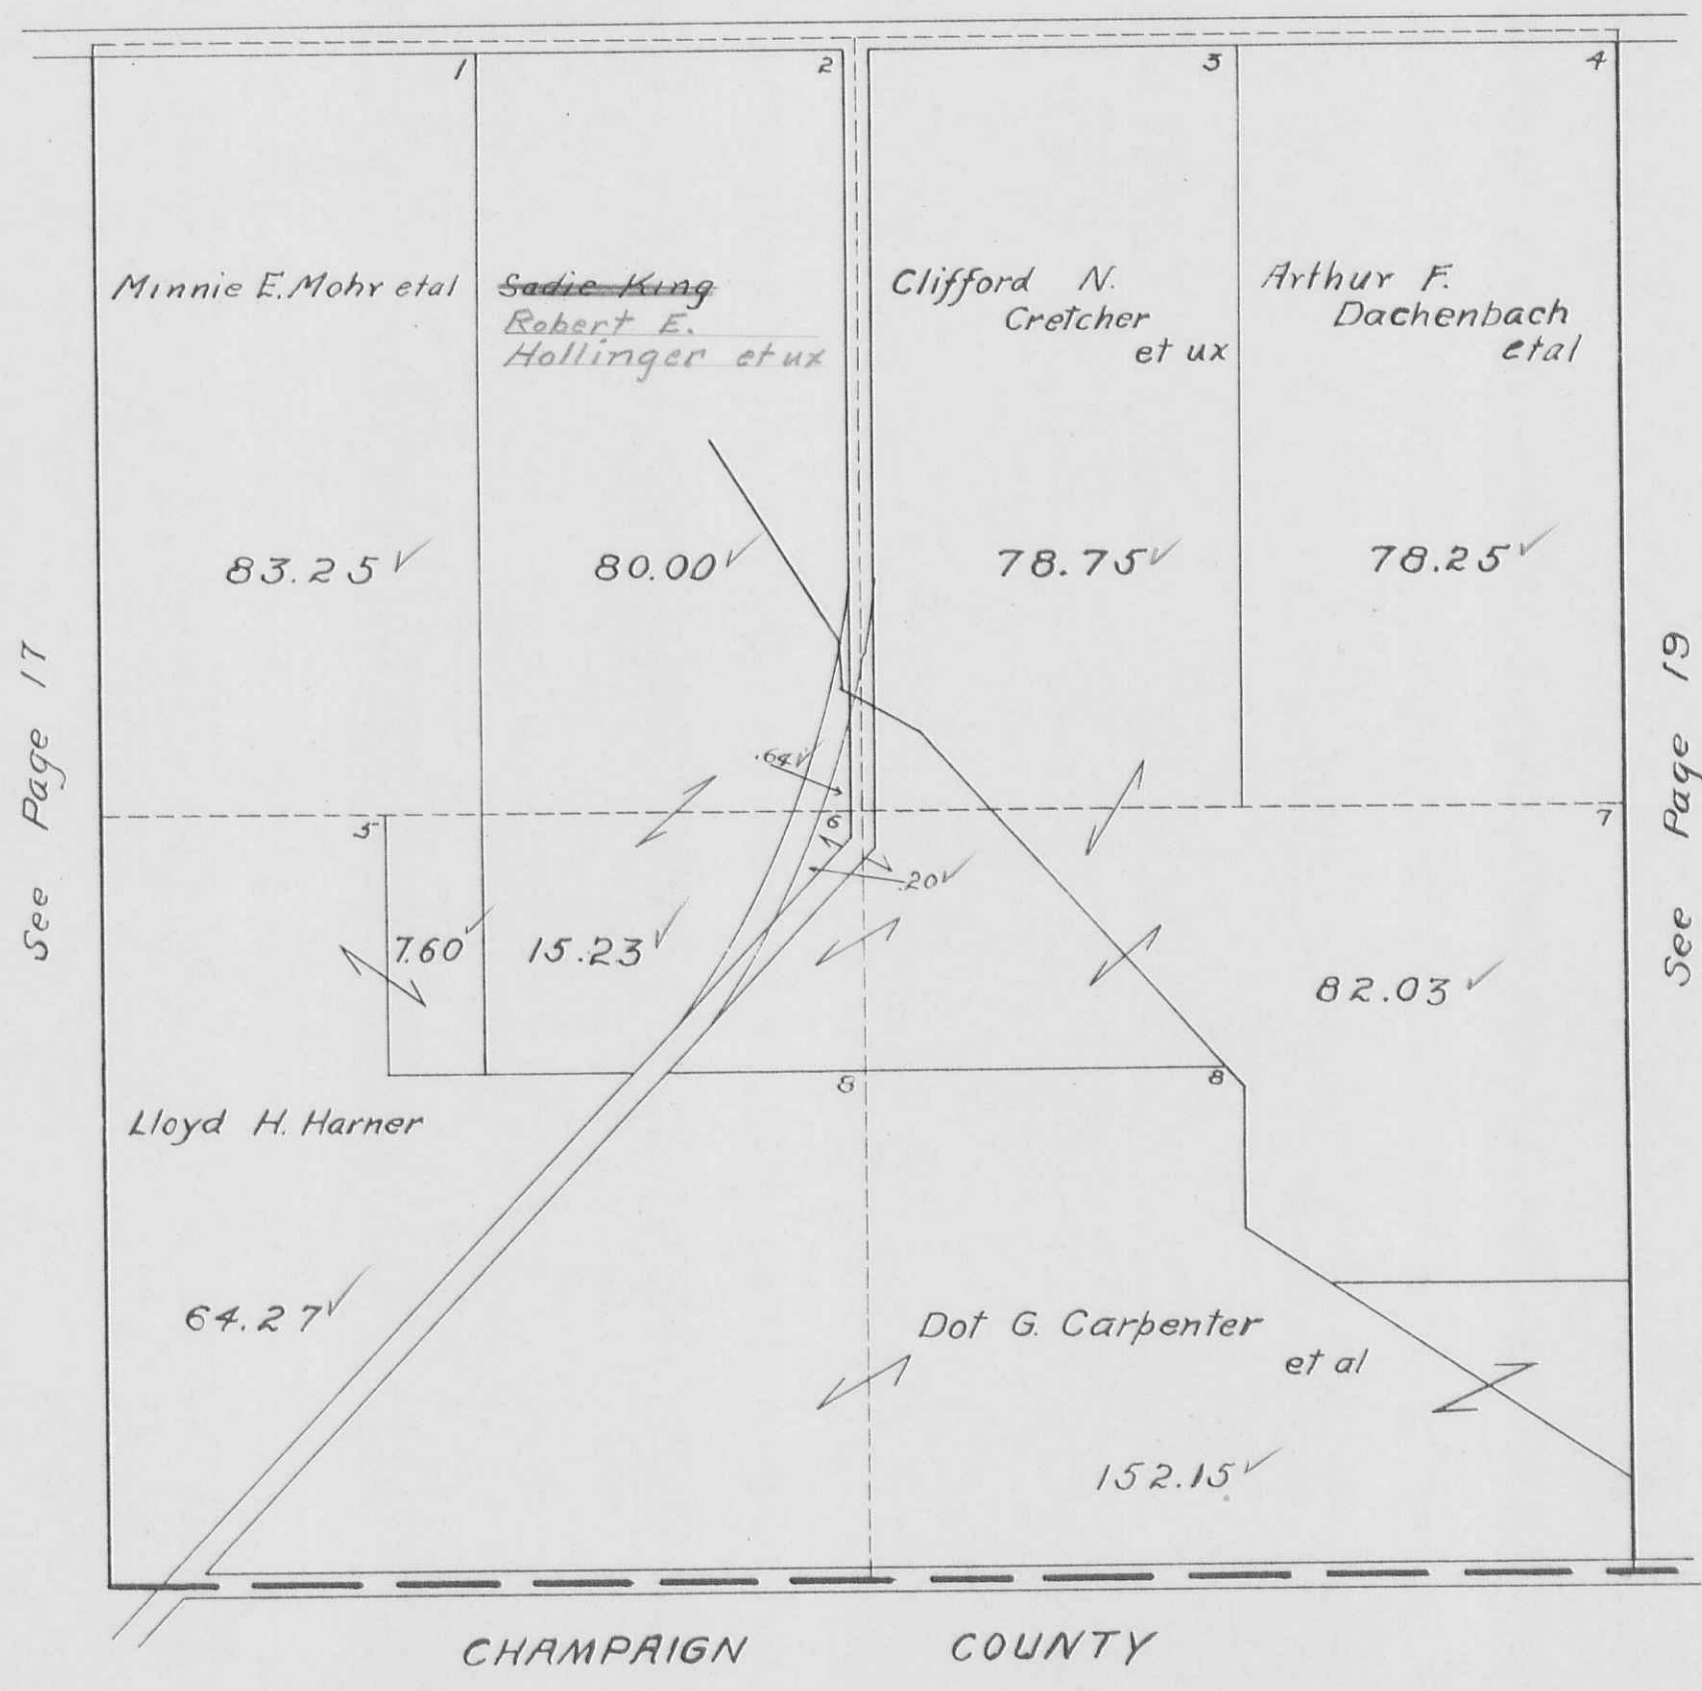

UNION TOWNSHIP  
SECTION 16 TOWN 4 RANGE 13

SCALE 10 CHAINS TO THE INCH

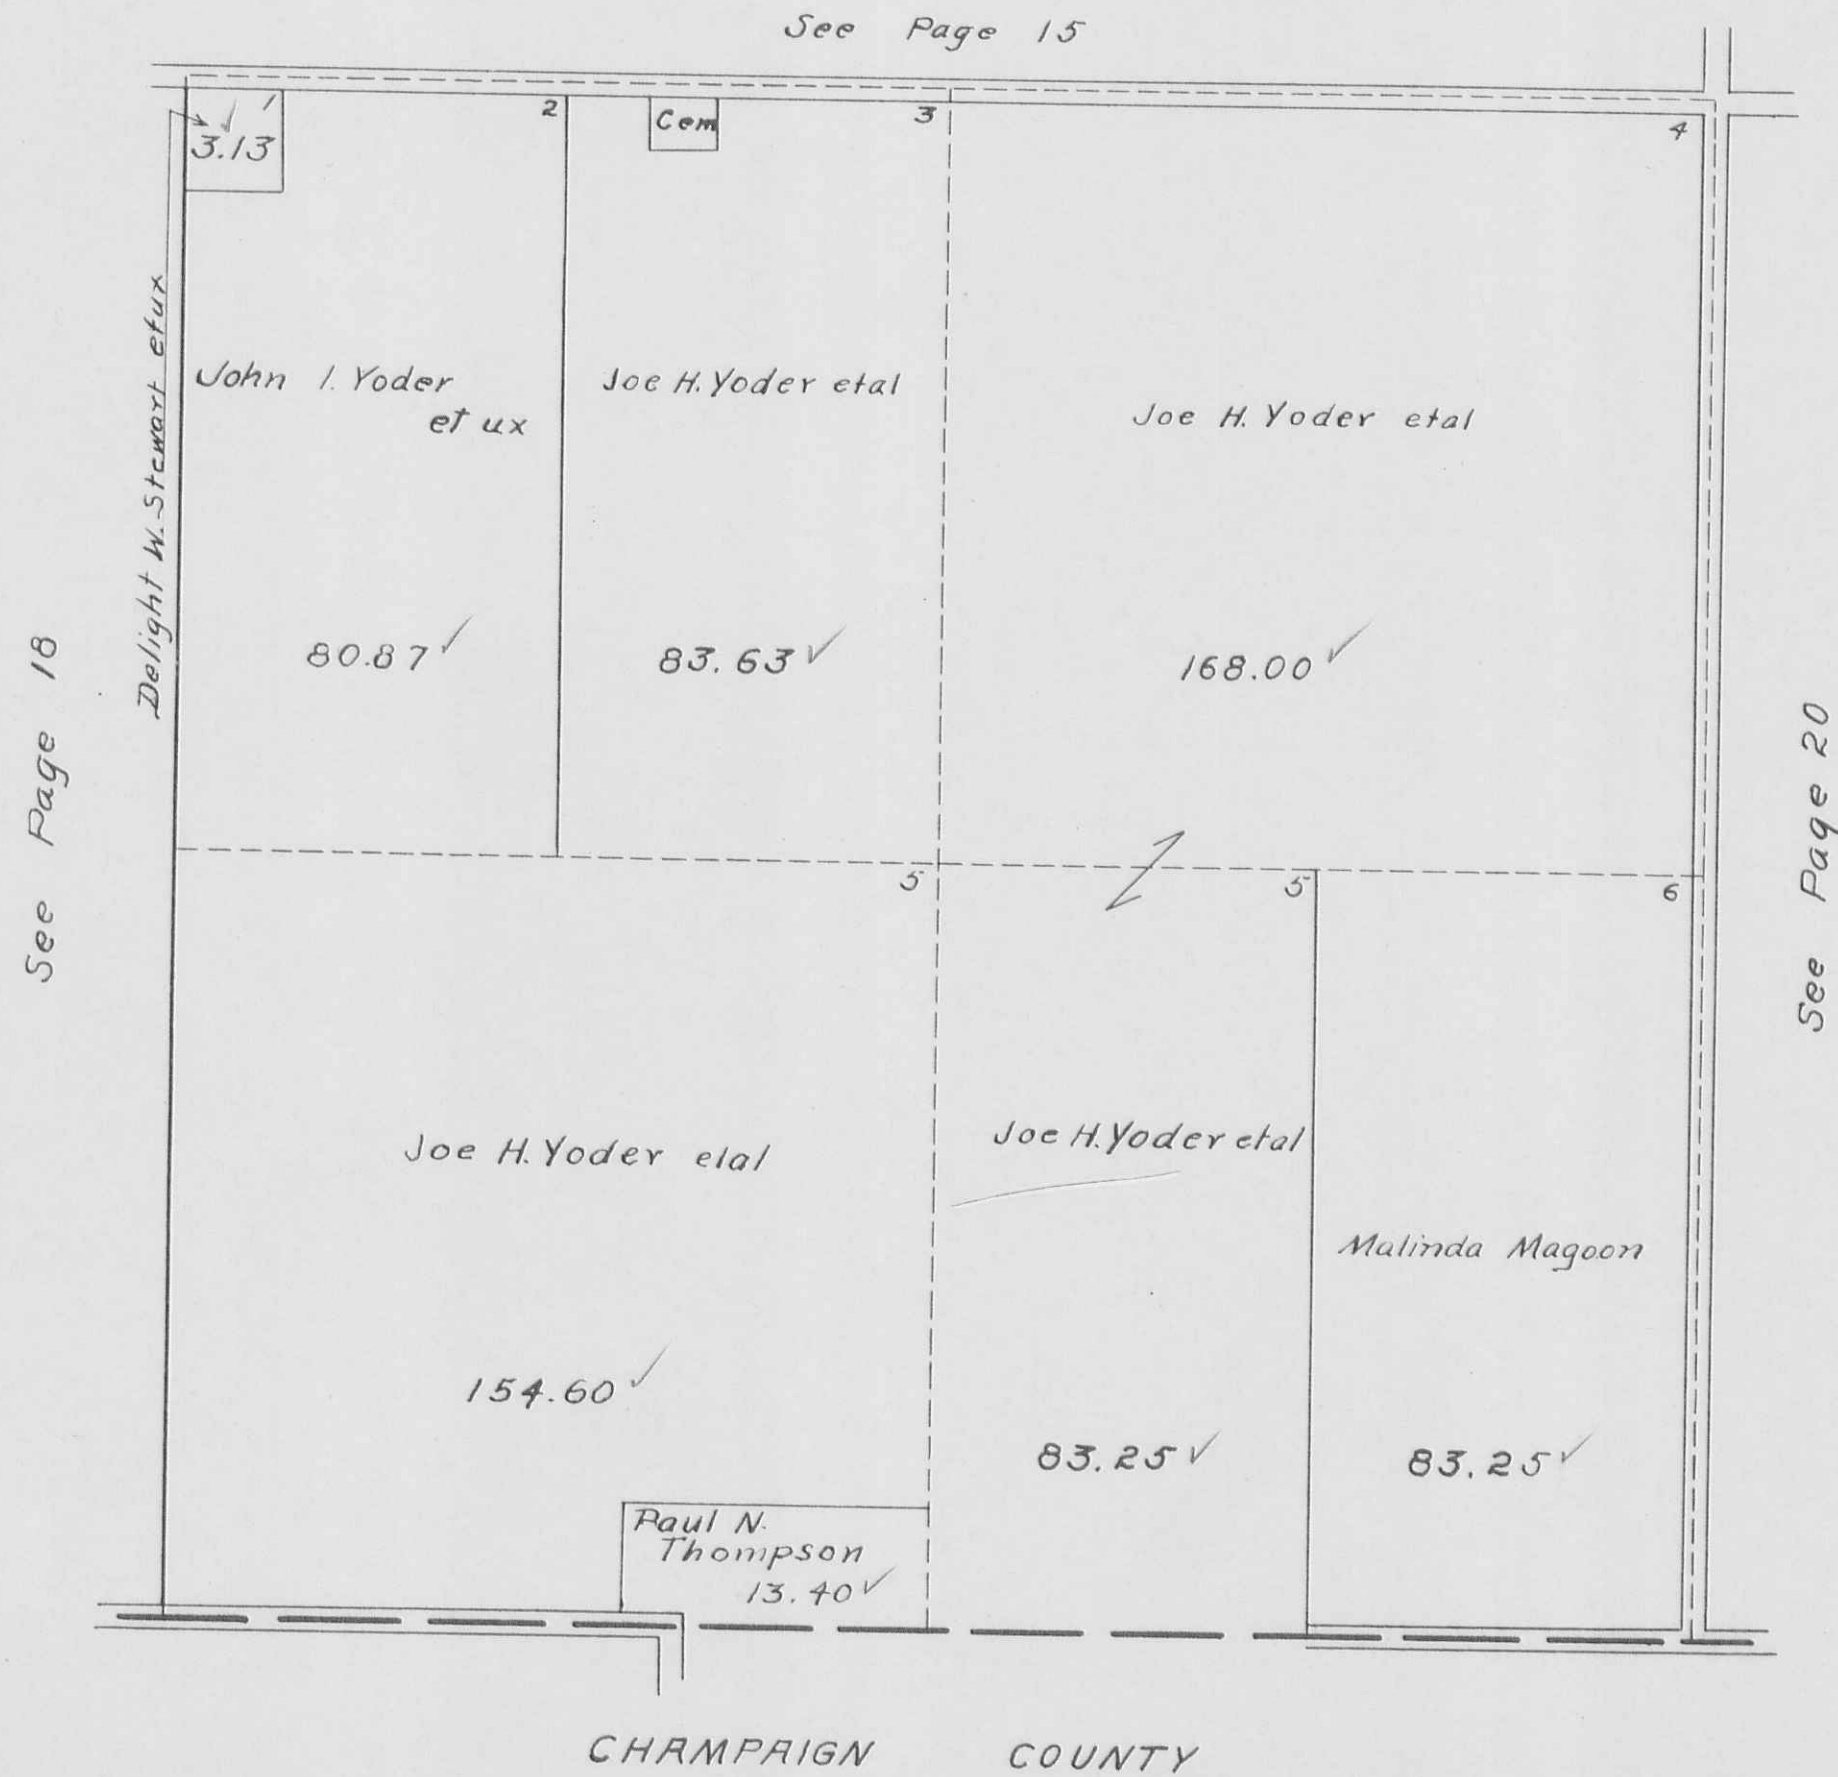


SECTION 10 TOWN 4 RANGE 13

SECTION 4 TOWN 4 RANGE 13

SCALE 10 CHAINS TO THE INCH

See Page 16

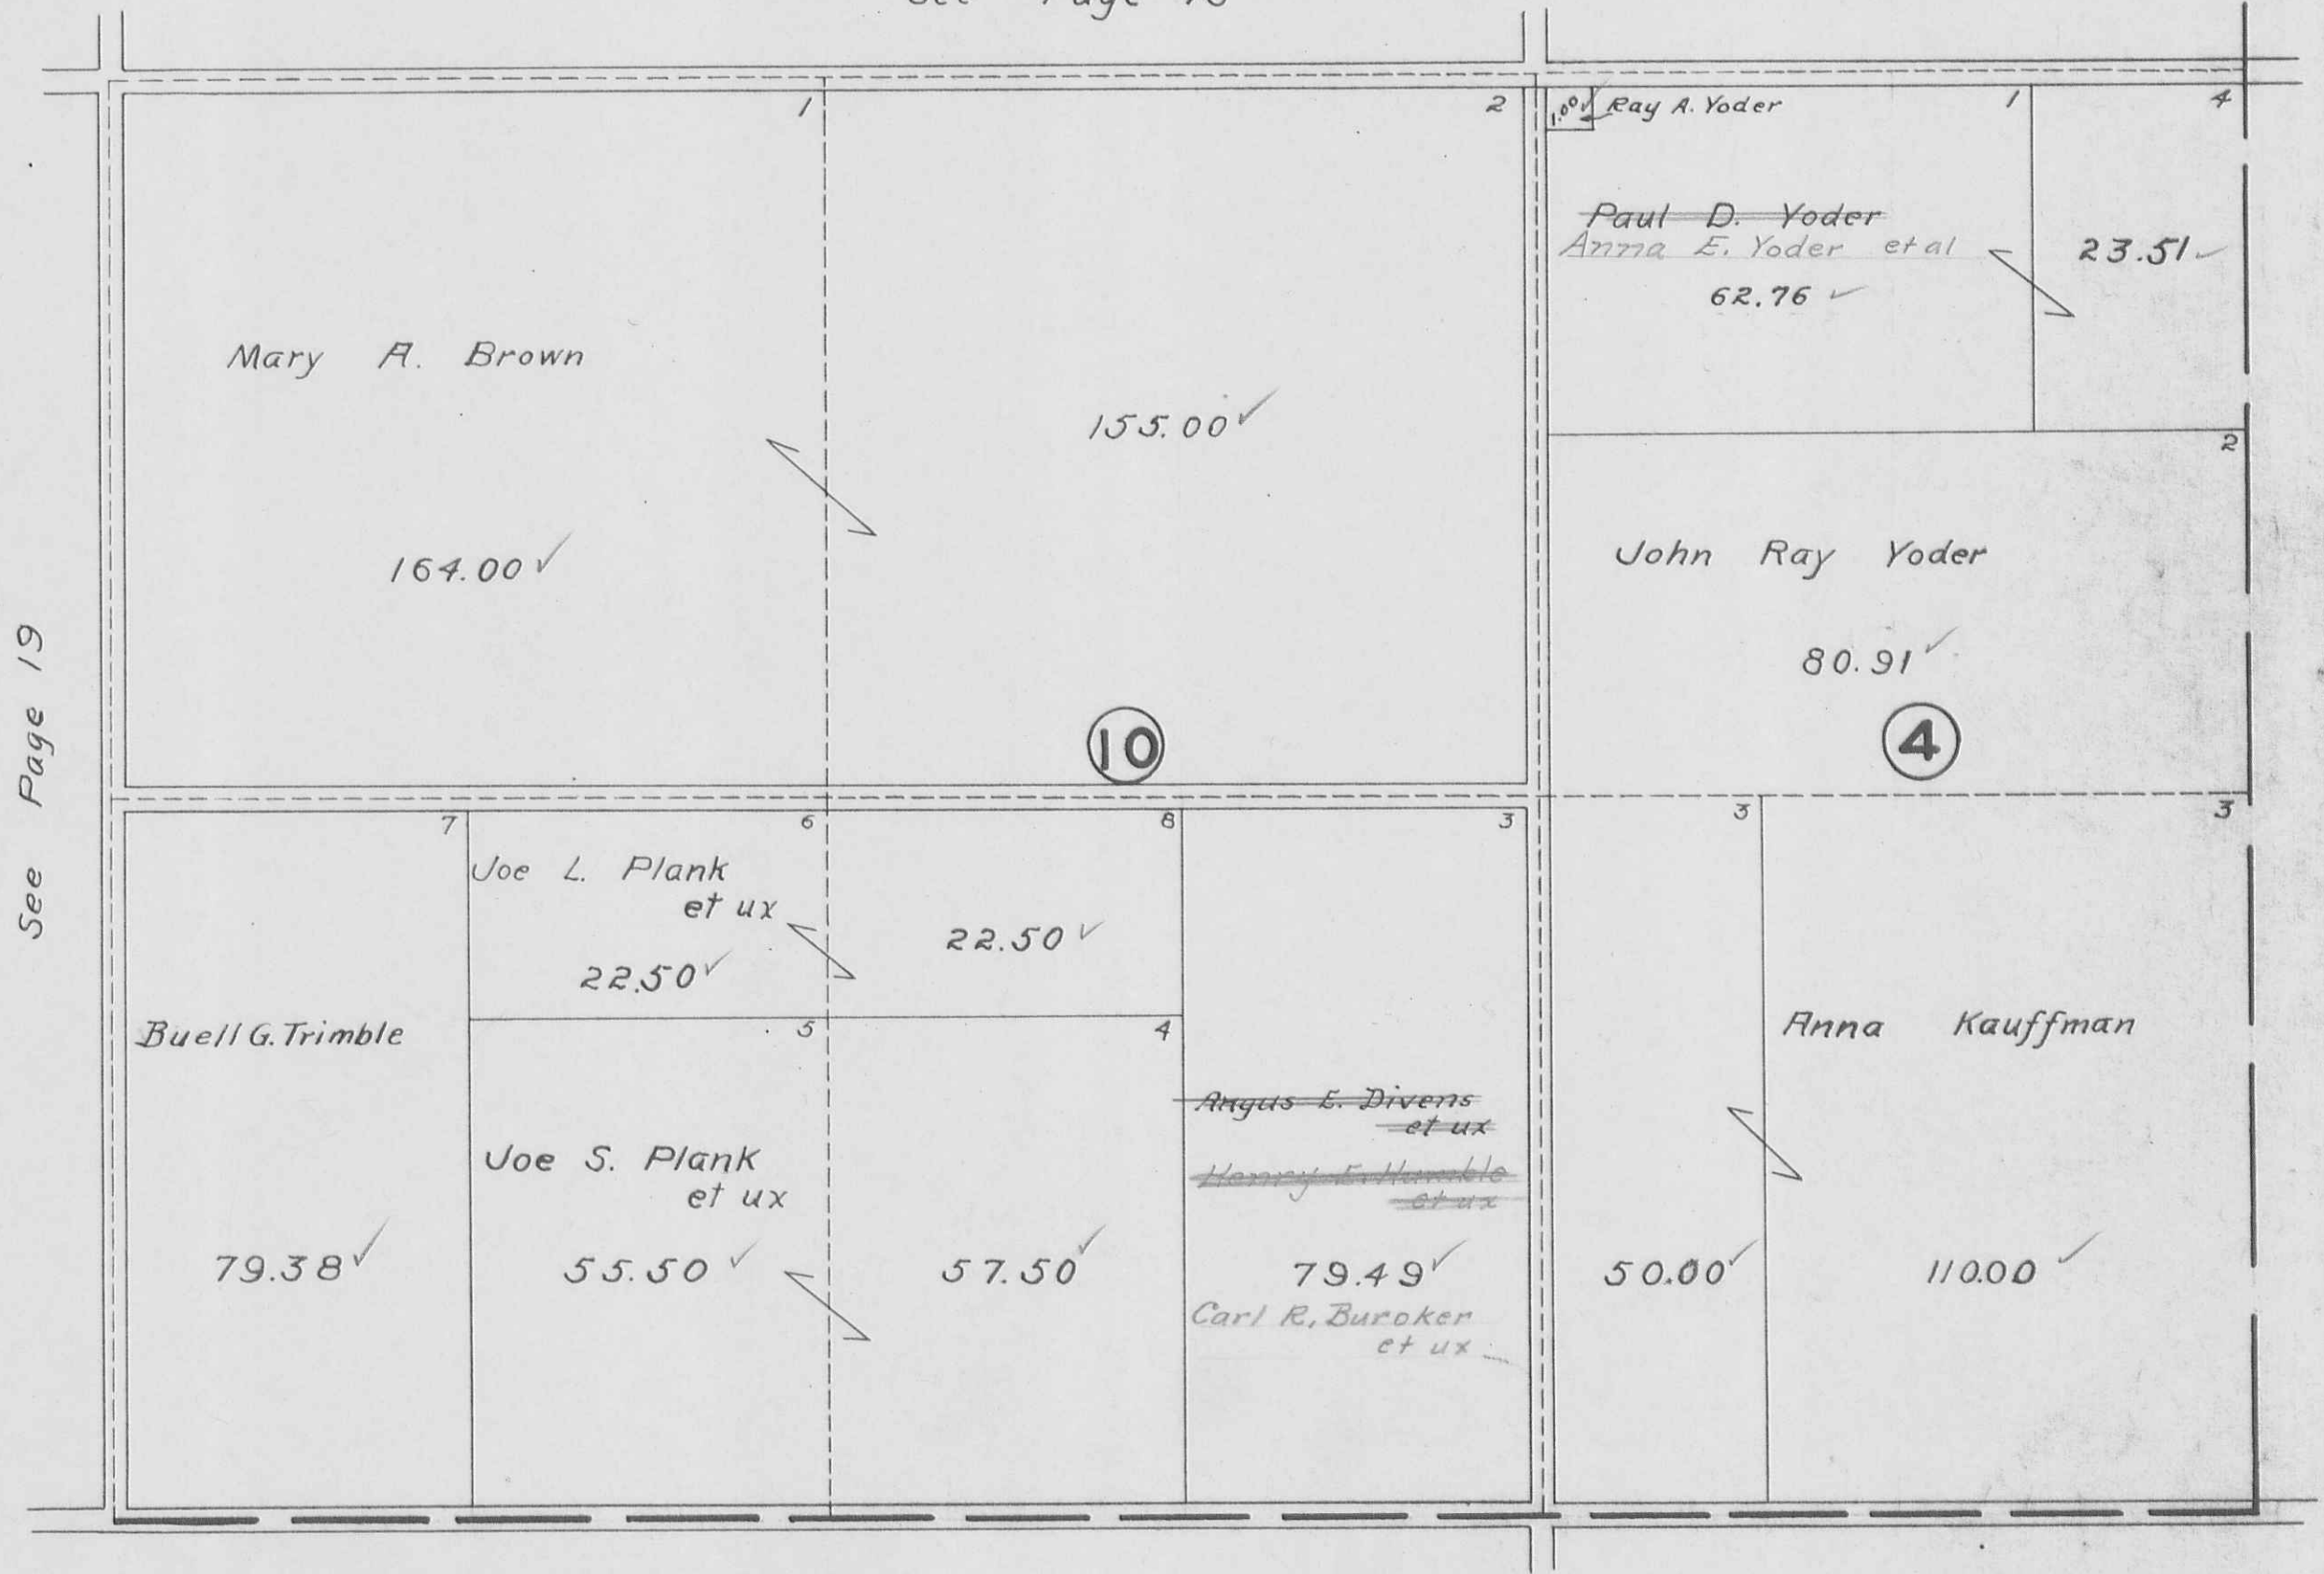

See Page 19

CHAMPAIGN COUNTY