

1954
Plat Book

ZANE
TOWNSHIP
1951

ZANE TOWNSHIP
VIRGINIA MILITARY SURVEYS
INDEX

CORRECTED TO Jan. 1, 1955
Jan. 1-1956
Jan. 1-1957
Jan. 1-1958



R.F.W.

Z ANE TOWNSHIP
 VIRGINIA MILITARY SURVEYS
 INDEX


SURVEY NUMBER	PAGE
479.....	21
545.....	11
1502.....	23
3154.....	6
3155.....	10-24-25-26
3159.....	3
3160.....	17
3161.....	3
3163.....	22
3230.....	13
3231.....	13
3680.....	8-9
3681.....	22
3688.....	20
3753.....	5
4570.....	4-7
4606.....	17
4658 }.....	23
4678 }	
4666.....	20
4676.....	3
4697.....	19
4759.....	23
4811.....	11
4859.....	20
4880.....	22
4933.....	18
4953.....	16

SURVEY NUMBER	PAGE
5049.....	19
7117.....	14-15
9657 }.....	14-15
9740 }	
9679.....	14-15
12256.....	17
12395 }.....	12
12399 }	
12402 }	
12427 }	
12428 }	

ZANE TOWNSHIP
 VIRGINIA MILITARY SURVEYS


3159
 3161
 4570
 4676

SCALE 10 CHAINS TO THE INCH

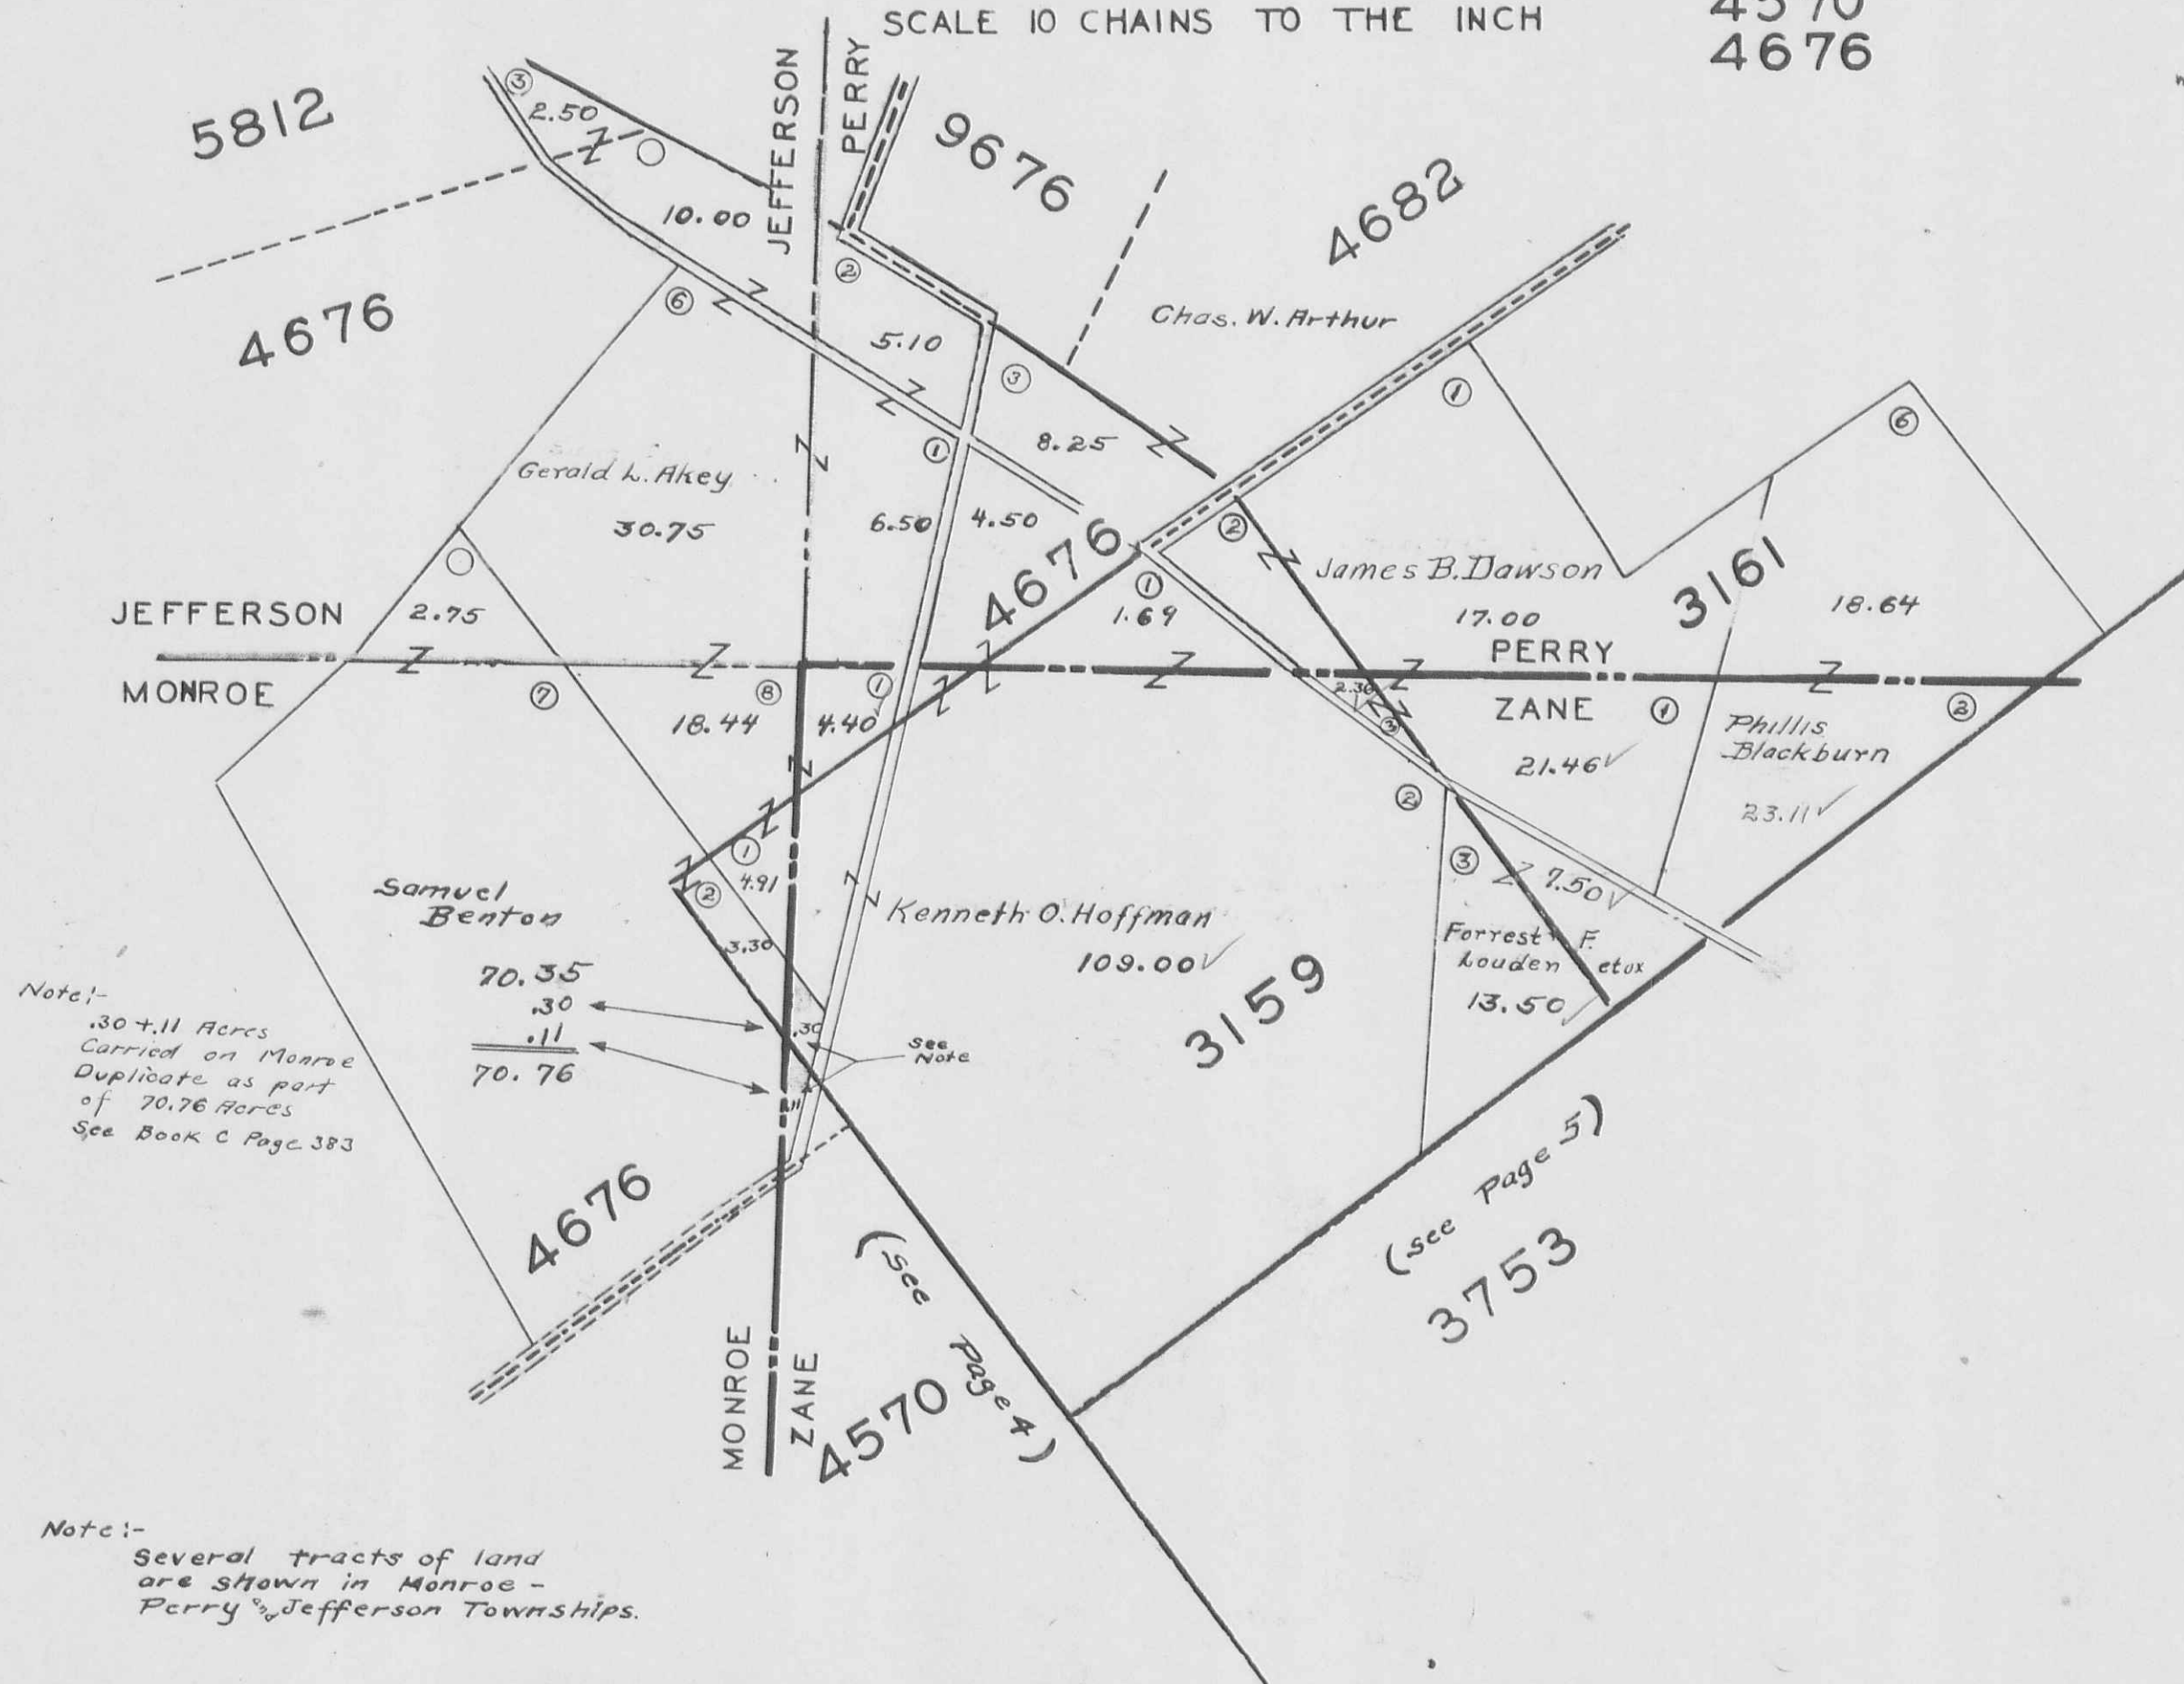

ZANE TOWNSHIP
 VIRGINIA MILITARY SURVEY 4570



SCALE 10 CHAINS TO THE INCH

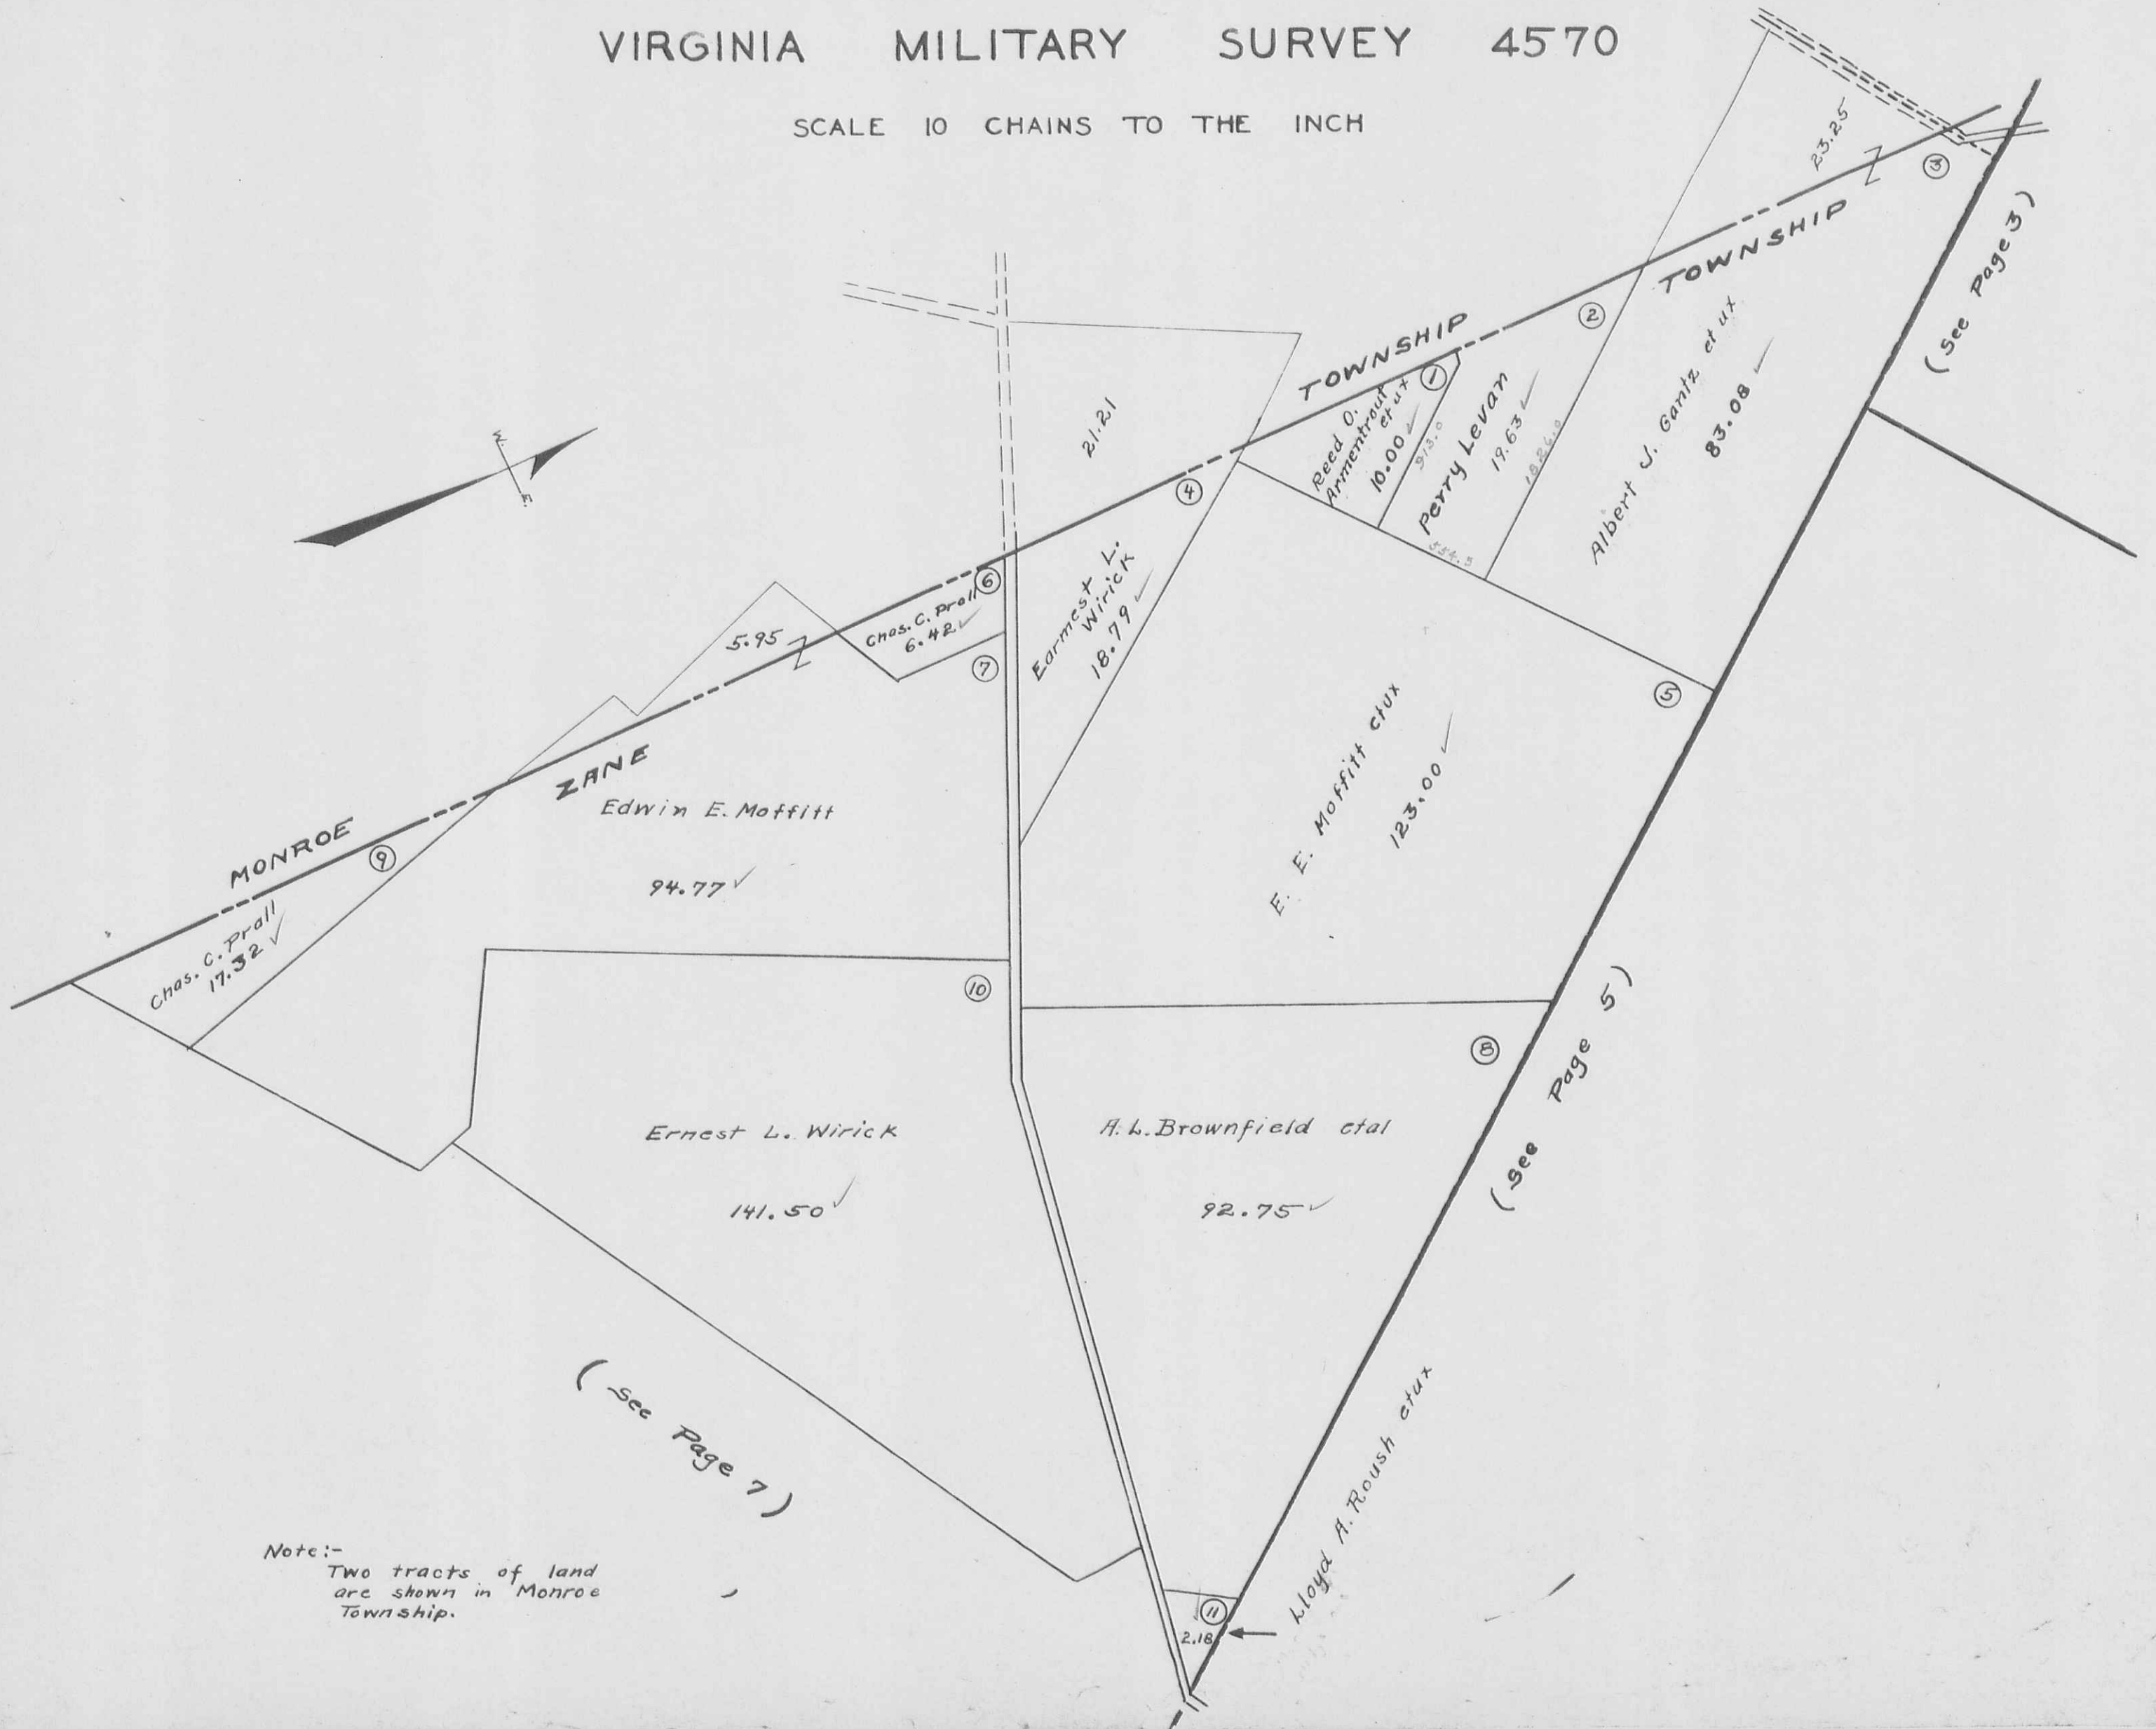

Note:-
 Two tracts of land
 are shown in Monroe
 Township.

ZANE TOWNSHIP
VIRGINIA MILITARY SURVEY 3753

SCALE 10 CHAINS TO THE INCH
(See Page 3)

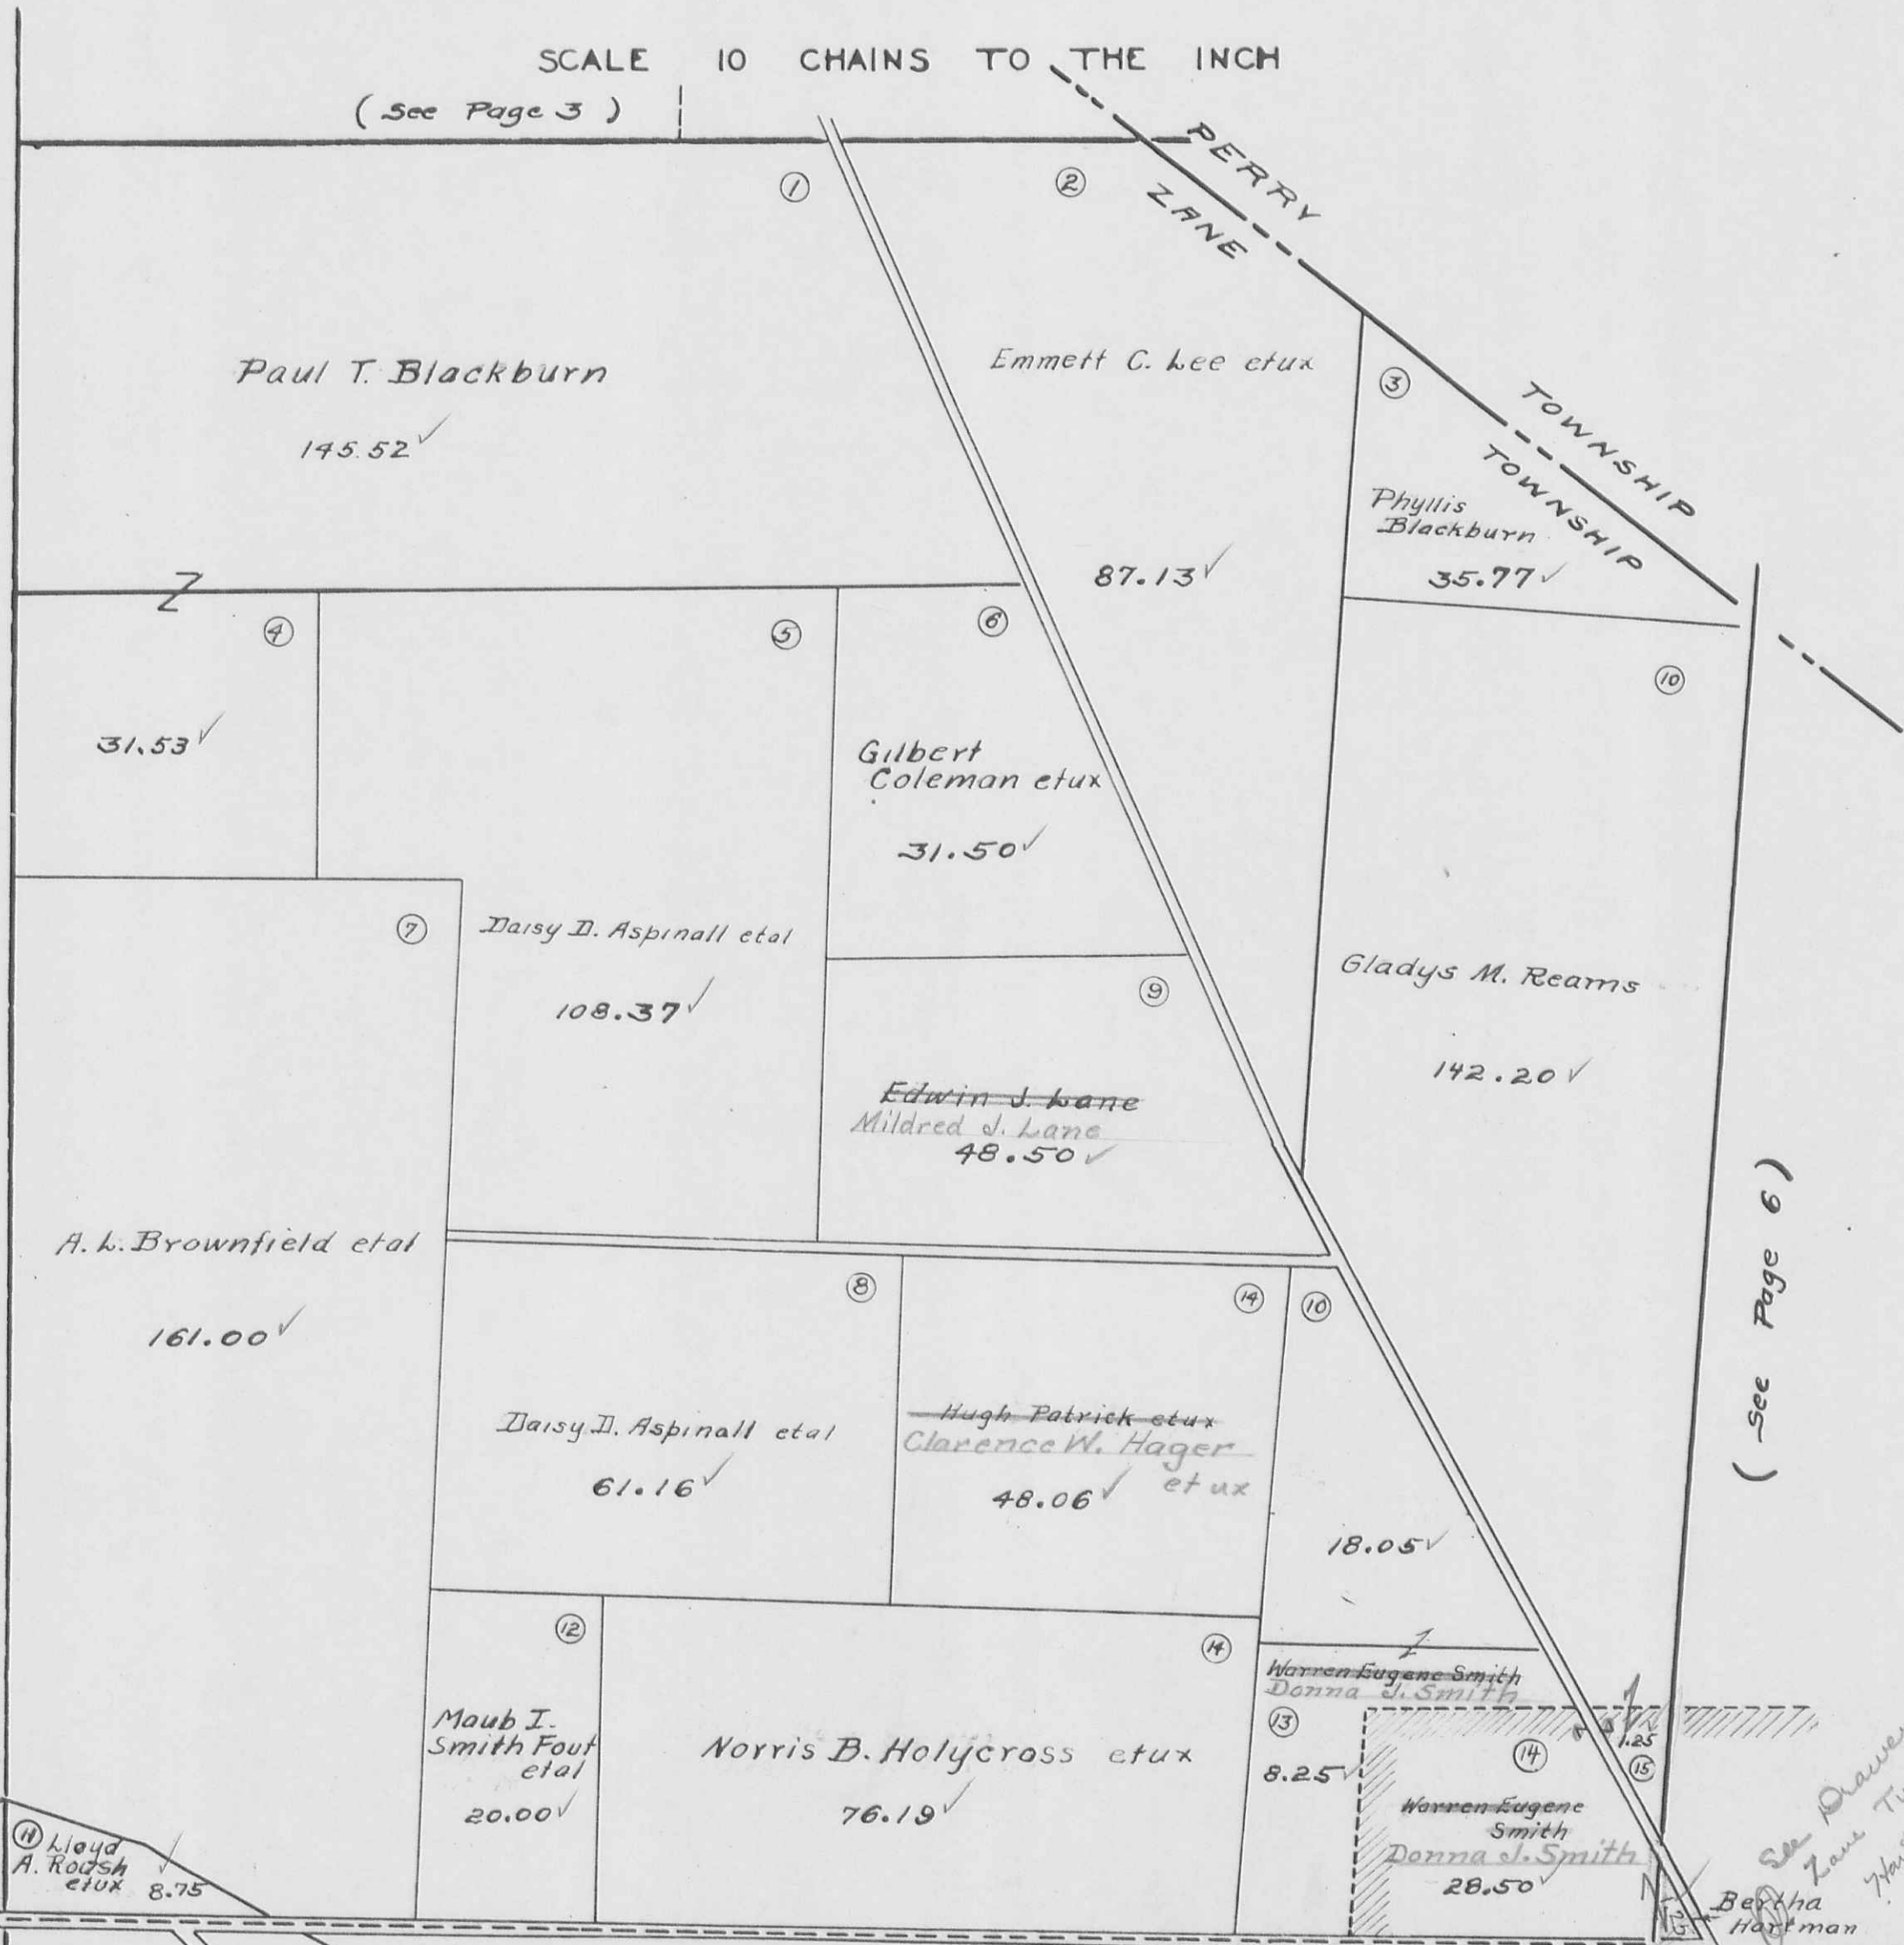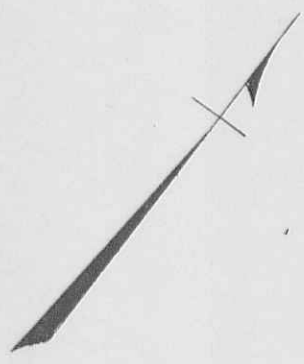

(See Page 4)

(See Page 6)


(See Page 8)

See Drawer R.
Zane Twp.
Hartman does not
own this

MIDDLEBURG


ZANE TOWNSHIP
VIRGINIA MILITARY SURVEY 3154

SCALE 10 CHAINS TO THE INCH

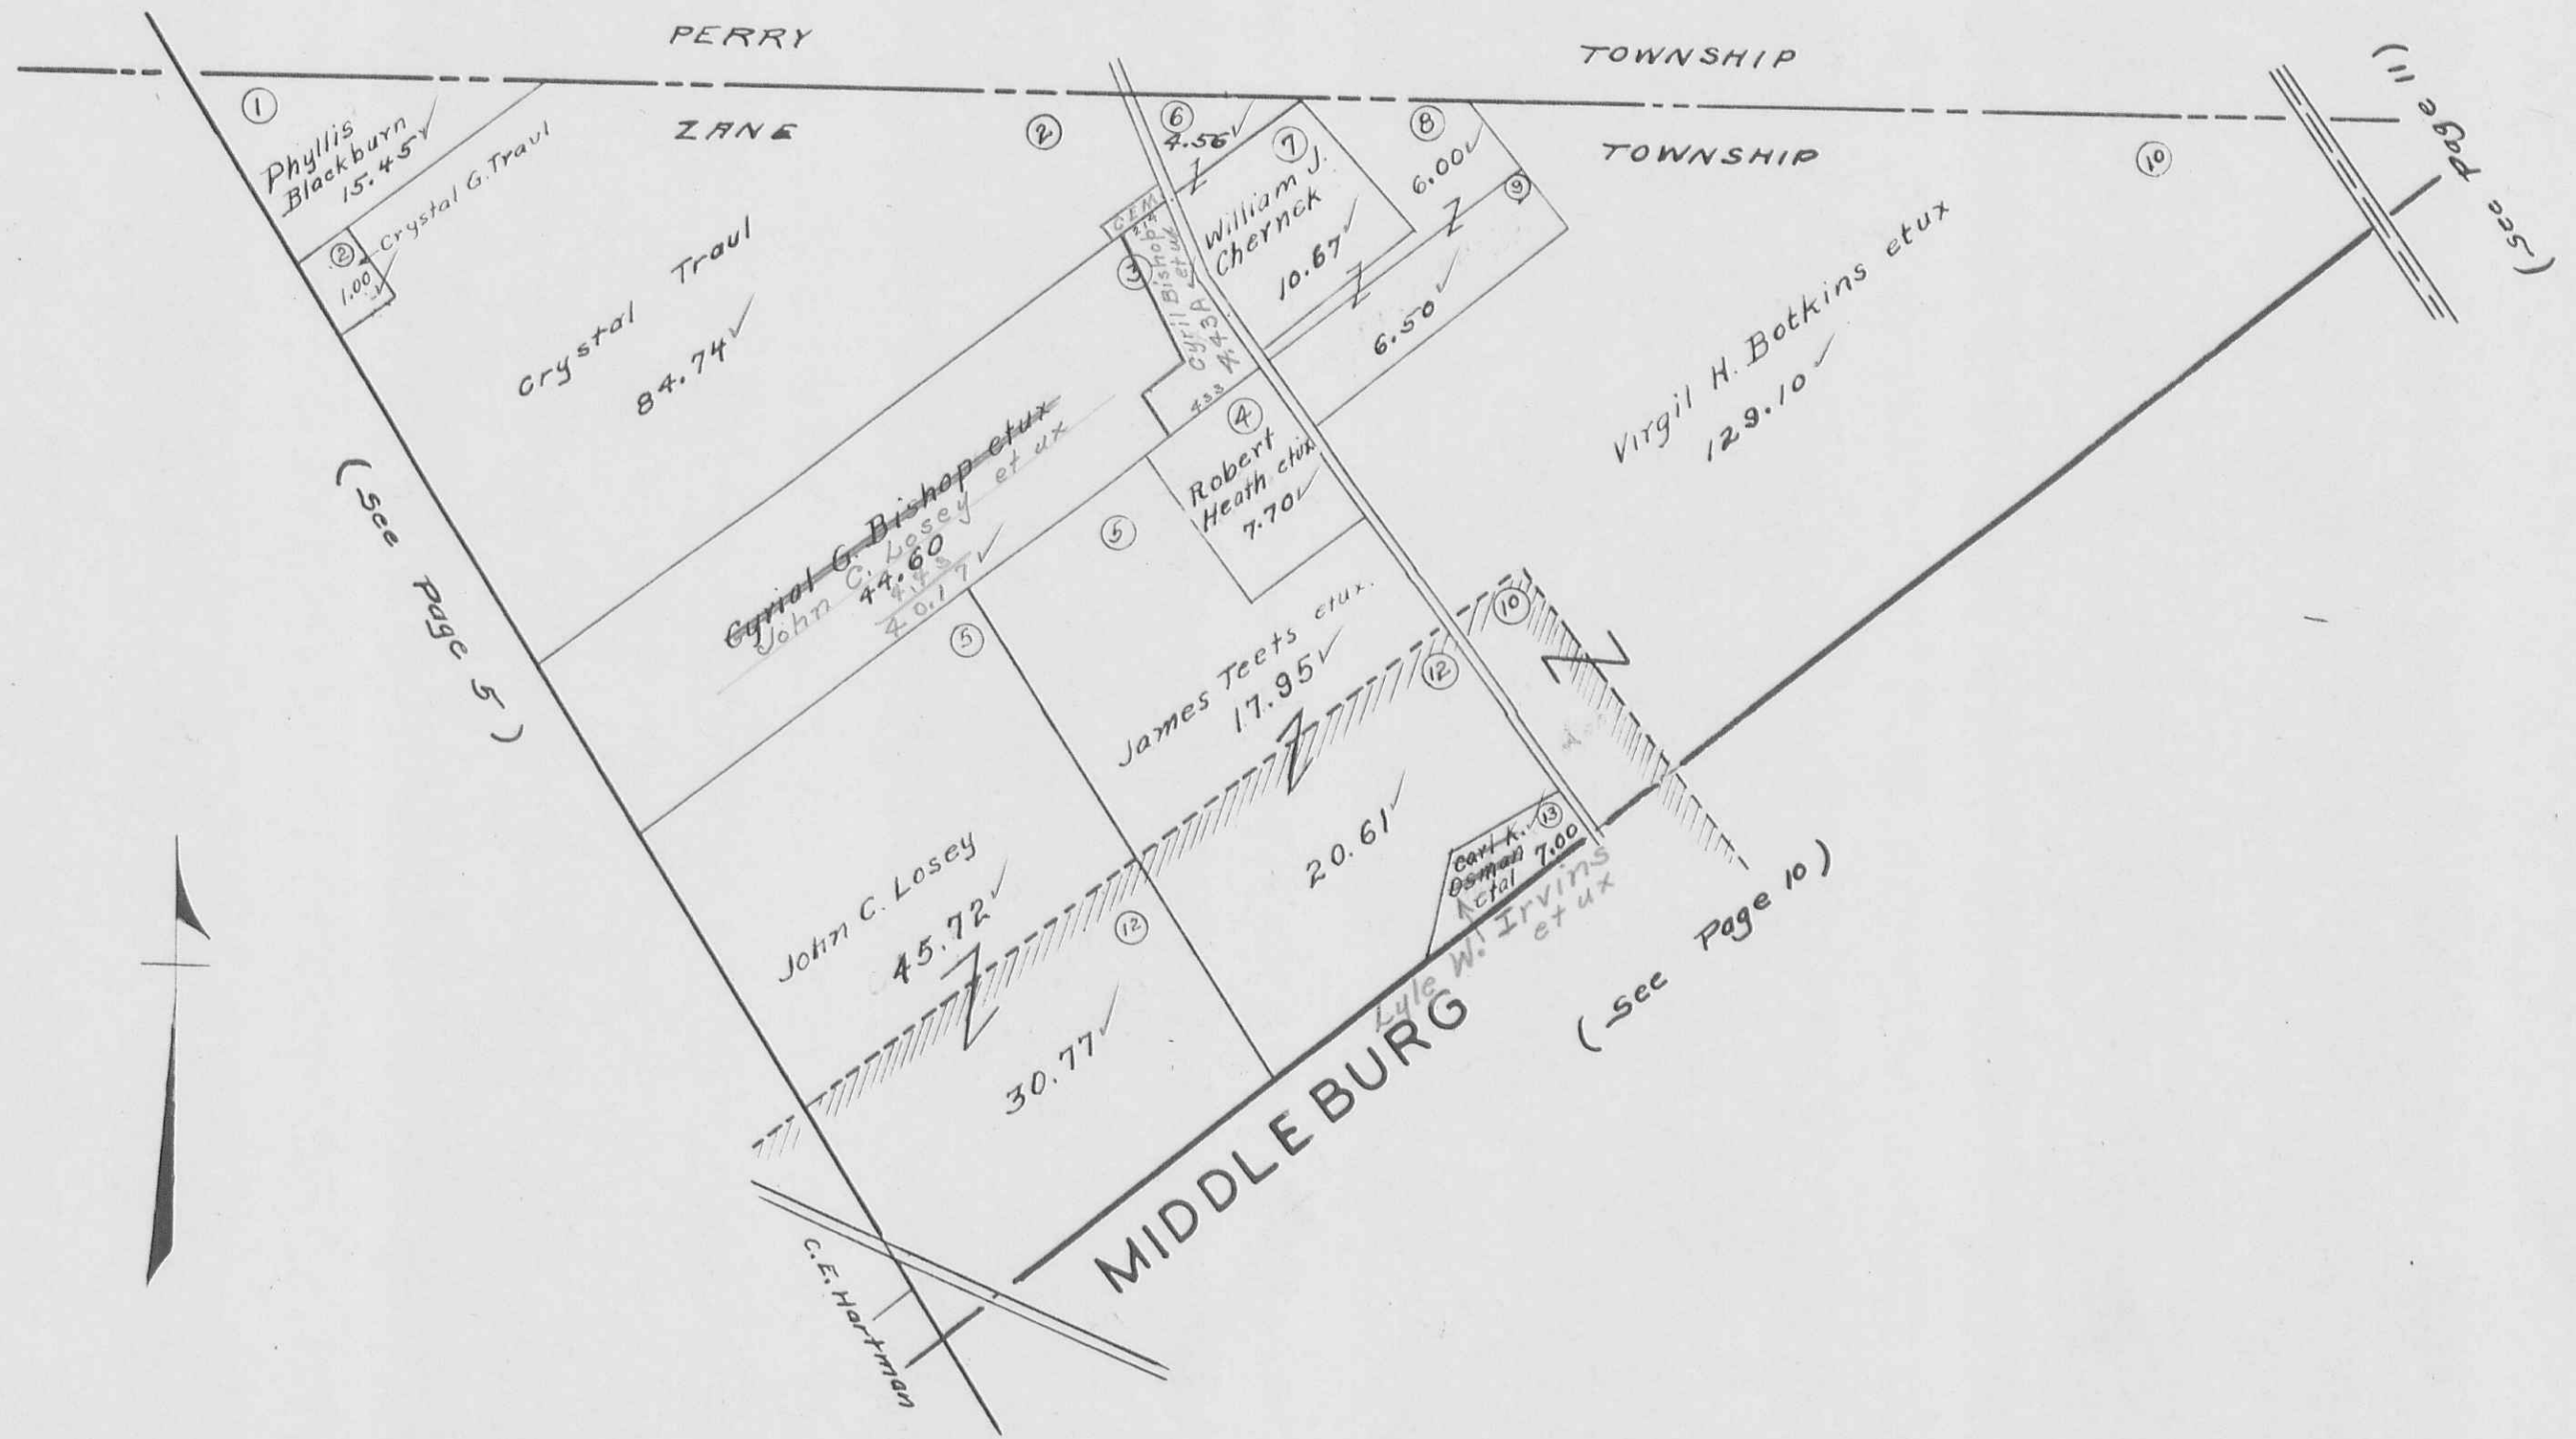

ZANE TOWNSHIP
VIRGINIA MILITARY SURVEY 4570



SCALE 10 CHAINS TO THE INCH

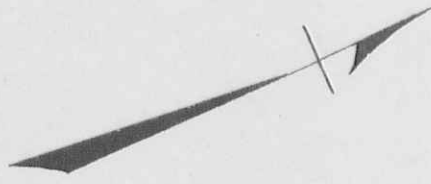

ZANE TOWNSHIP
VIRGINIA MILITARY SURVEY 3680

SCALE 10 CHAINS TO THE INCH

See Page 5

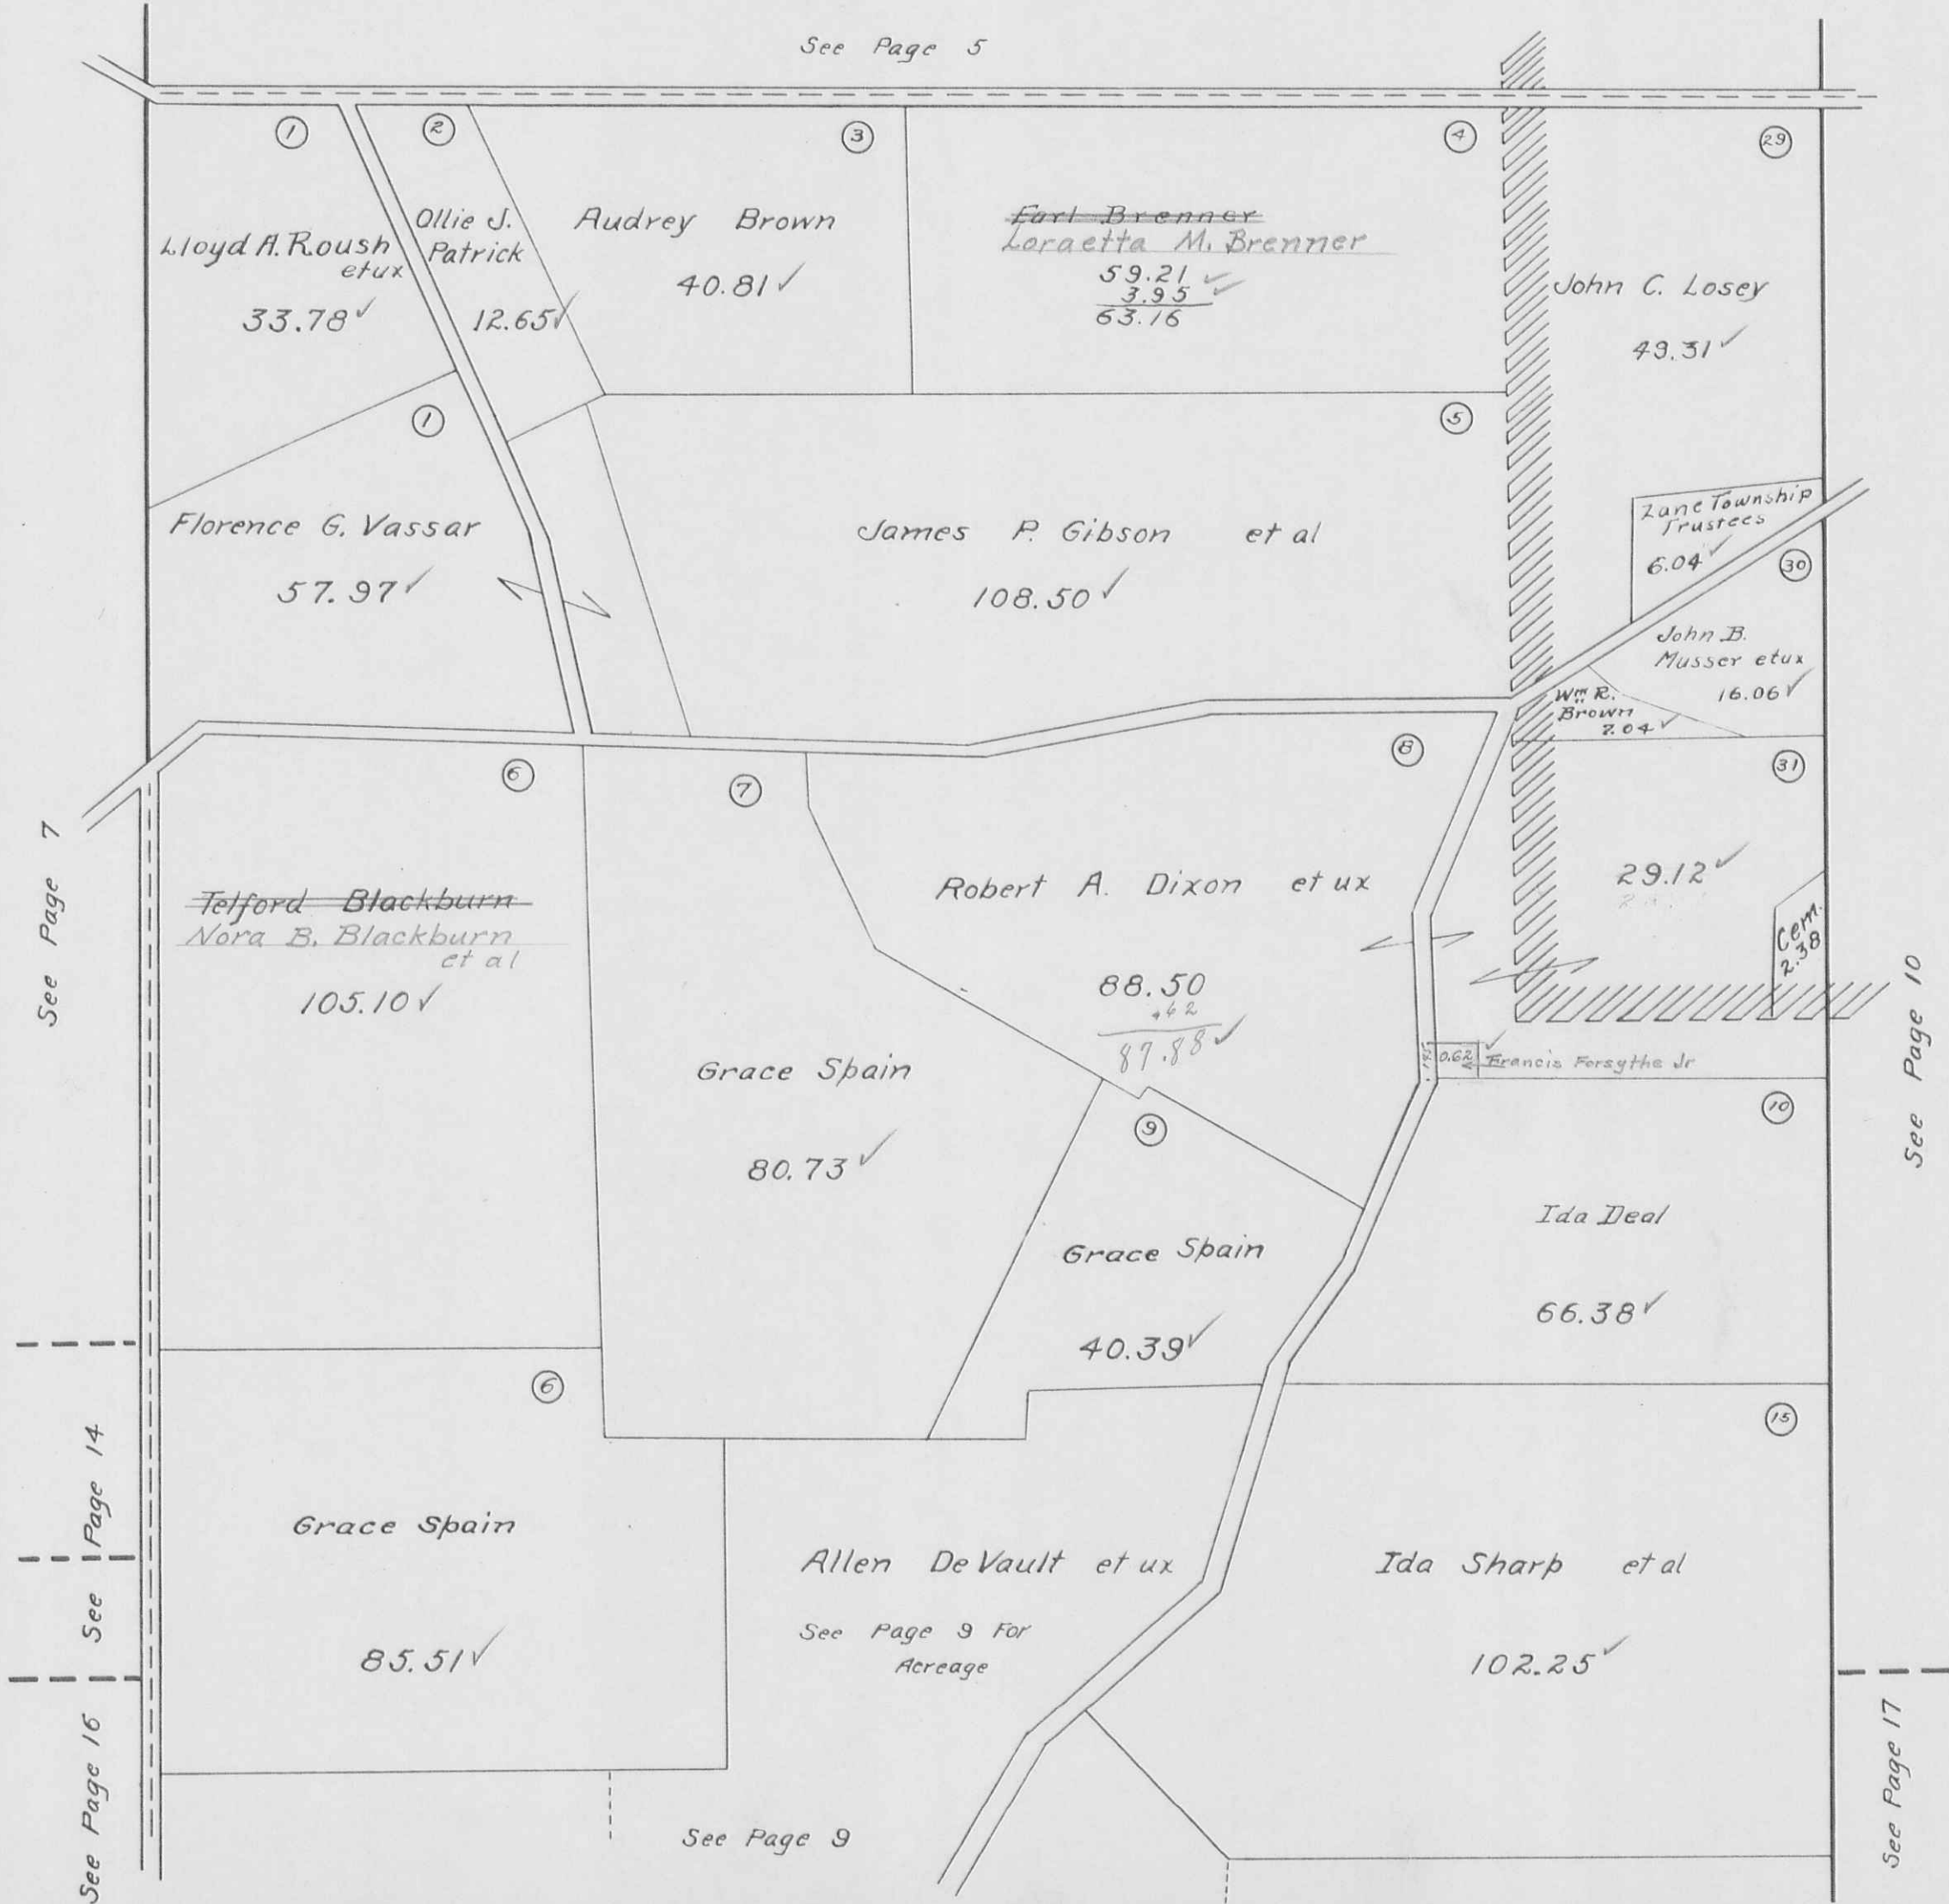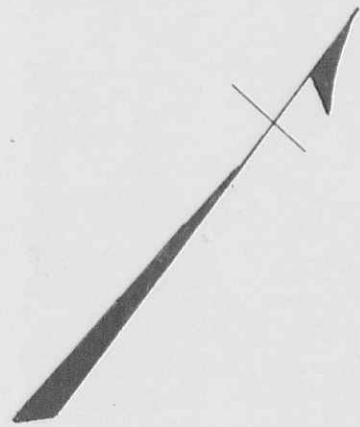

See Page 7

See Page 14

See

See Page 16

See Page 9



See Page 9 For Acreage

See Page 10

See Page 17

ZANE TOWNSHIP
 VIRGINIA MILITARY SURVEY 3680

SCALE 10 CHAINS TO THE INCH

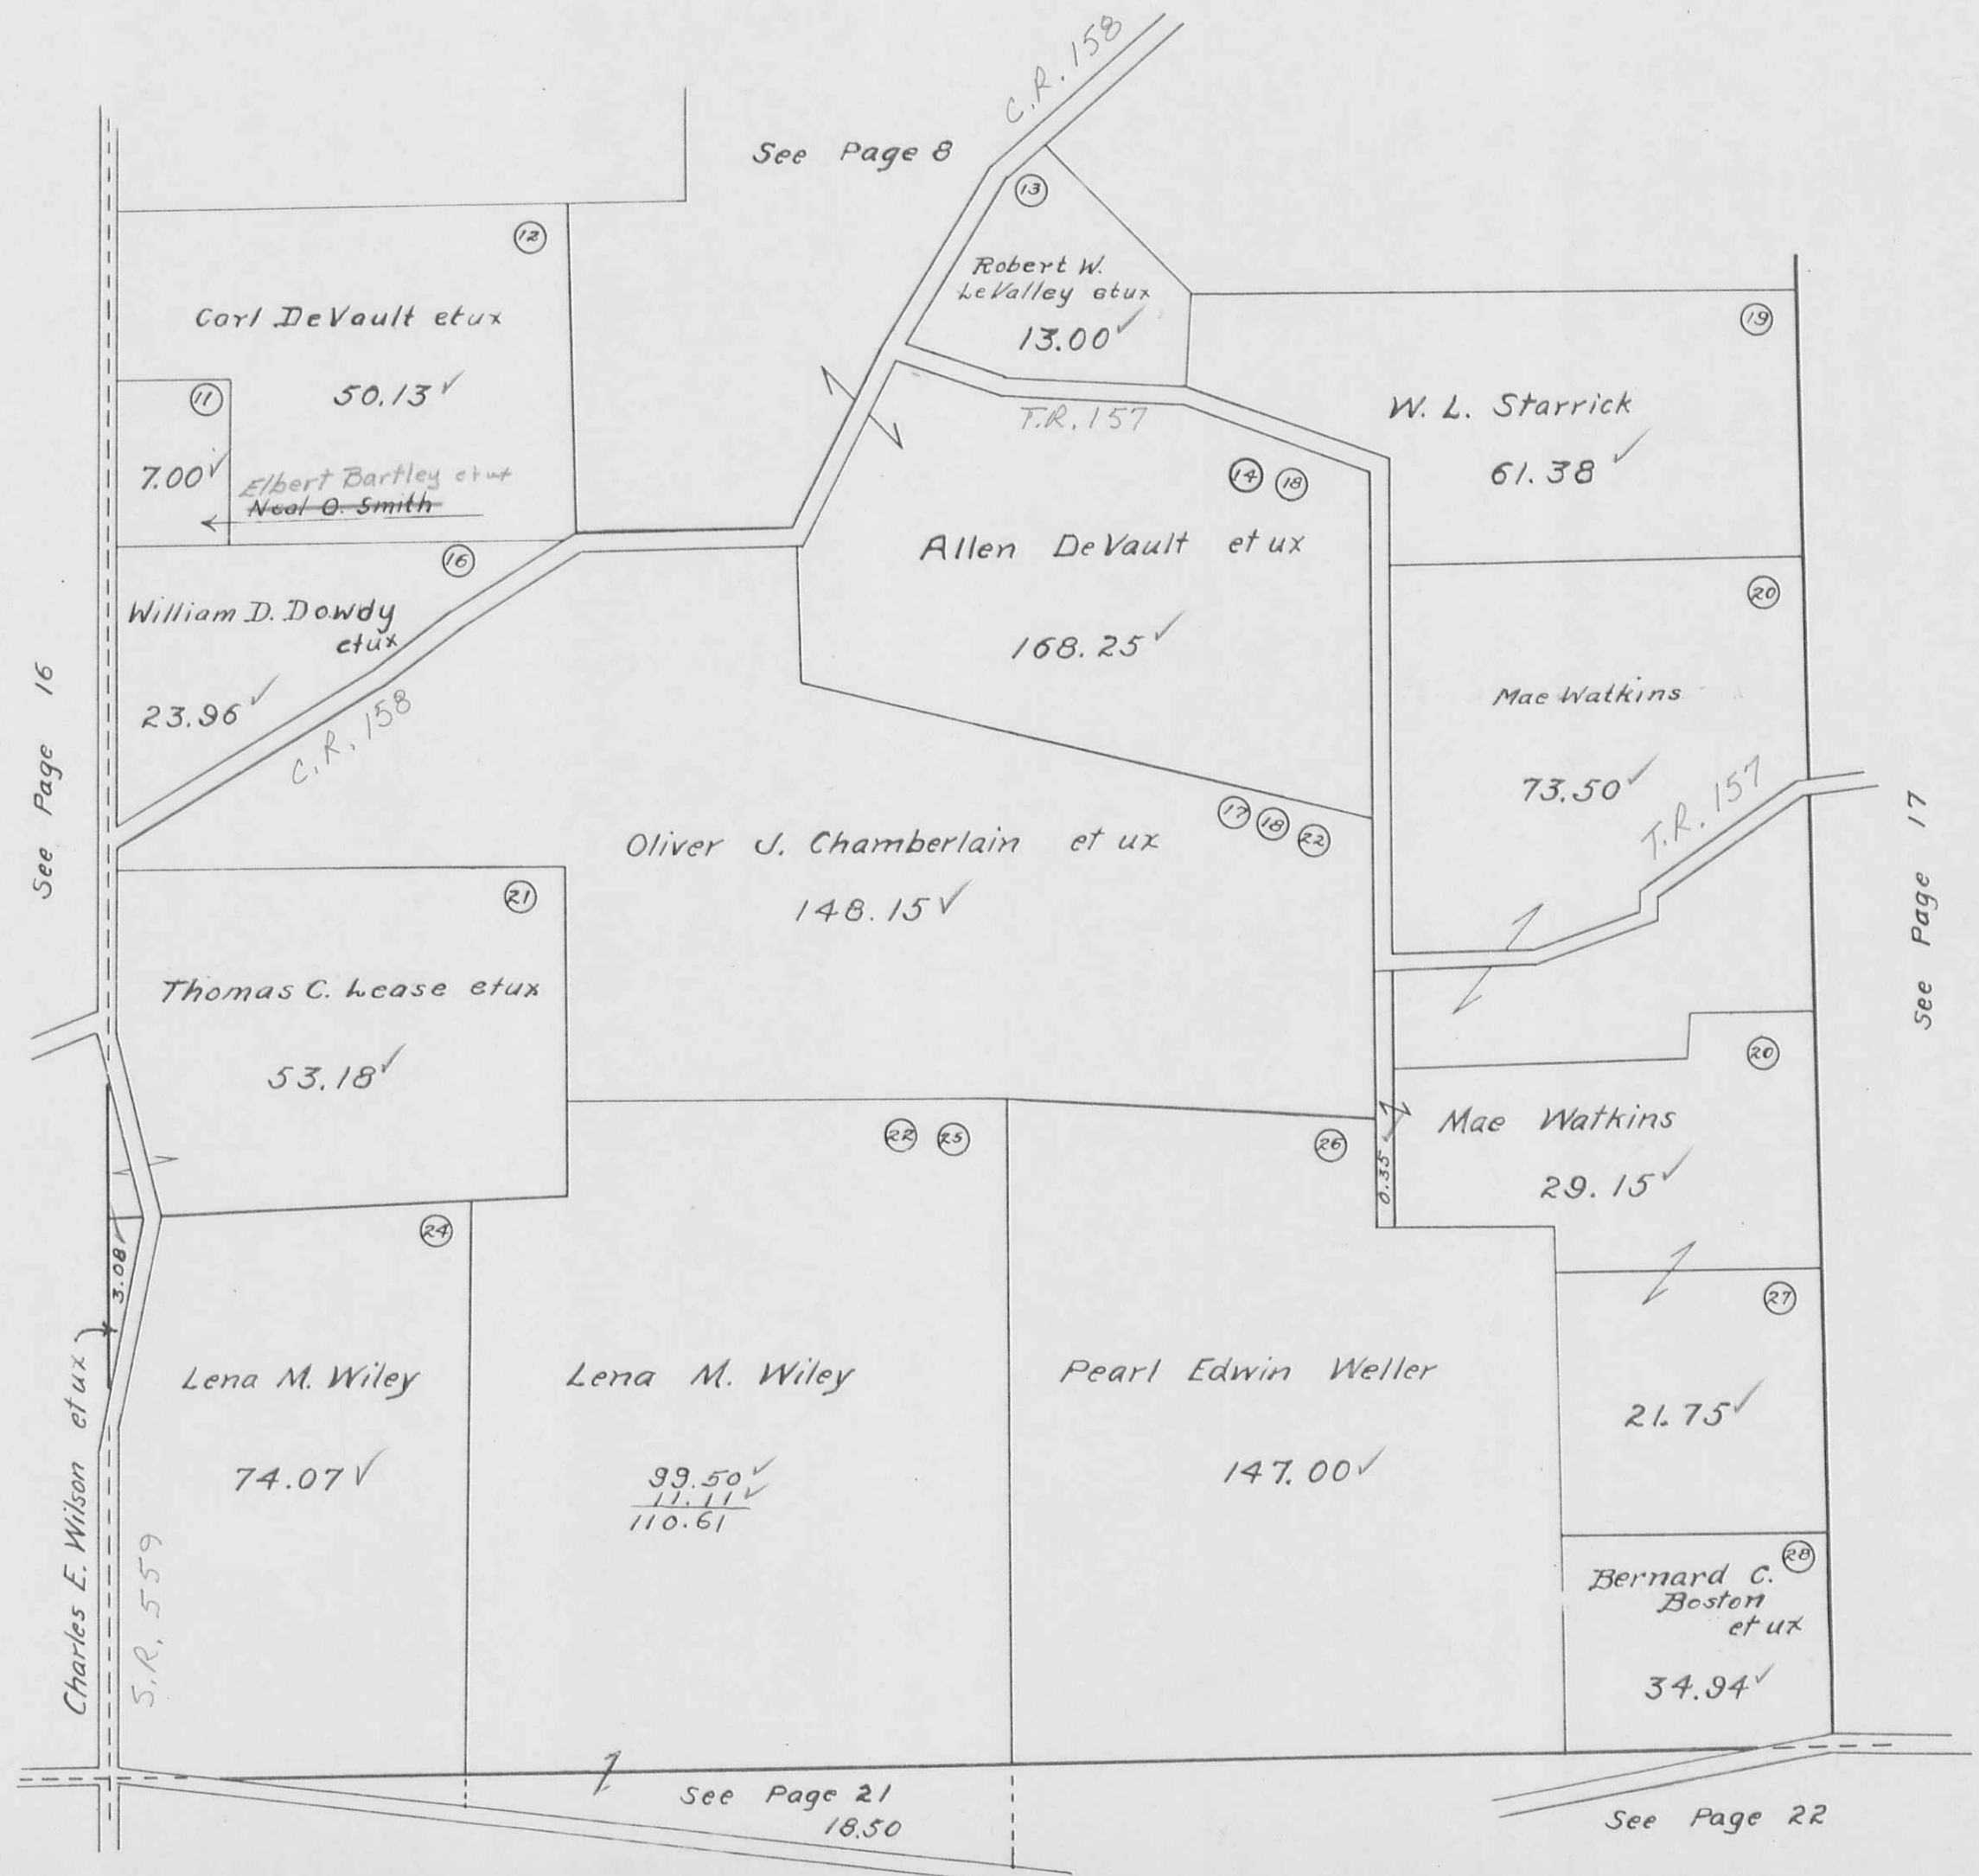
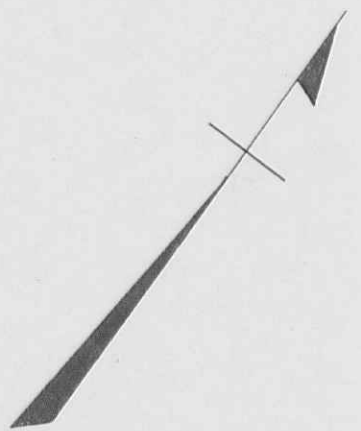


H.E.D.

ZANE TOWNSHIP
 VIRGINIA MILITARY SURVEY 3155

SCALE 10 CHAINS TO THE INCH

(See Page 6)

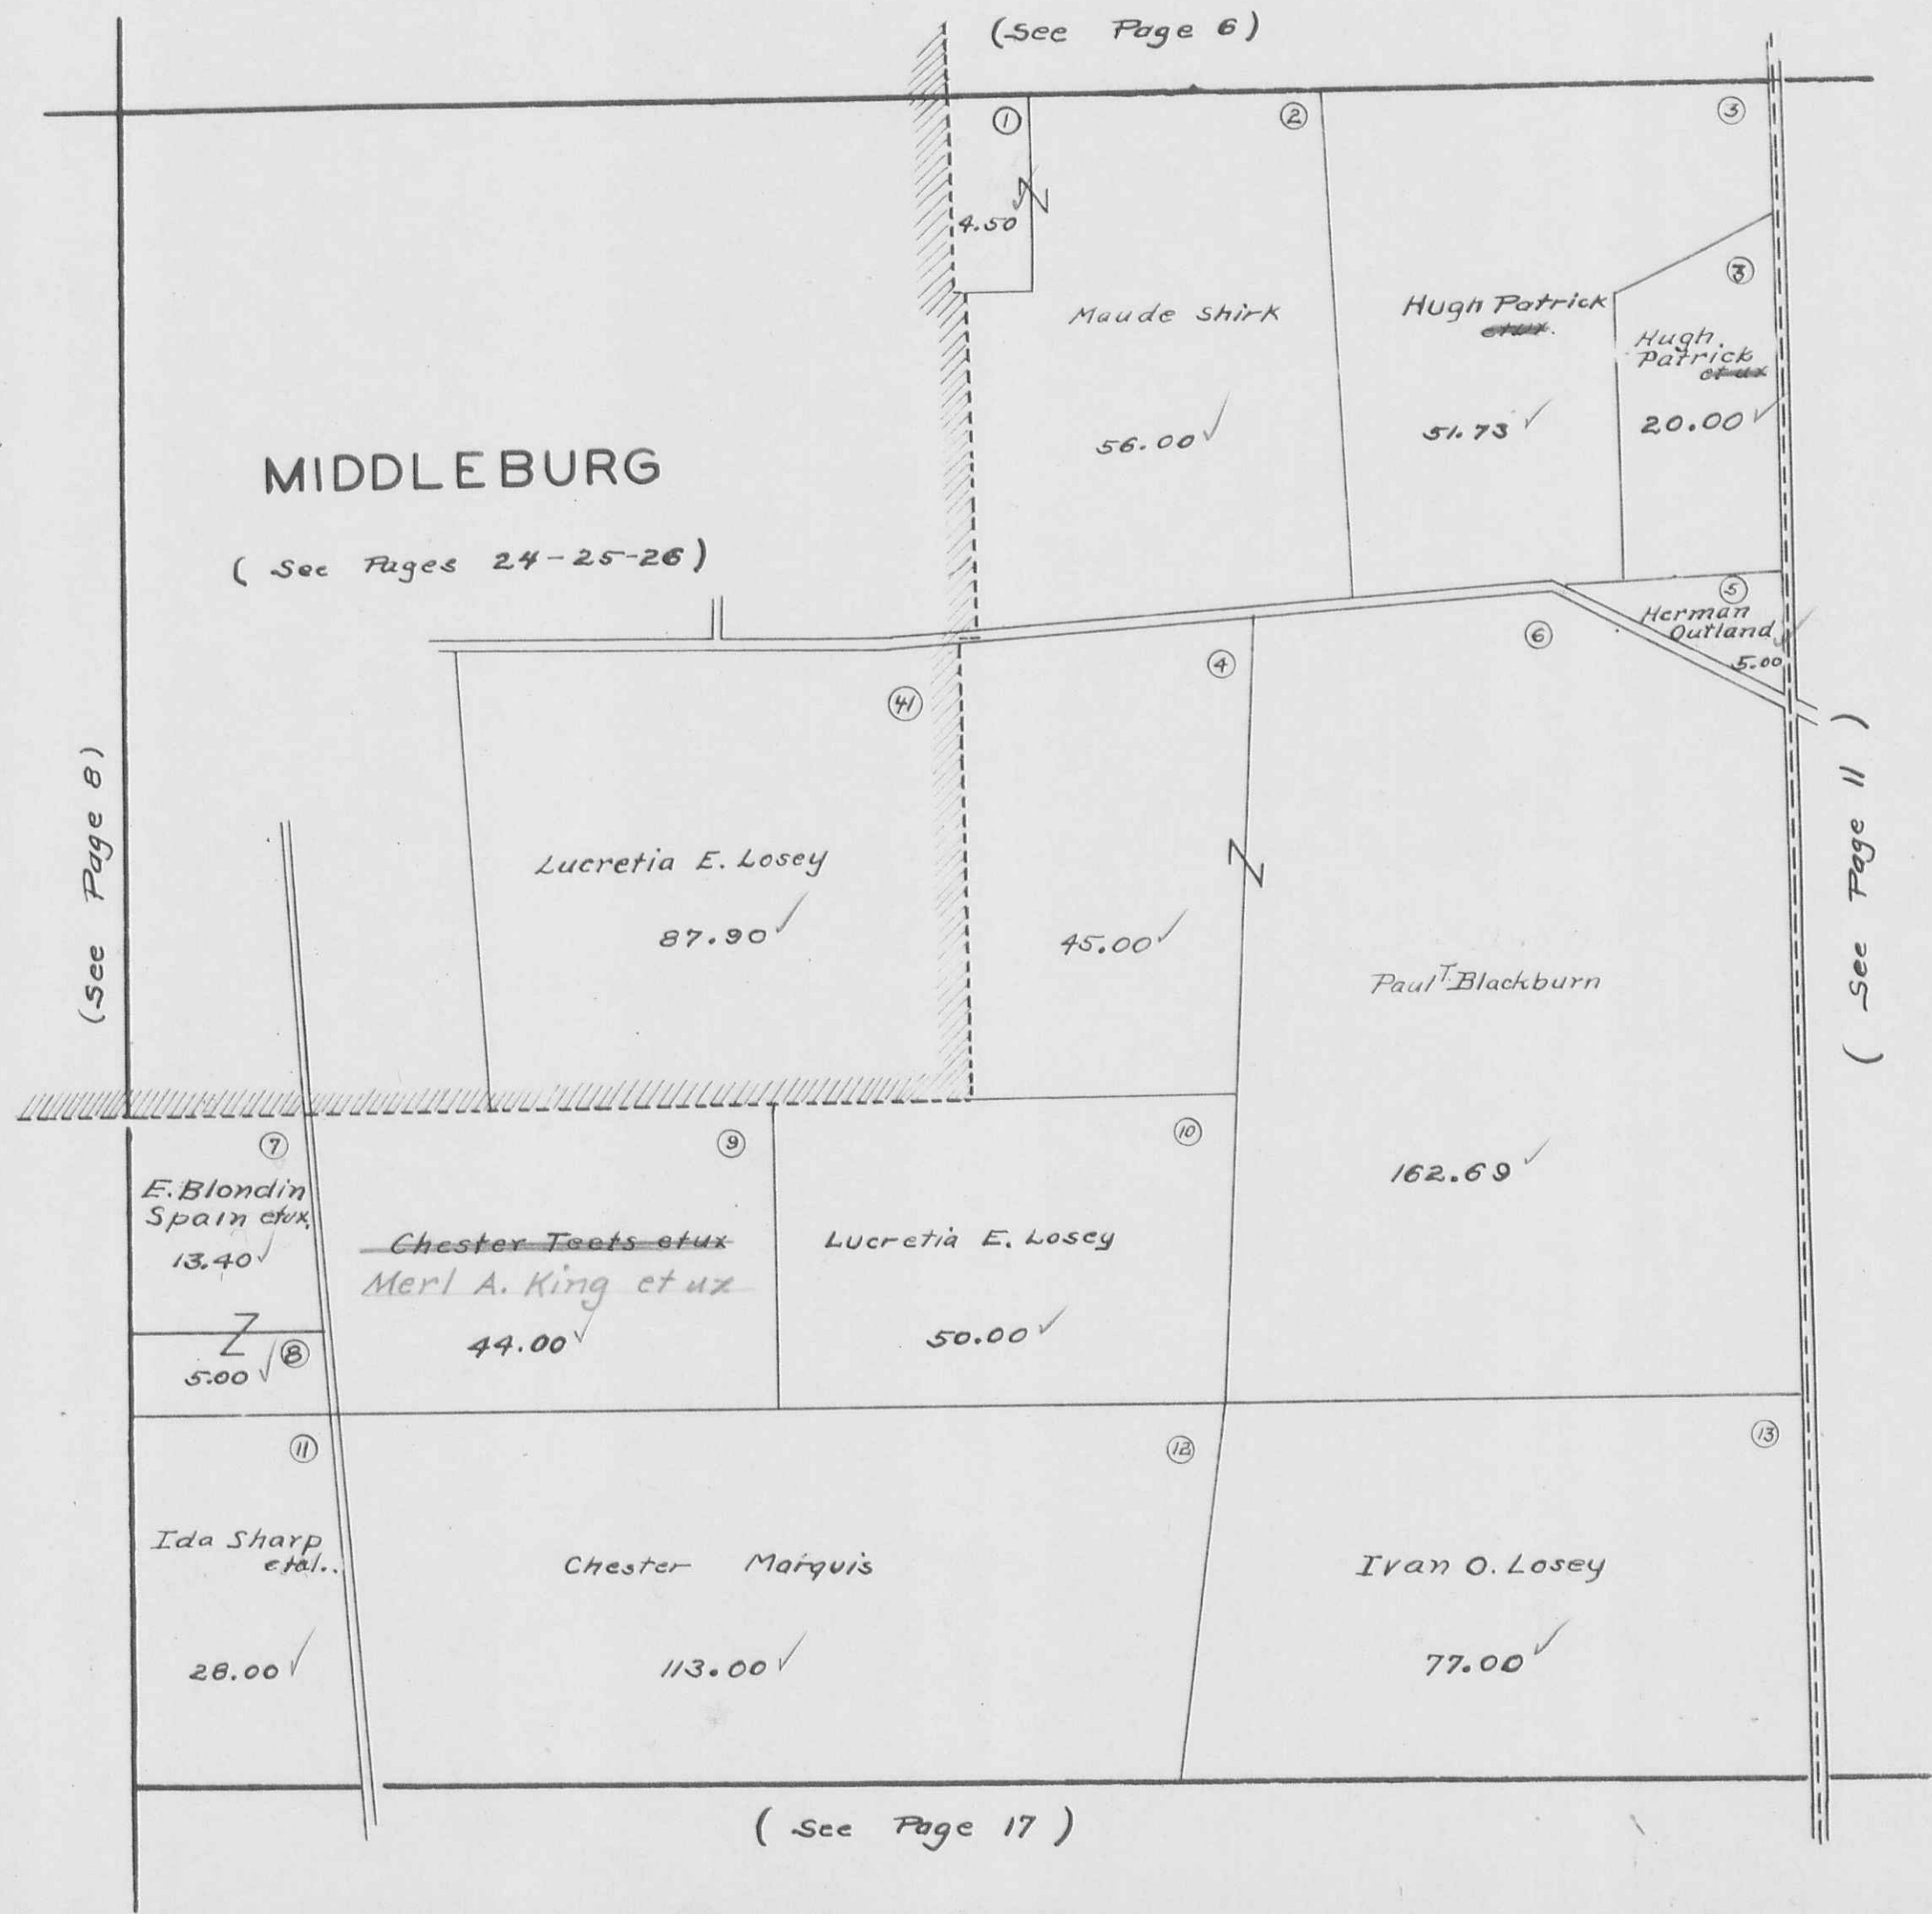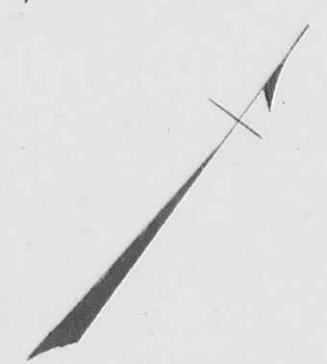

ZANE TOWNSHIP
VIRGINIA MILITARY SURVEYS 545
4811


SCALE 10 CHAINS TO THE INCH



ZANE TOWNSHIP
VIRGINIA MILITARY SURVEY


SCALE 10 CHAINS TO THE INCH

12395
12399
12402
12427
12428

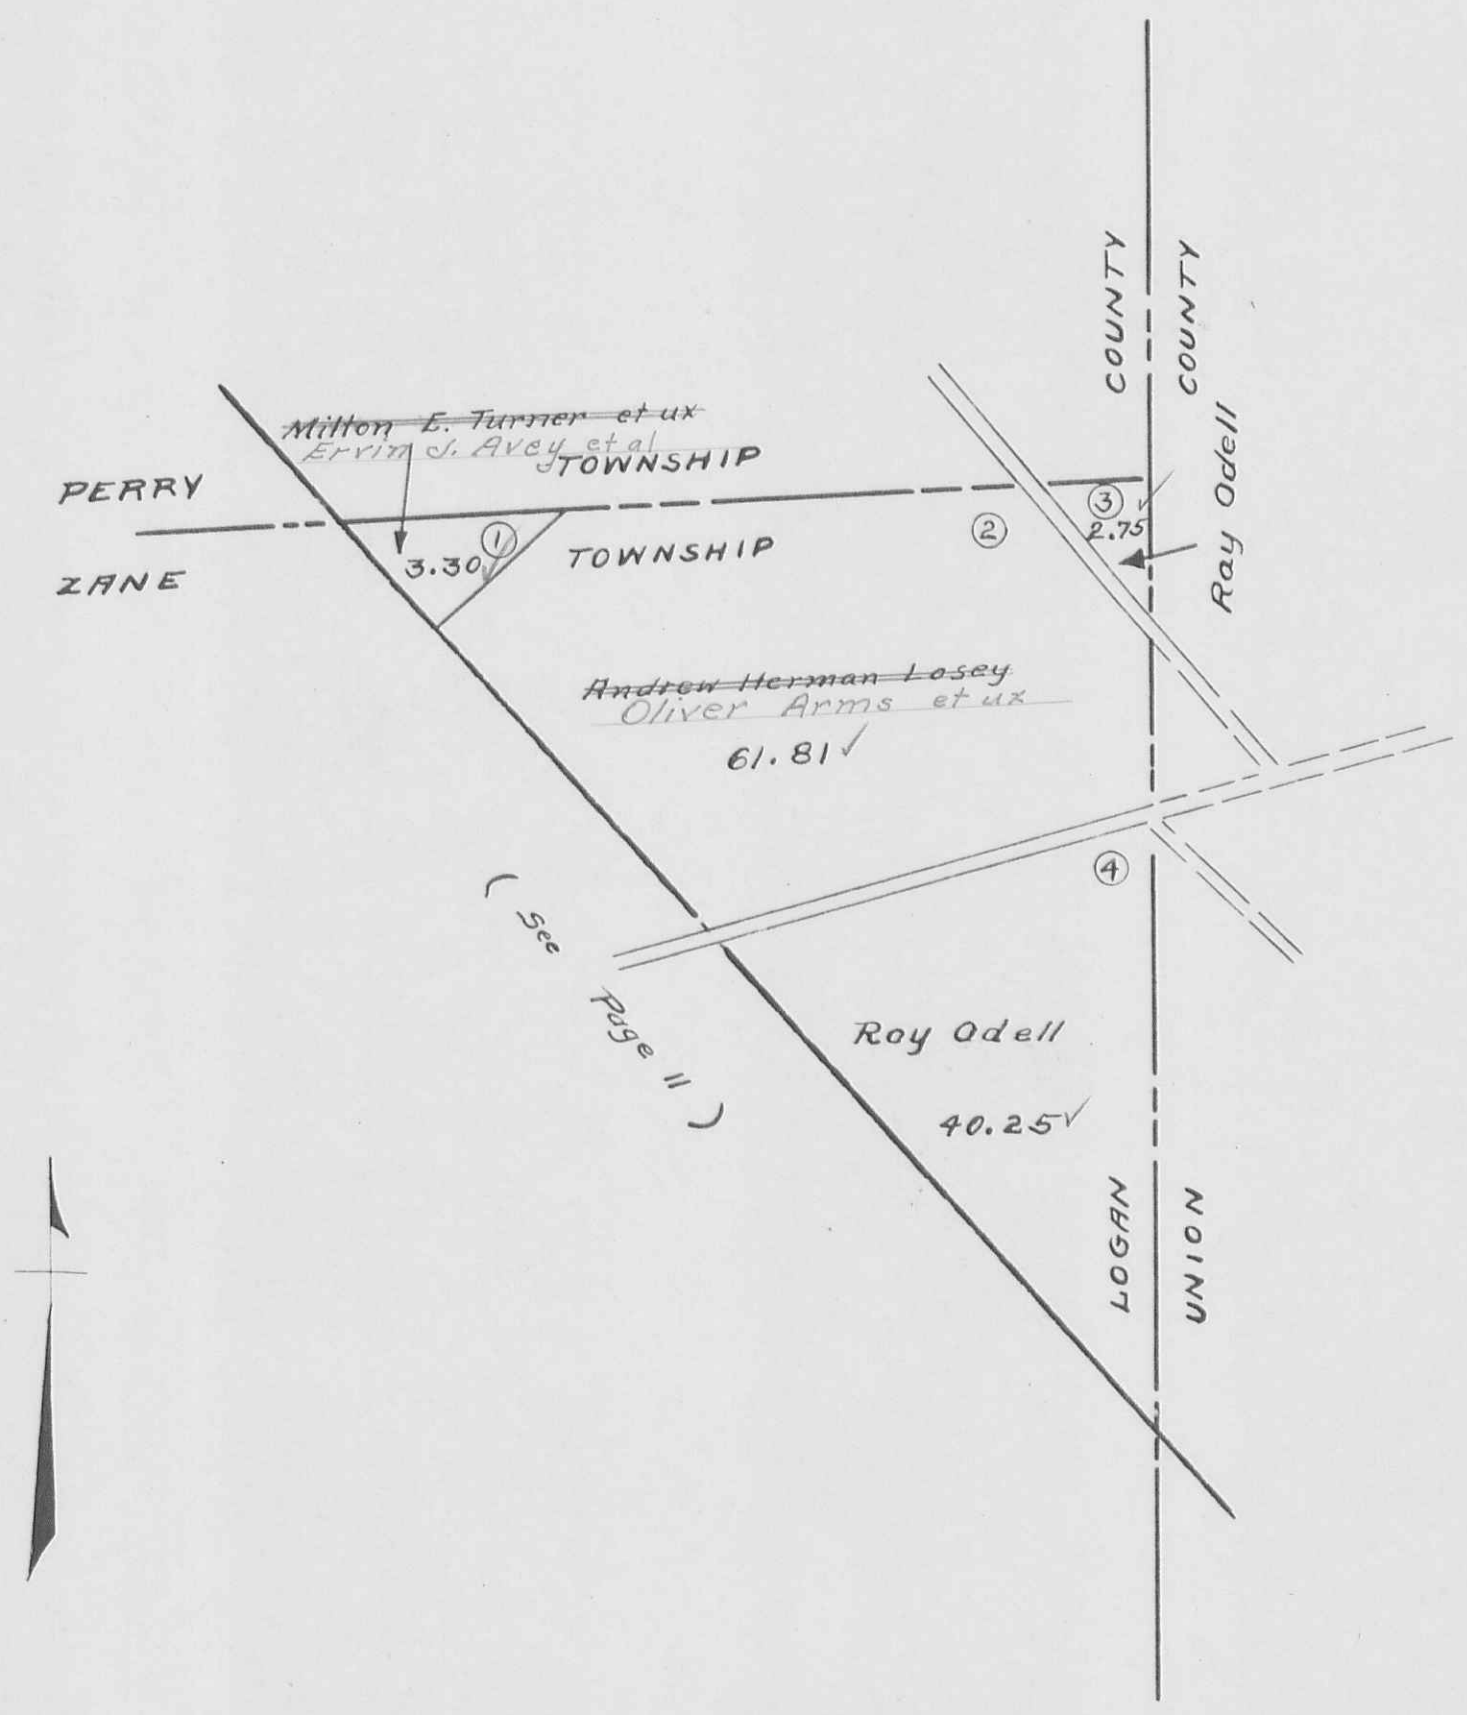

ZANE TOWNSHIP
VIRGINIA MILITARY SURVEYS 3230
3231


SCALE 10 CHAINS TO THE INCH

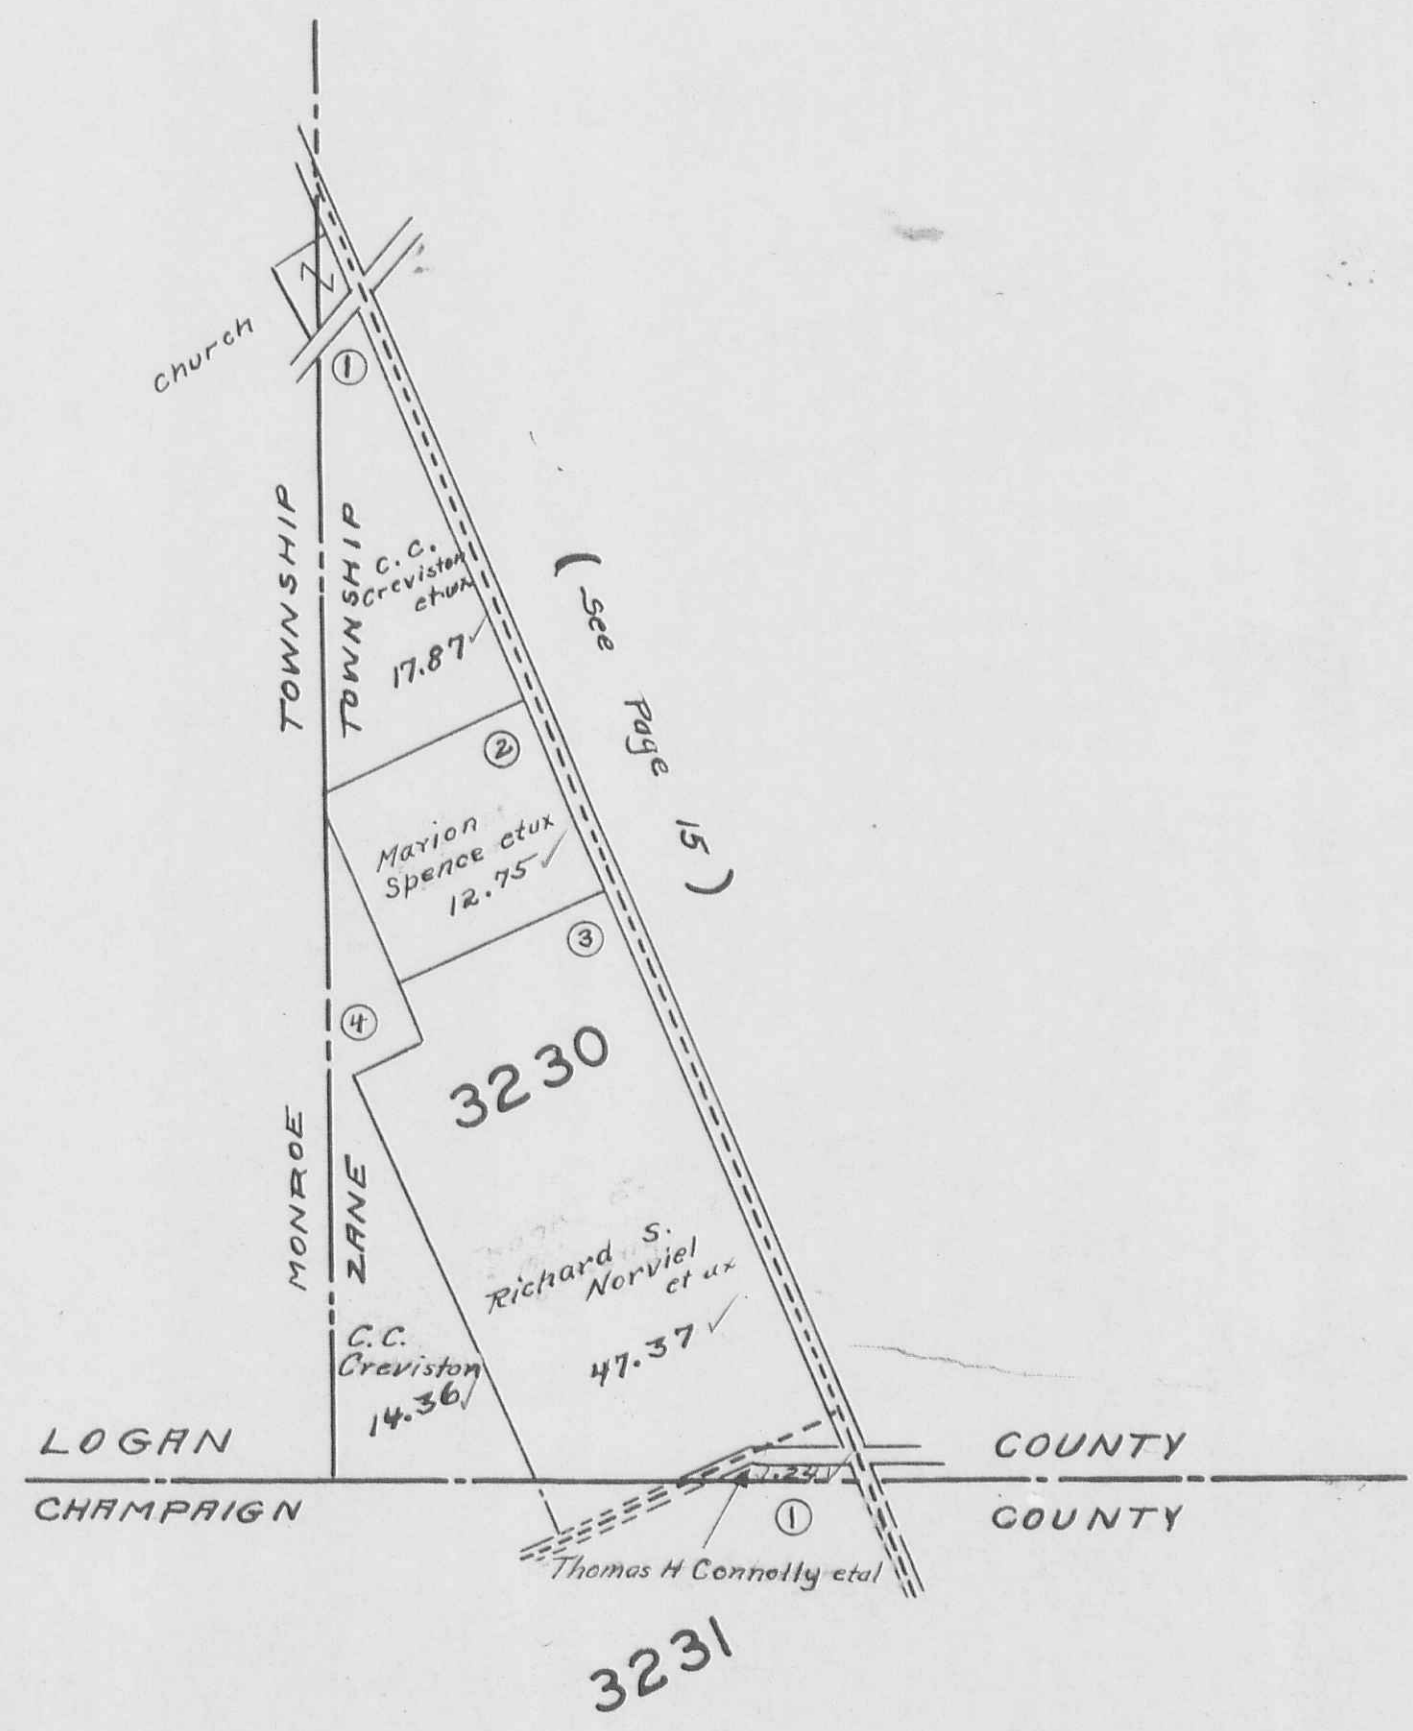

ZANE TOWNSHIP
VIRGINIA MILITARY SURVEYS

SCALE 10 CHAINS TO THE INCH

9679
7117
9657
9740


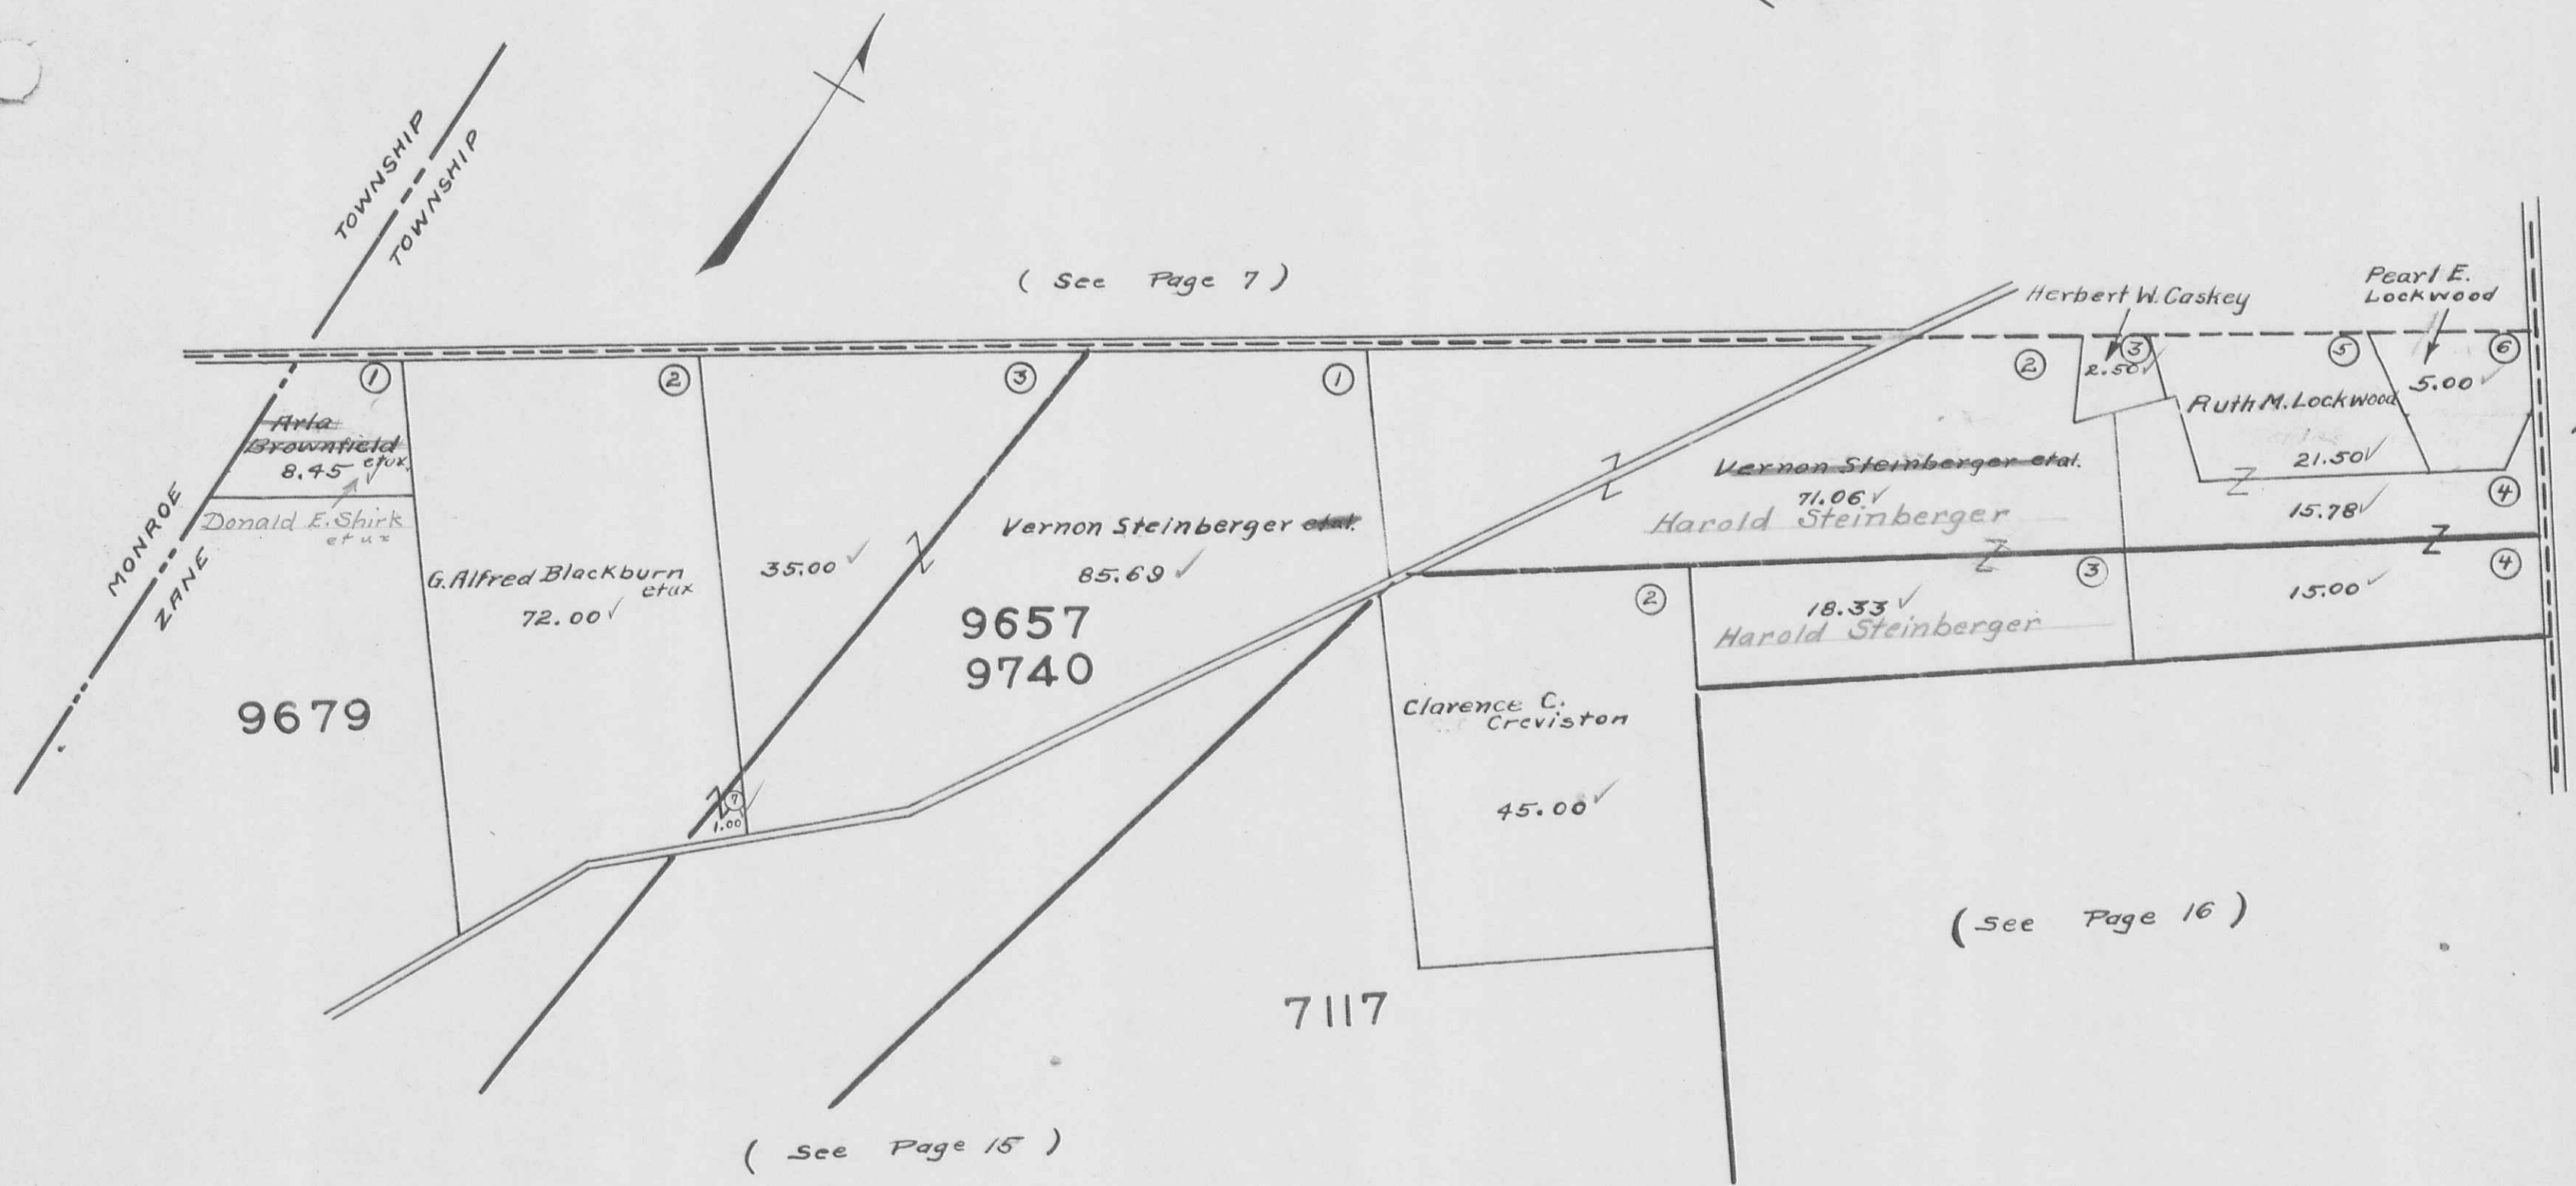


ZANE TOWNSHIP

VIRGINIA MILITARY SURVEYS

9679
7117
{ 9657
9740

SCALE 10 CHAINS TO THE INCH

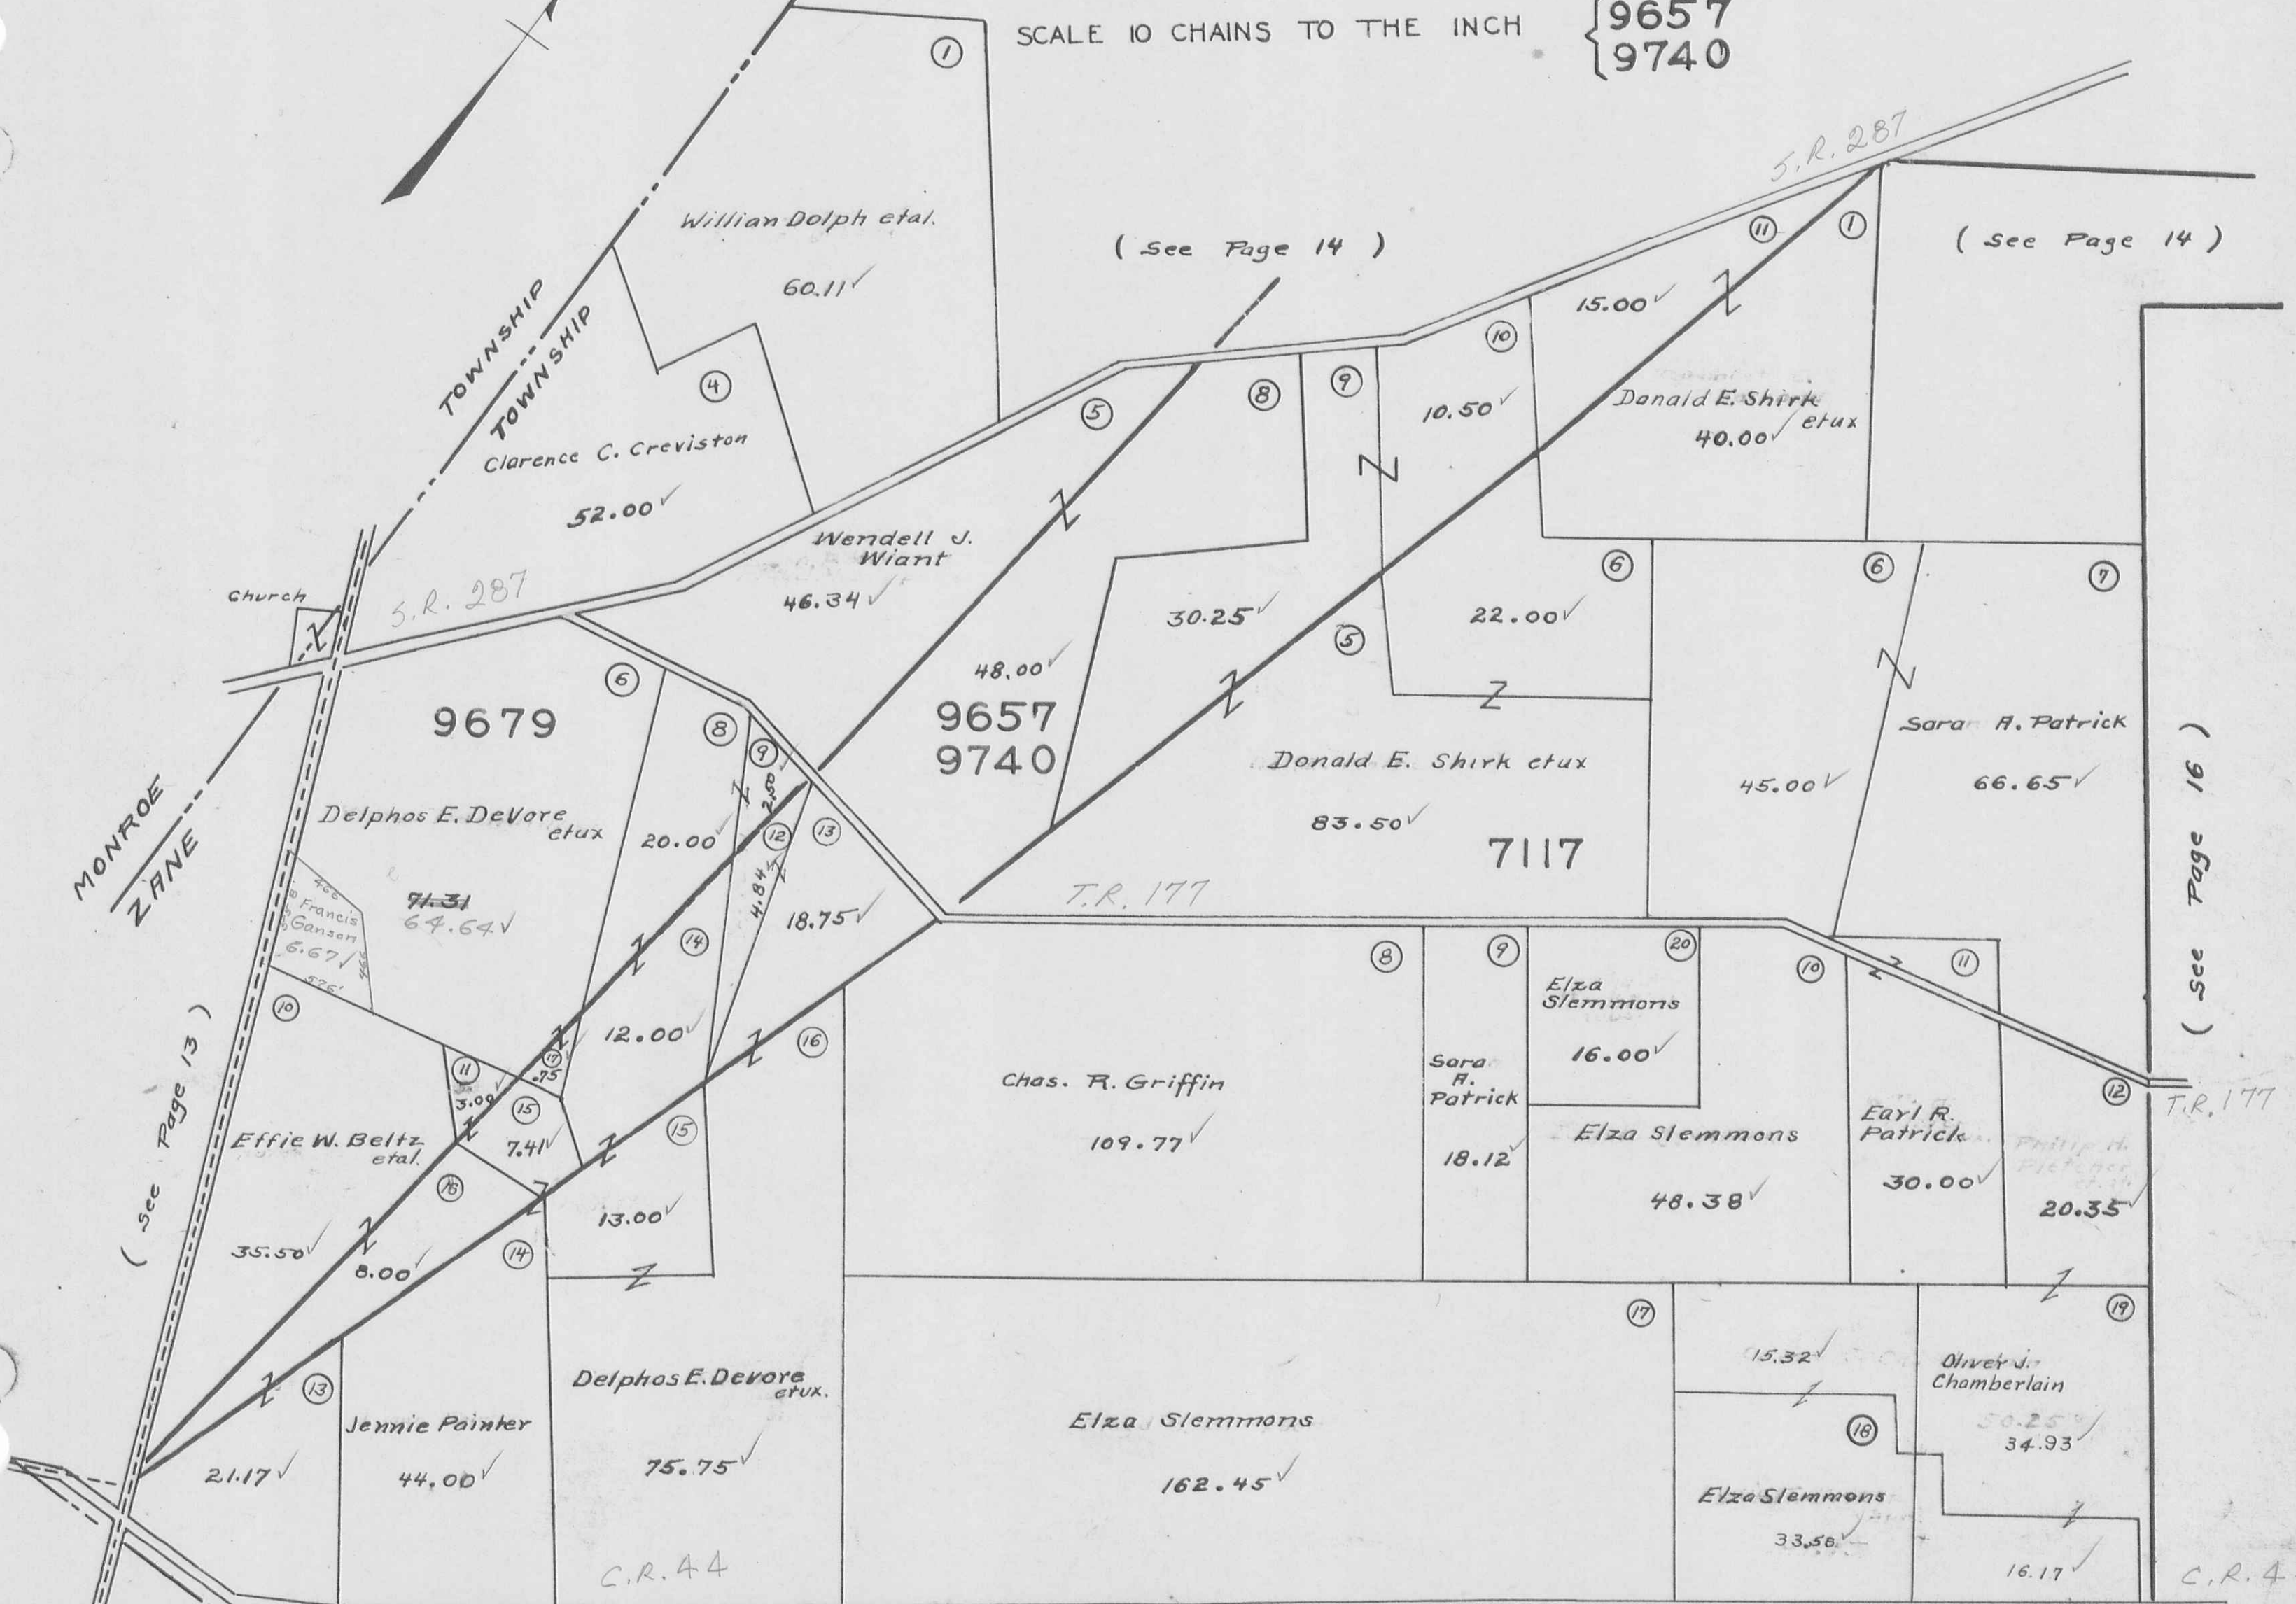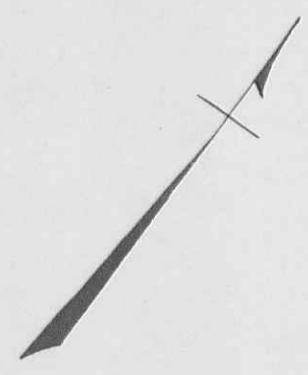

(See Page 14)

(See Page 14)

(see Page 16)

(see Page 13)

(See Page 19)



(See Page 20)

R.F.W.

ZANE TOWNSHIP
 VIRGINIA MILITARY SURVEY 4953



SCALE 10 CHAINS TO THE INCH

(See Page 14)

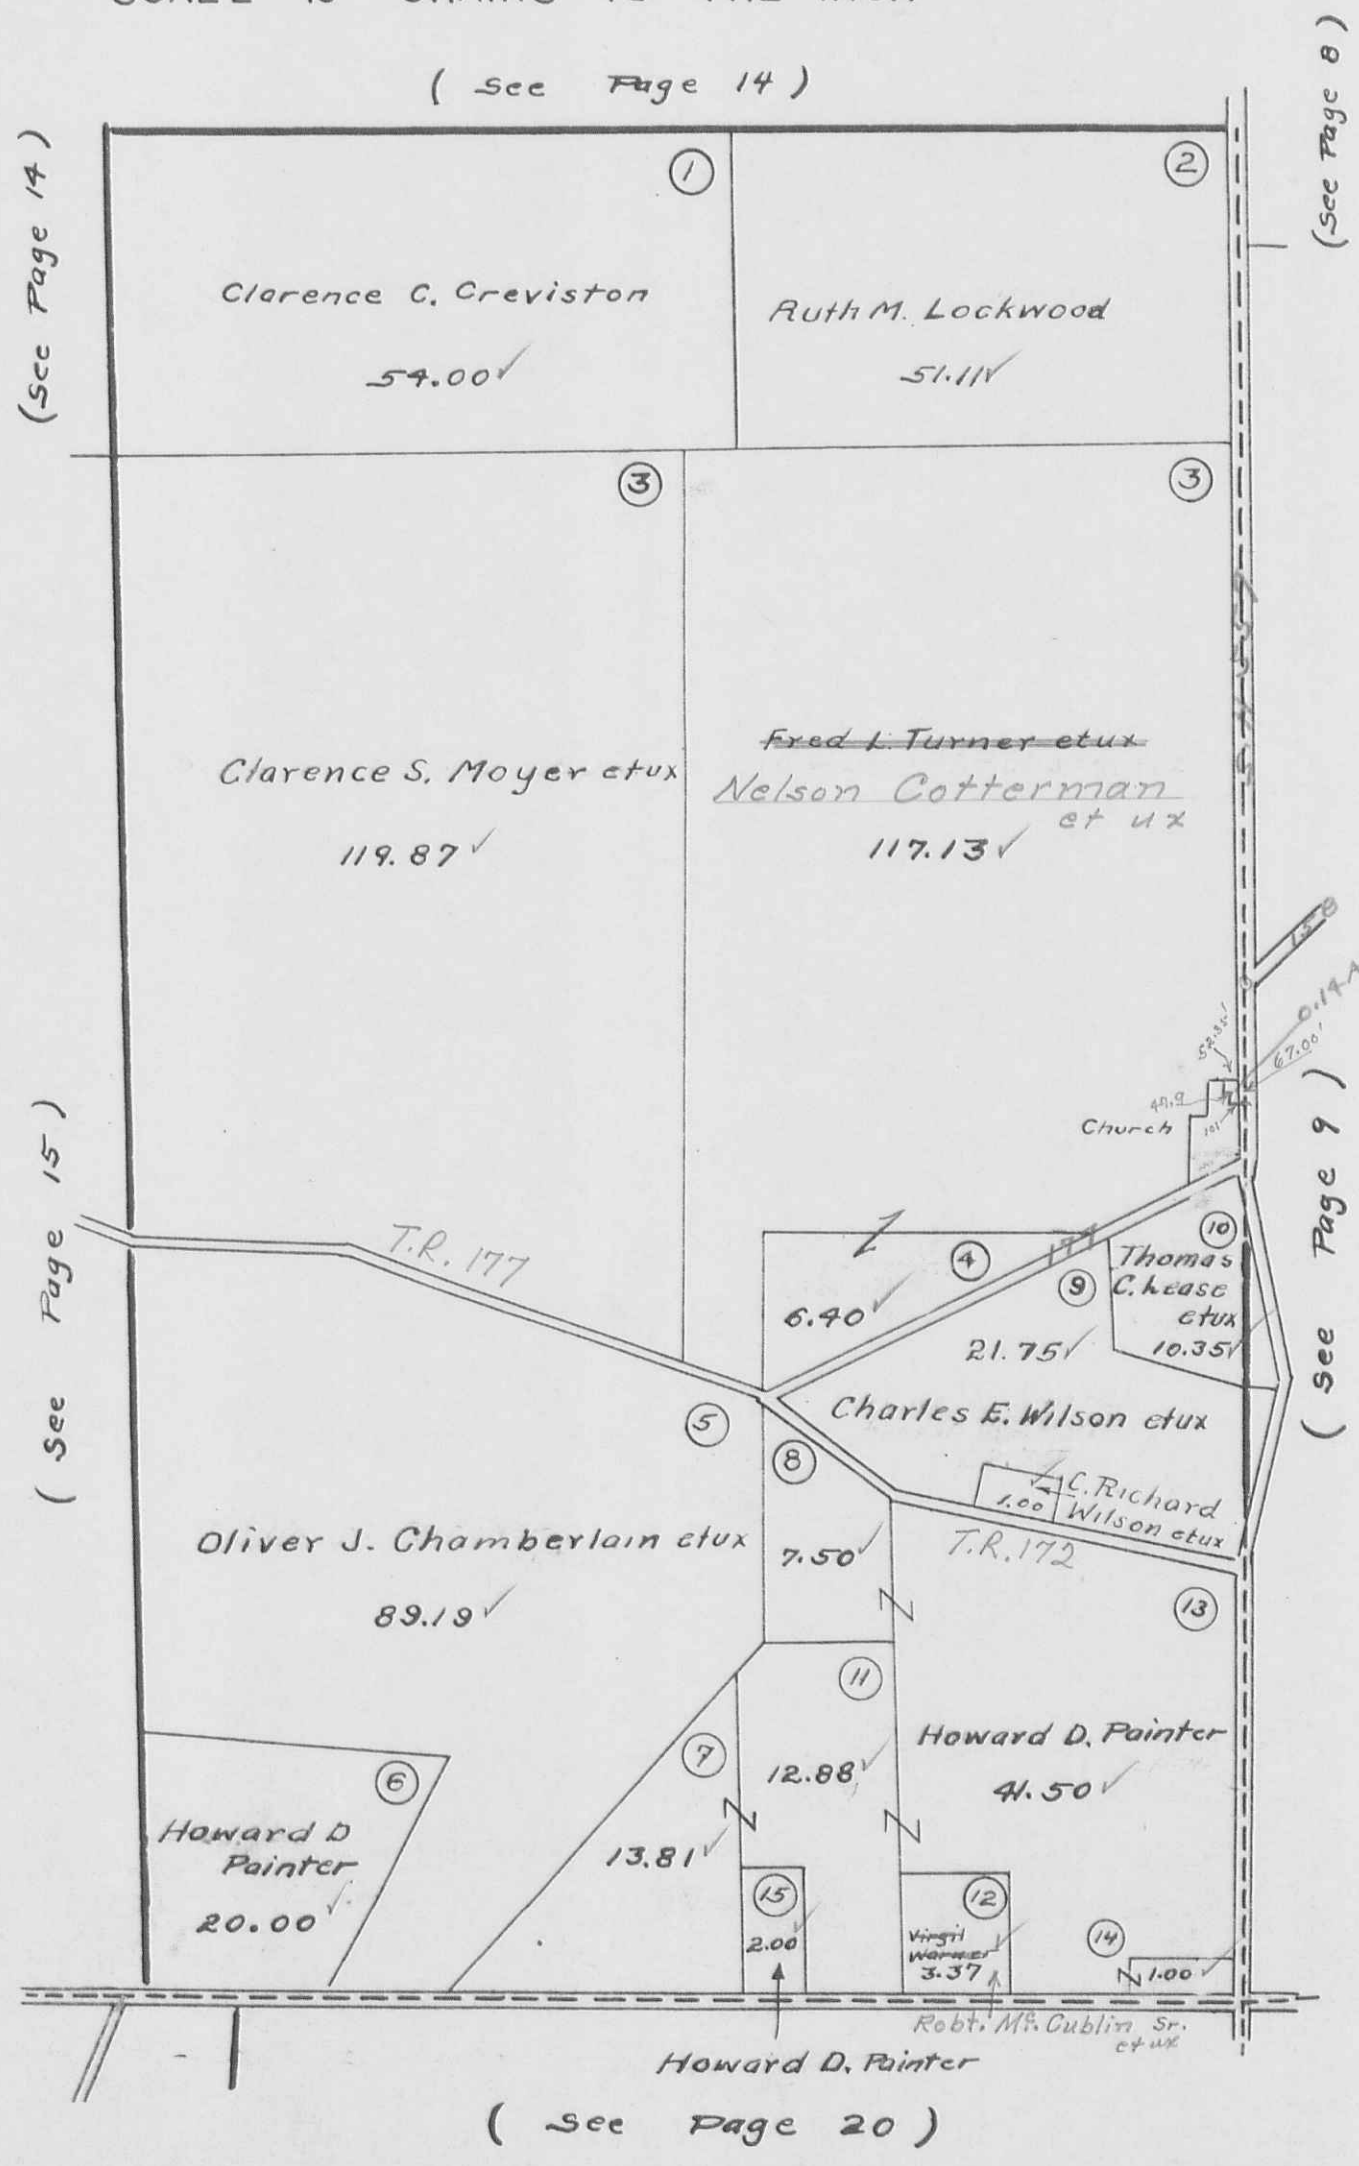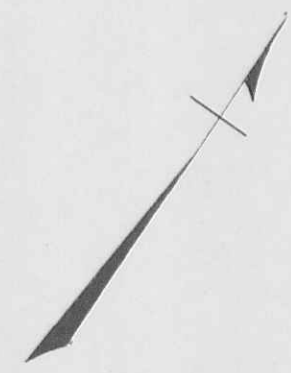

ZANE TOWNSHIP
 VIRGINIA MILITARY SURVEYS 3160 4606 12256

SCALE 10 CHAINS TO THE INCH
 (See Page 10)

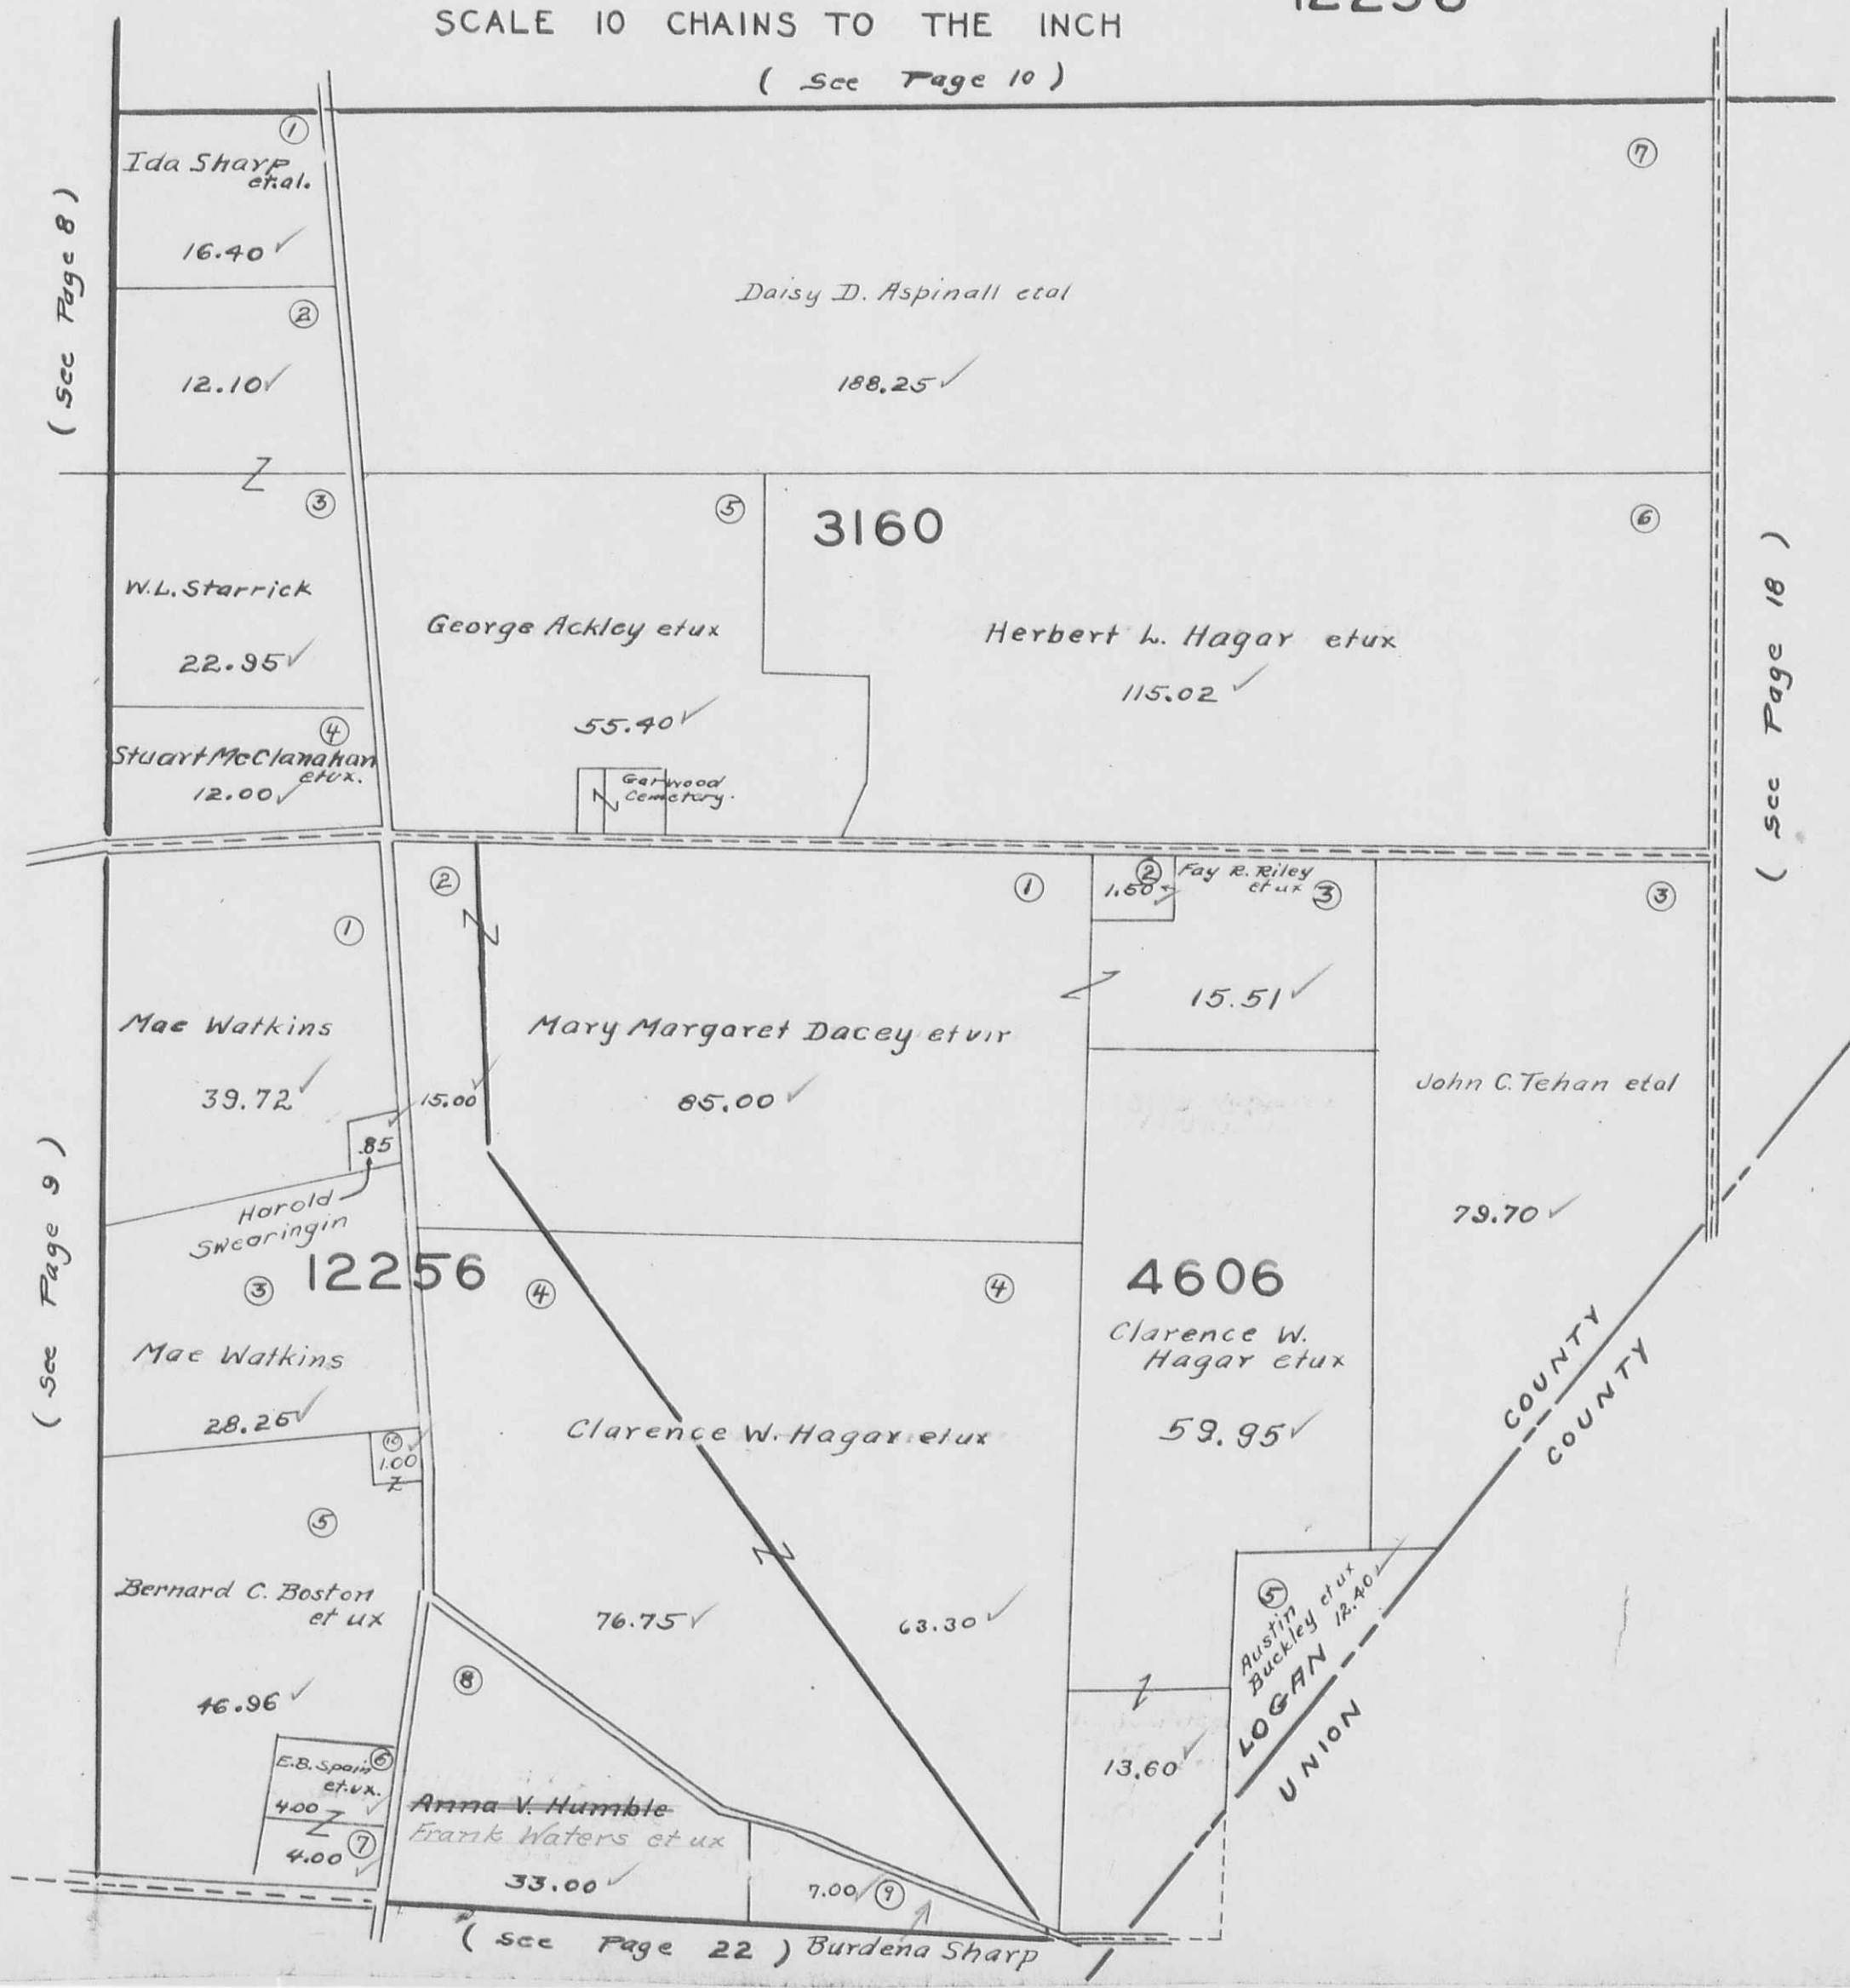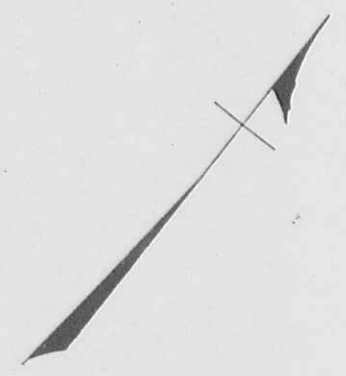

(See Page 8)

(See Page 9)


(See Page 18)

(See Page 22) Burdena Sharp

RFW


ZANE TOWNSHIP
VIRGINIA MILITARY SURVEY 4933

SCALE 10 CHAINS TO THE INCH

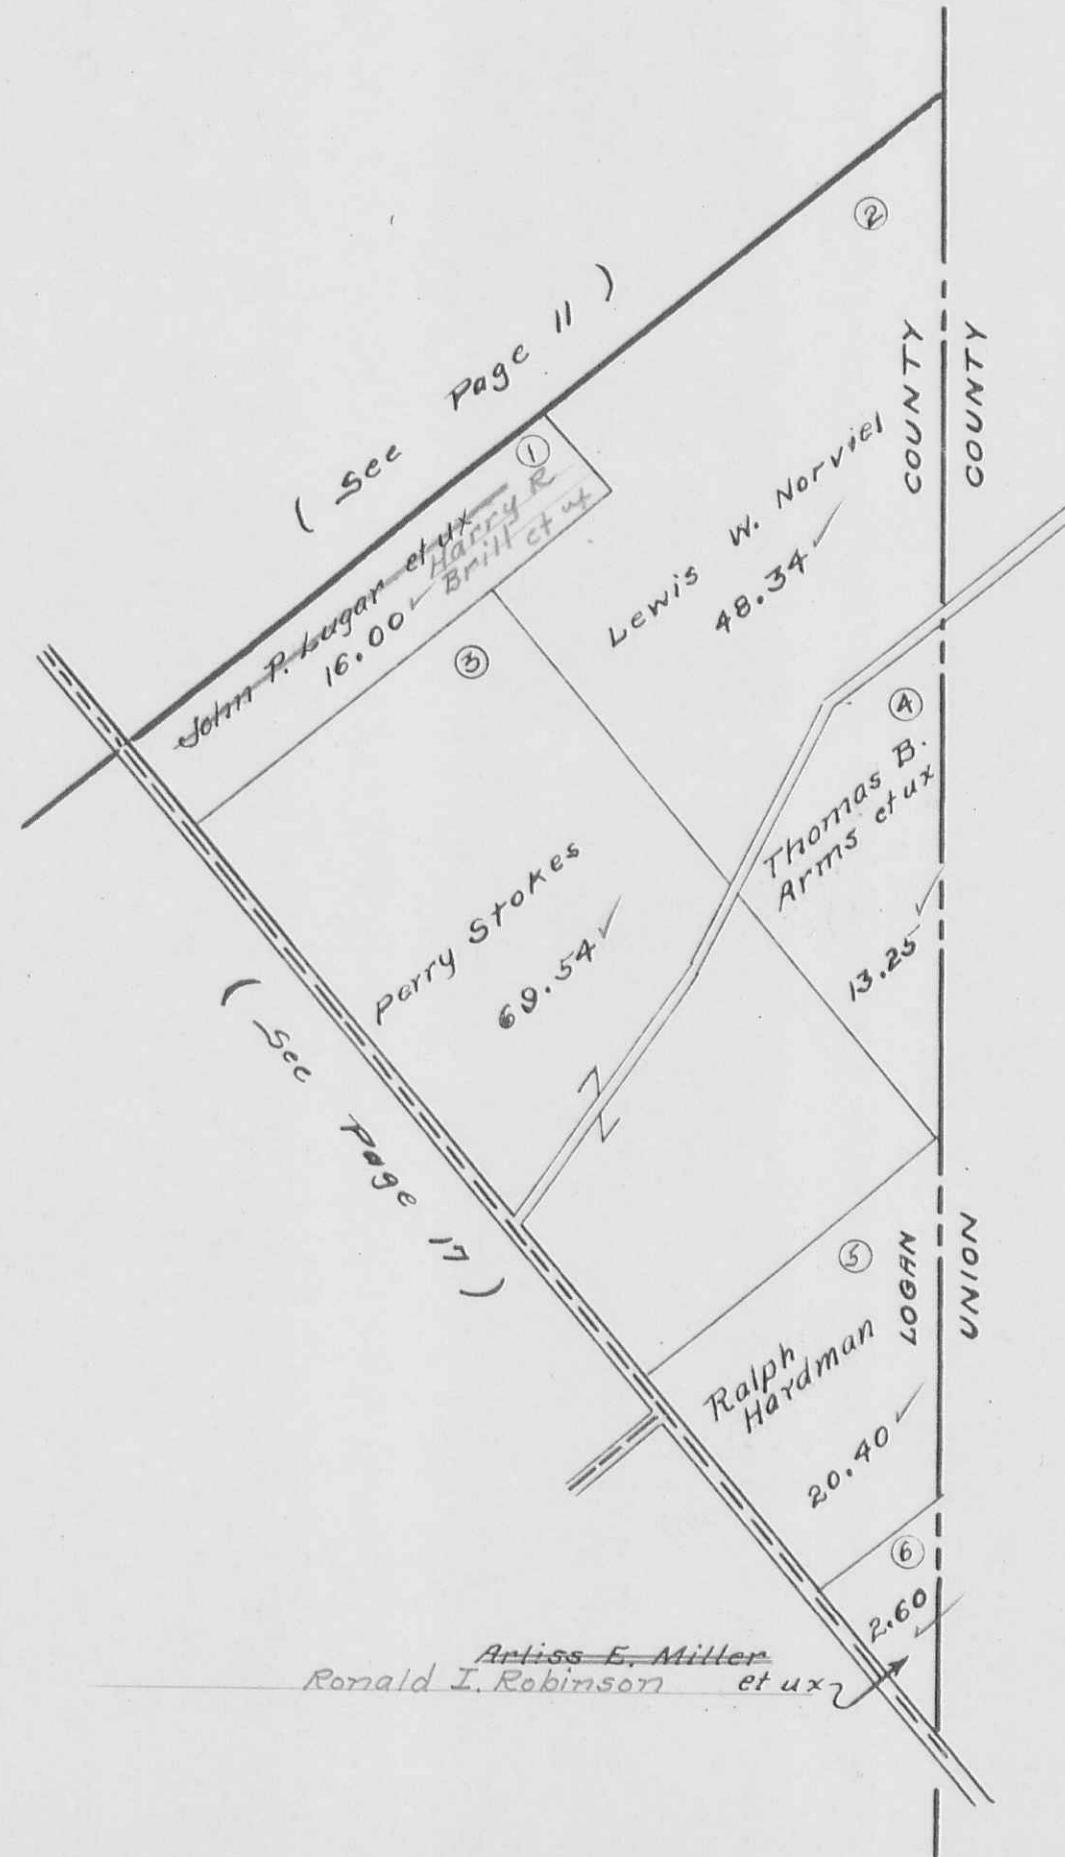

SCALE 10 CHAINS TO THE INCH

(See Page 15)

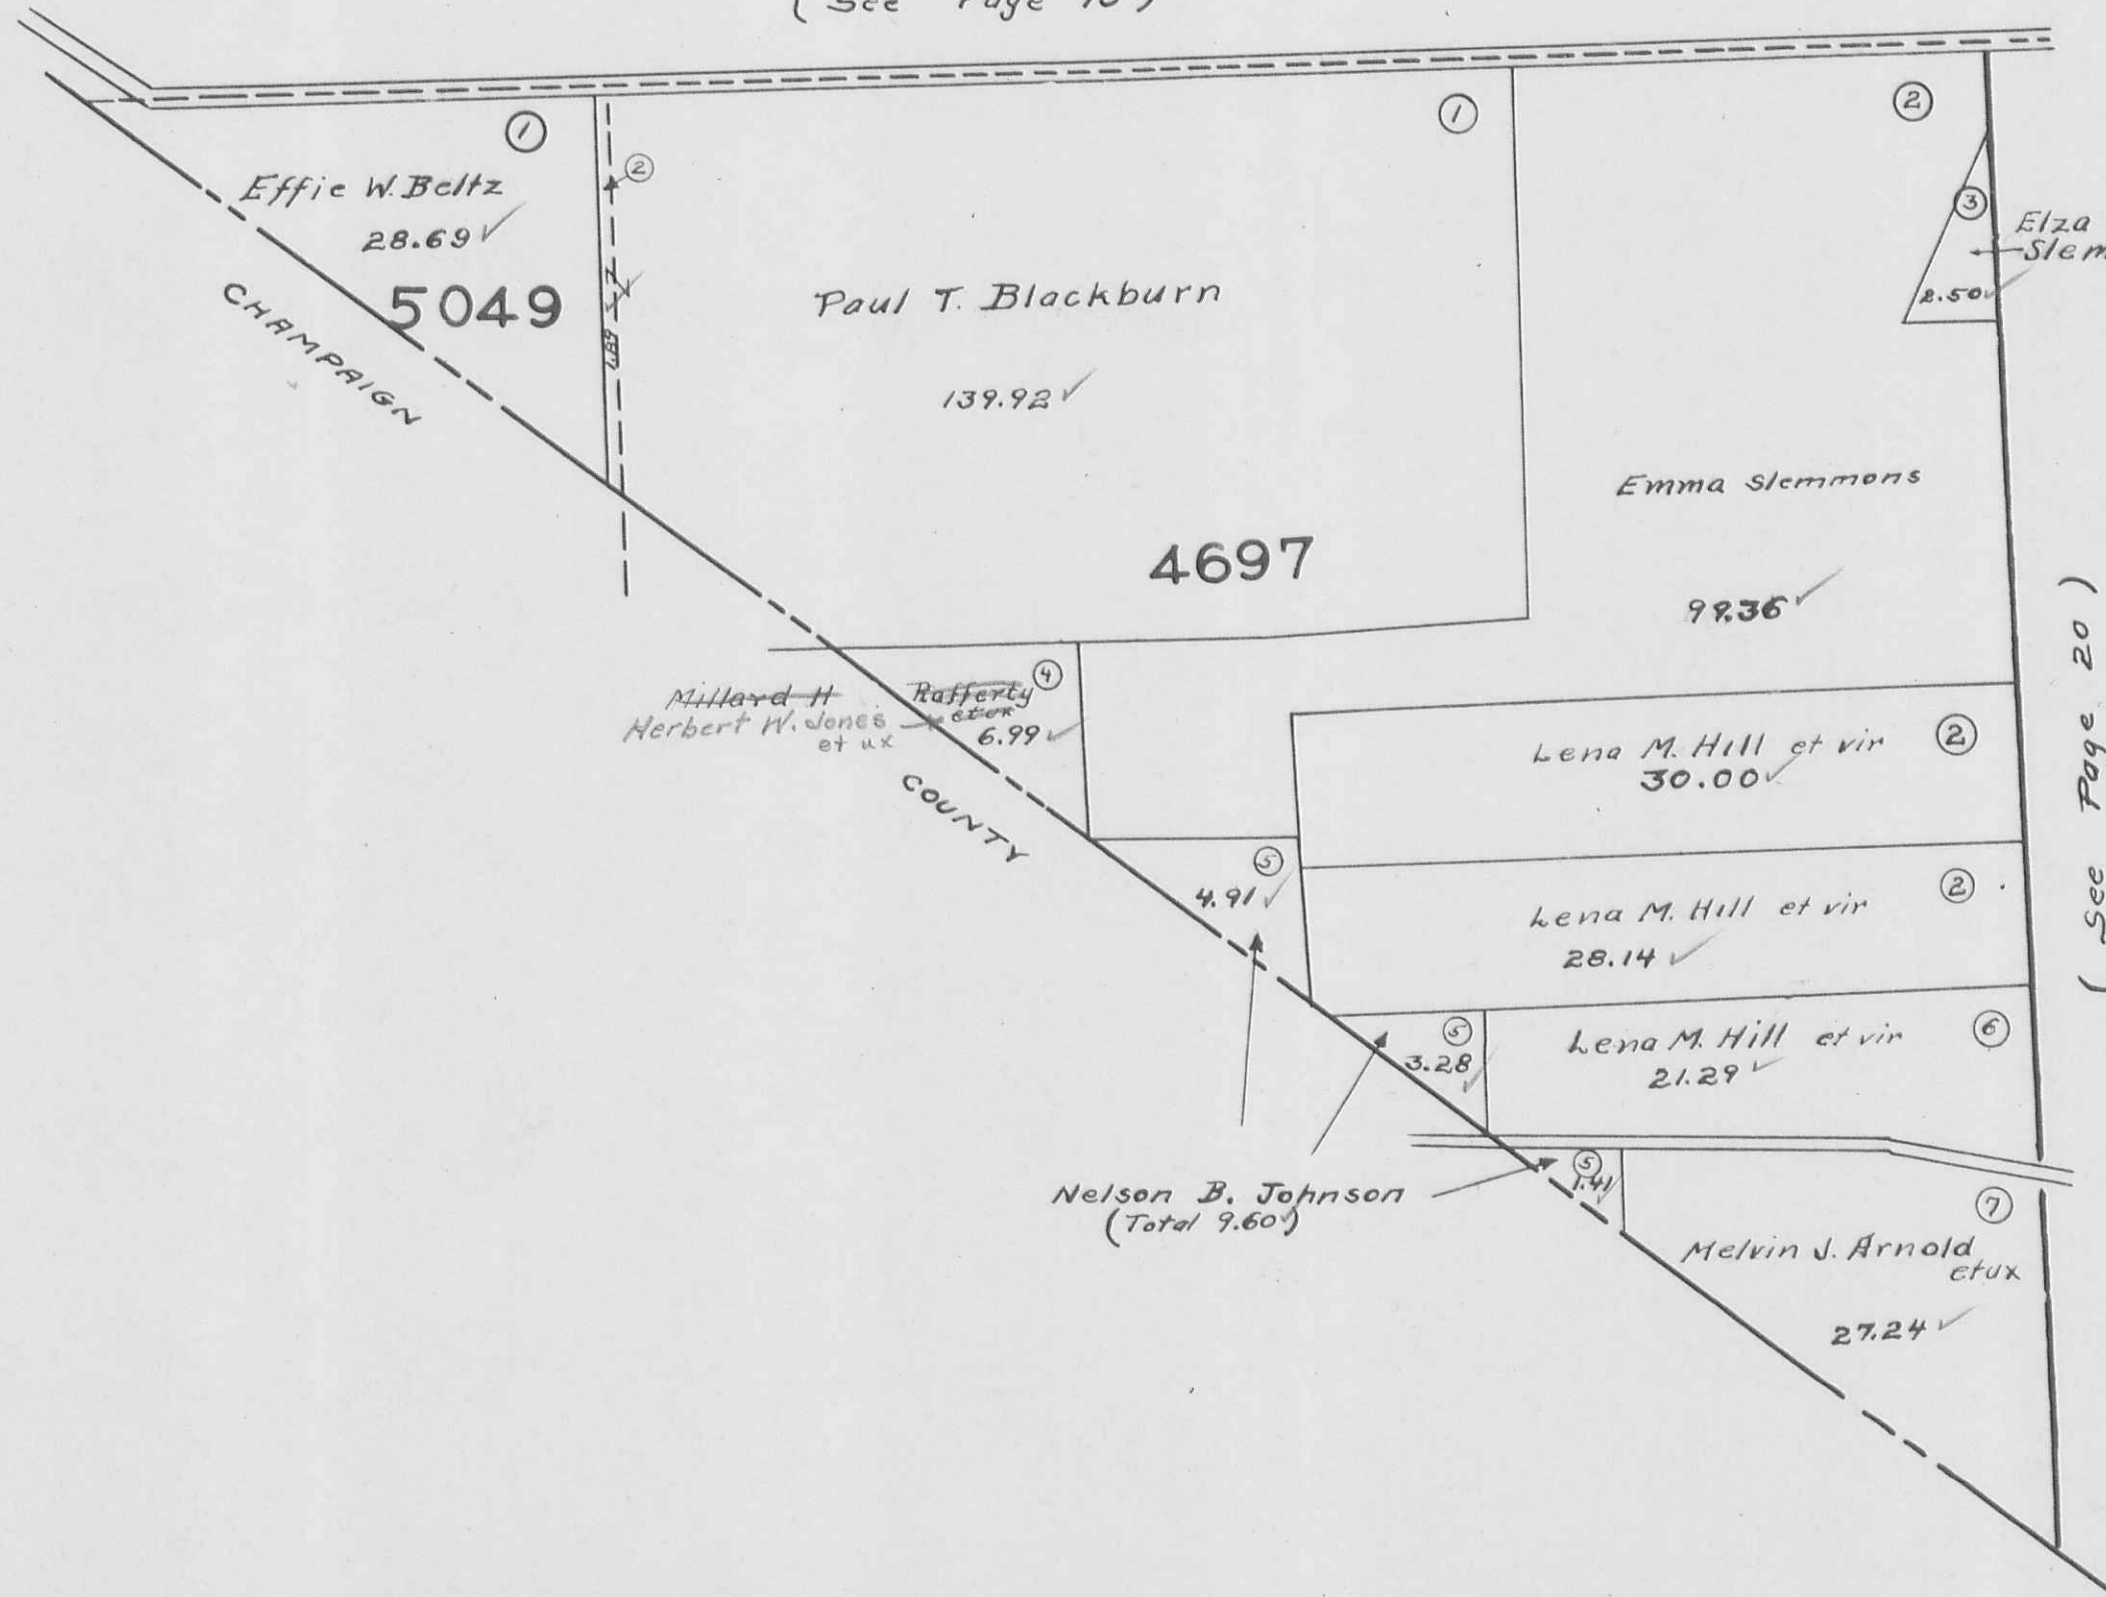


(See Page 20)

ZANE TOWNSHIP
VIRGINIA MILITARY SURVEYS

3688
4666
4859

SCALE 10 CHAINS TO THE INCH
(See Page 15)


(See Page 16)

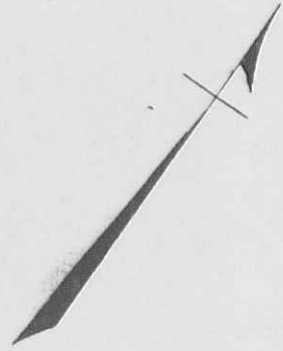

(See Page 19)

LOGAN
CHAMPAIGN

COUNTY
COUNTY

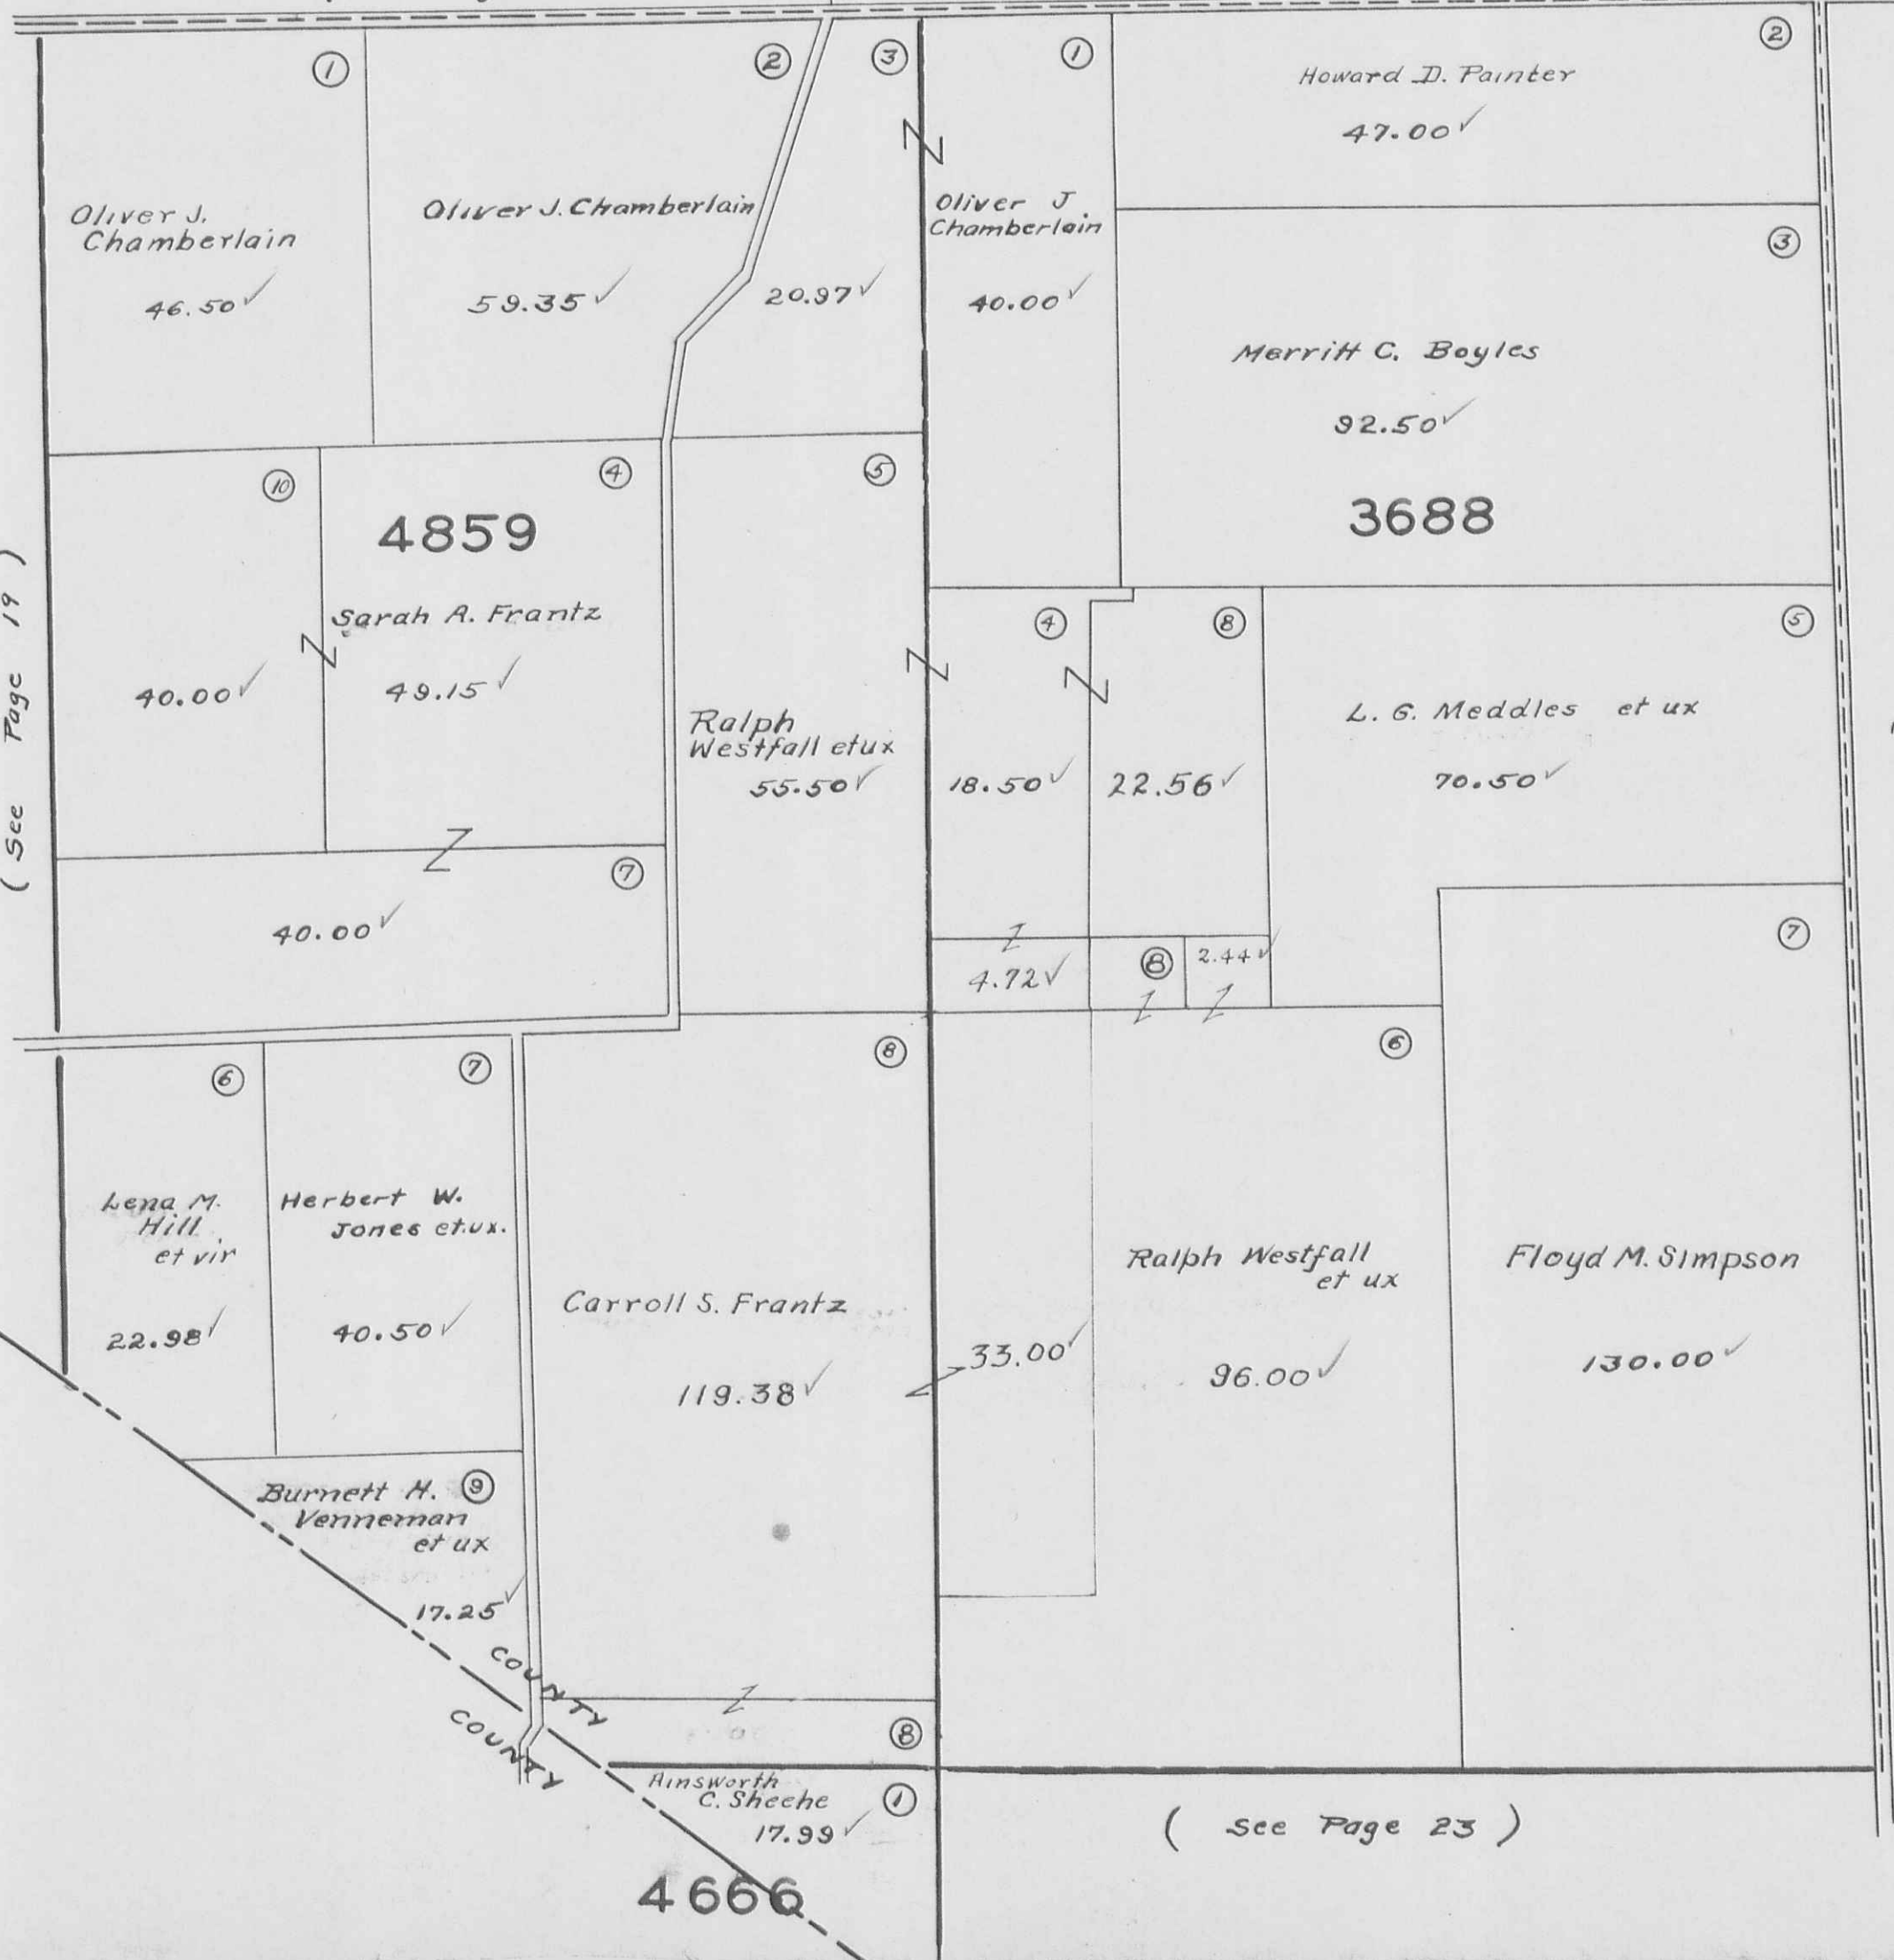



(See Page 21)

(See Page 23)

4666

ZANE TOWNSHIP
VIRGINIA MILITARY SURVEY 479


SCALE 10 CHAINS TO THE INCH

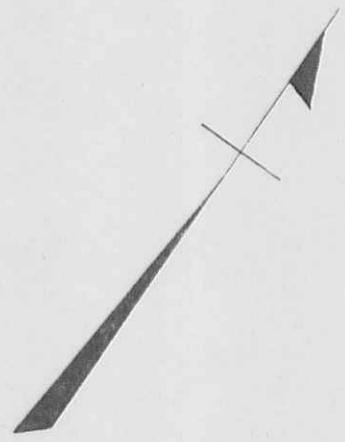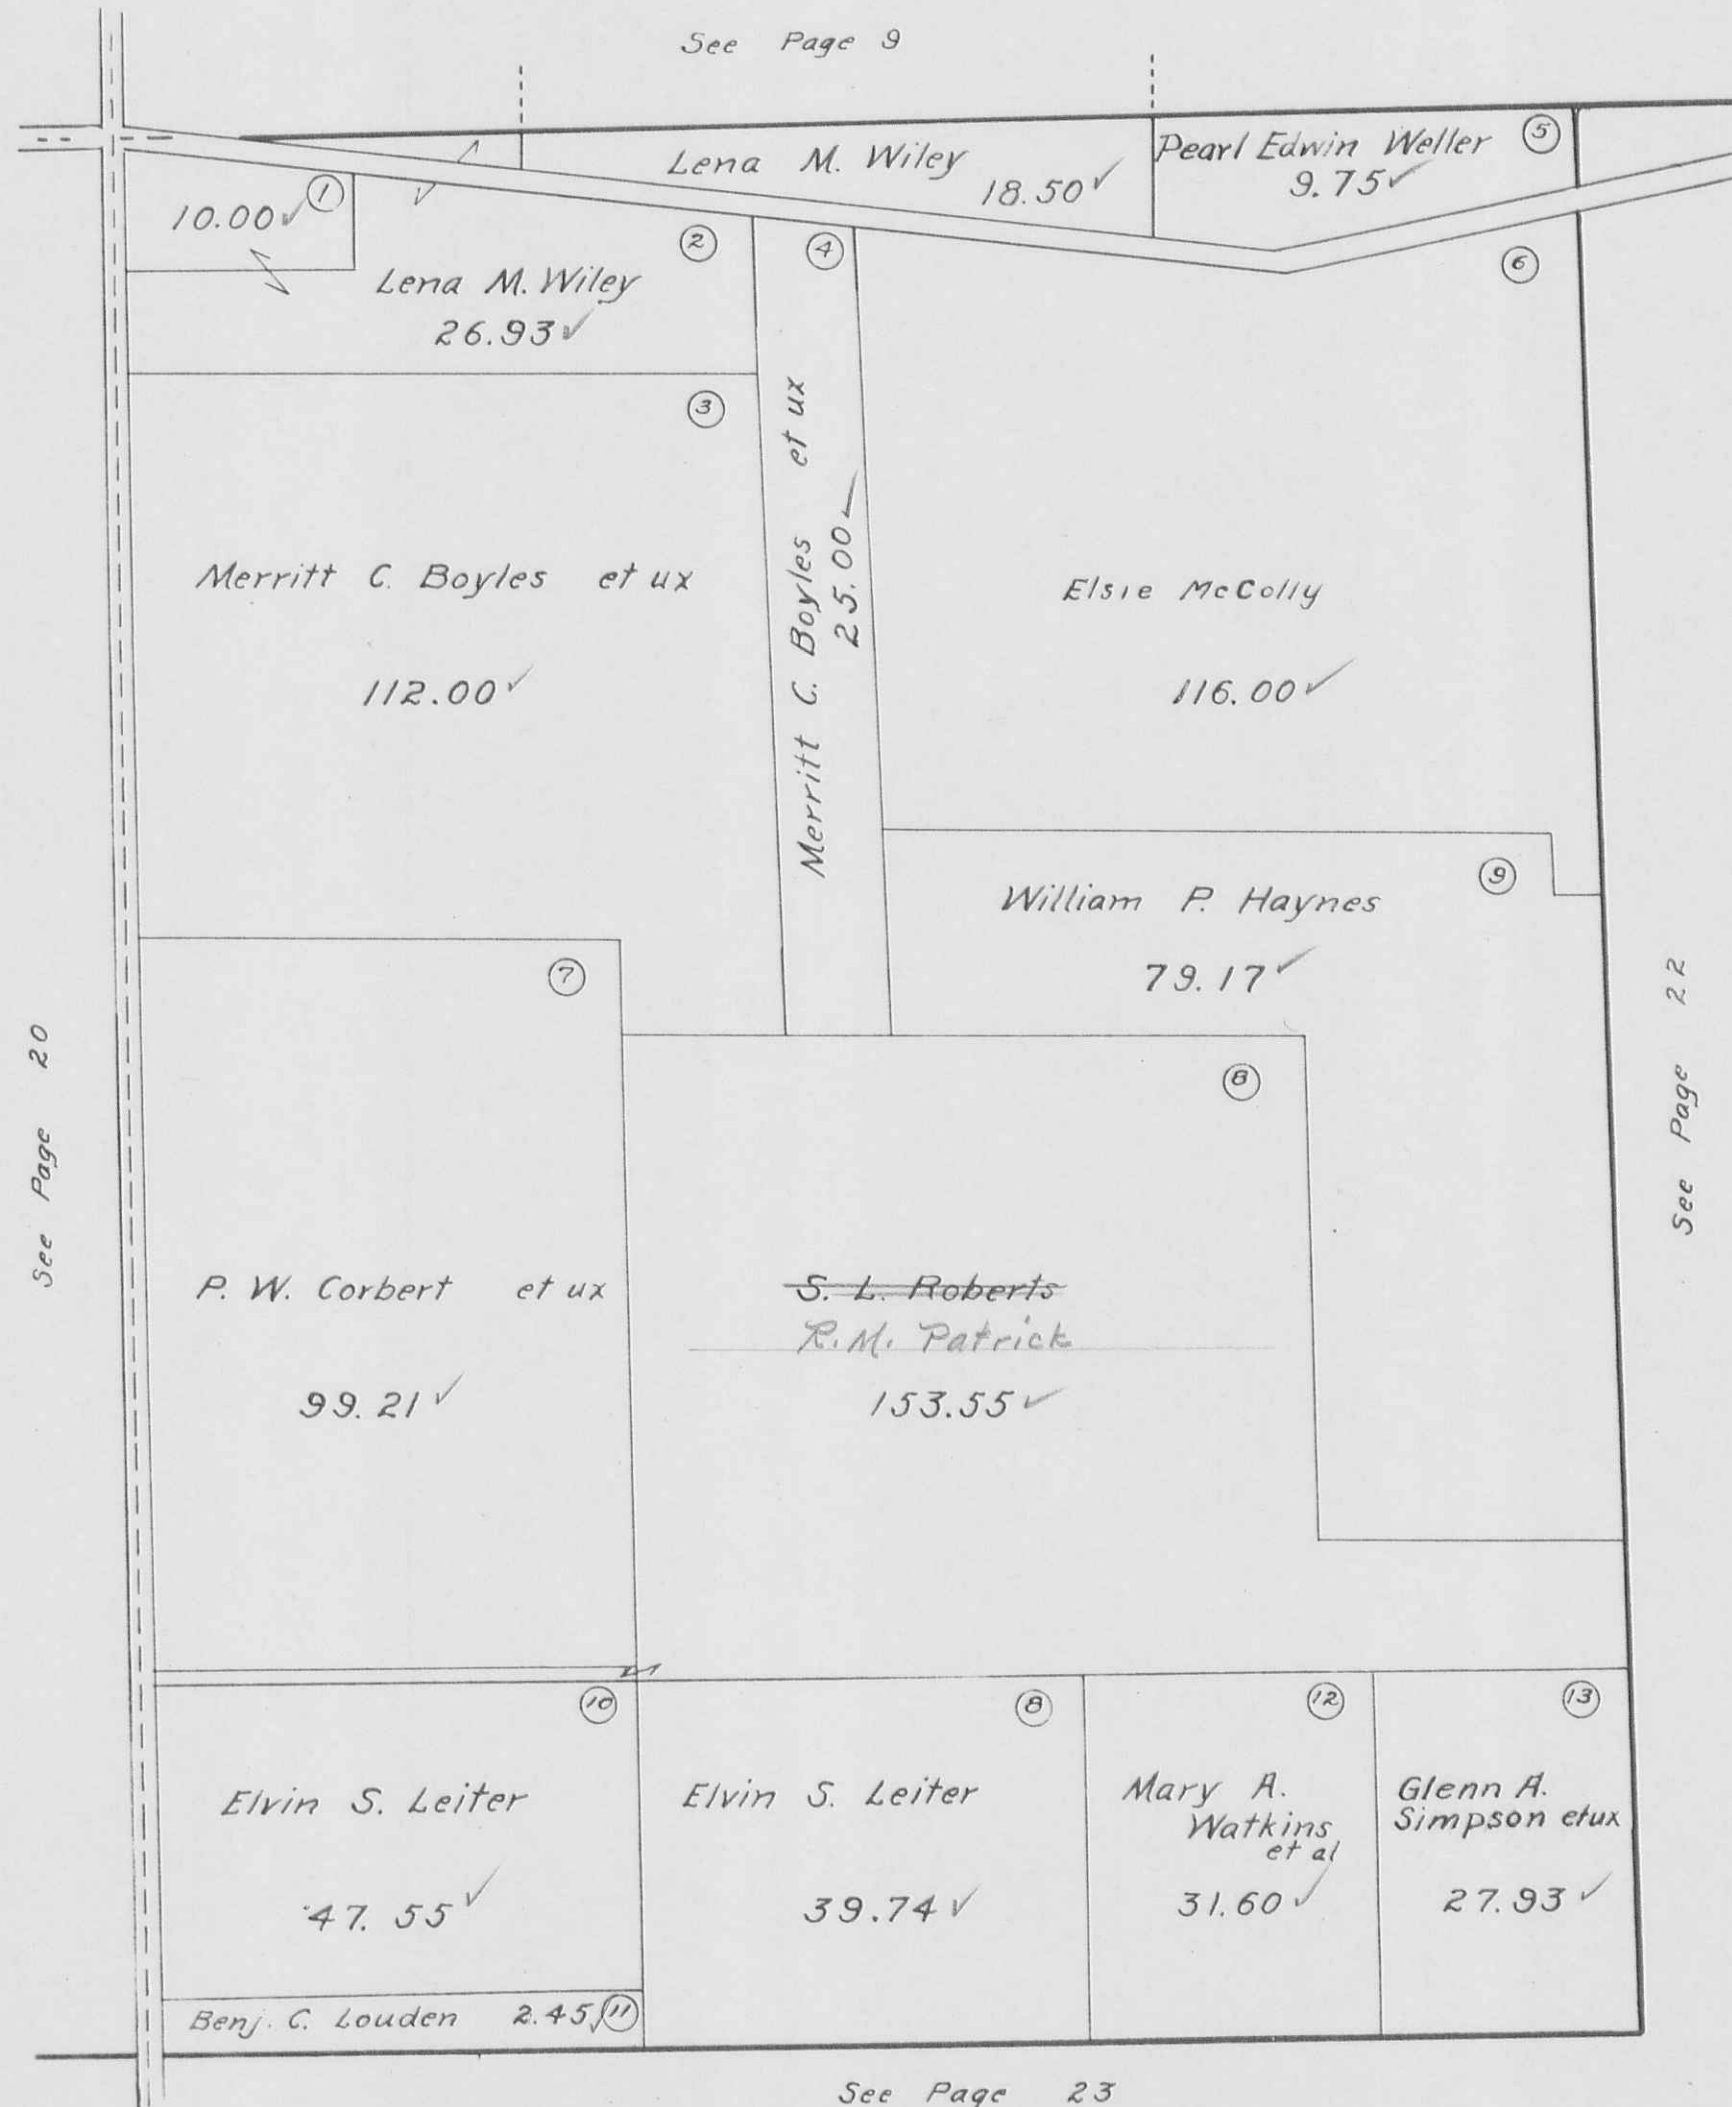

ZANE TOWNSHIP
VIRGINIA MILITARY SURVEYS

3163
3681
4880


SCALE 10 CHAINS TO THE INCH

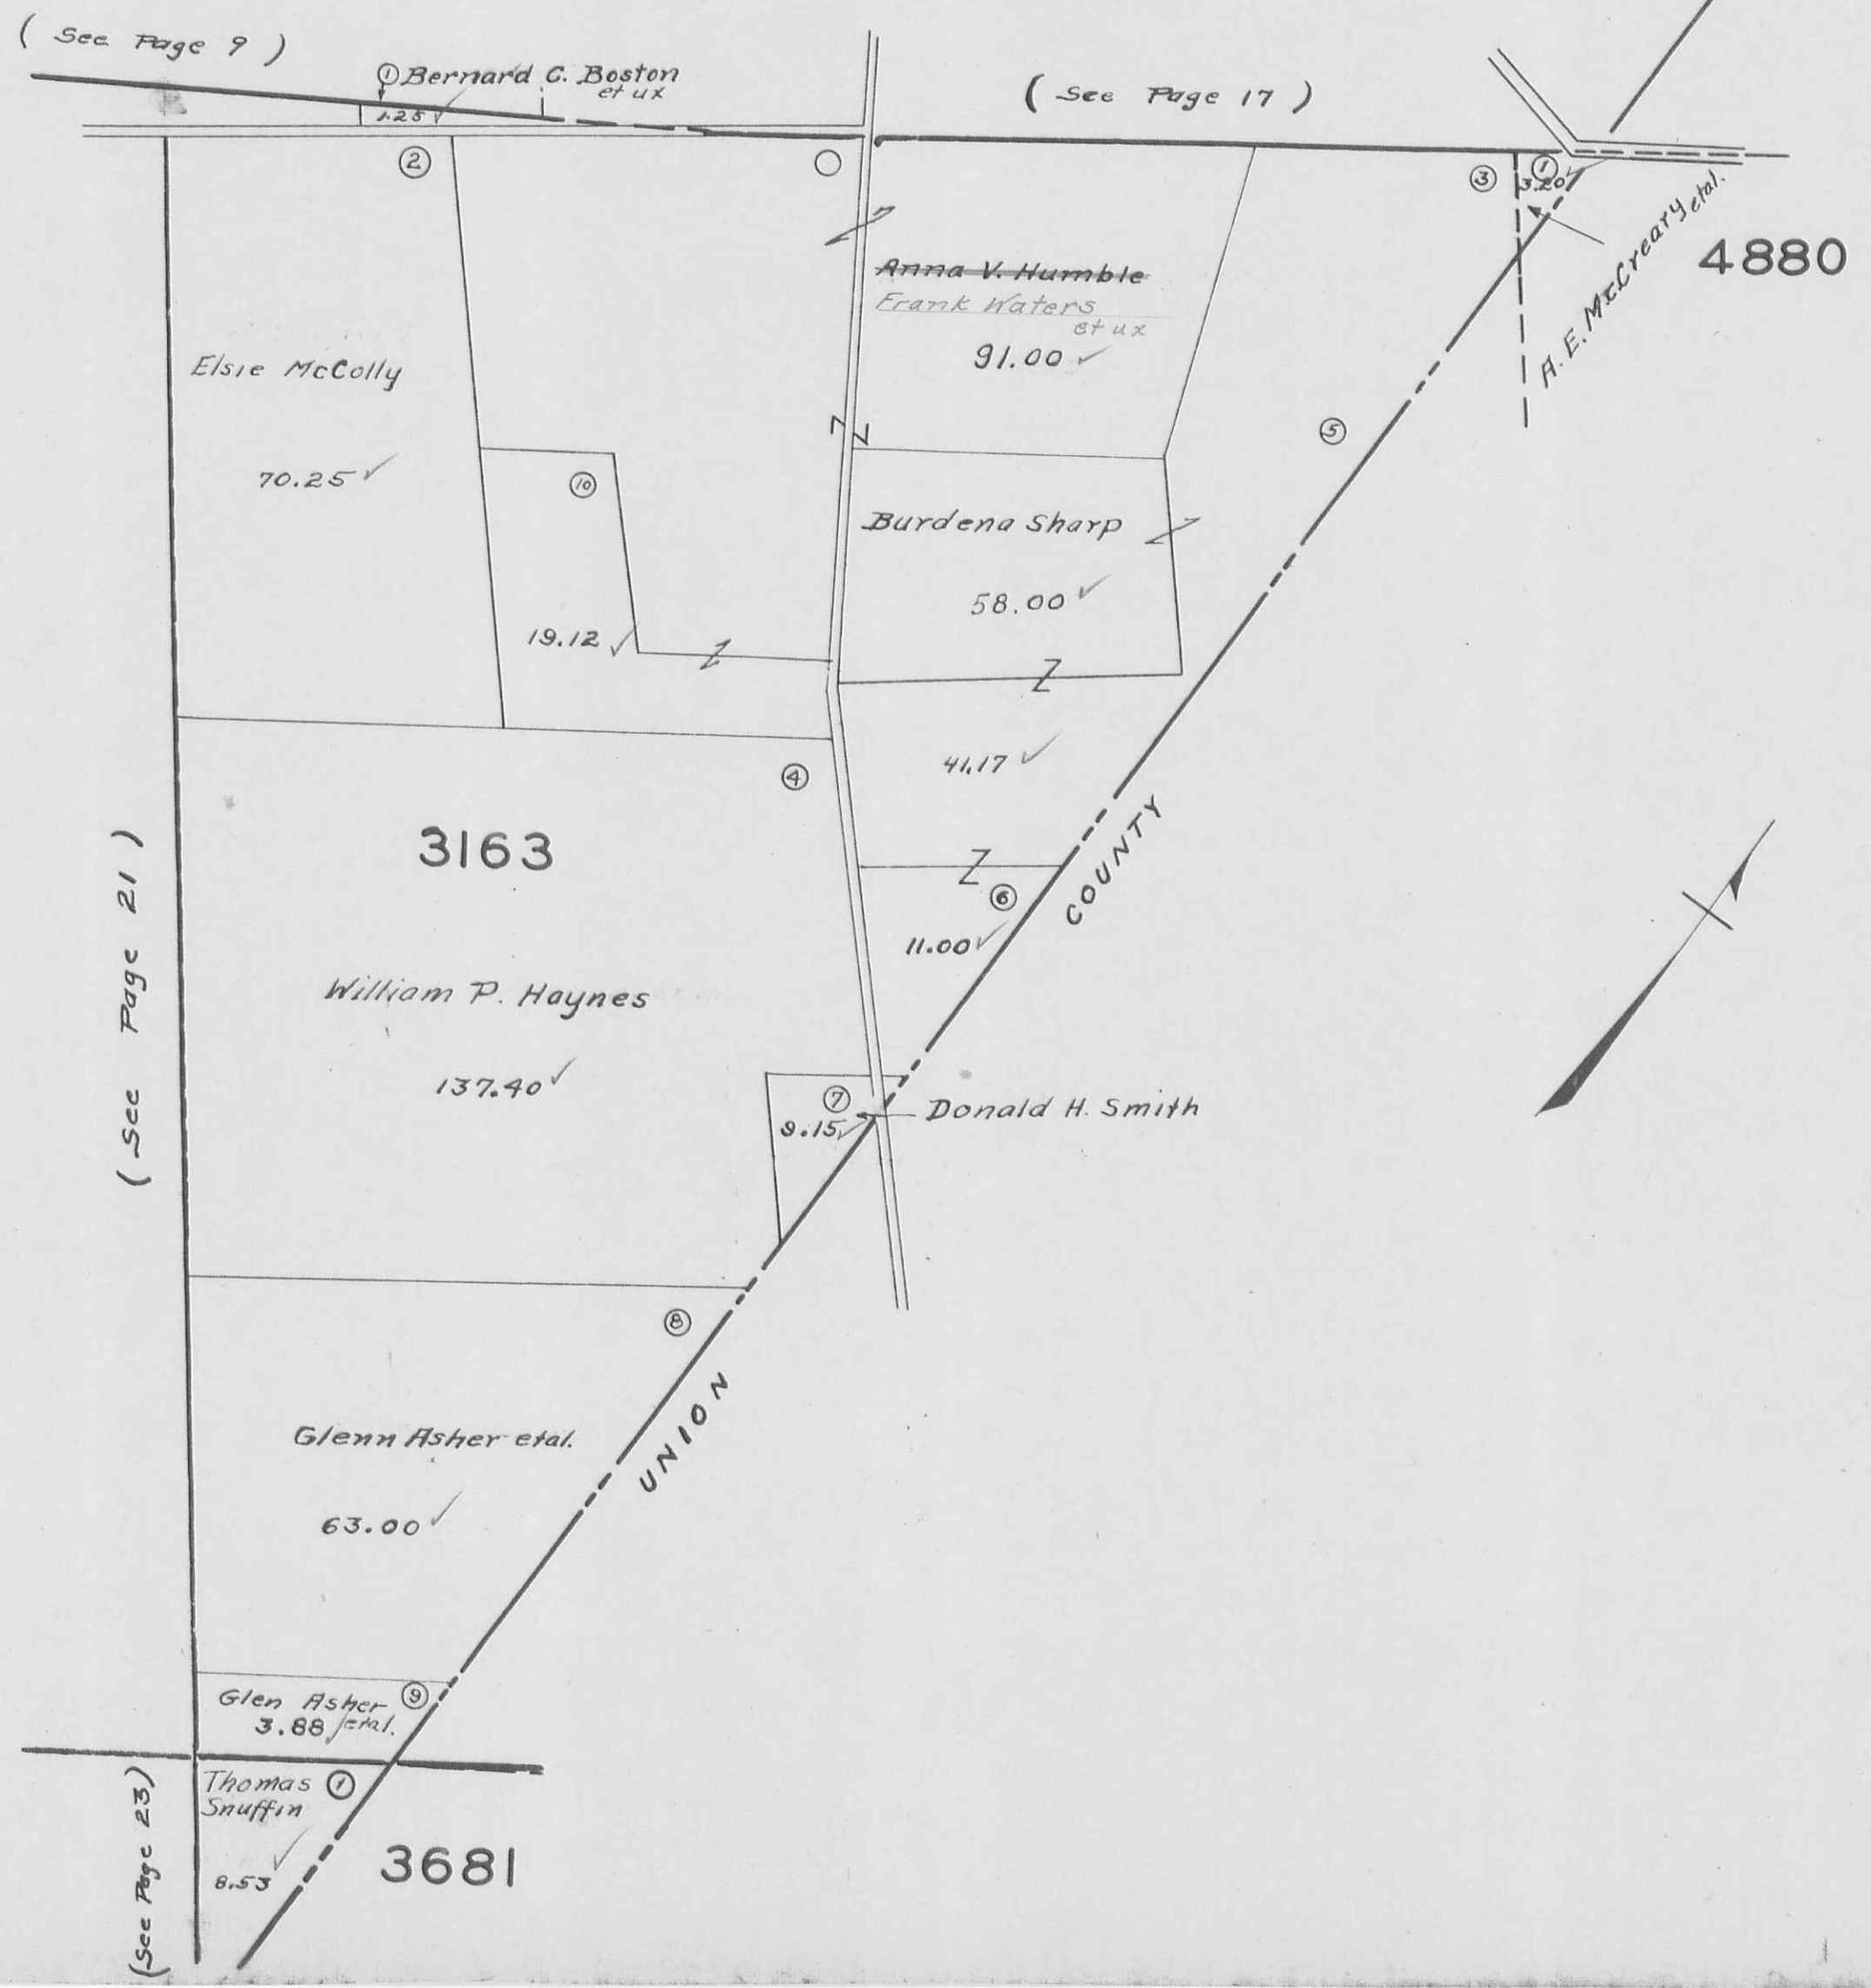

ZANE TOWNSHIP
VIRGINIA MILITARY SURVEYS

1502
4759
{4658
4678

SCALE 10 CHAINS TO THE INCH

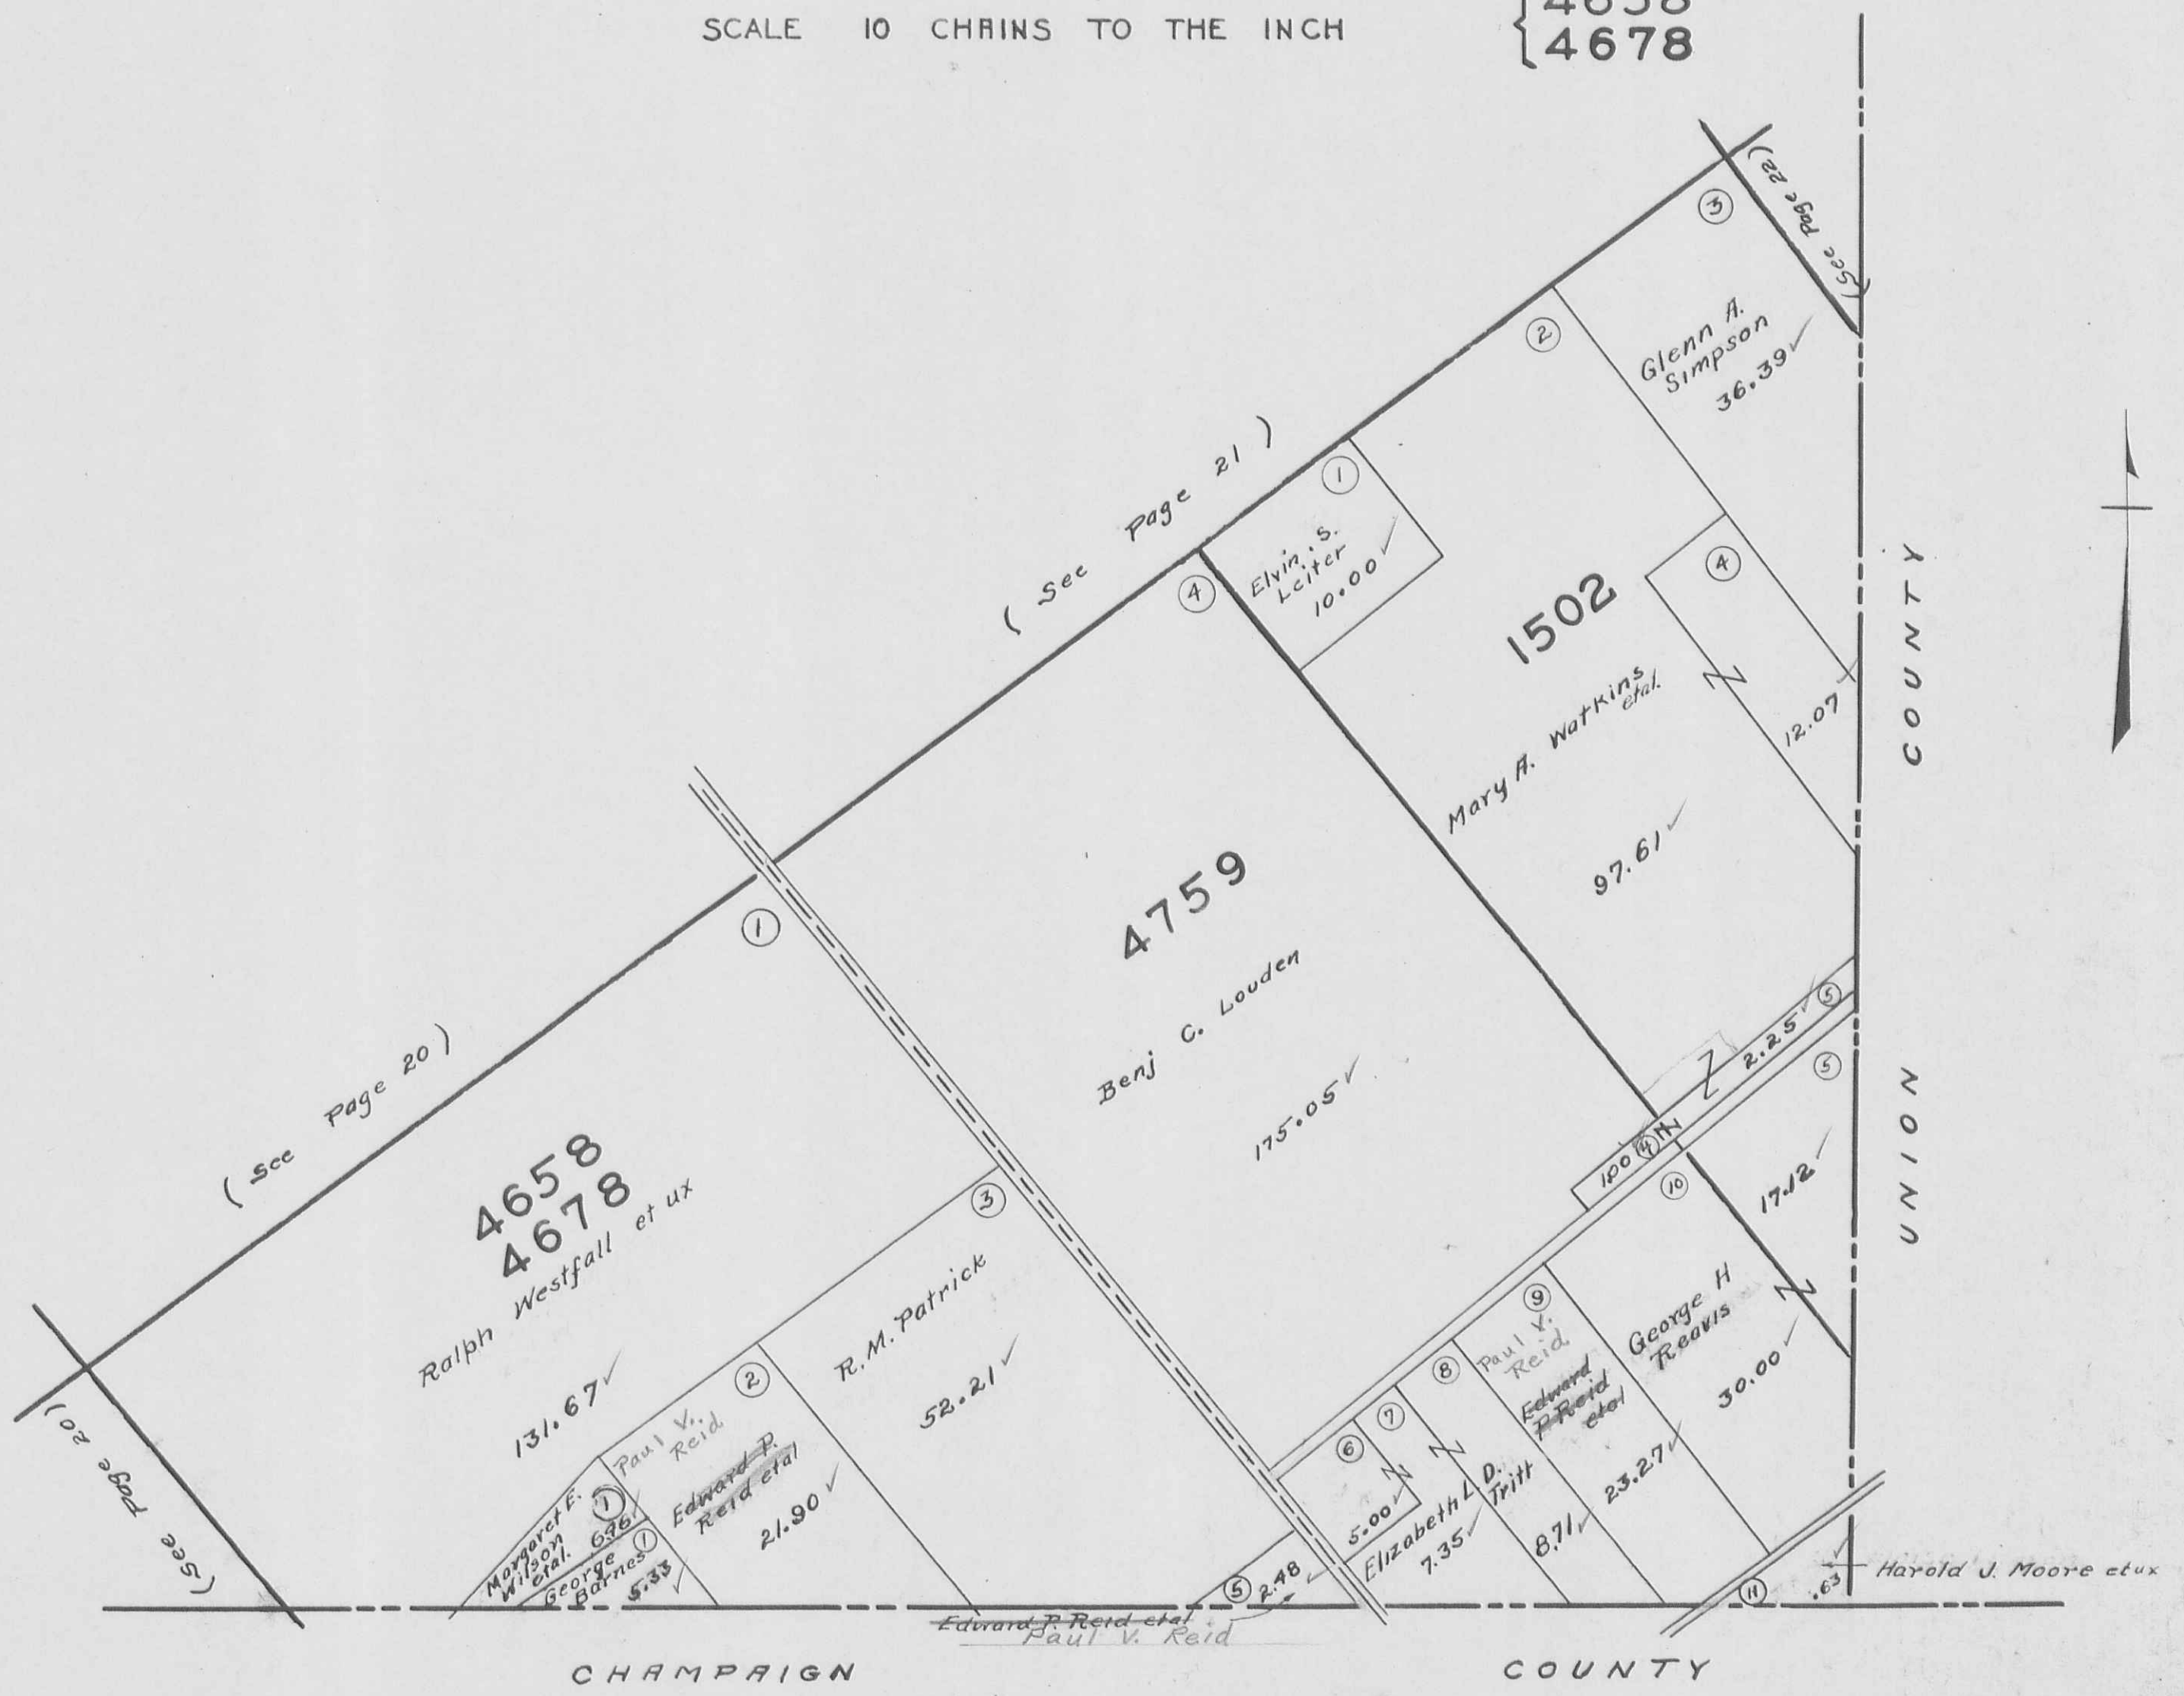

ZANE TOWNSHIP
 VIRGINIA MILITARY SURVEY 3155

MIDDLEBURG

SCALE 200 FEET TO THE INCH

(See Page 5)

(See Page 6)

V.M.S. 3753

V.M.S. 3154

V.M.S. 3680

V.M.S. 3155

Frank Norviel

John C. Losey


James Teets et ux

2.45

.50

3.51

15.46

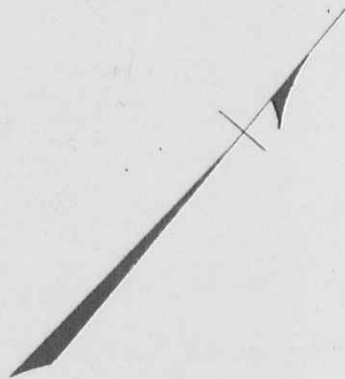

(See Page 8)

John C. Losey

Bertha V. Miller

V.M.S. 3680

V.M.S. 3155

WESTERN STREET

STREET

STREET

STREET

WATER STREET

URBANA STREET

STREET

COLUMBUS STREET

STREET


NORTH STREET

GREEN STREET

STREET

(See Page 26)


(See Page 25)

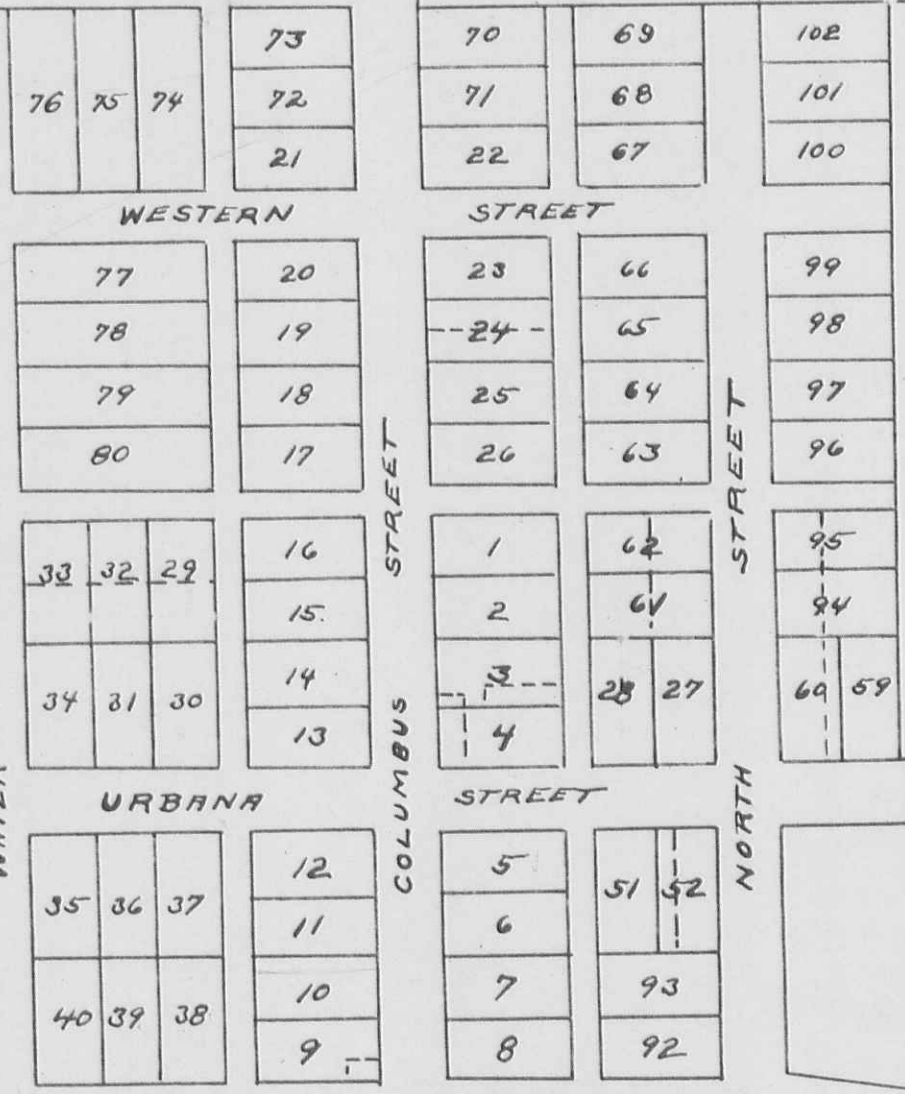

ZANE TOWNSHIP
VIRGINIA MILITARY SURVEY 3155

MIDDLEBURG

(See Page 24) SCALE 200 FEET TO THE INCH

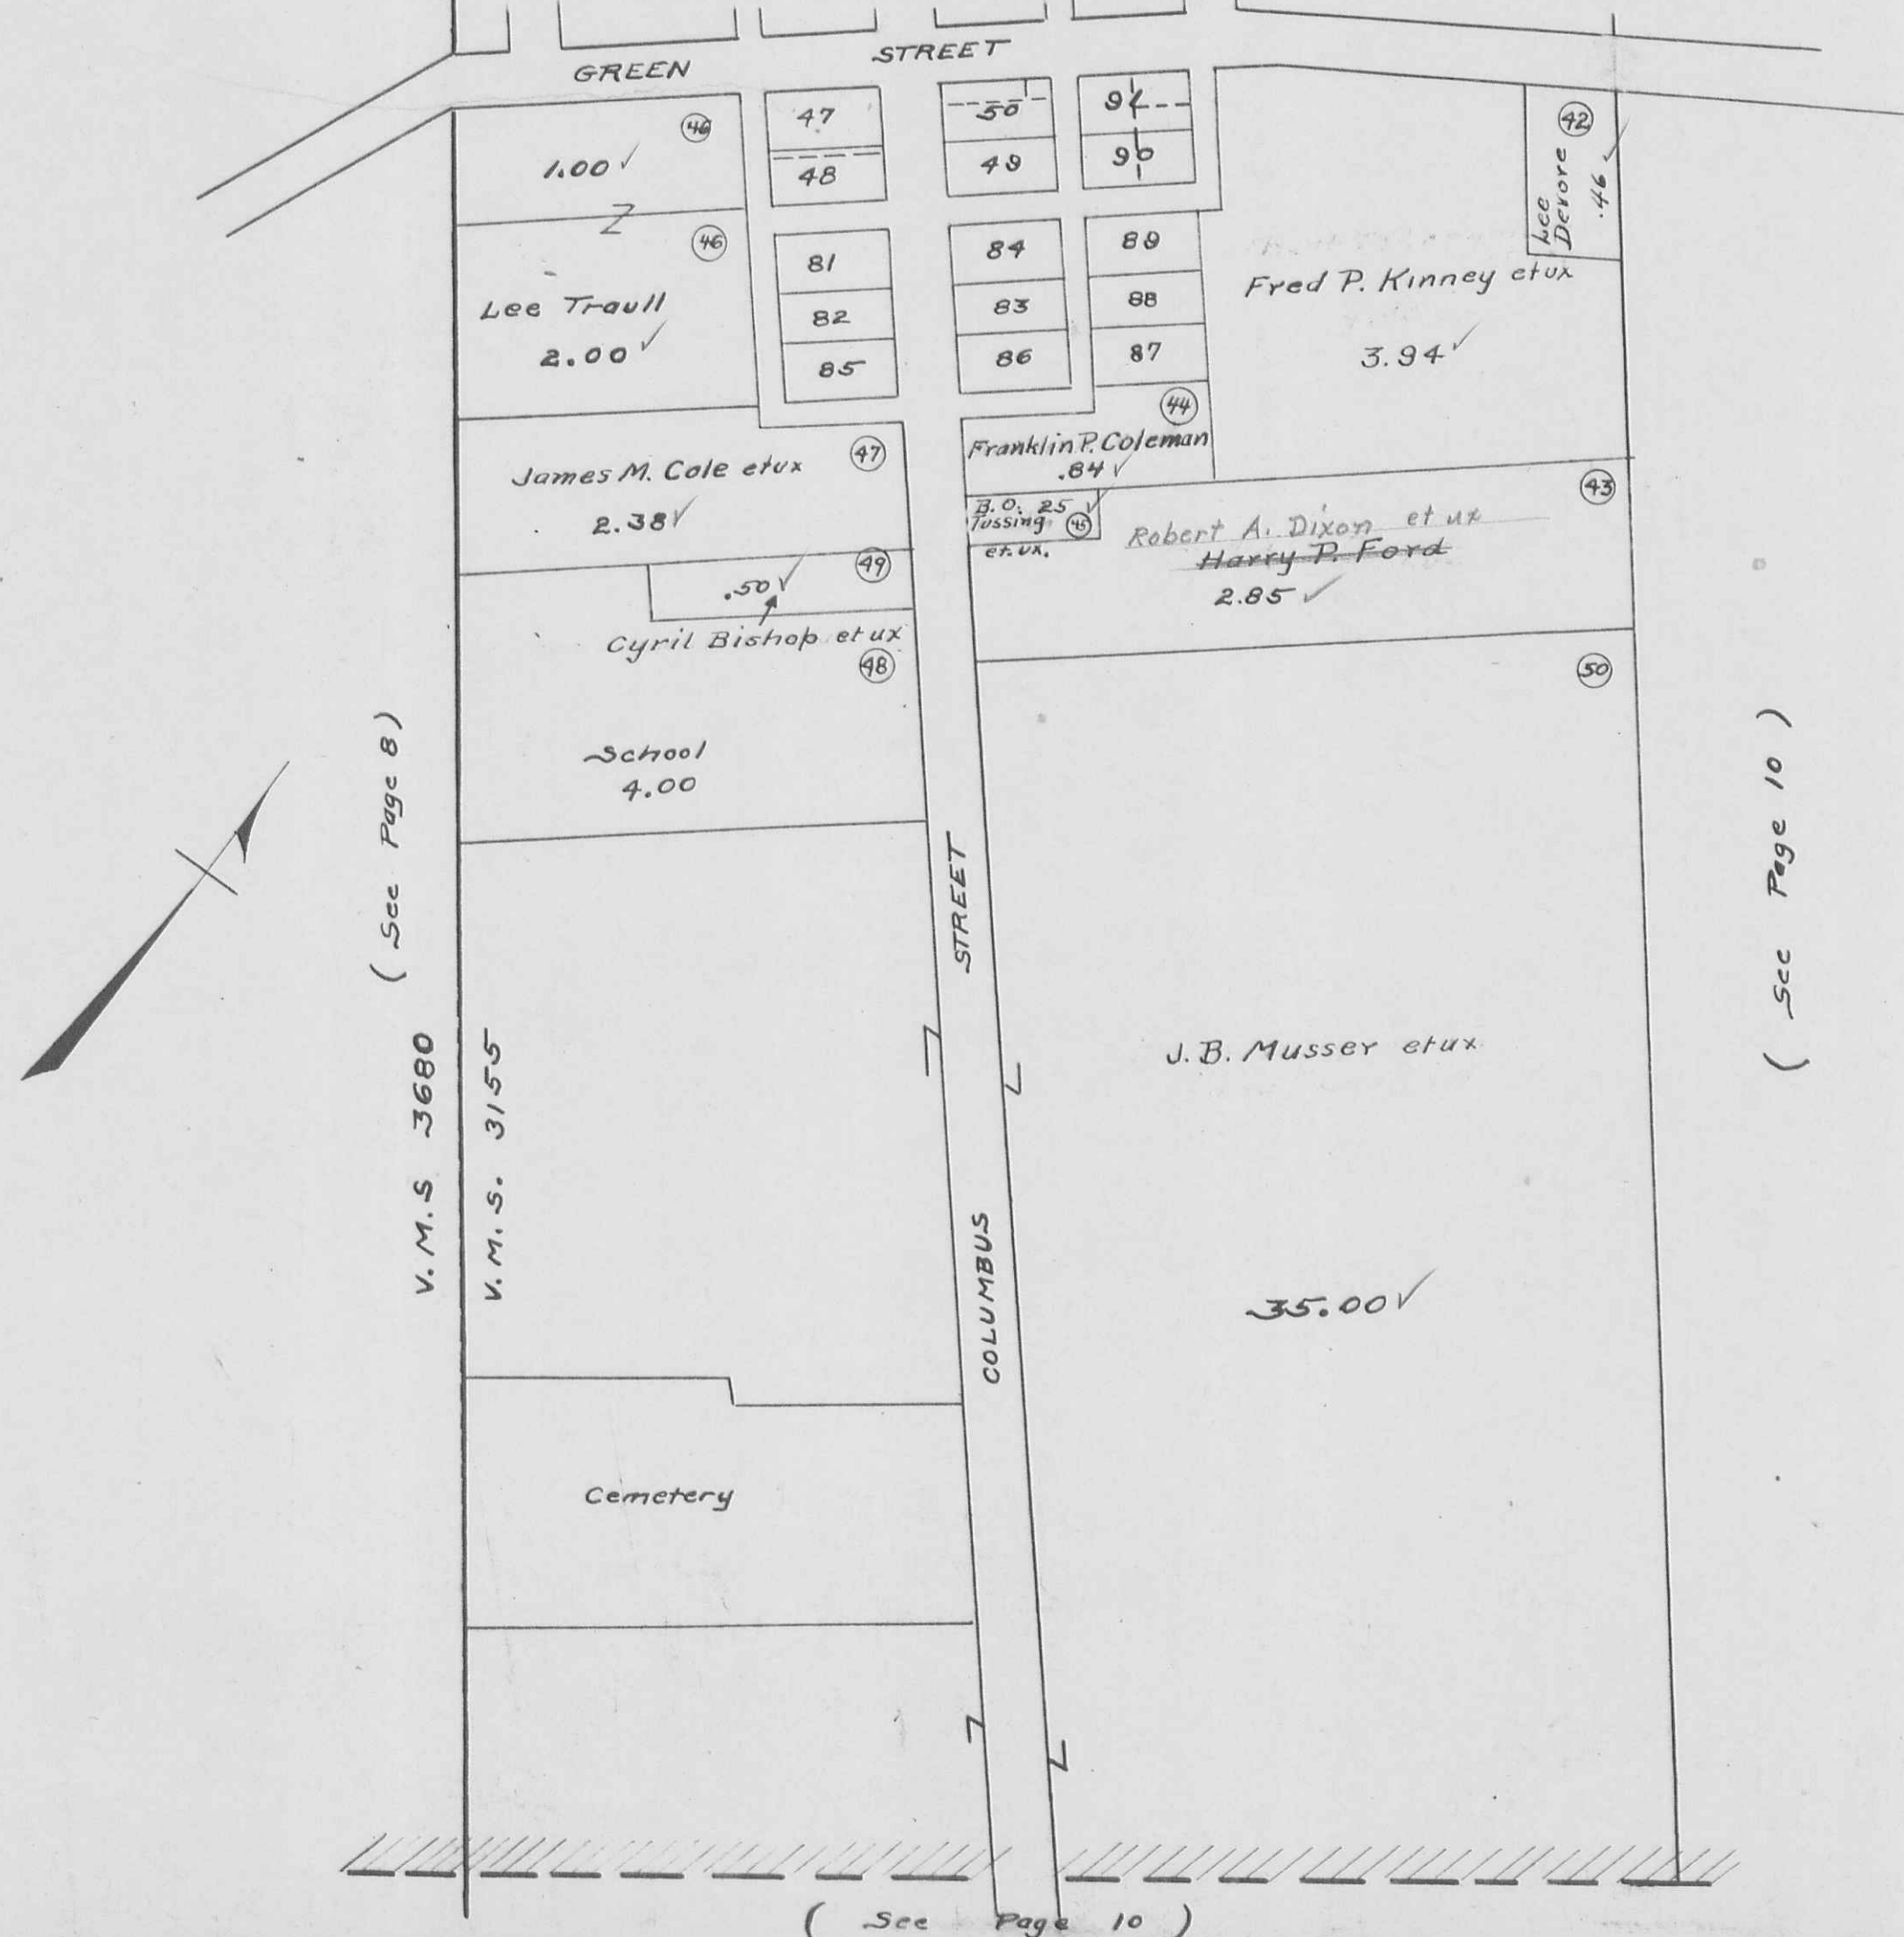

(See Page 8)

V.M.S. 3680

V.M.S. 3155

COLUMBUS STREET

GREEN STREET


STREET

(See Page 10)

(See Page 10)

ZANE TOWNSHIP
 VIRGINIA MILITARY SURVEY 3155
 MIDDLEBURG

SCALE 200 FEET TO THE INCH

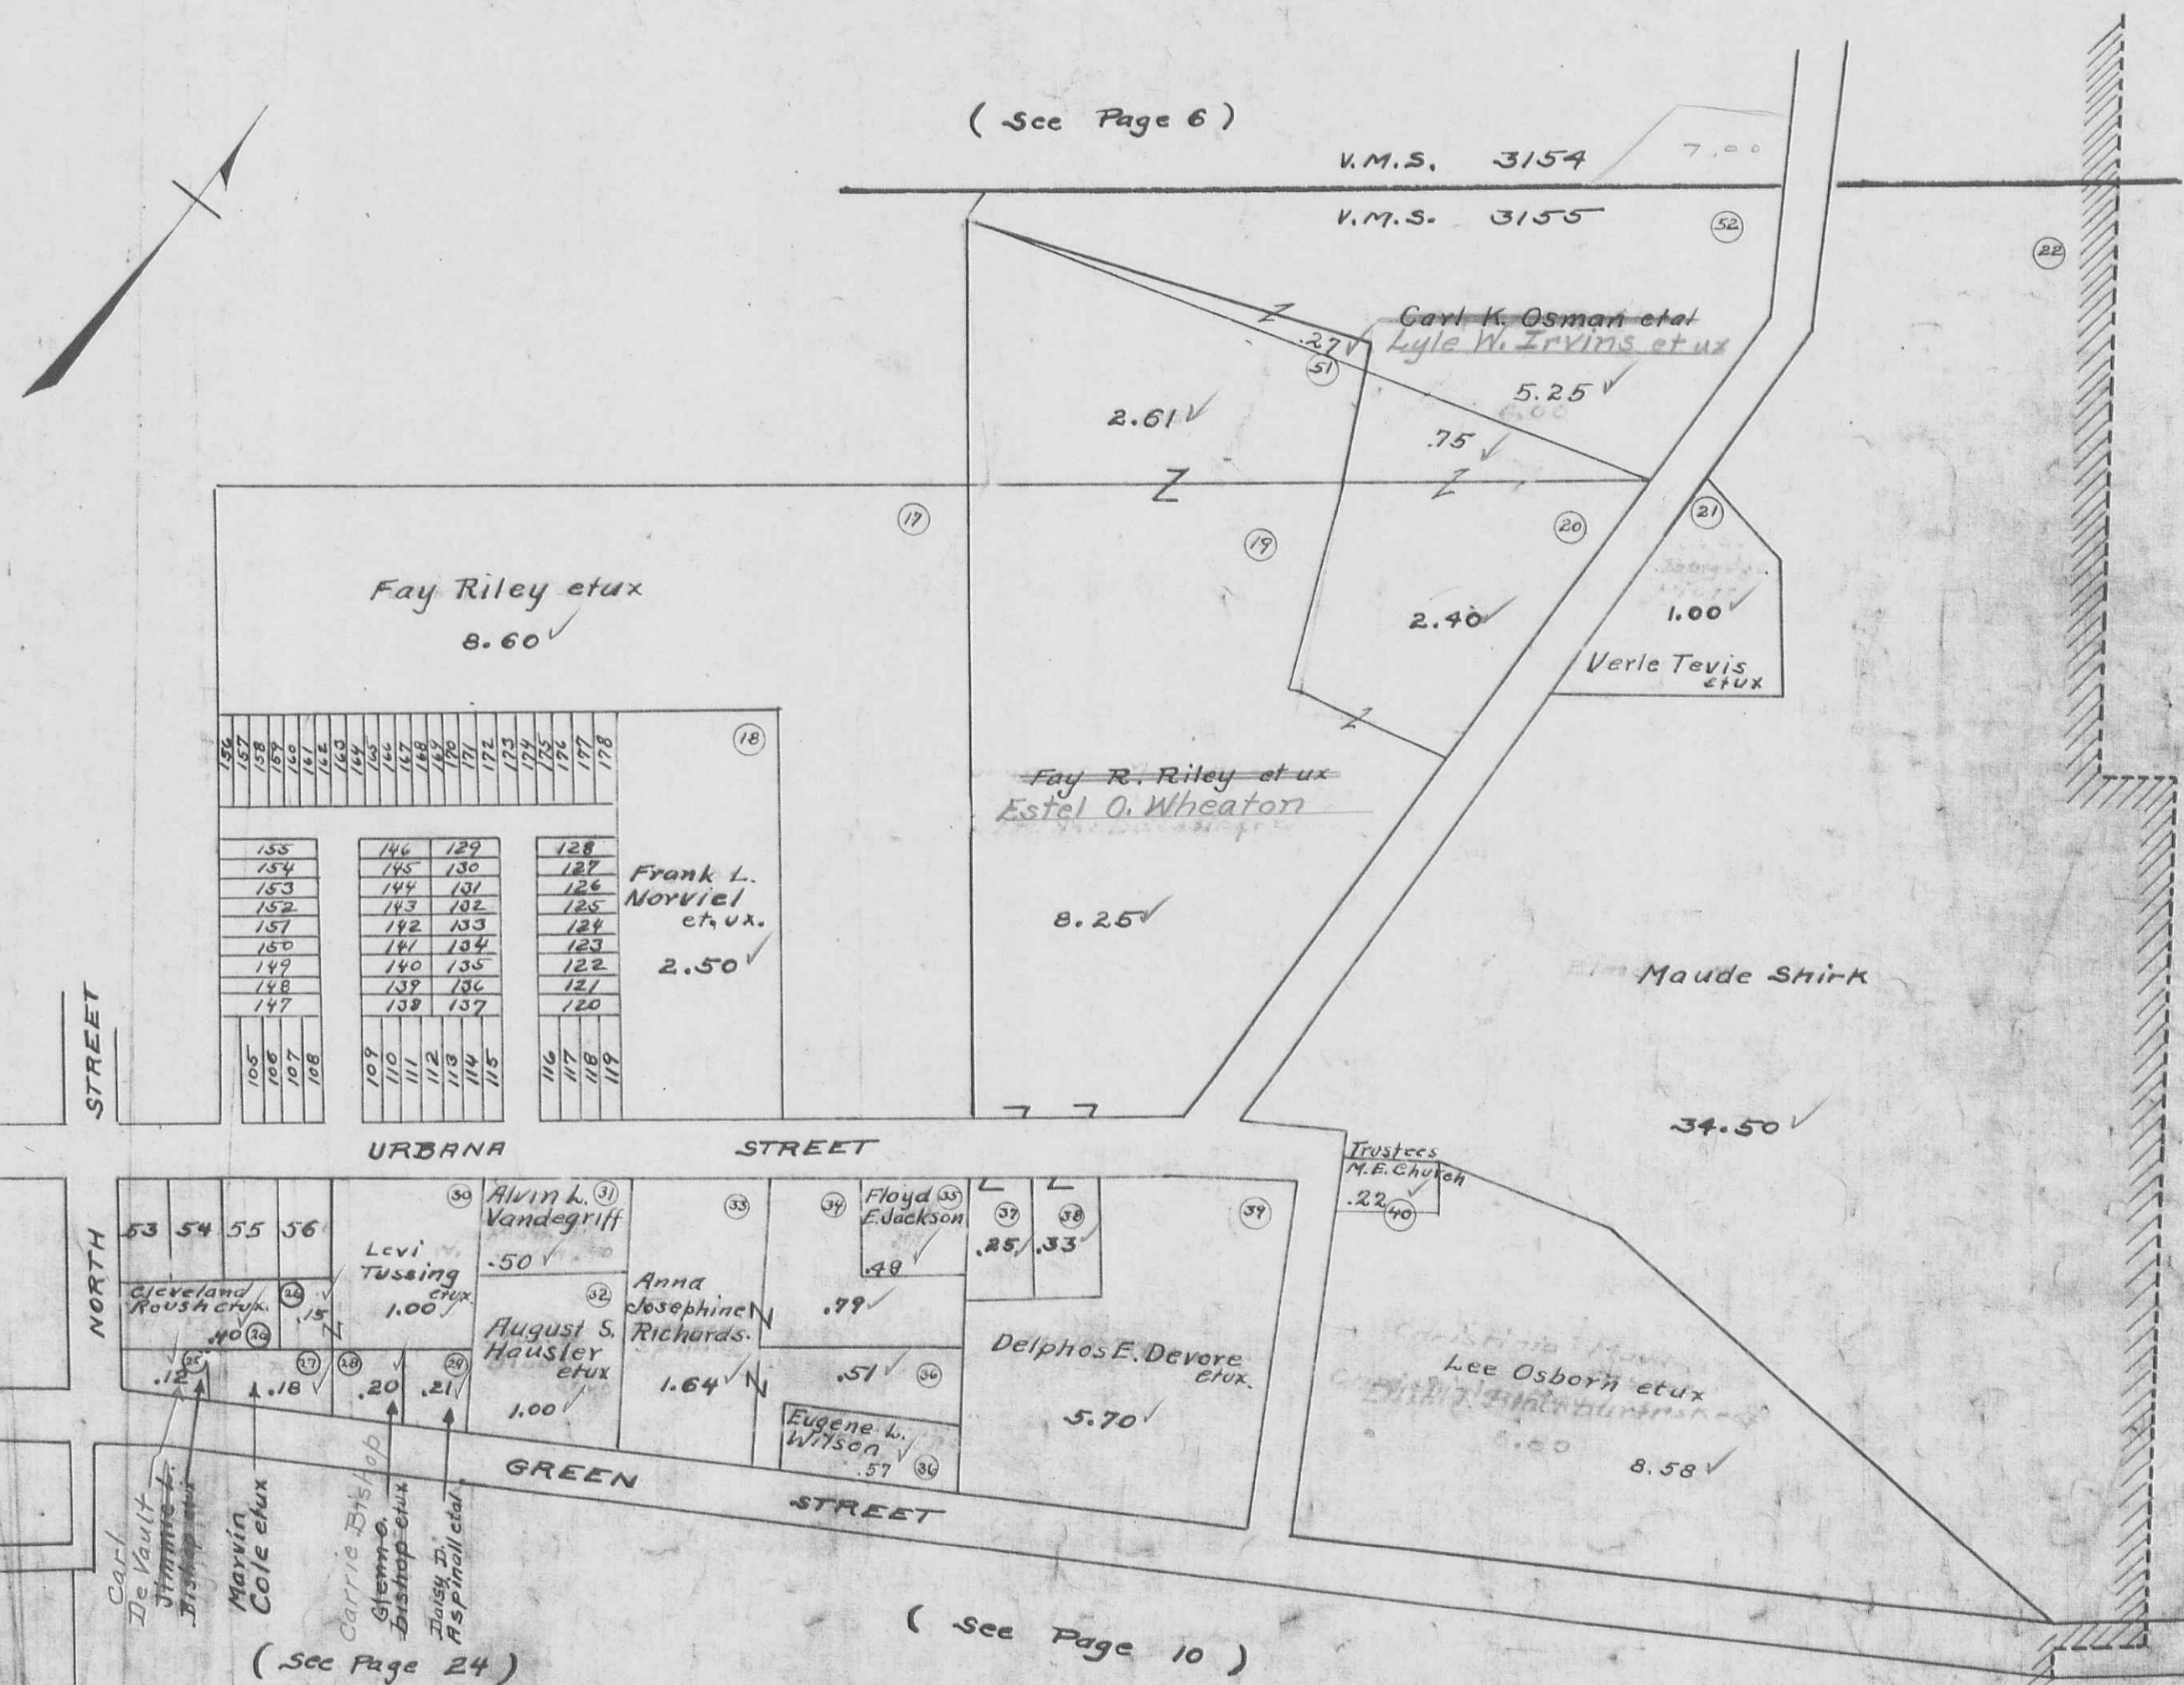

(See Page 24)

(See Page 10)

(See Page 24)

(See Page 10)