

UNION

TOWNSHIP

1966

INDEX

SECTION TOWN RANGE PAGE

1	3	4	8
2	3	4	4
7	3	4	8
8	3	4	4
13	3	4	7
14	3	4	3
19	3	4	6
20	3	4	2
25	3	4	5
26	3	4	1
4	4	3	20
5	4	3	16
6	4	3	12
10	4	3	20
11	4	3	16
12	4	3	12
16	4	3	19
17	4	3	15
18	4	3	11
22	4	3	18
23	4	3	14
24	4	3	10
28	4	3	17
29	4	3	13
30	4	3	9

BETWEEN THE MIAMI  
RIVERS SURVEY

# UNION TOWNSHIP

## INDEX MAP

SECTION - TOWN - RANGE

Scale: 40 Chains to the Inch

PAGE 0

CORRECTED TO

~~January 1, 1966~~

~~JANUARY 1, 1967~~

JANUARY 1, 1968

JANUARY 1, 1969

		HARRISON TOWNSHIP				
TOWNSHIP	26-3-14 PAGE 1	20-3-14 PAGE 2	14-3-14 PAGE 3	8-3-14 PAGE 4	2-3-14 PAGE 4	
	25-3-14 PAGE 5	19-3-14 PAGE 6	13-3-14 PAGE 7	7-3-14 PAGE 8	1-3-14 PAGE 8	
TOWNSHIP	30-4-13 PAGE 9	24-4-13 PAGE 10	18-4-13 PAGE 11	12-4-13 PAGE 12	6-4-13 PAGE 12	
	29-4-13 PAGE 13	23-4-13 PAGE 14	17-4-13 PAGE 15	11-4-13 PAGE 16	5-4-13 PAGE 16	
MIAMI	28-4-13 PAGE 17	22-4-13 PAGE 18	16-4-13 PAGE 19	10-4-13 PAGE 20	4-4-13 PAGE 20	

TOWNSHIP

LIBERTY




CHAMPAIGN

COUNTY


UNION TOWNSHIP  
SECTION 26 TOWN 3 RANGE 14

SCALE 10 CHAINS TO THE INCH

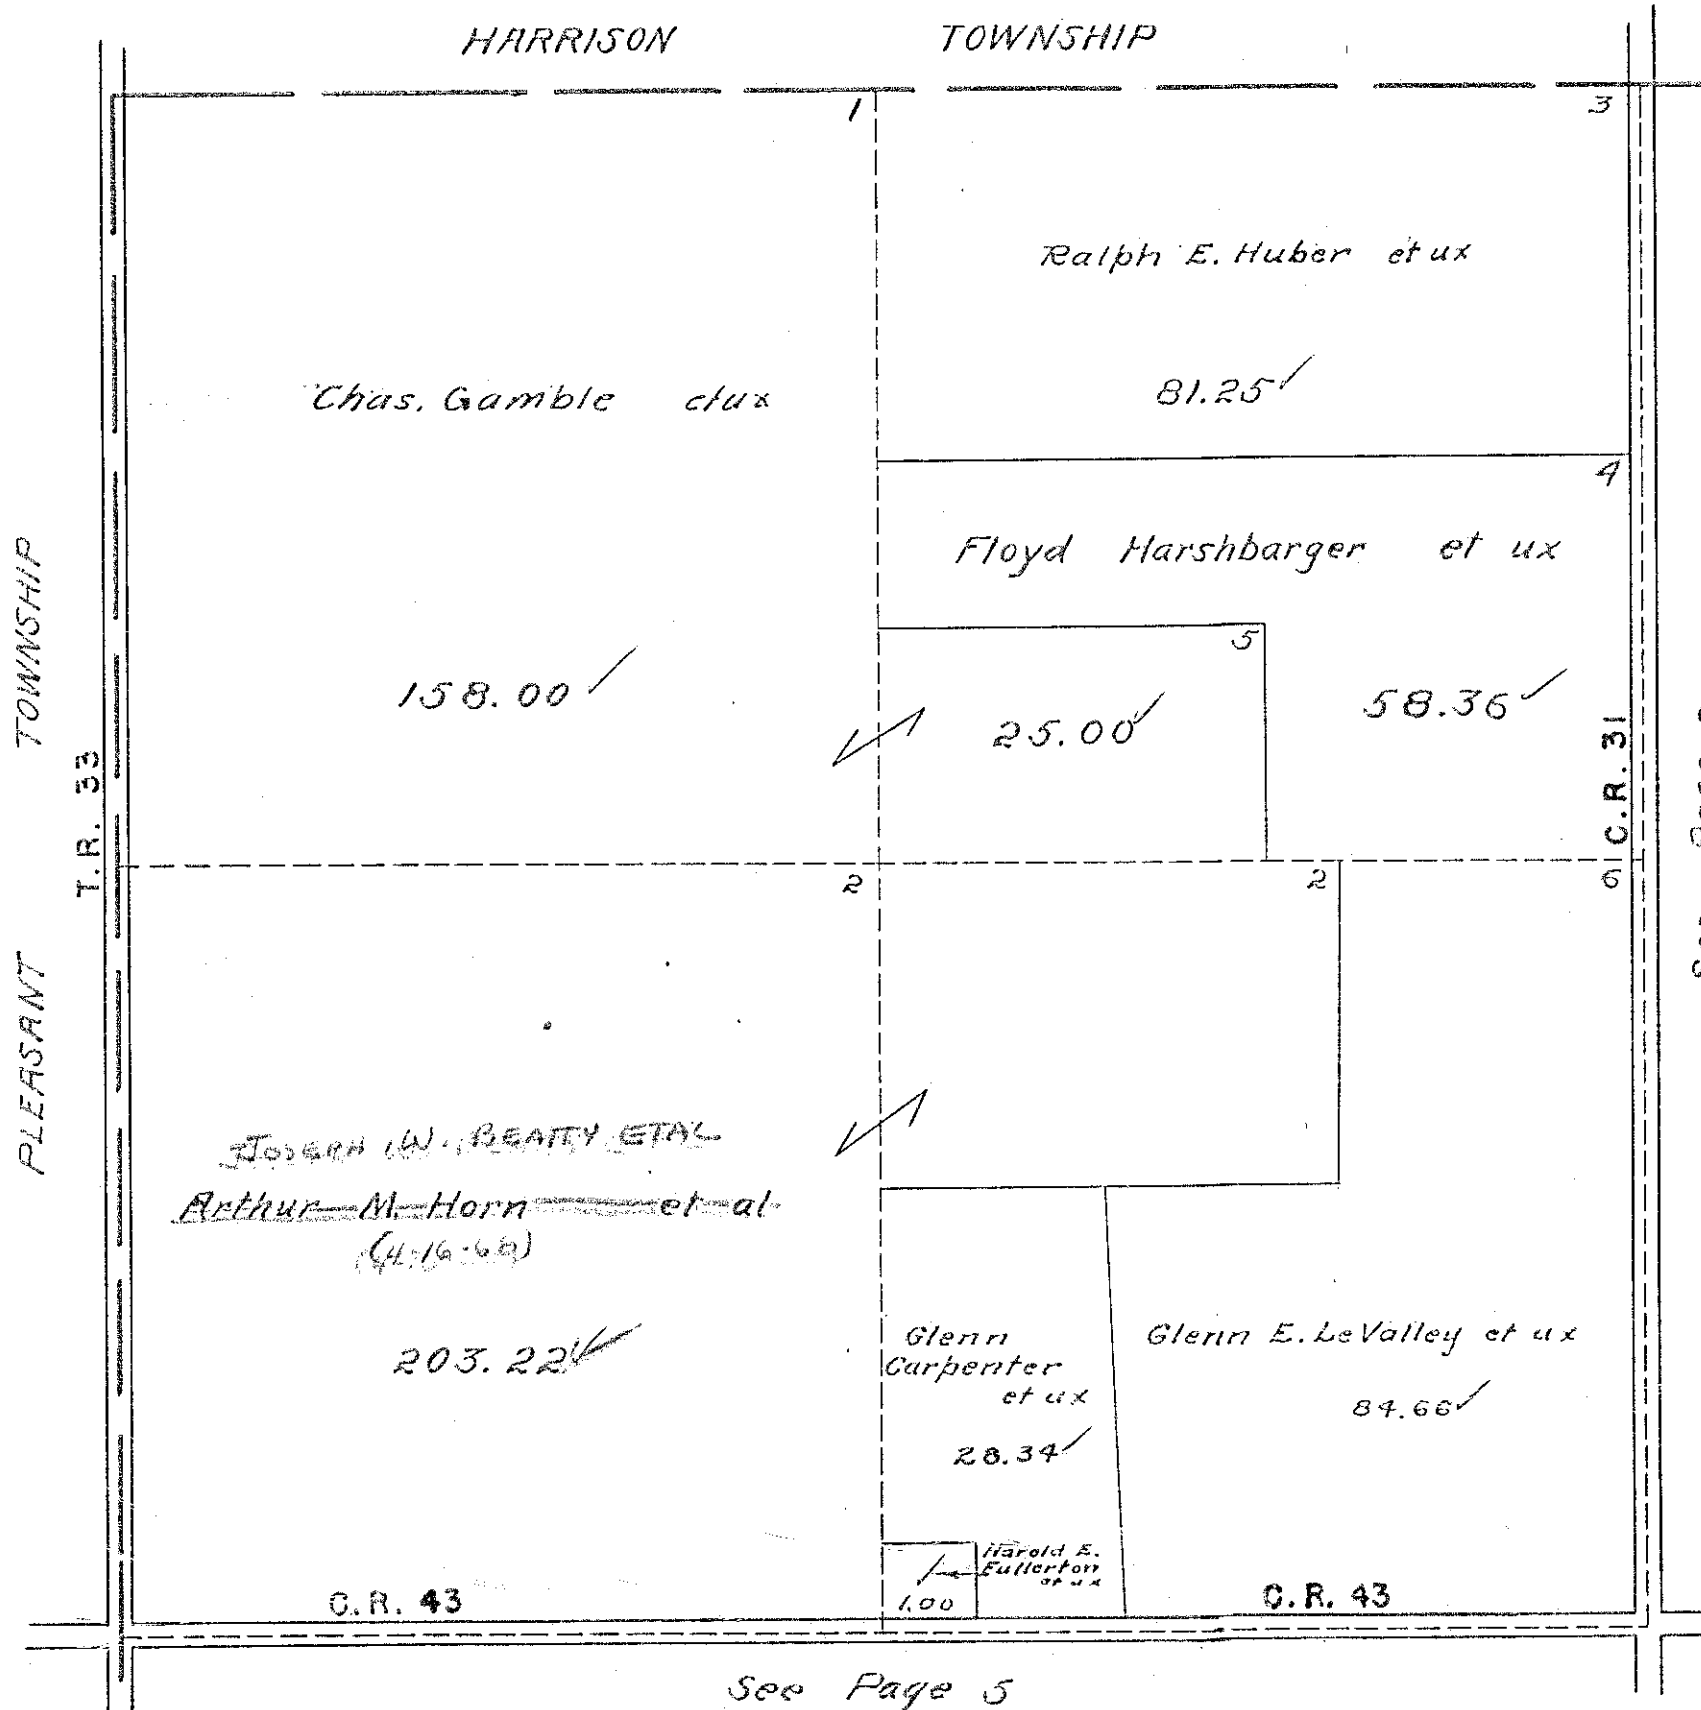


UNION TOWNSHIP  
SECTION 20 TOWN 3 RANGE 14

SCALE 10 CHAINS TO THE INCH

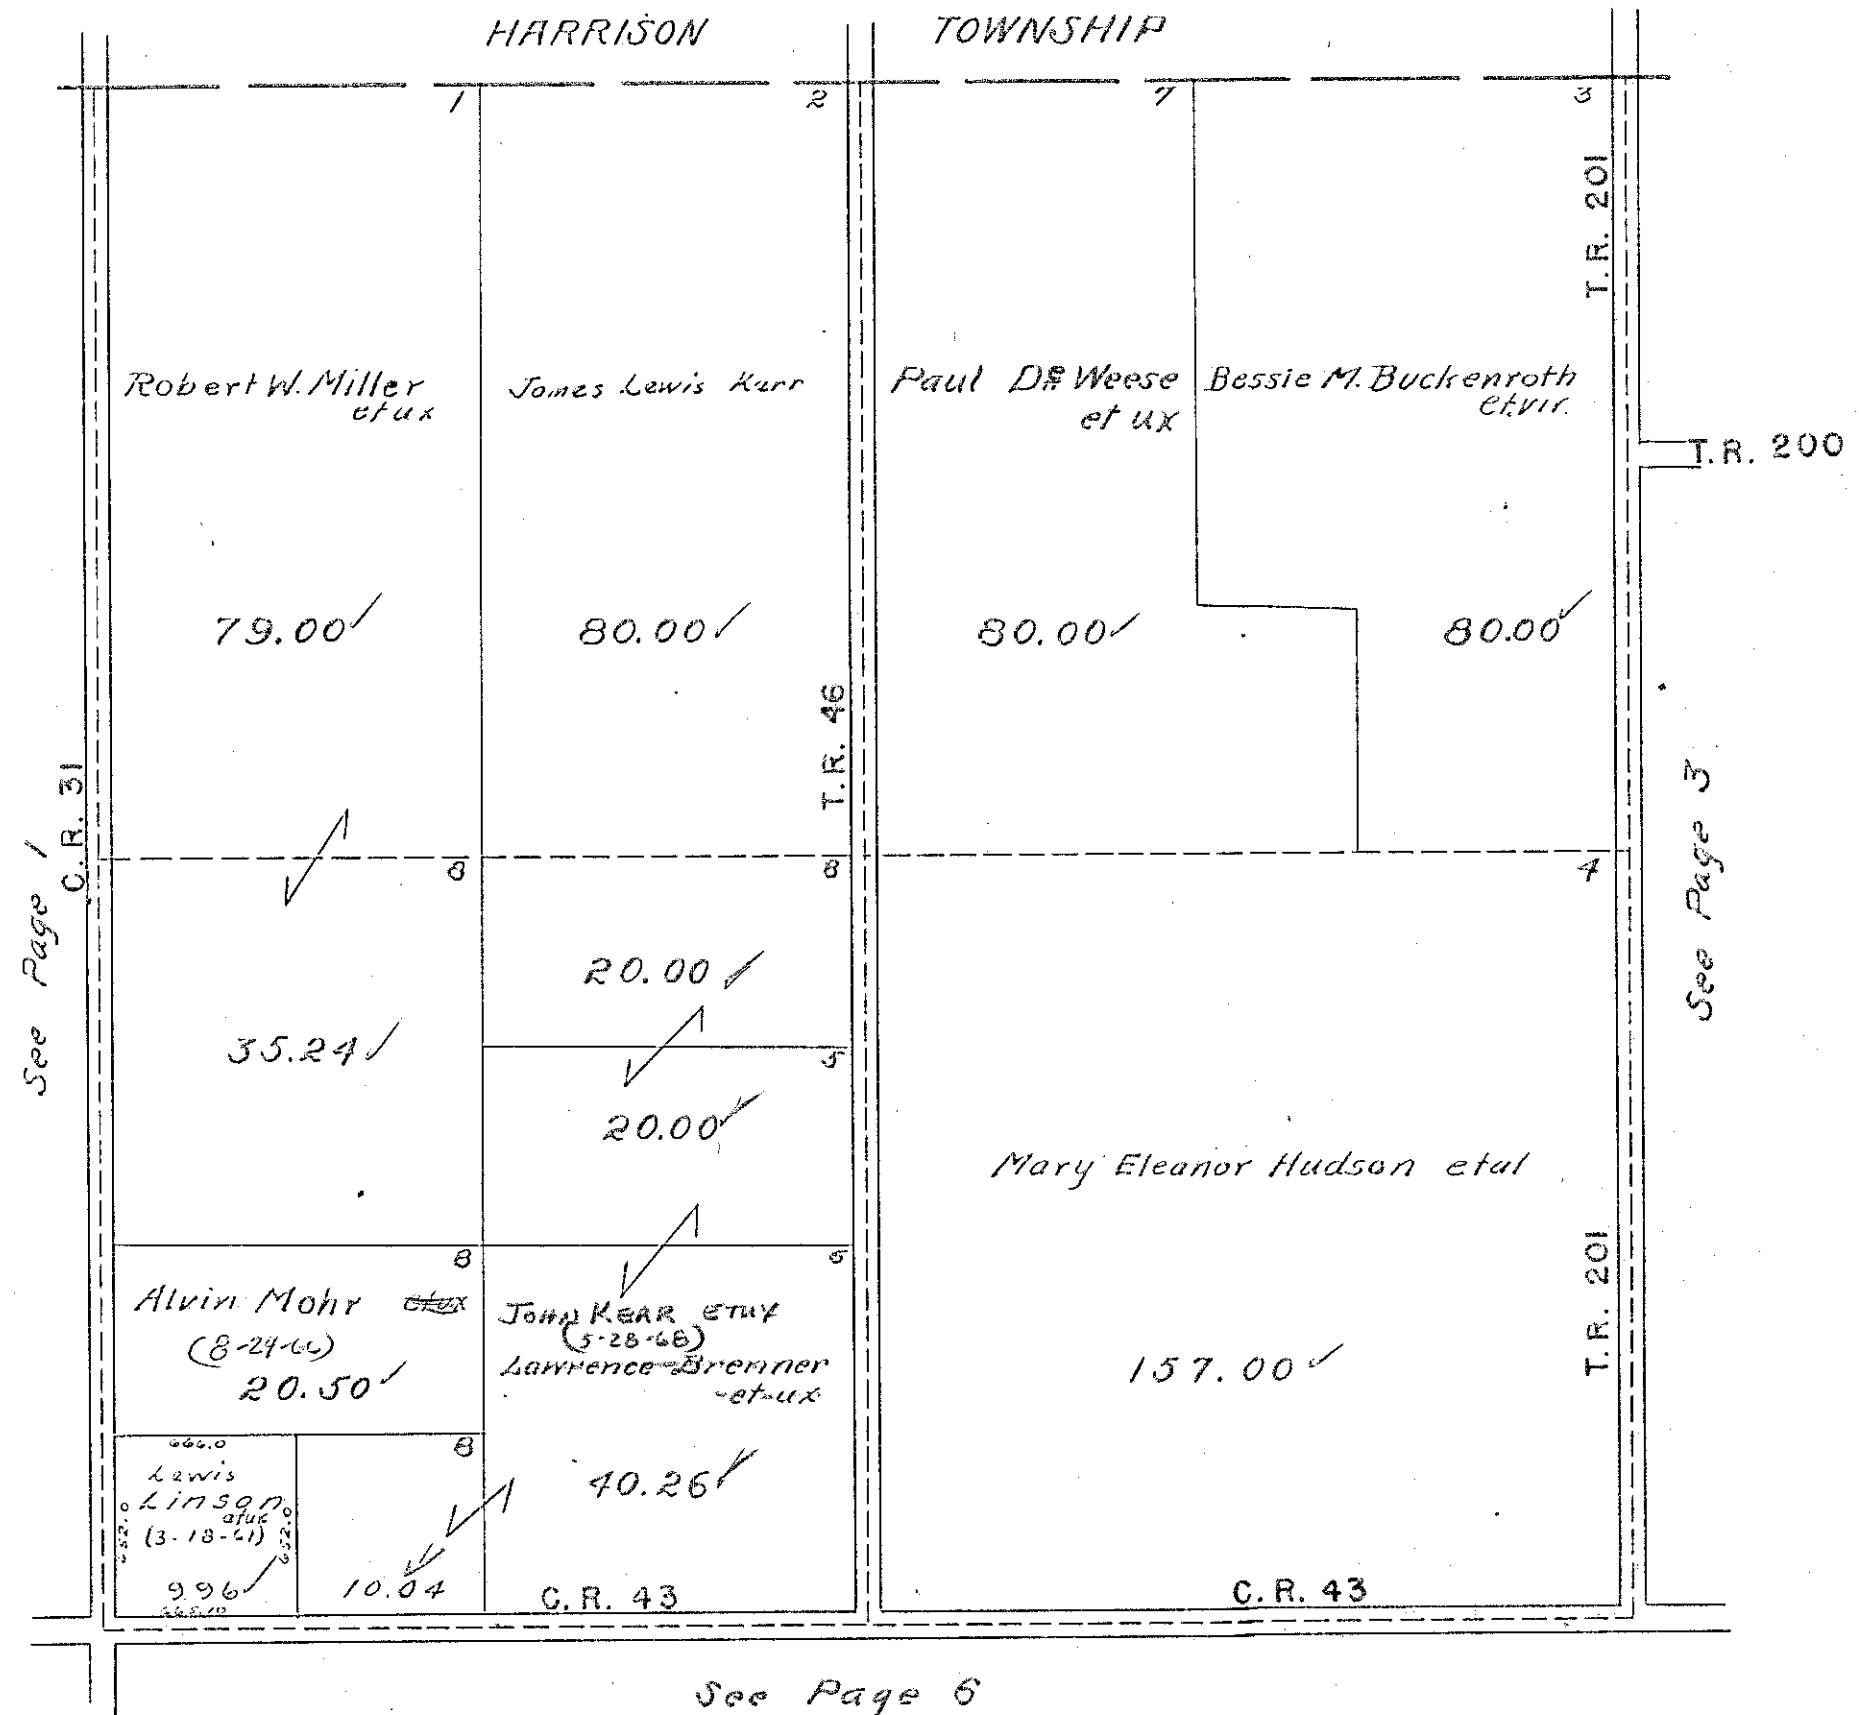

UNION TOWNSHIP  
SECTION 14 TOWN 3 RANGE 14

SCALE 10 CHAINS TO THE INCH

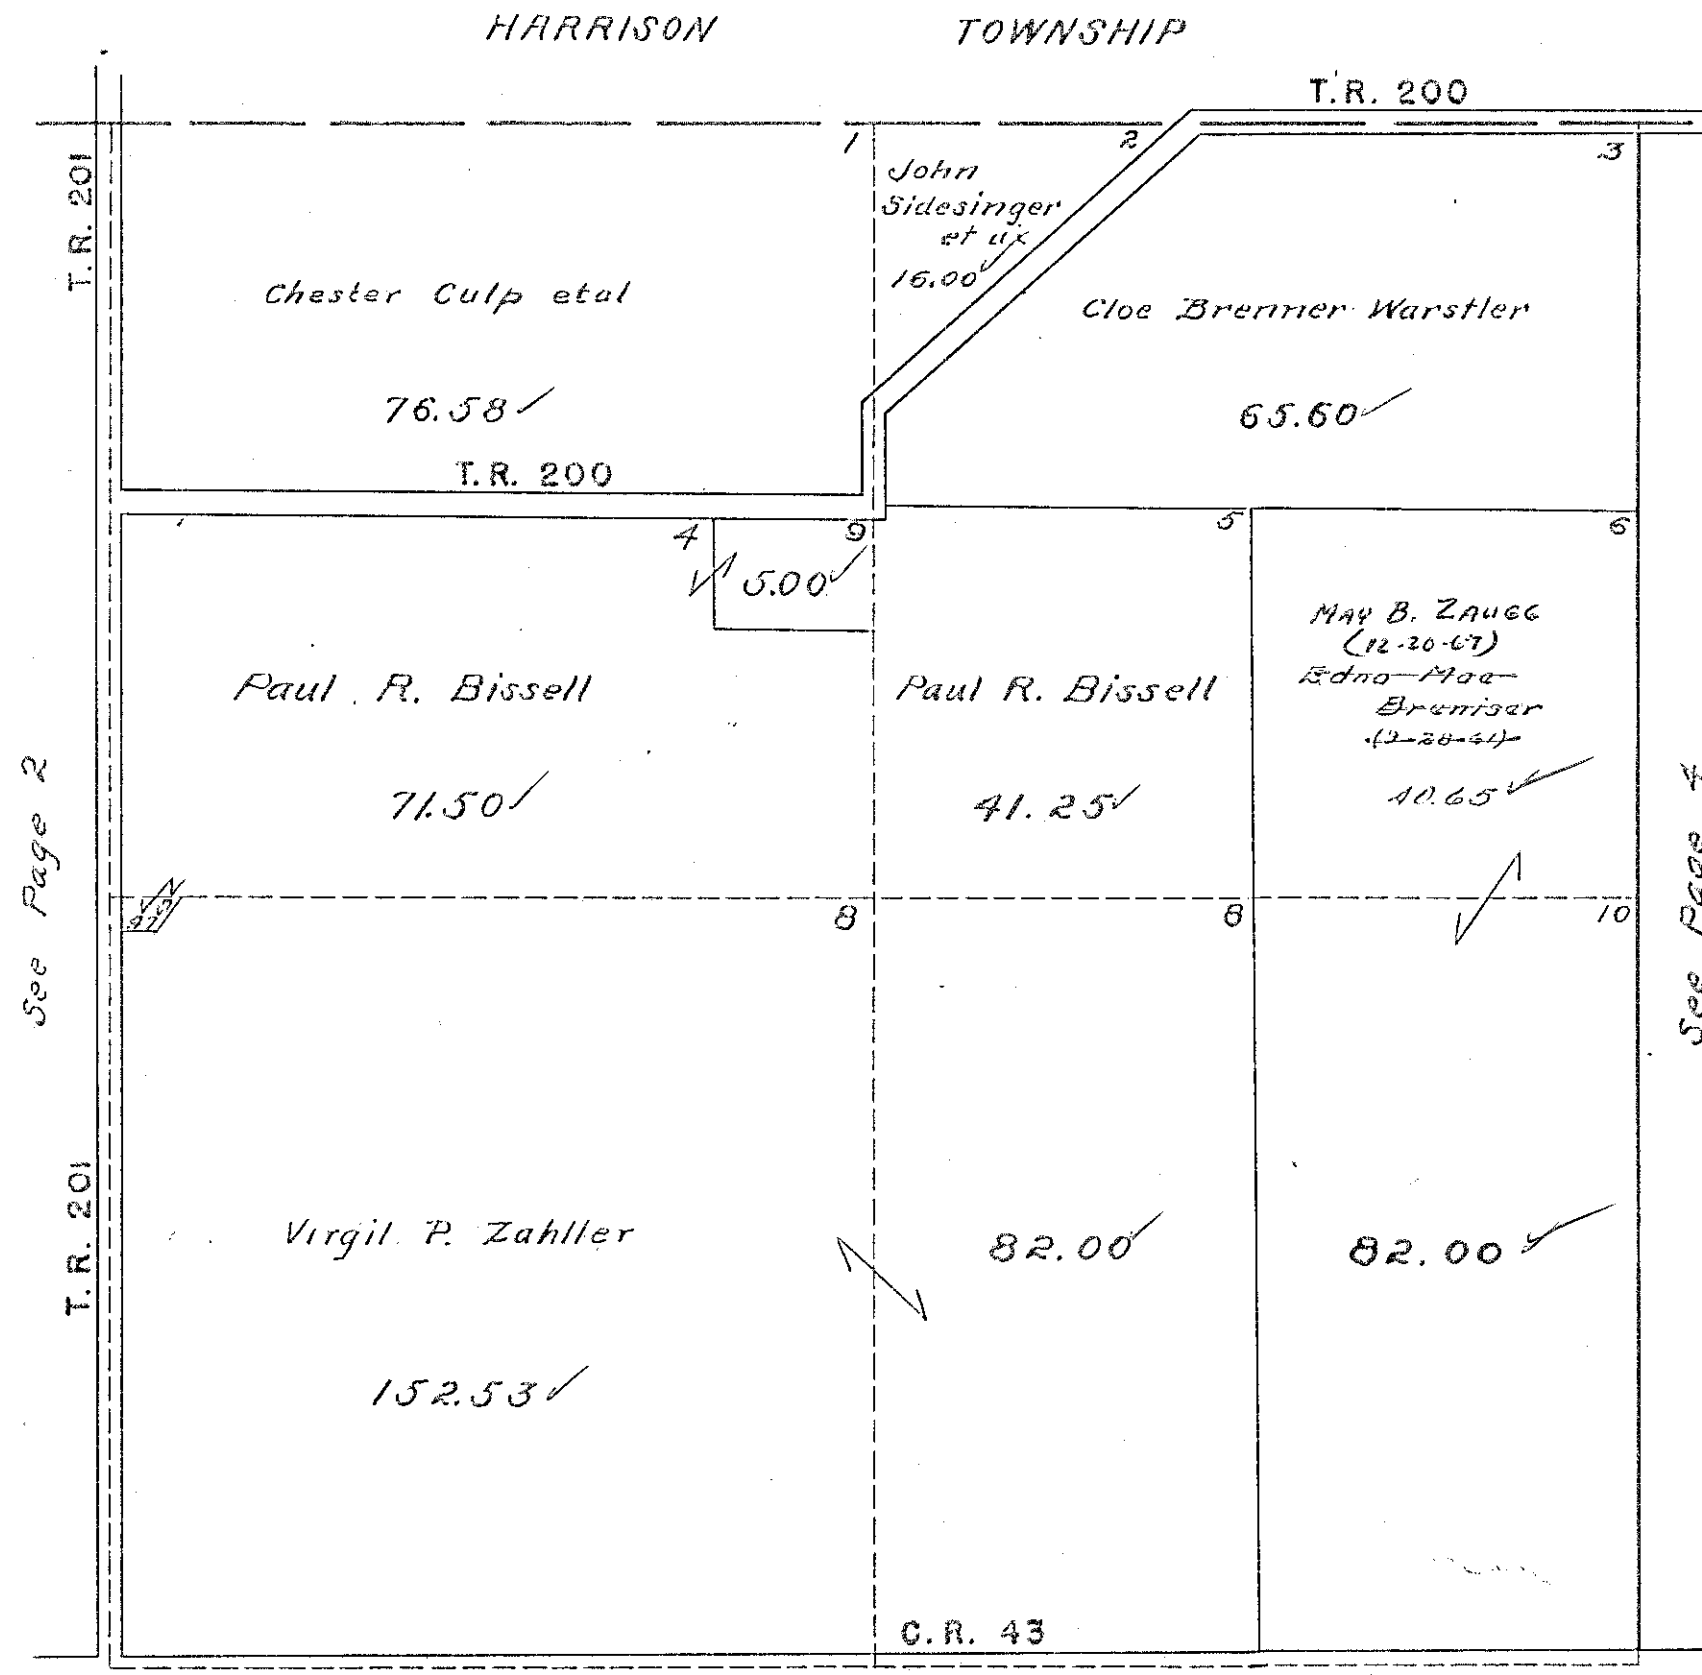


See Page 7



UNION TOWNSHIP  
SECTION 25 TOWN 3 RANGE 14


SCALE 10 CHAINS TO THE INCH

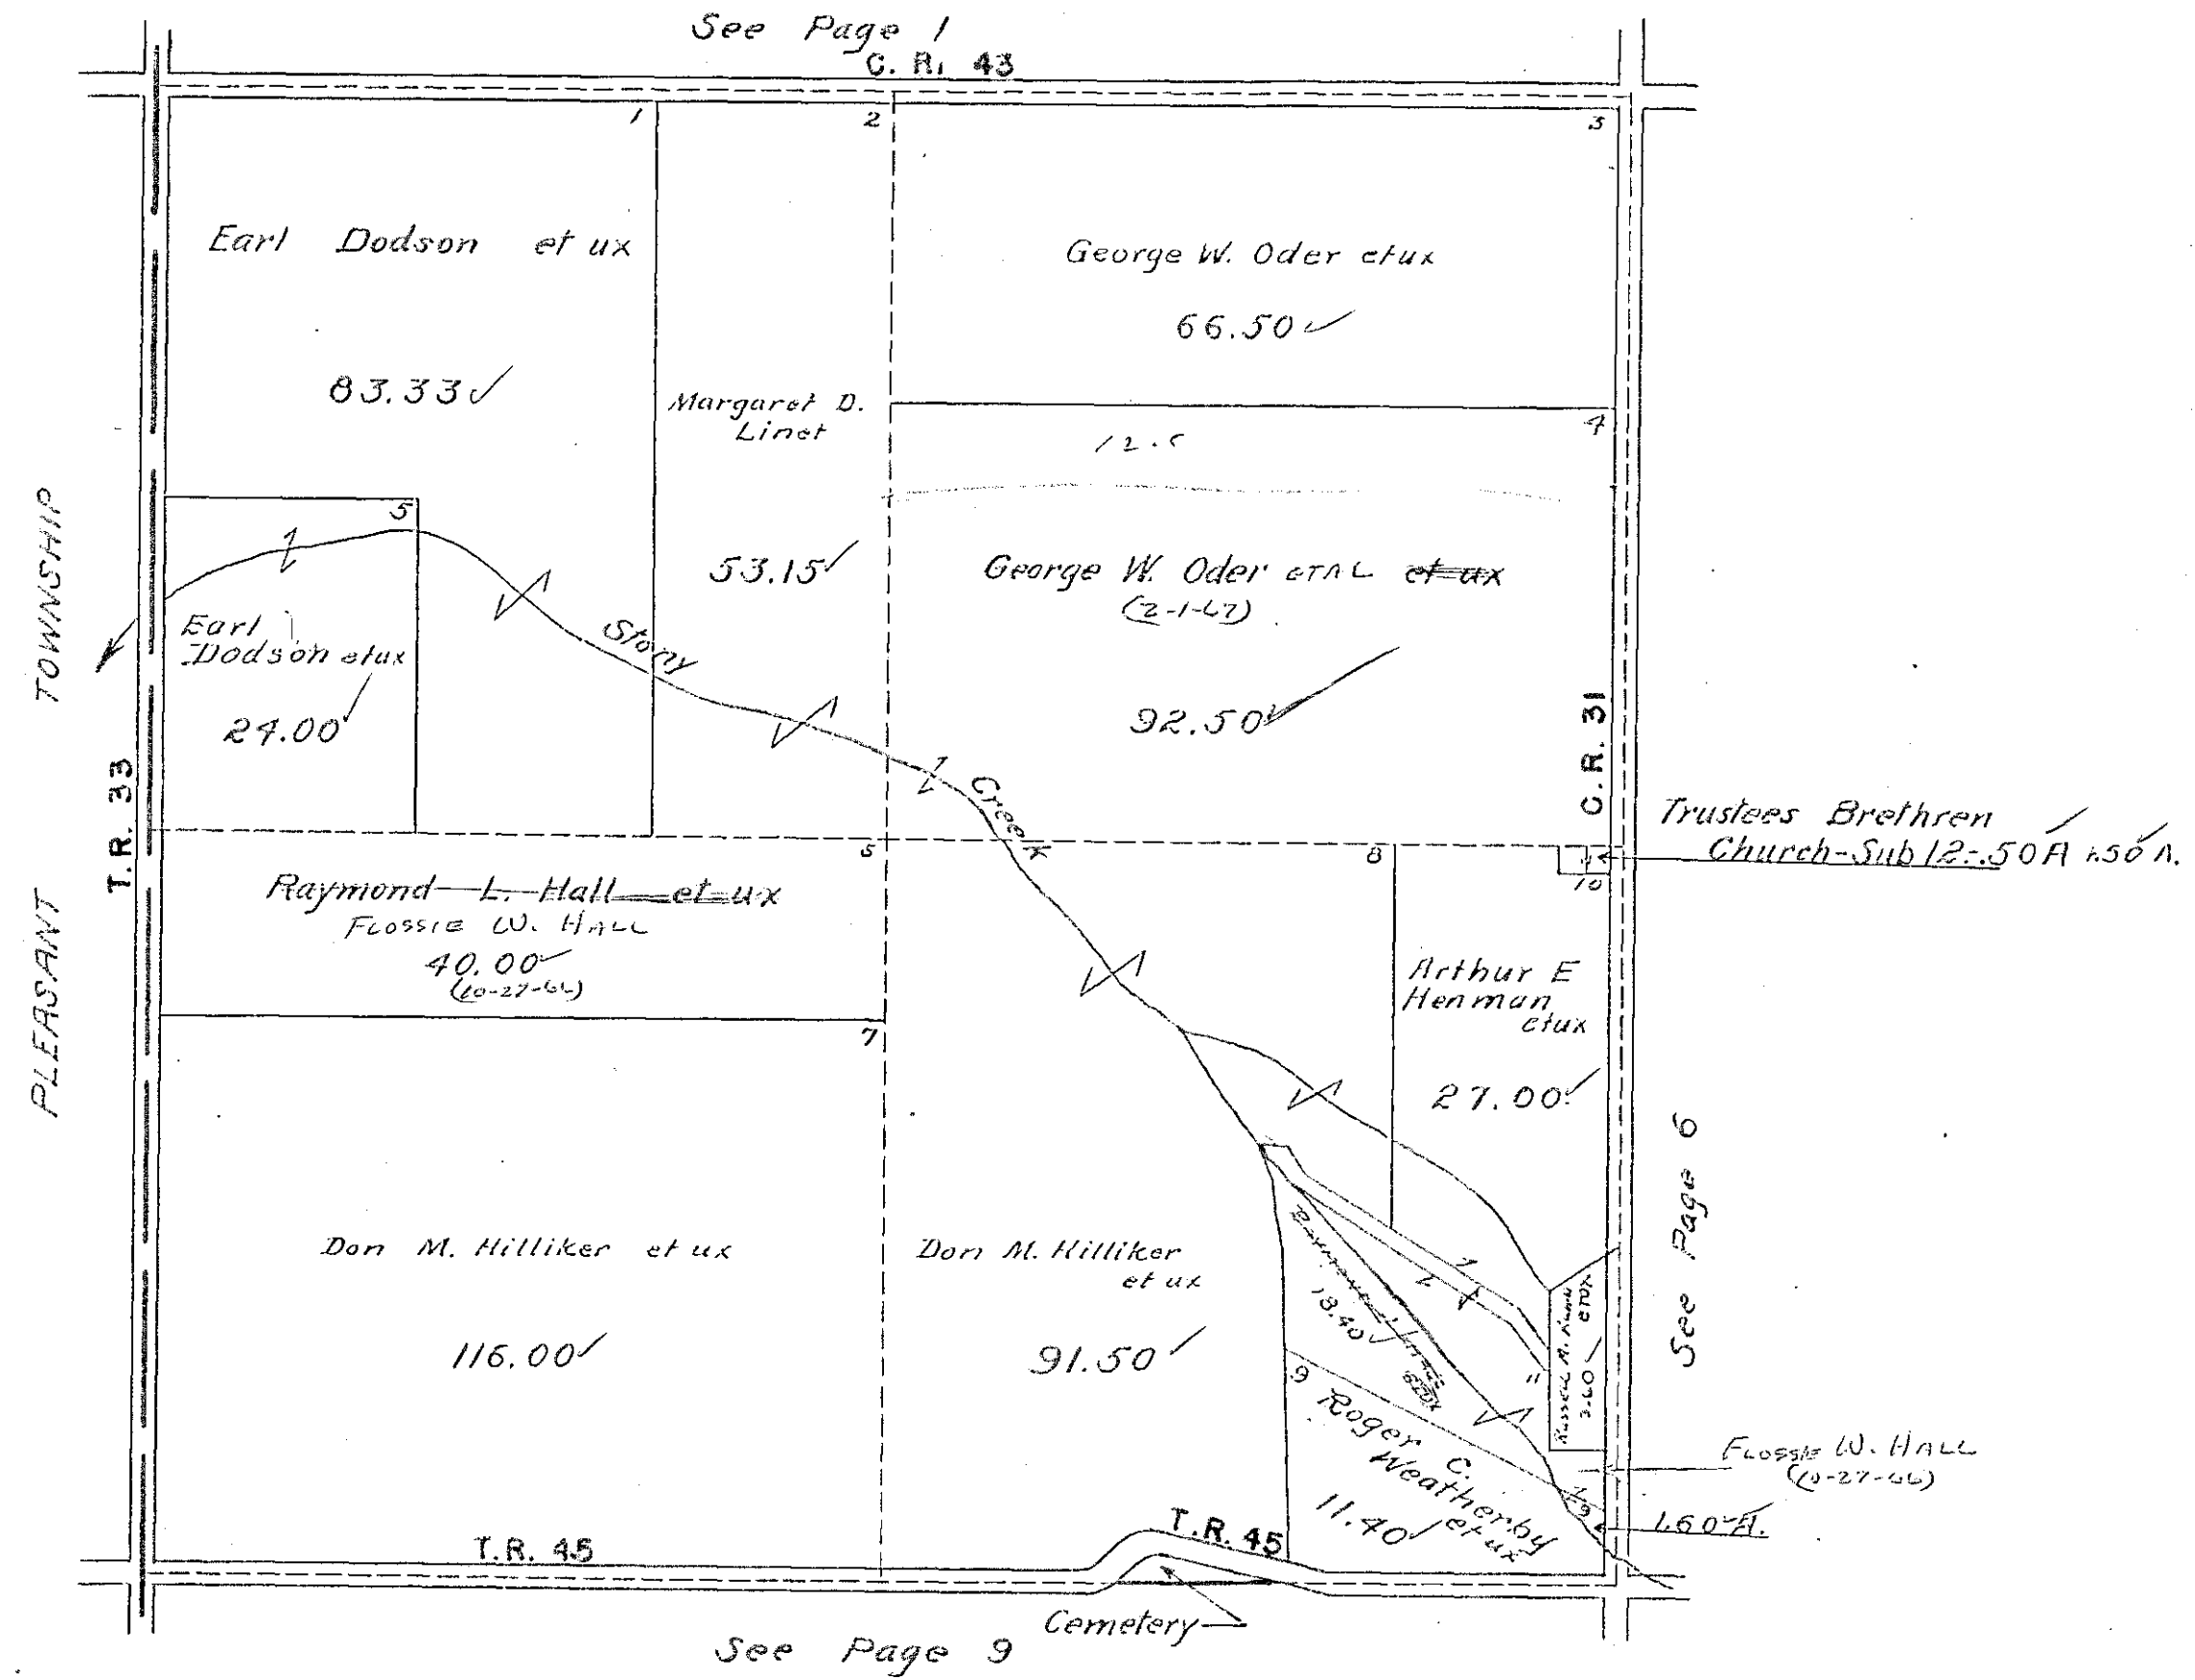



SECTION 19 TOWN 3 RANGE 14

SCALE 10 CHAINS TO THE INCH

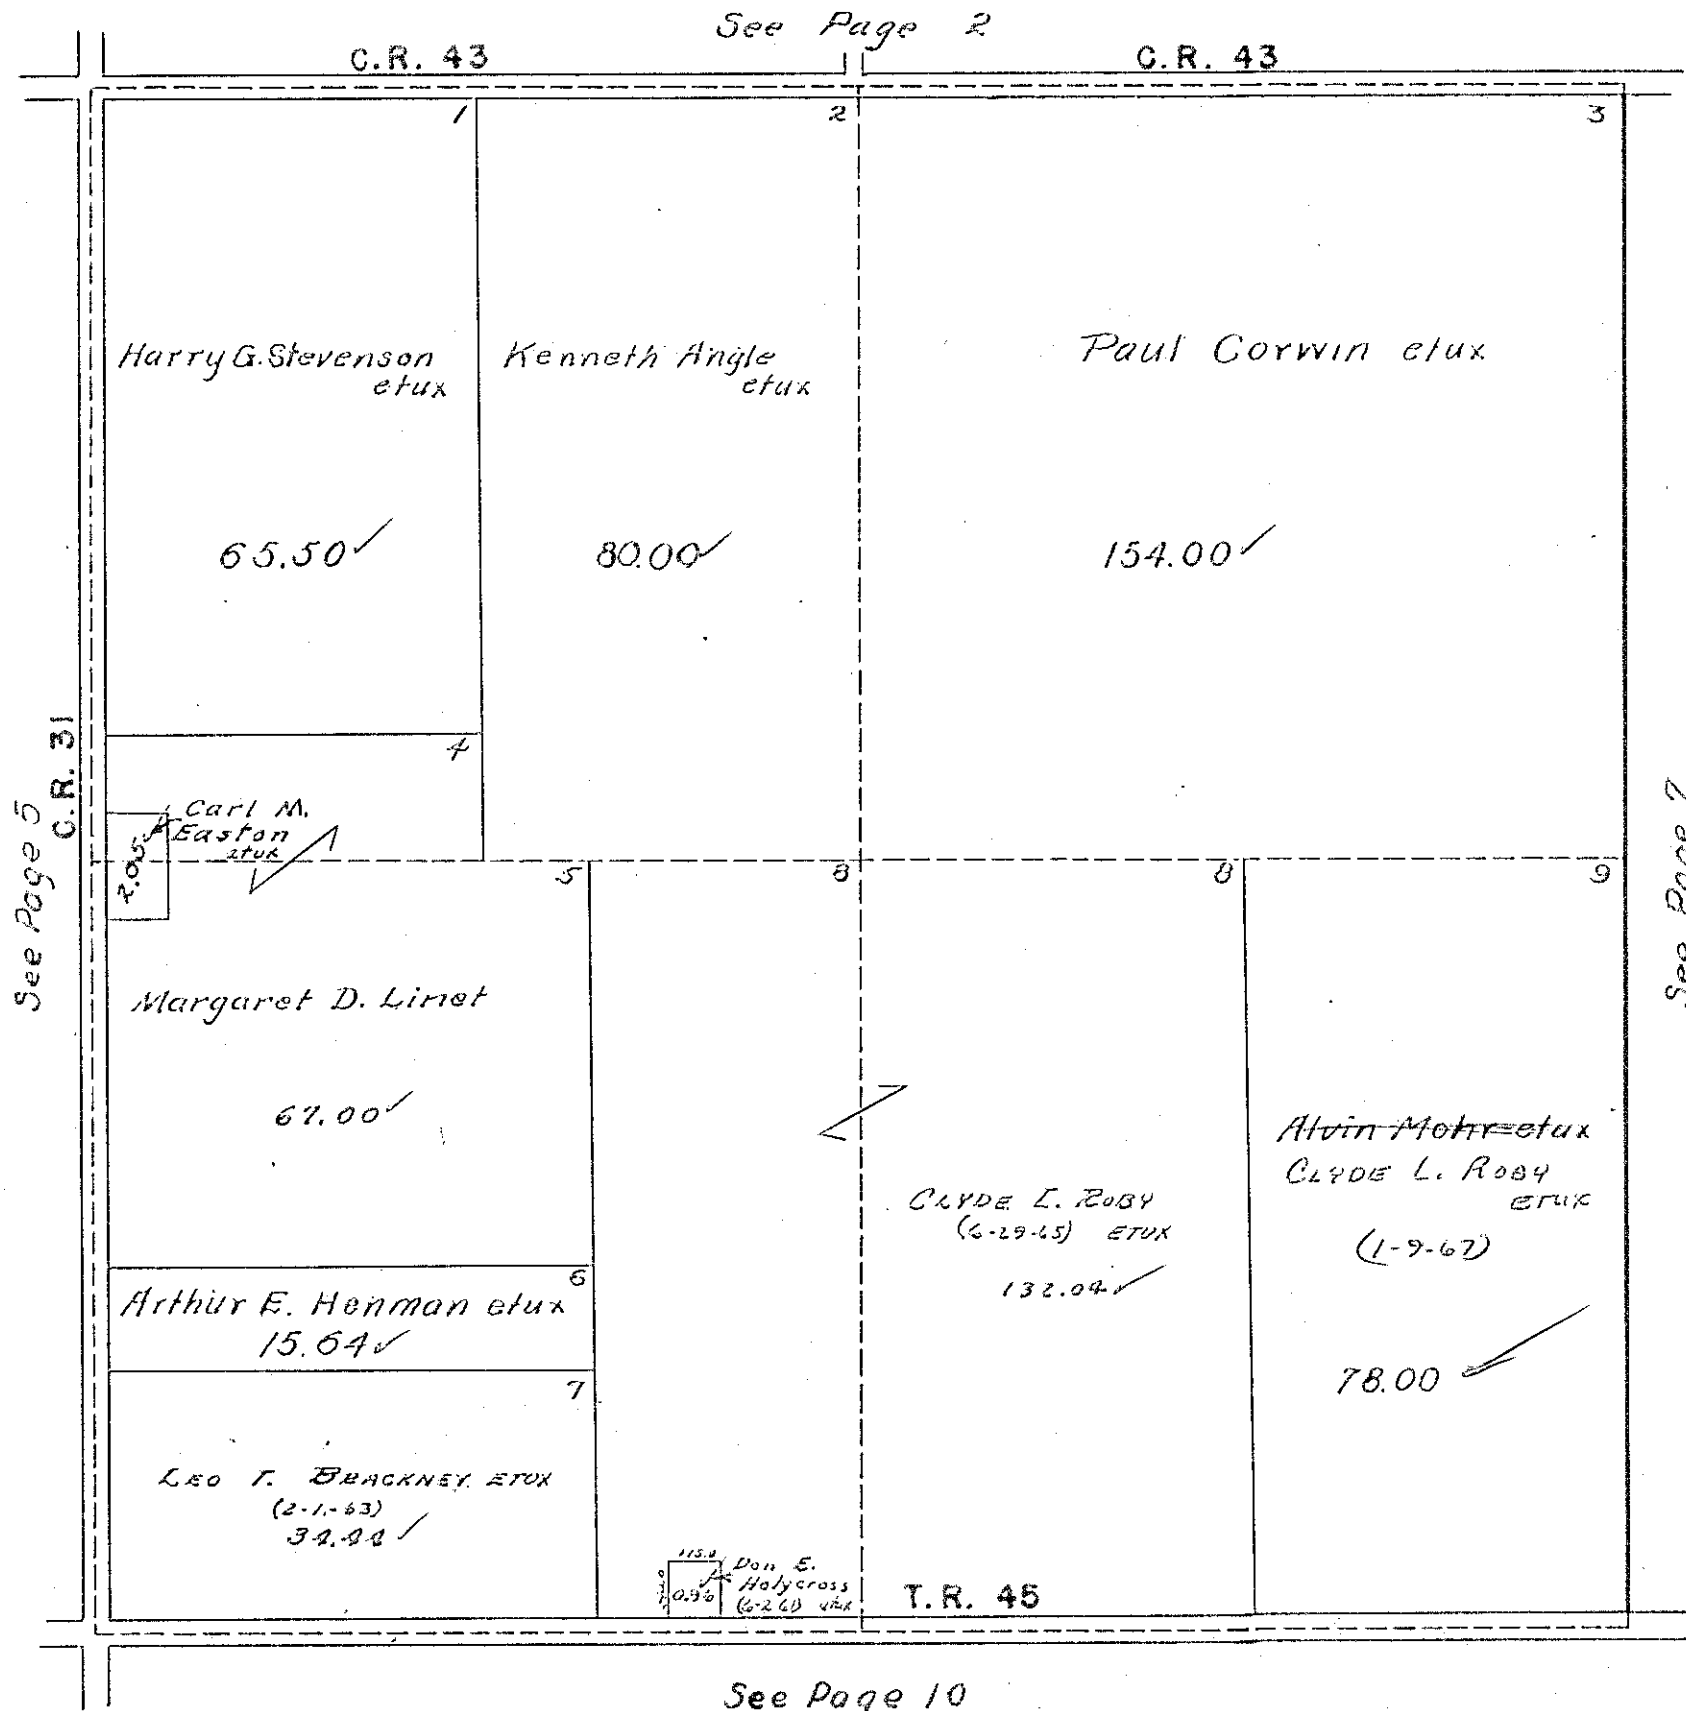

See Page 5  
C.R. 31


See Page 2

See Page 7

See Page 10

UNION TOWNSHIP  
SECTION 13 TOWN 3 RANGE 14


SCALE 10 CHAINS TO THE INCH

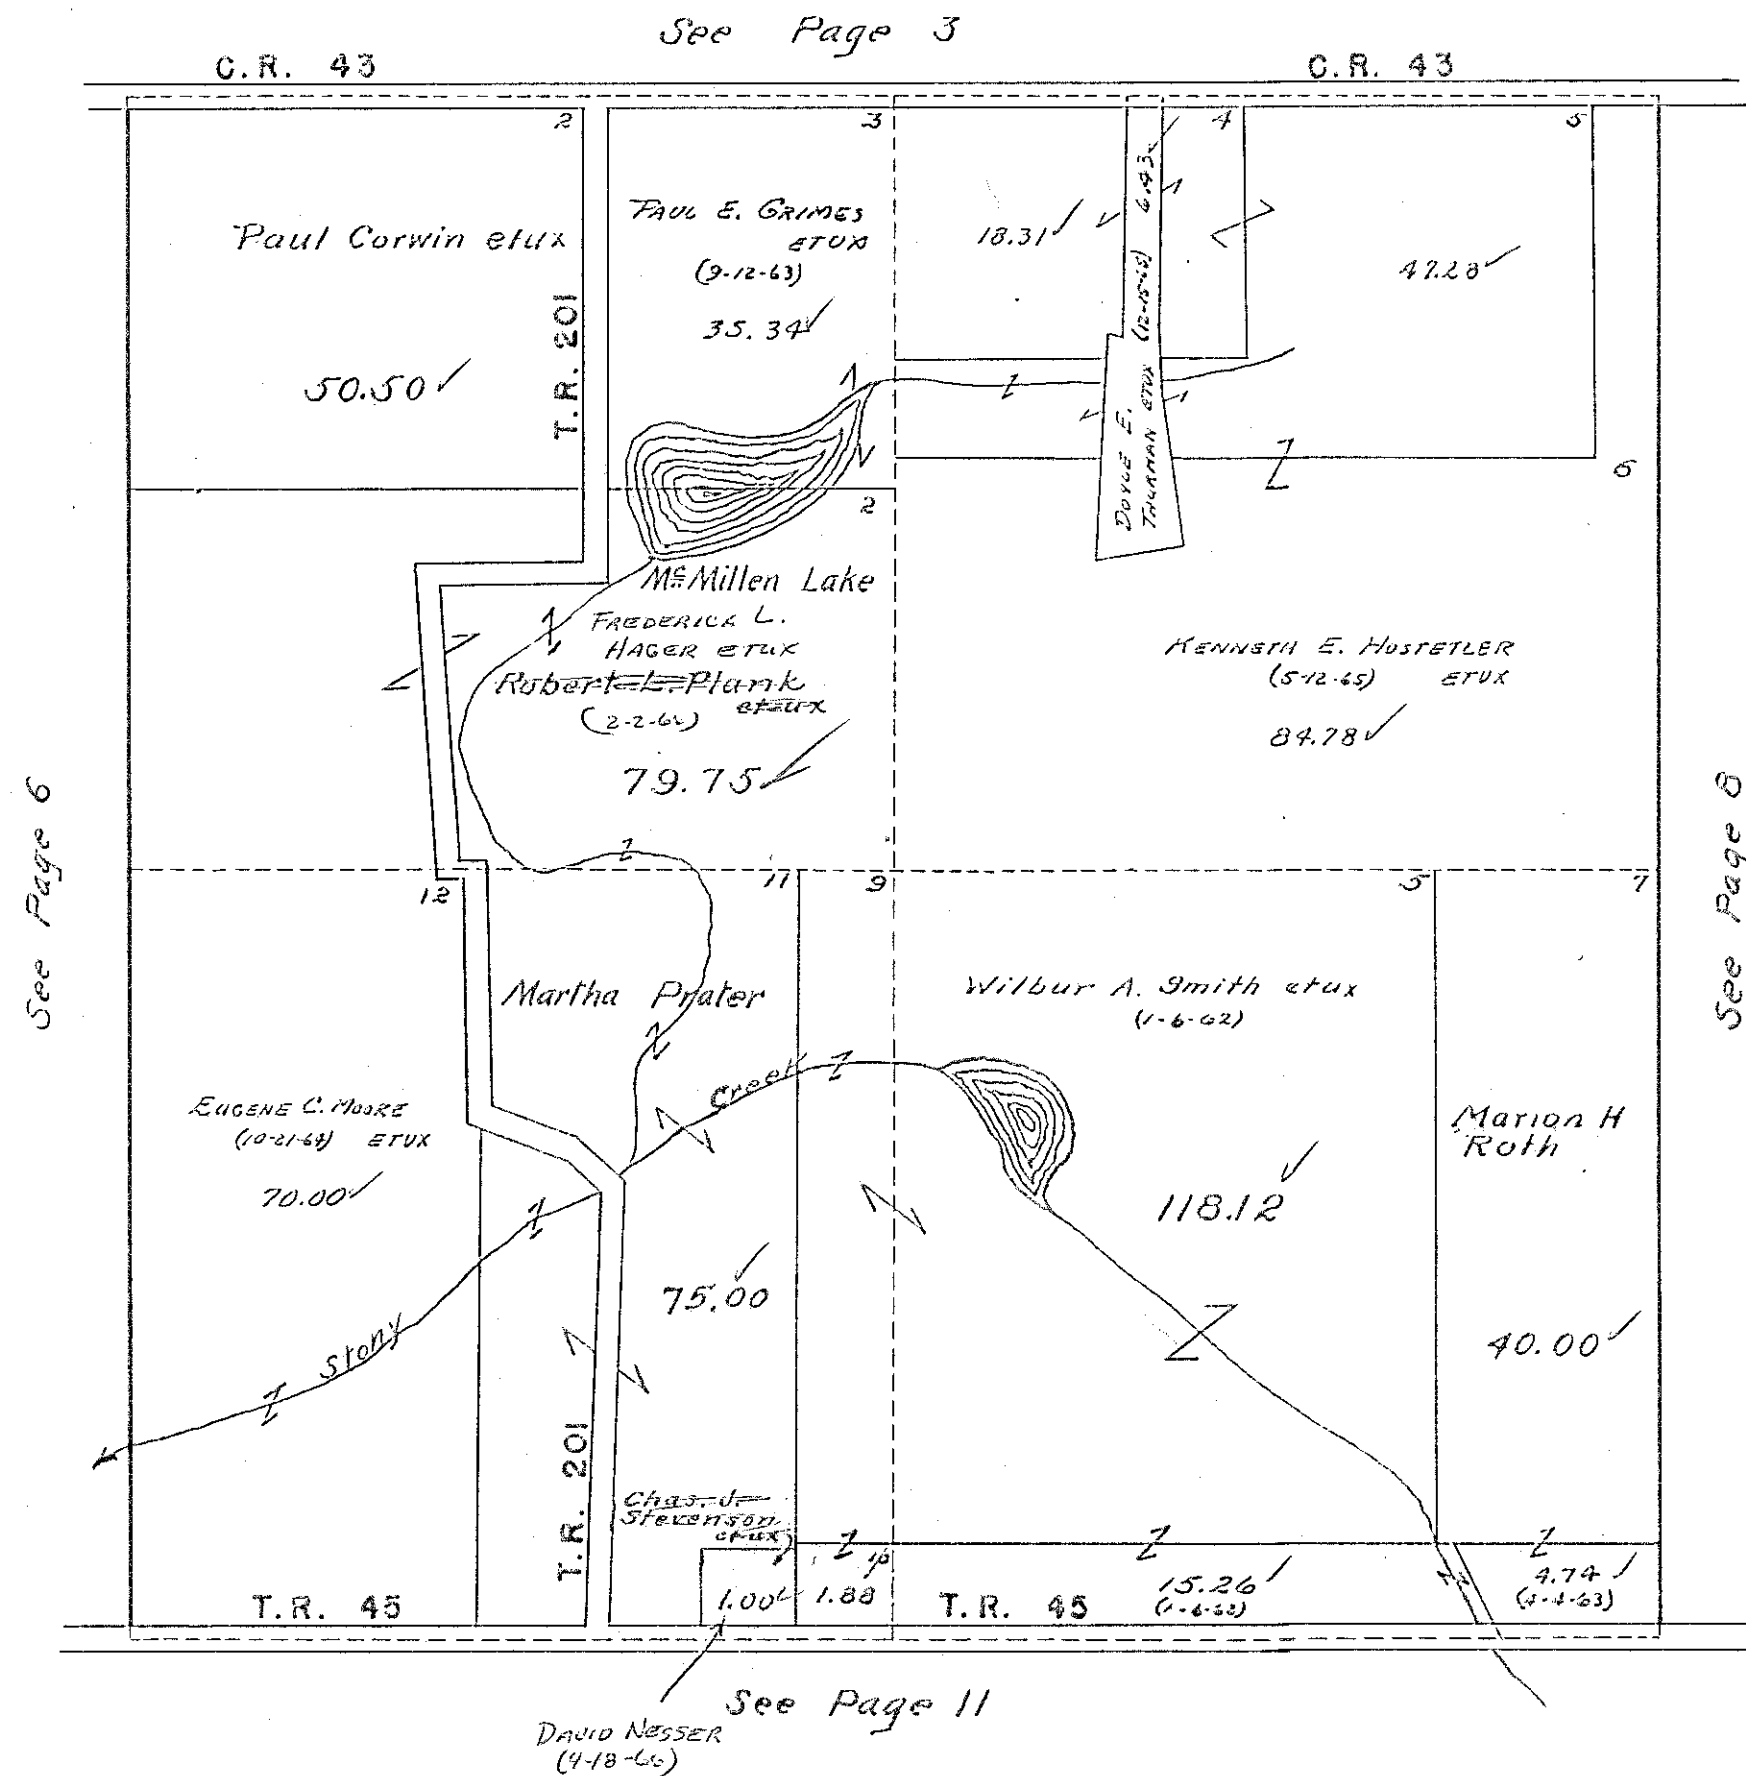

SECTION 7 TOWN 3 RANGE 14

SECTION 1 TOWN 3 RANGE 14

SCALE 10 CHAINS TO THE INCH

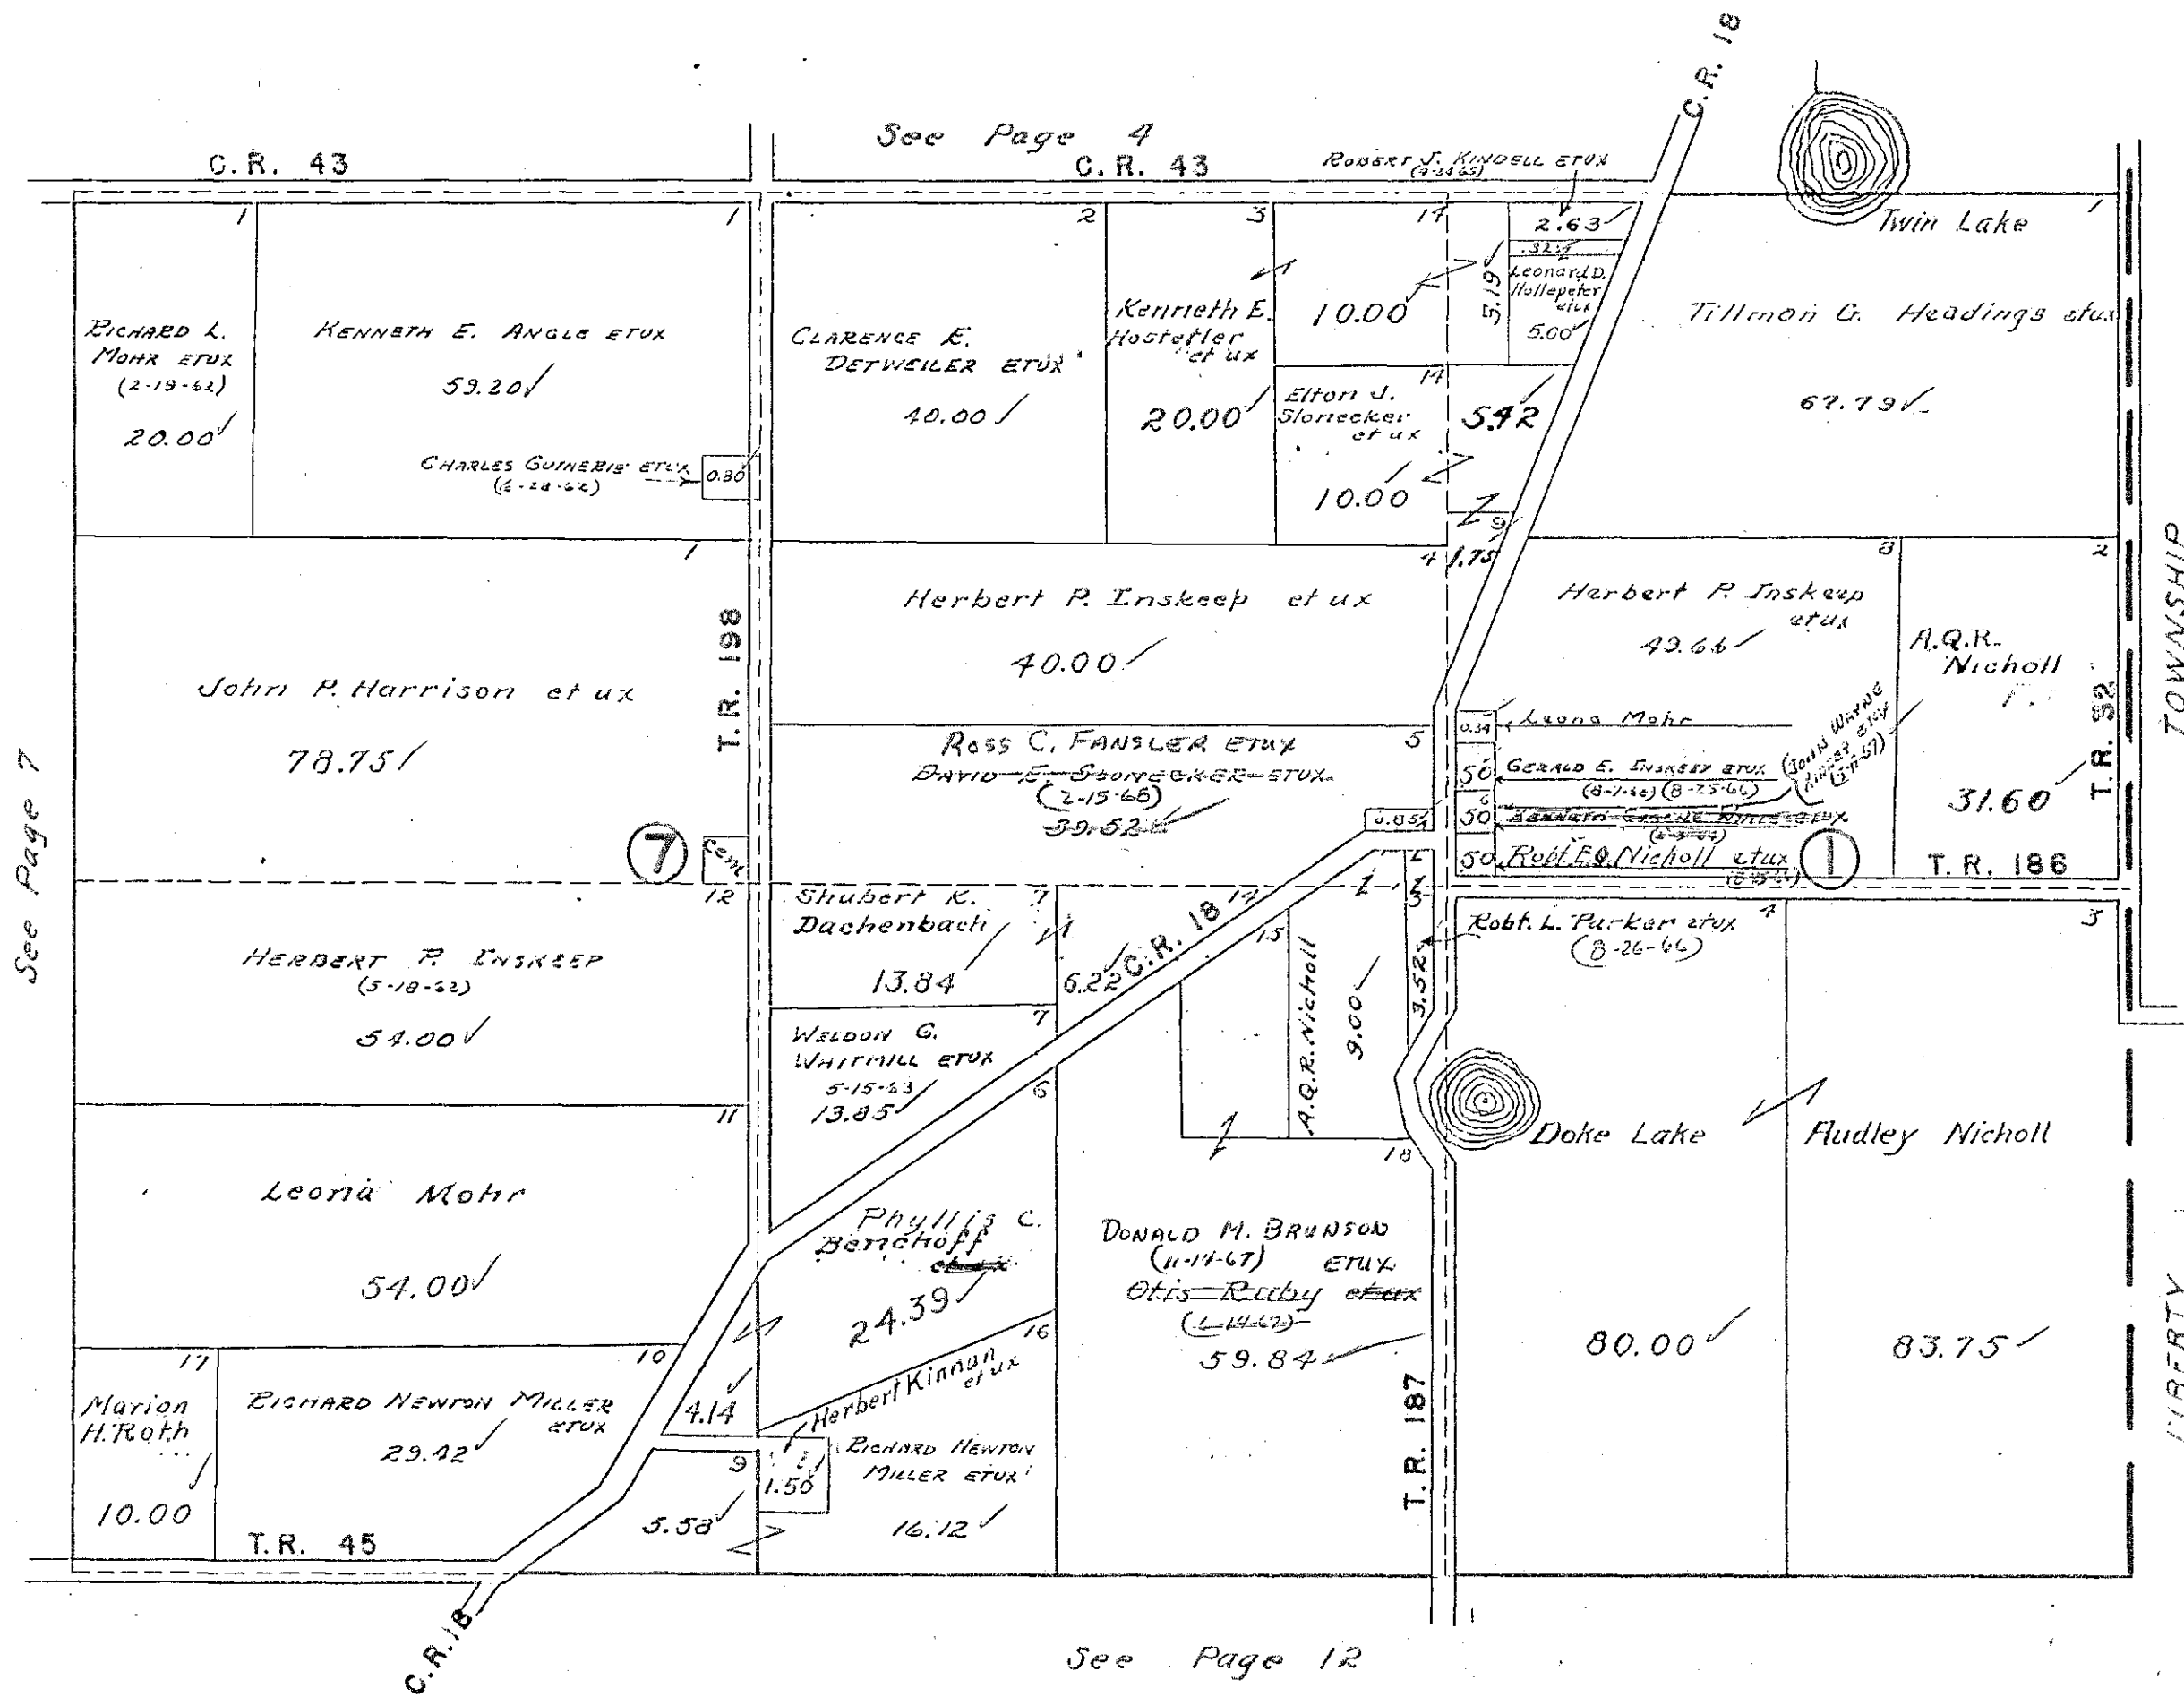


See Page 7

See Page 4

See Page 12


UNION TOWNSHIP  
SECTION 30 TOWN 4 RANGE 13

SCALE 10 CHAINS TO THE INCH

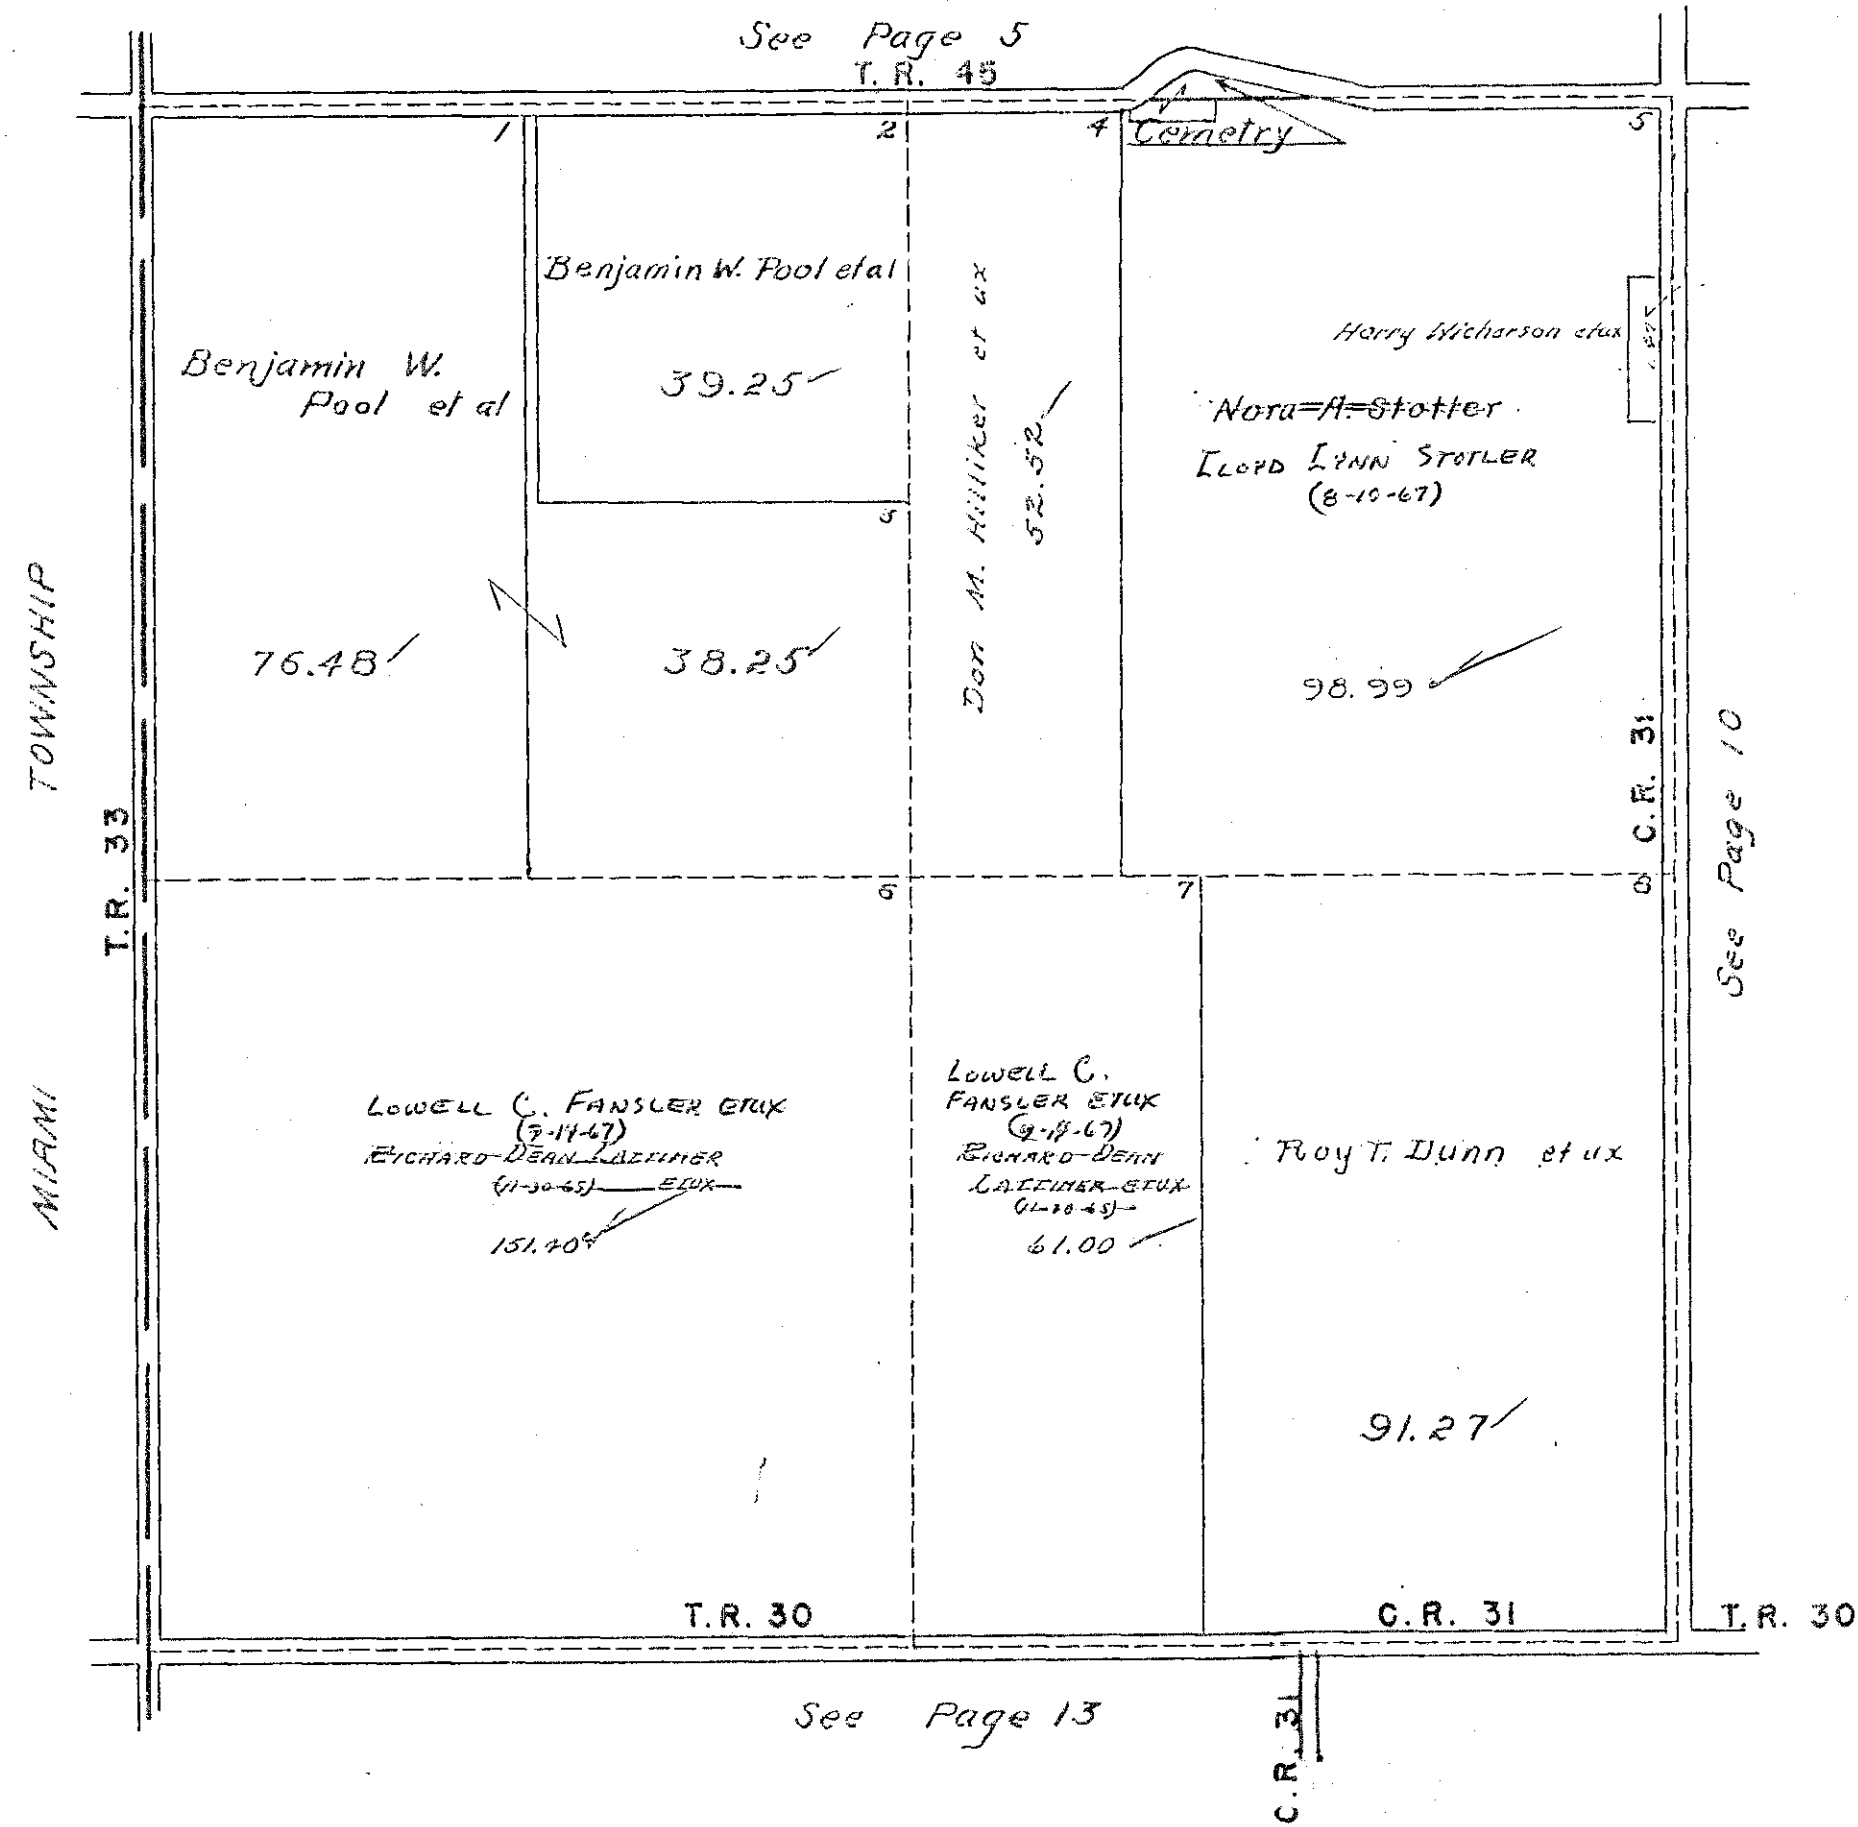

UNION TOWNSHIP  
SECTION 24 TOWN 4 RANGE 13

SCALE 10 CHAINS TO THE INCH

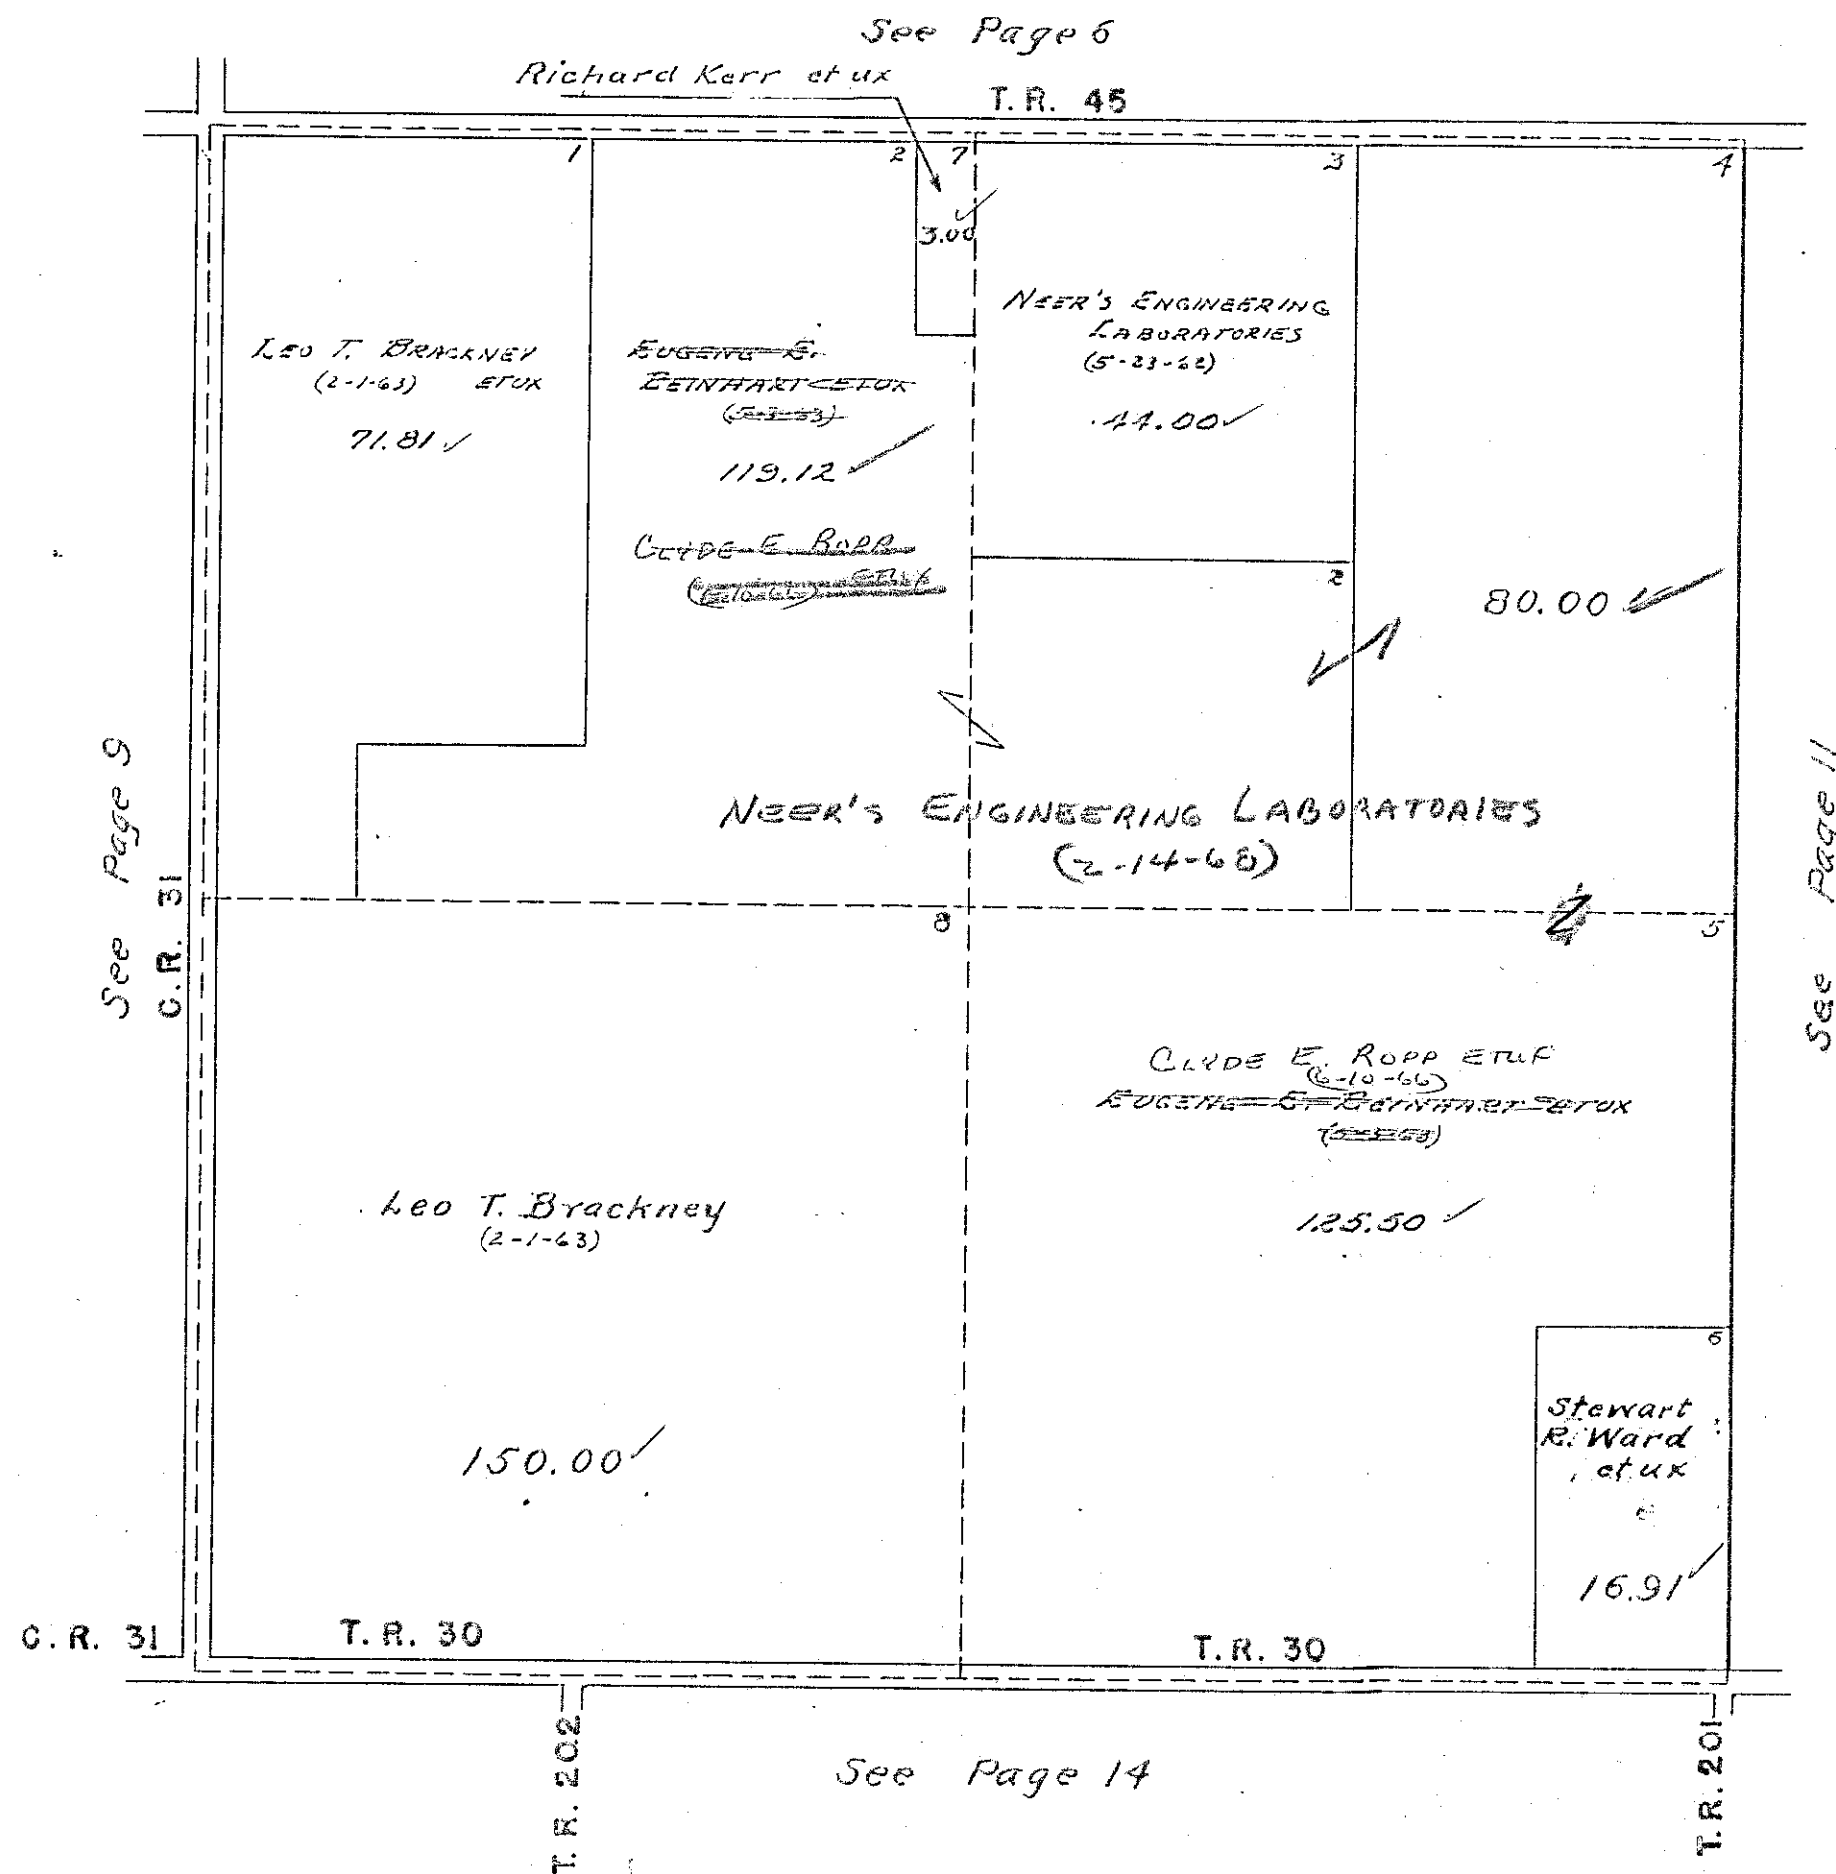


UNION TOWNSHIP  
SECTION 18 TOWN 4 RANGE 13

SCALE 10 CHAINS TO THE INCH

See Page 7

T.R. 45

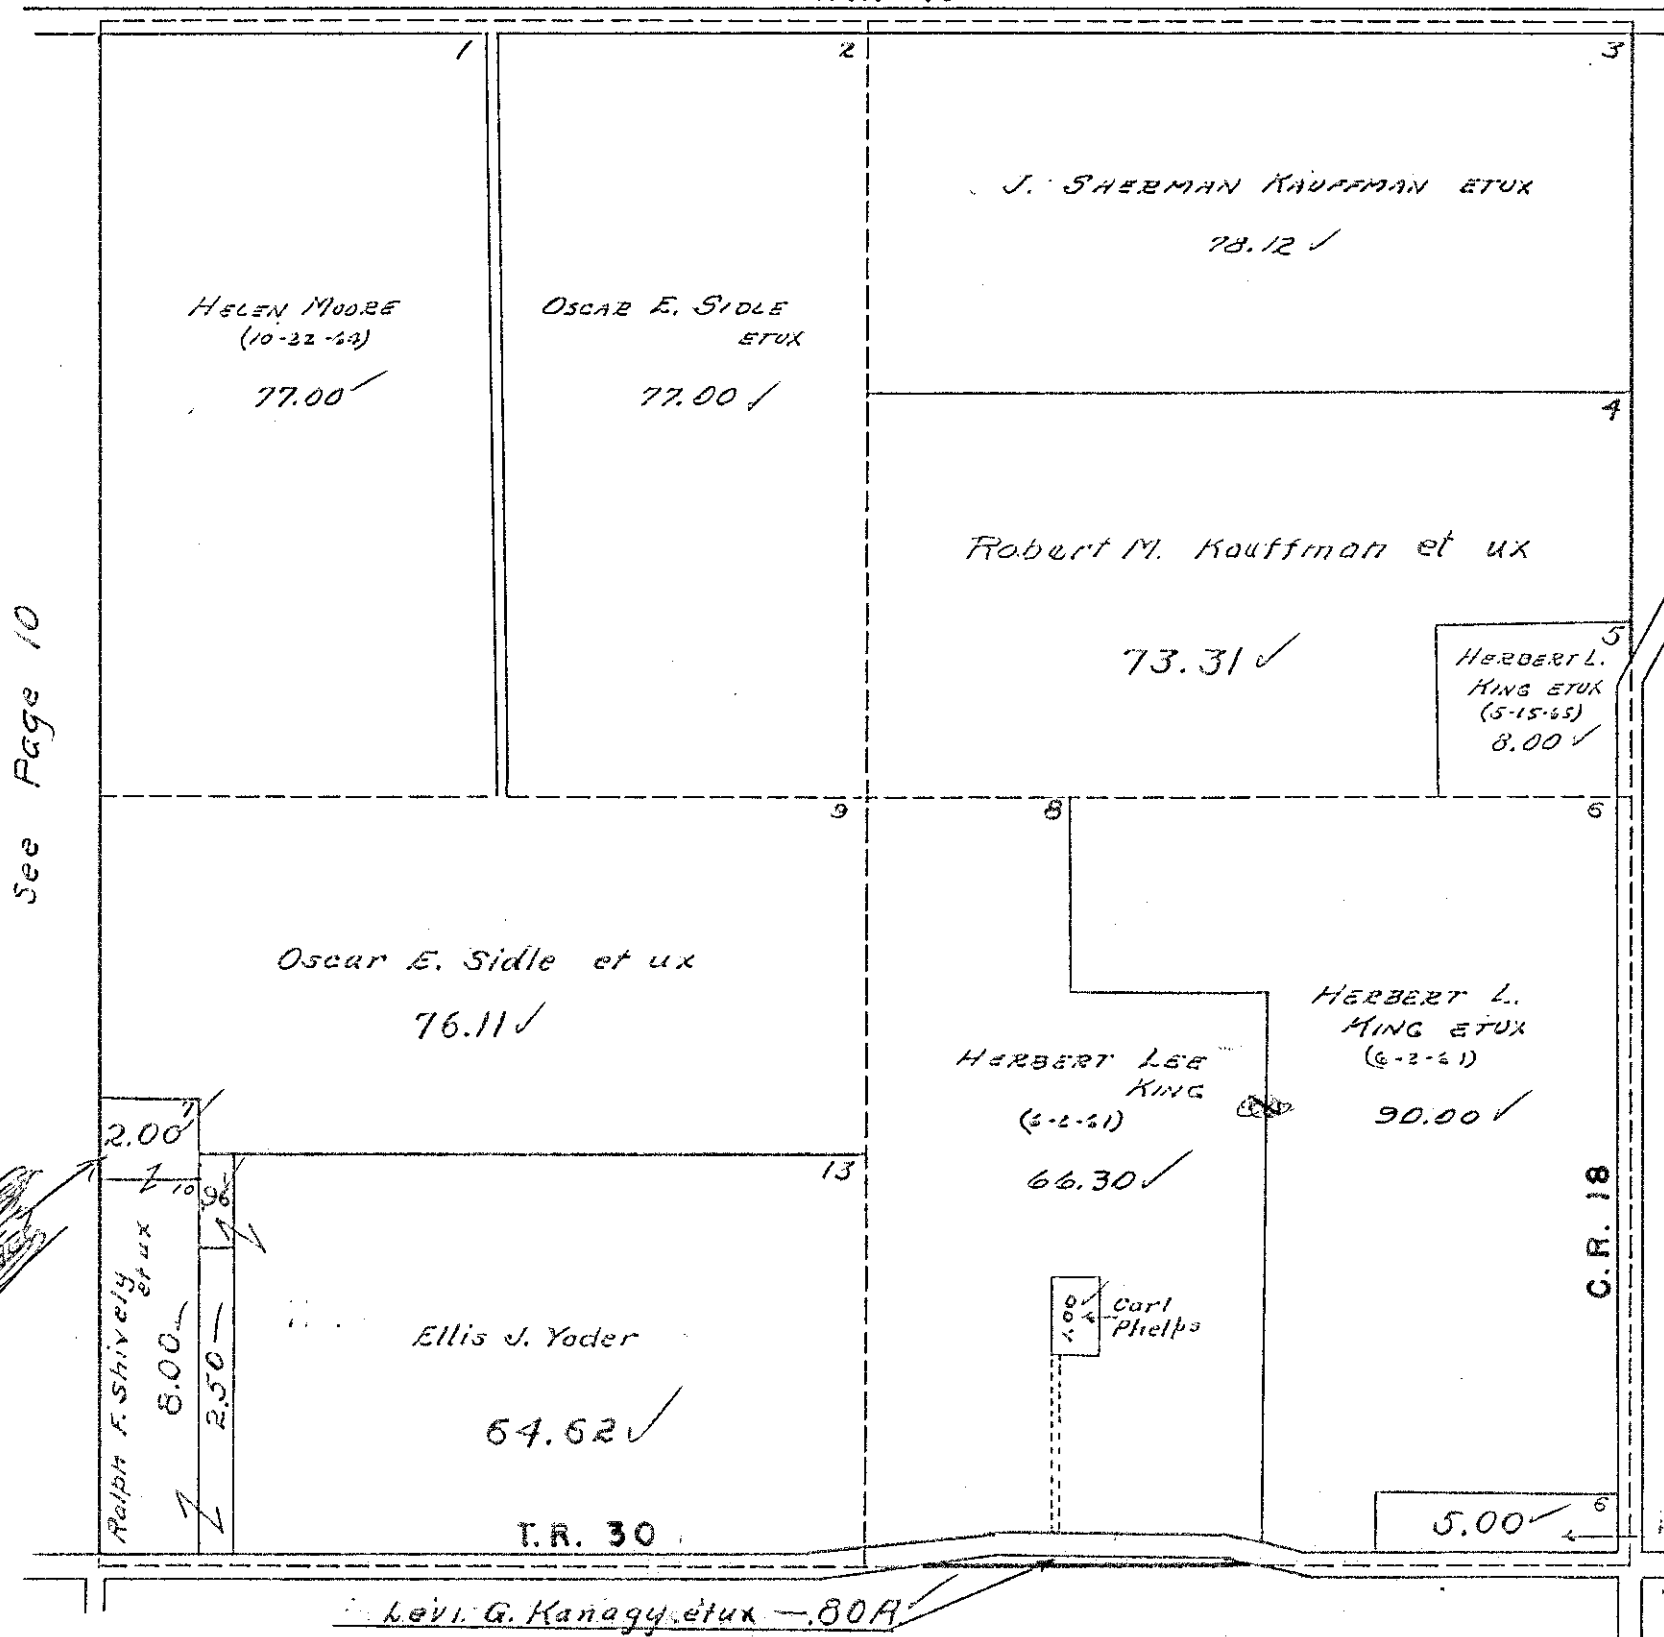

See Page 10

See Page 12


See Page 15

SECTION 12 TOWN 4 RANGE 13

SECTION 6 TOWN 4 RANGE 13

SCALE 10 CHAINS TO THE INCH

See Page 8

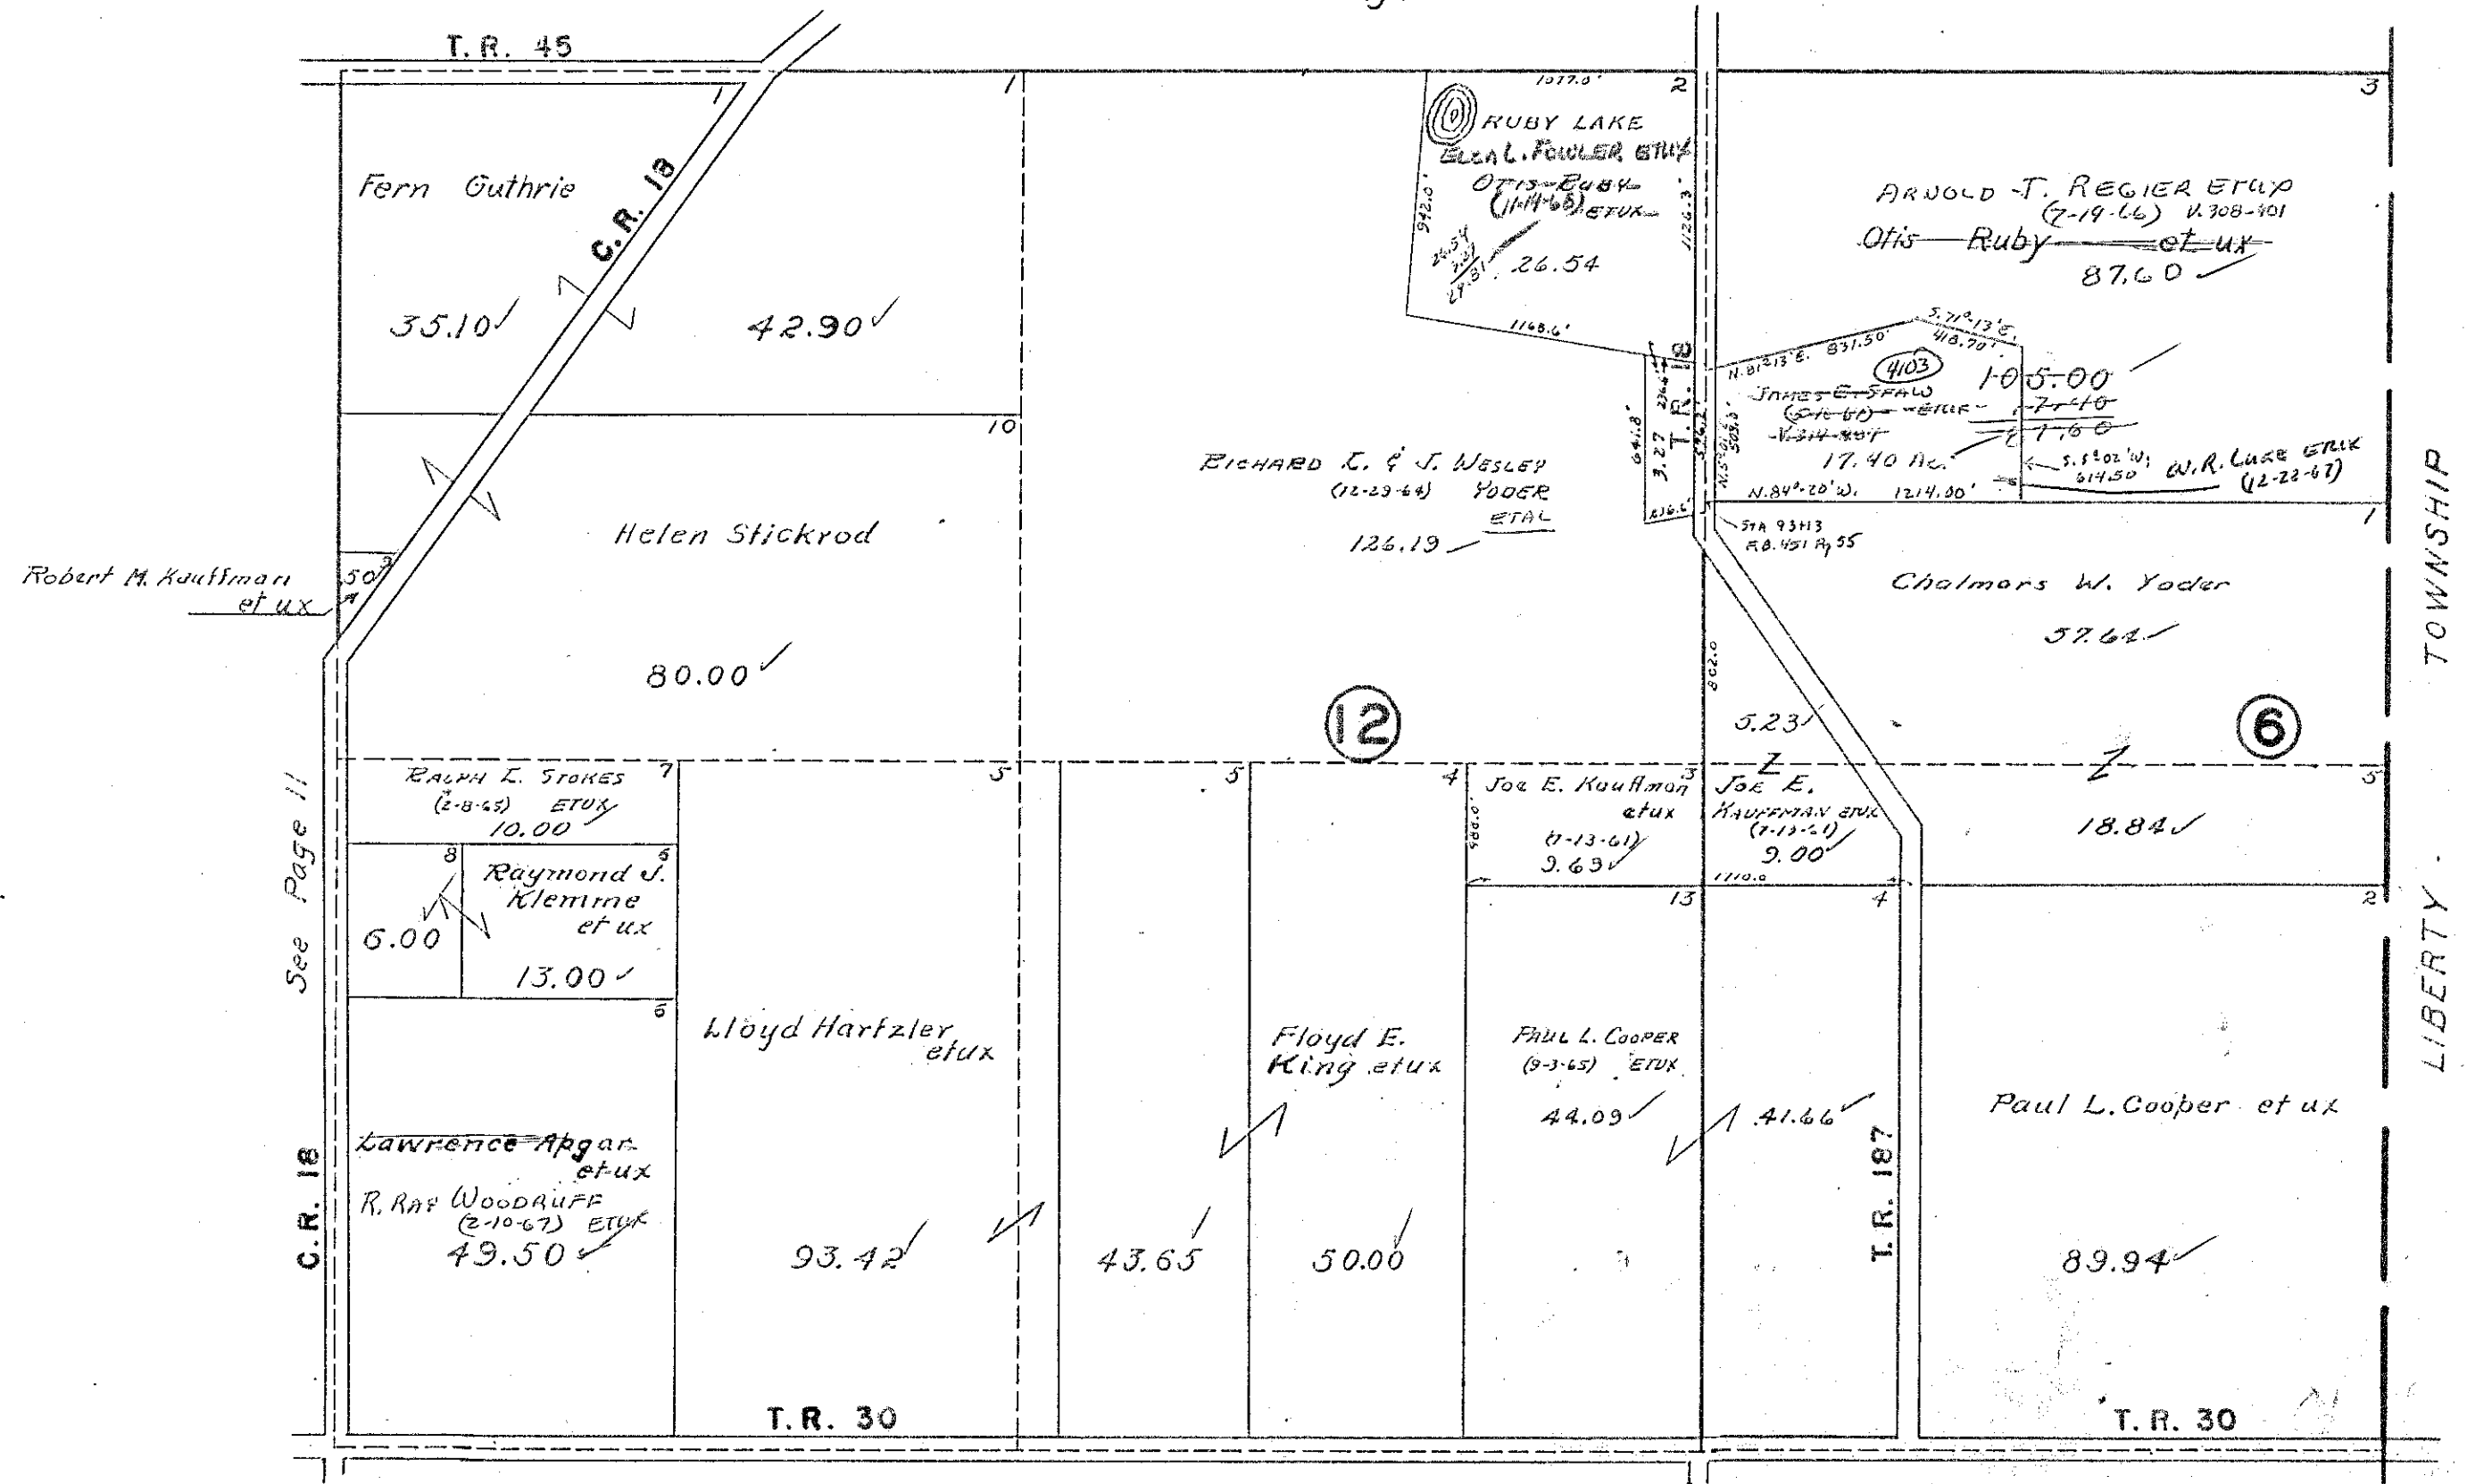


See Page 11

See Page 16

UNION TOWNSHIP  
SECTION 29 TOWN 4 RANGE 13

SCALE 10 CHAINS TO THE INCH

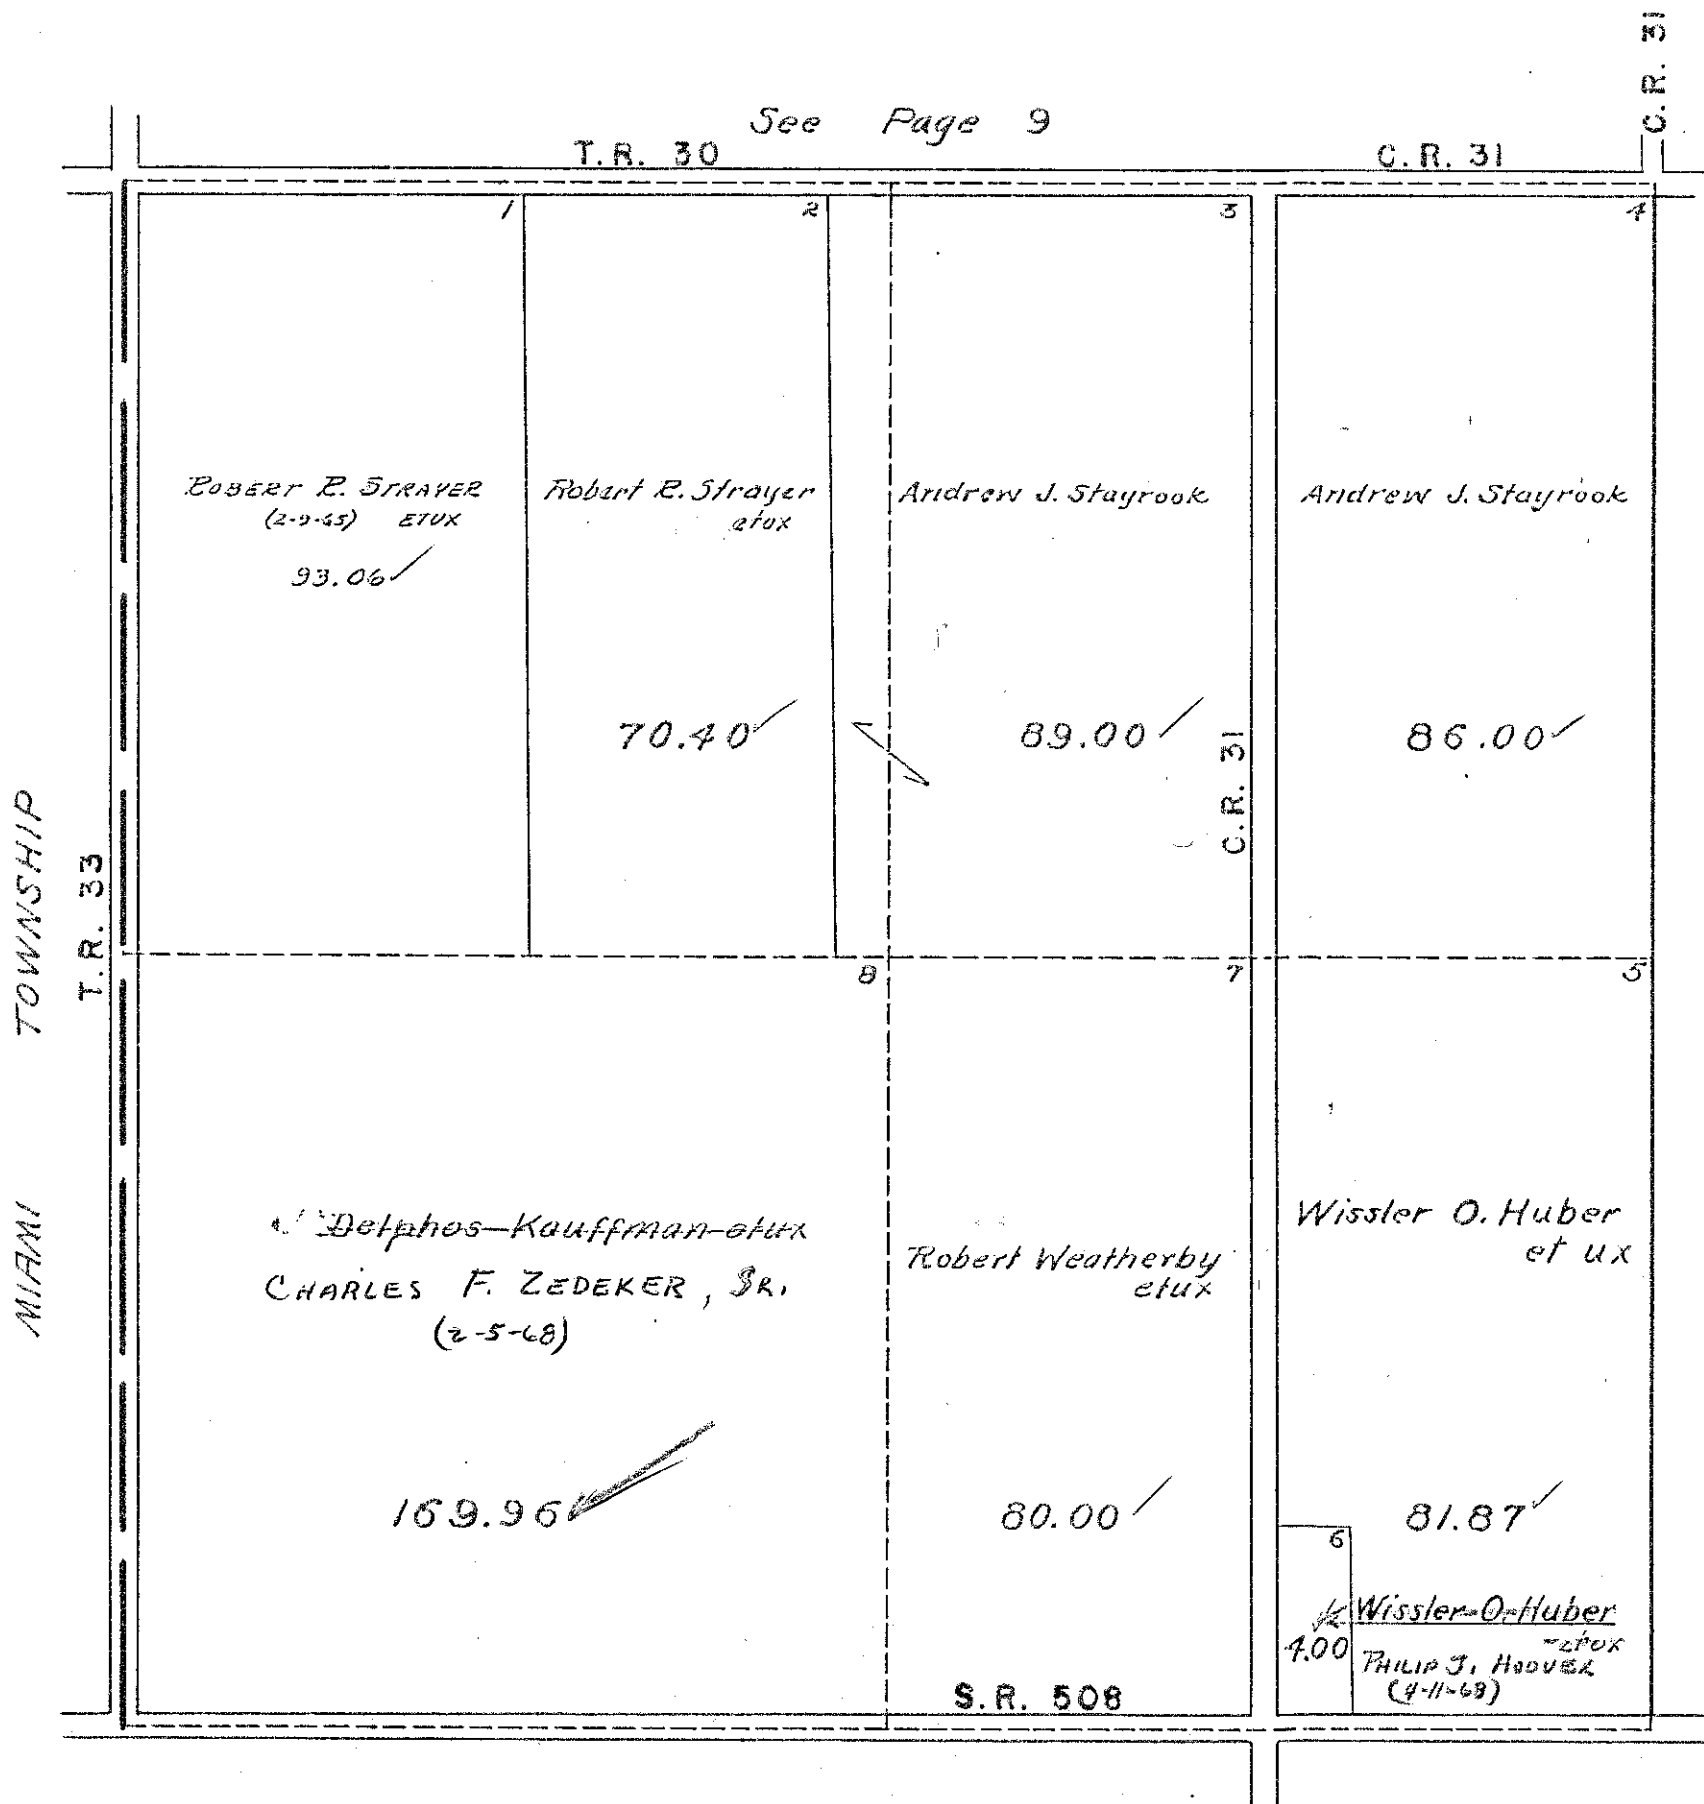


See Page 17



UNION TOWNSHIP  
SECTION 23 TOWN 4 RANGE 13


SCALE 10 CHAINS TO THE INCH

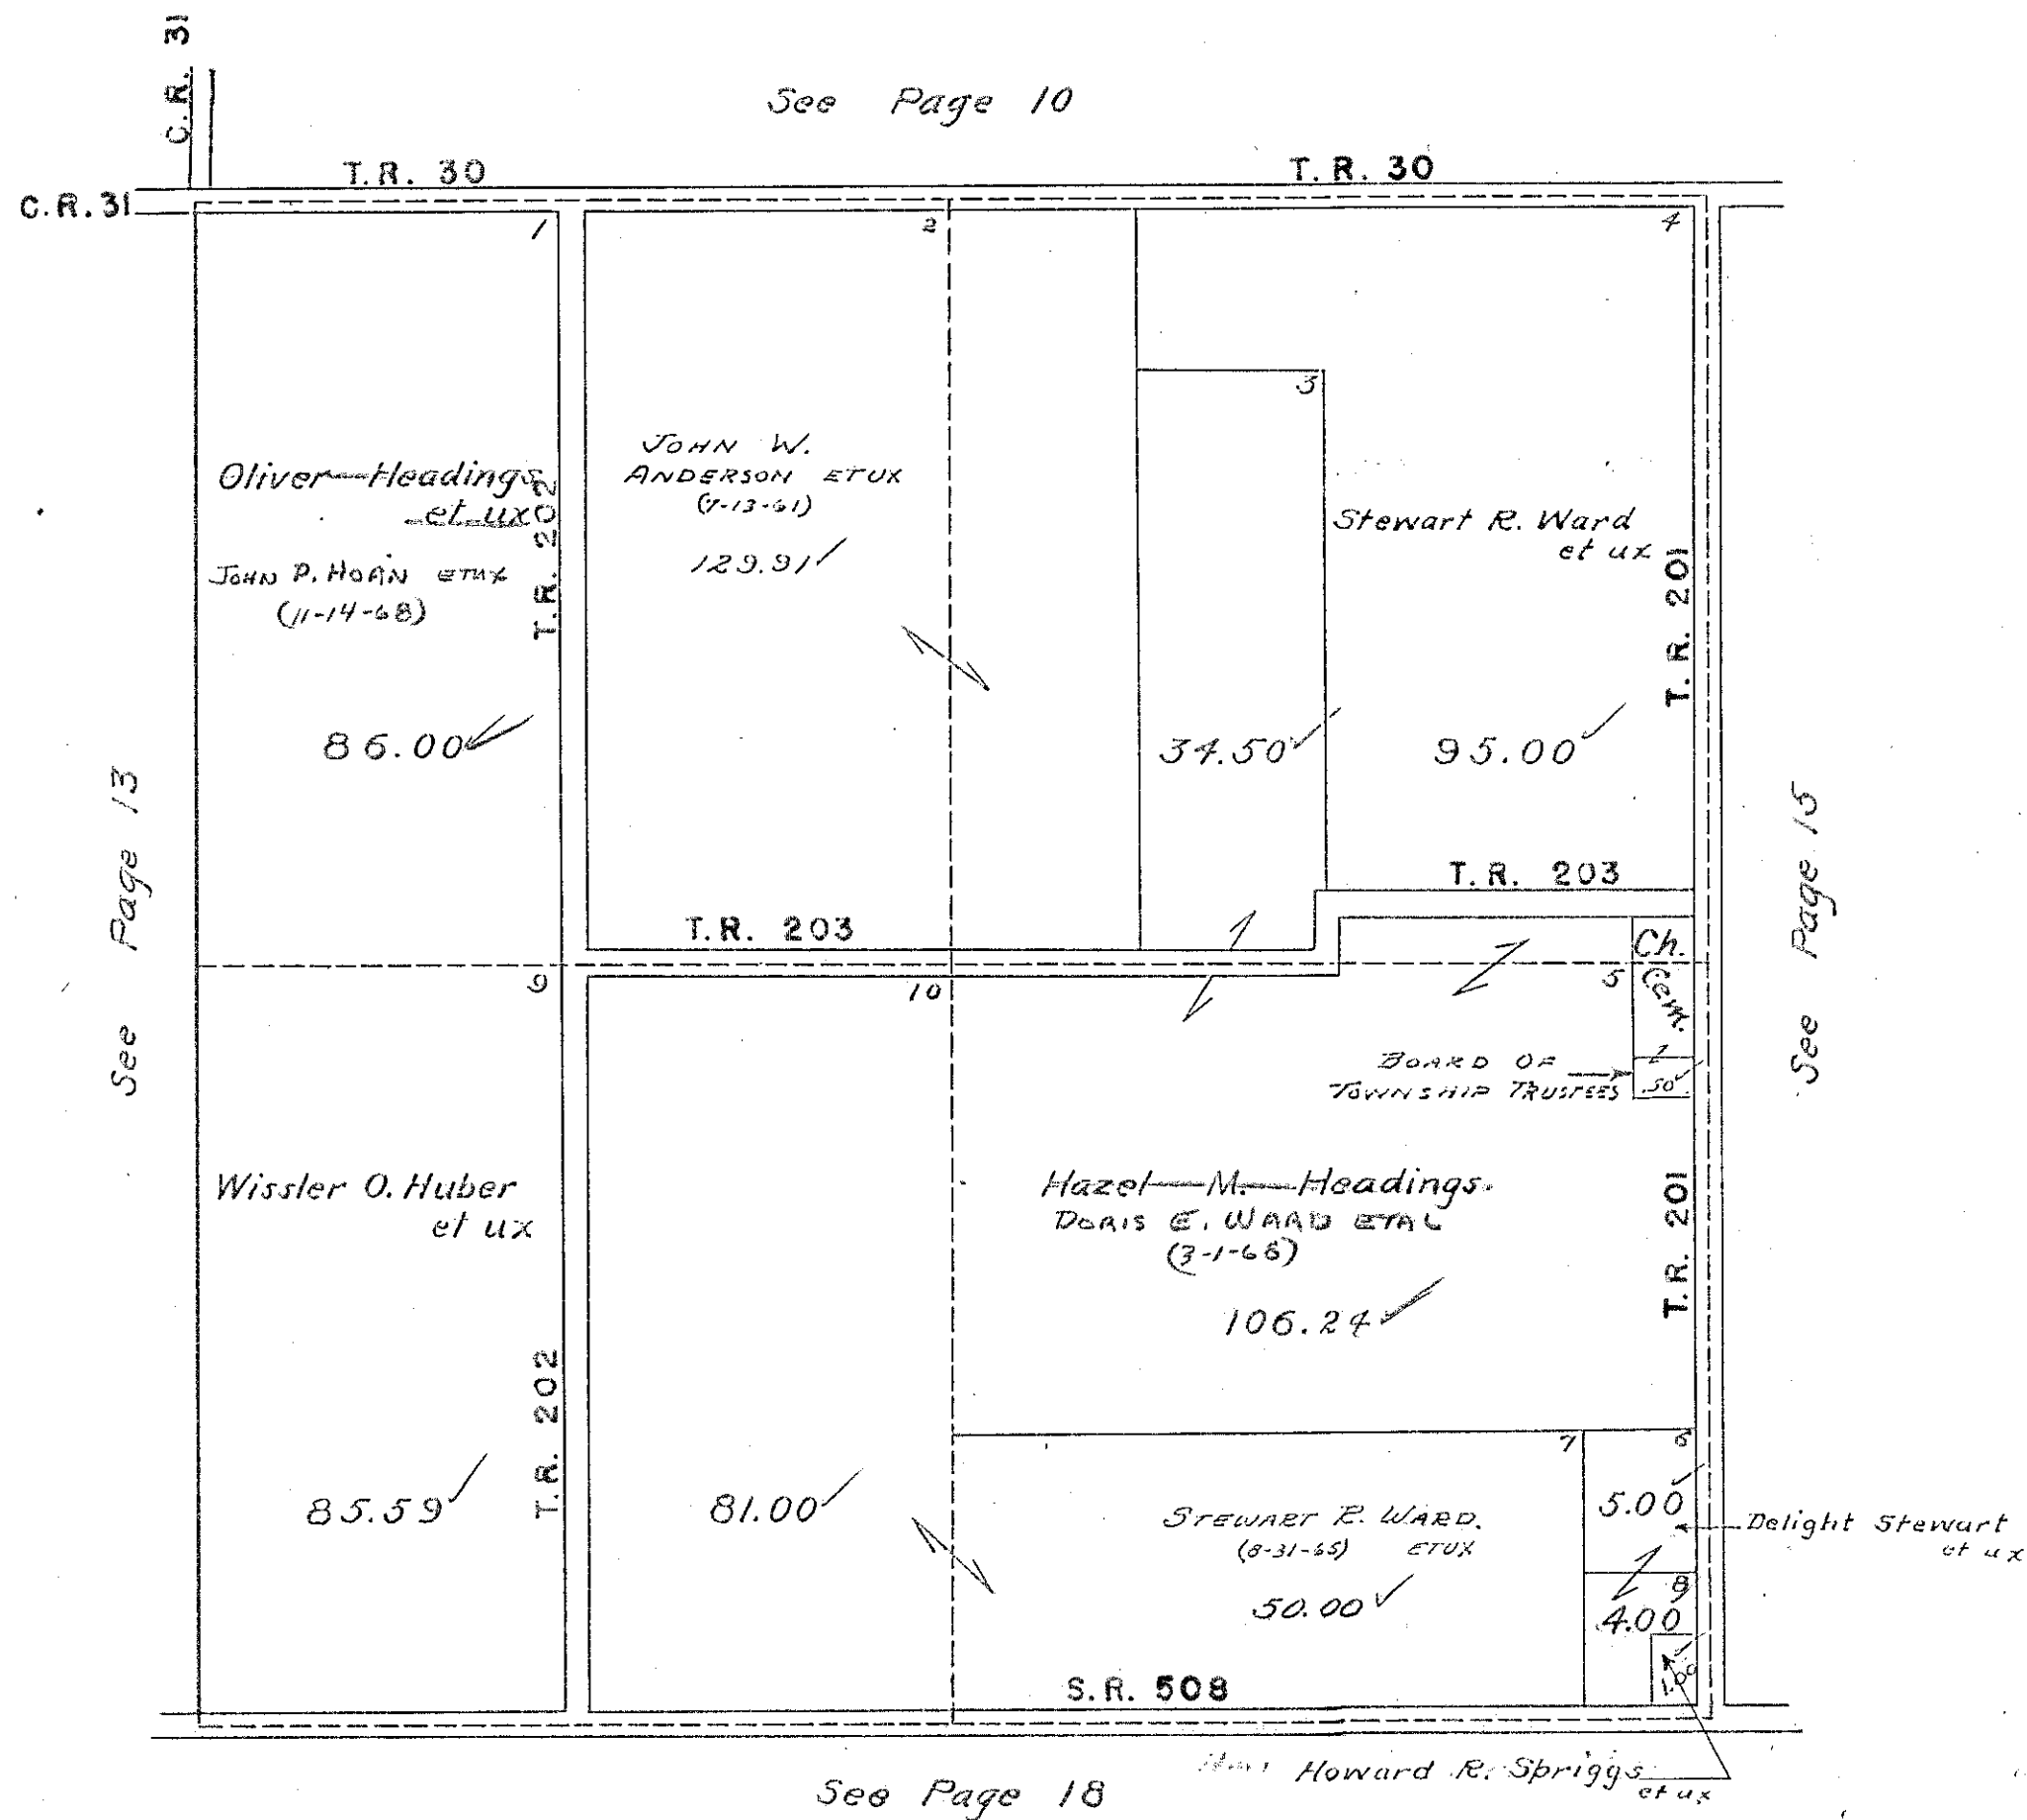

UNION TOWNSHIP  
SECTION 17 TOWN 4 RANGE 13

SCALE 10 CHAINS TO THE INCH

See Page 11

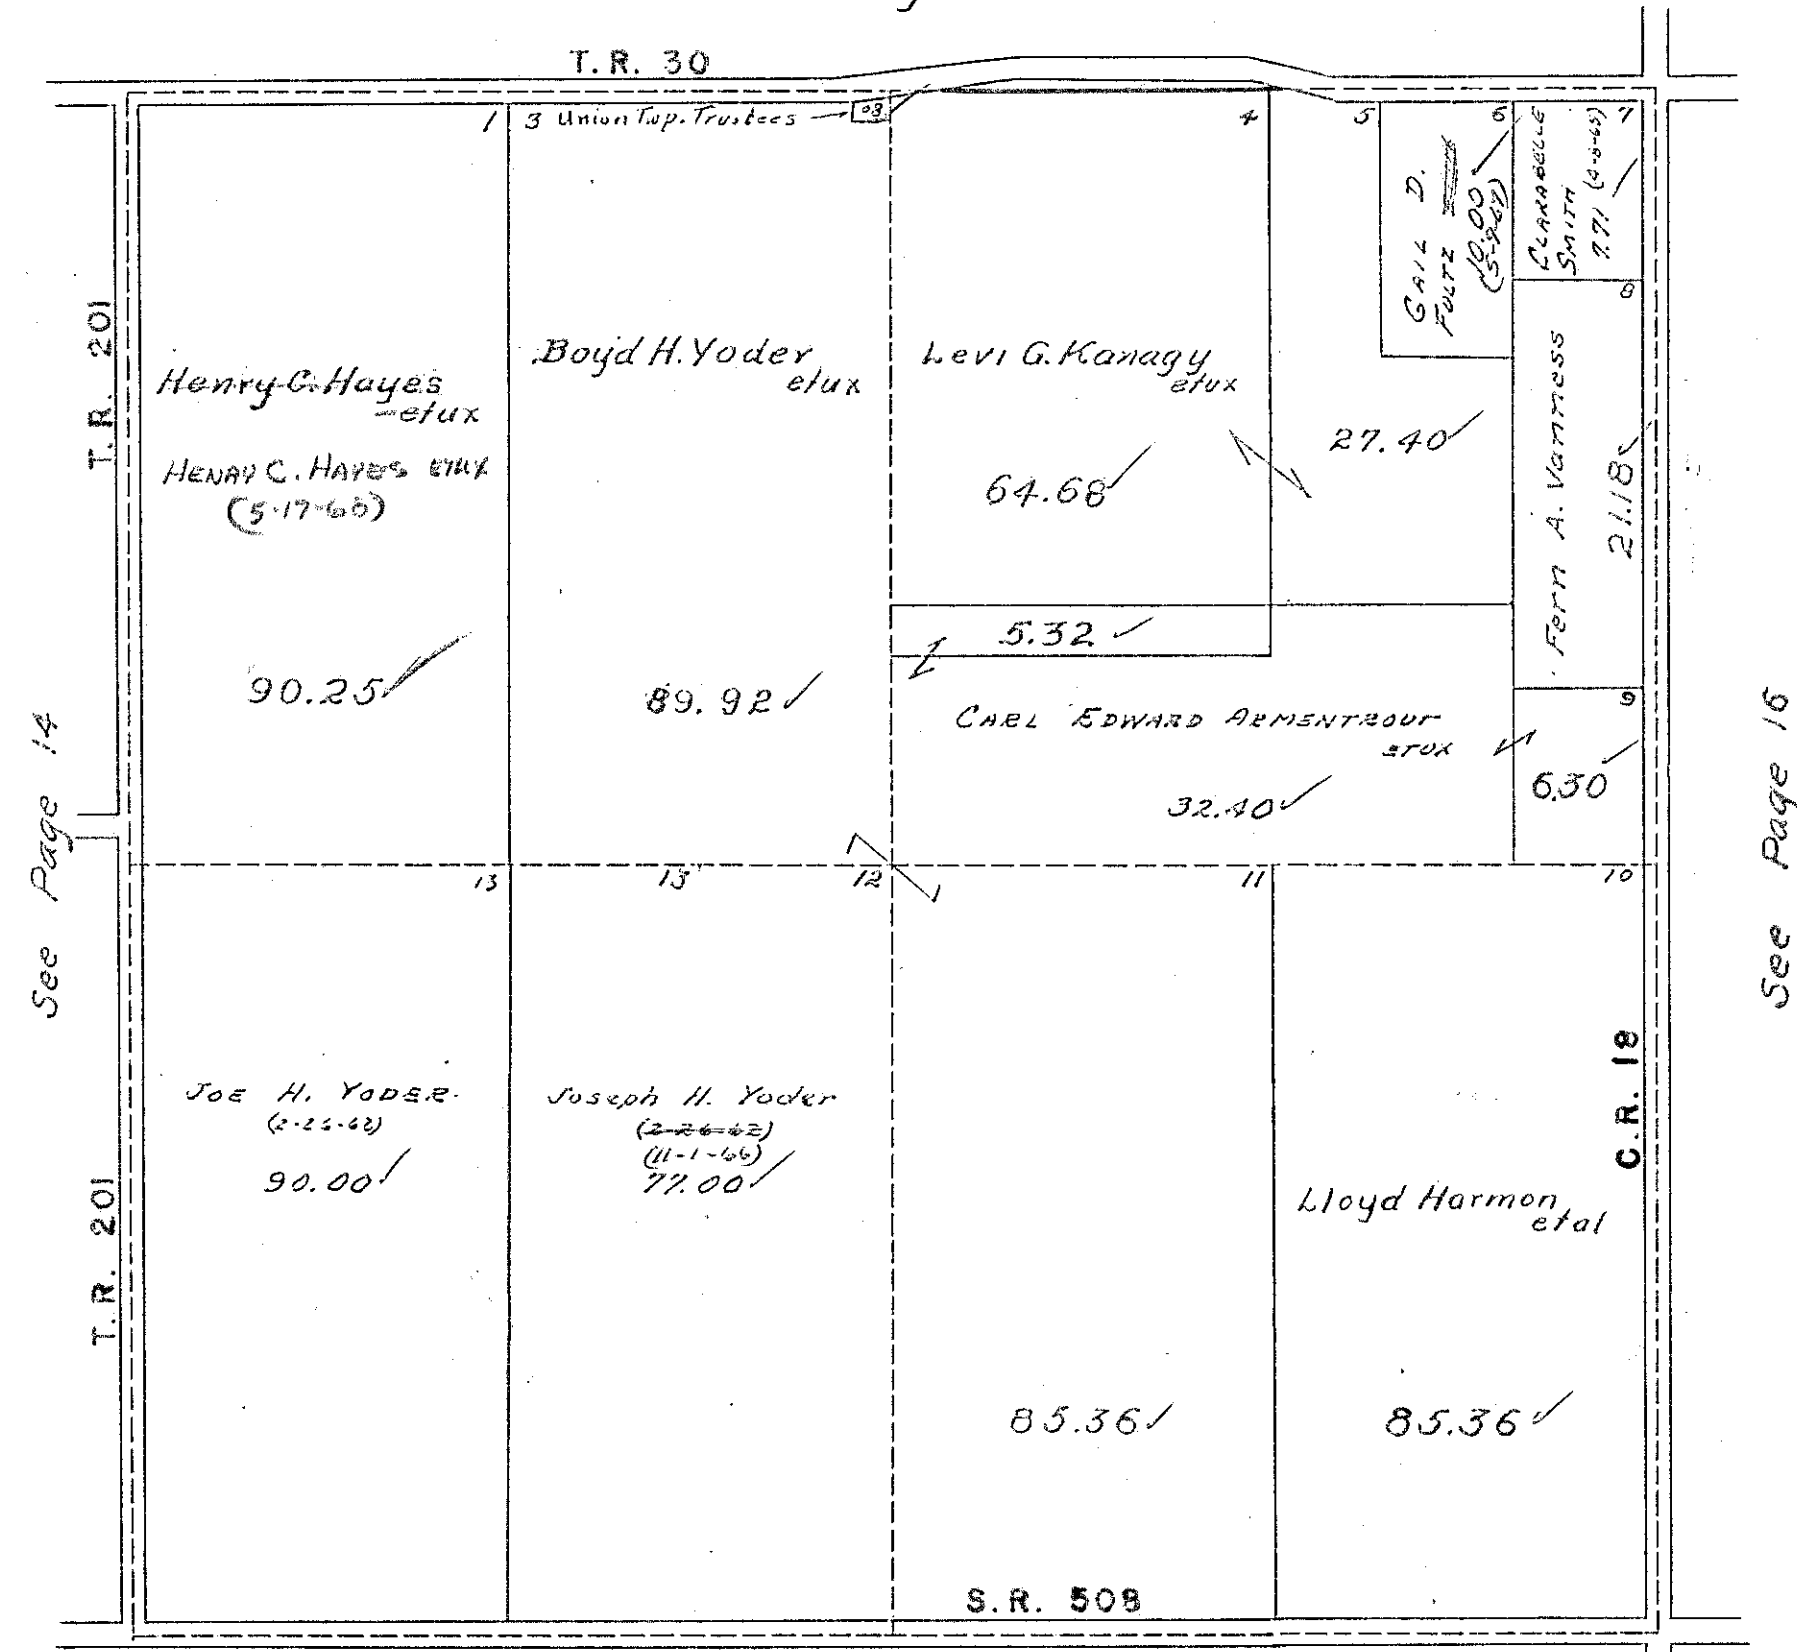

See Page 14

See Page 16

See Page 19




UNION TOWNSHIP  
SECTION 28 TOWN 4 RANGE 13

SCALE 10 CHAINS TO THE INCH

See Page 13

S.R. 503

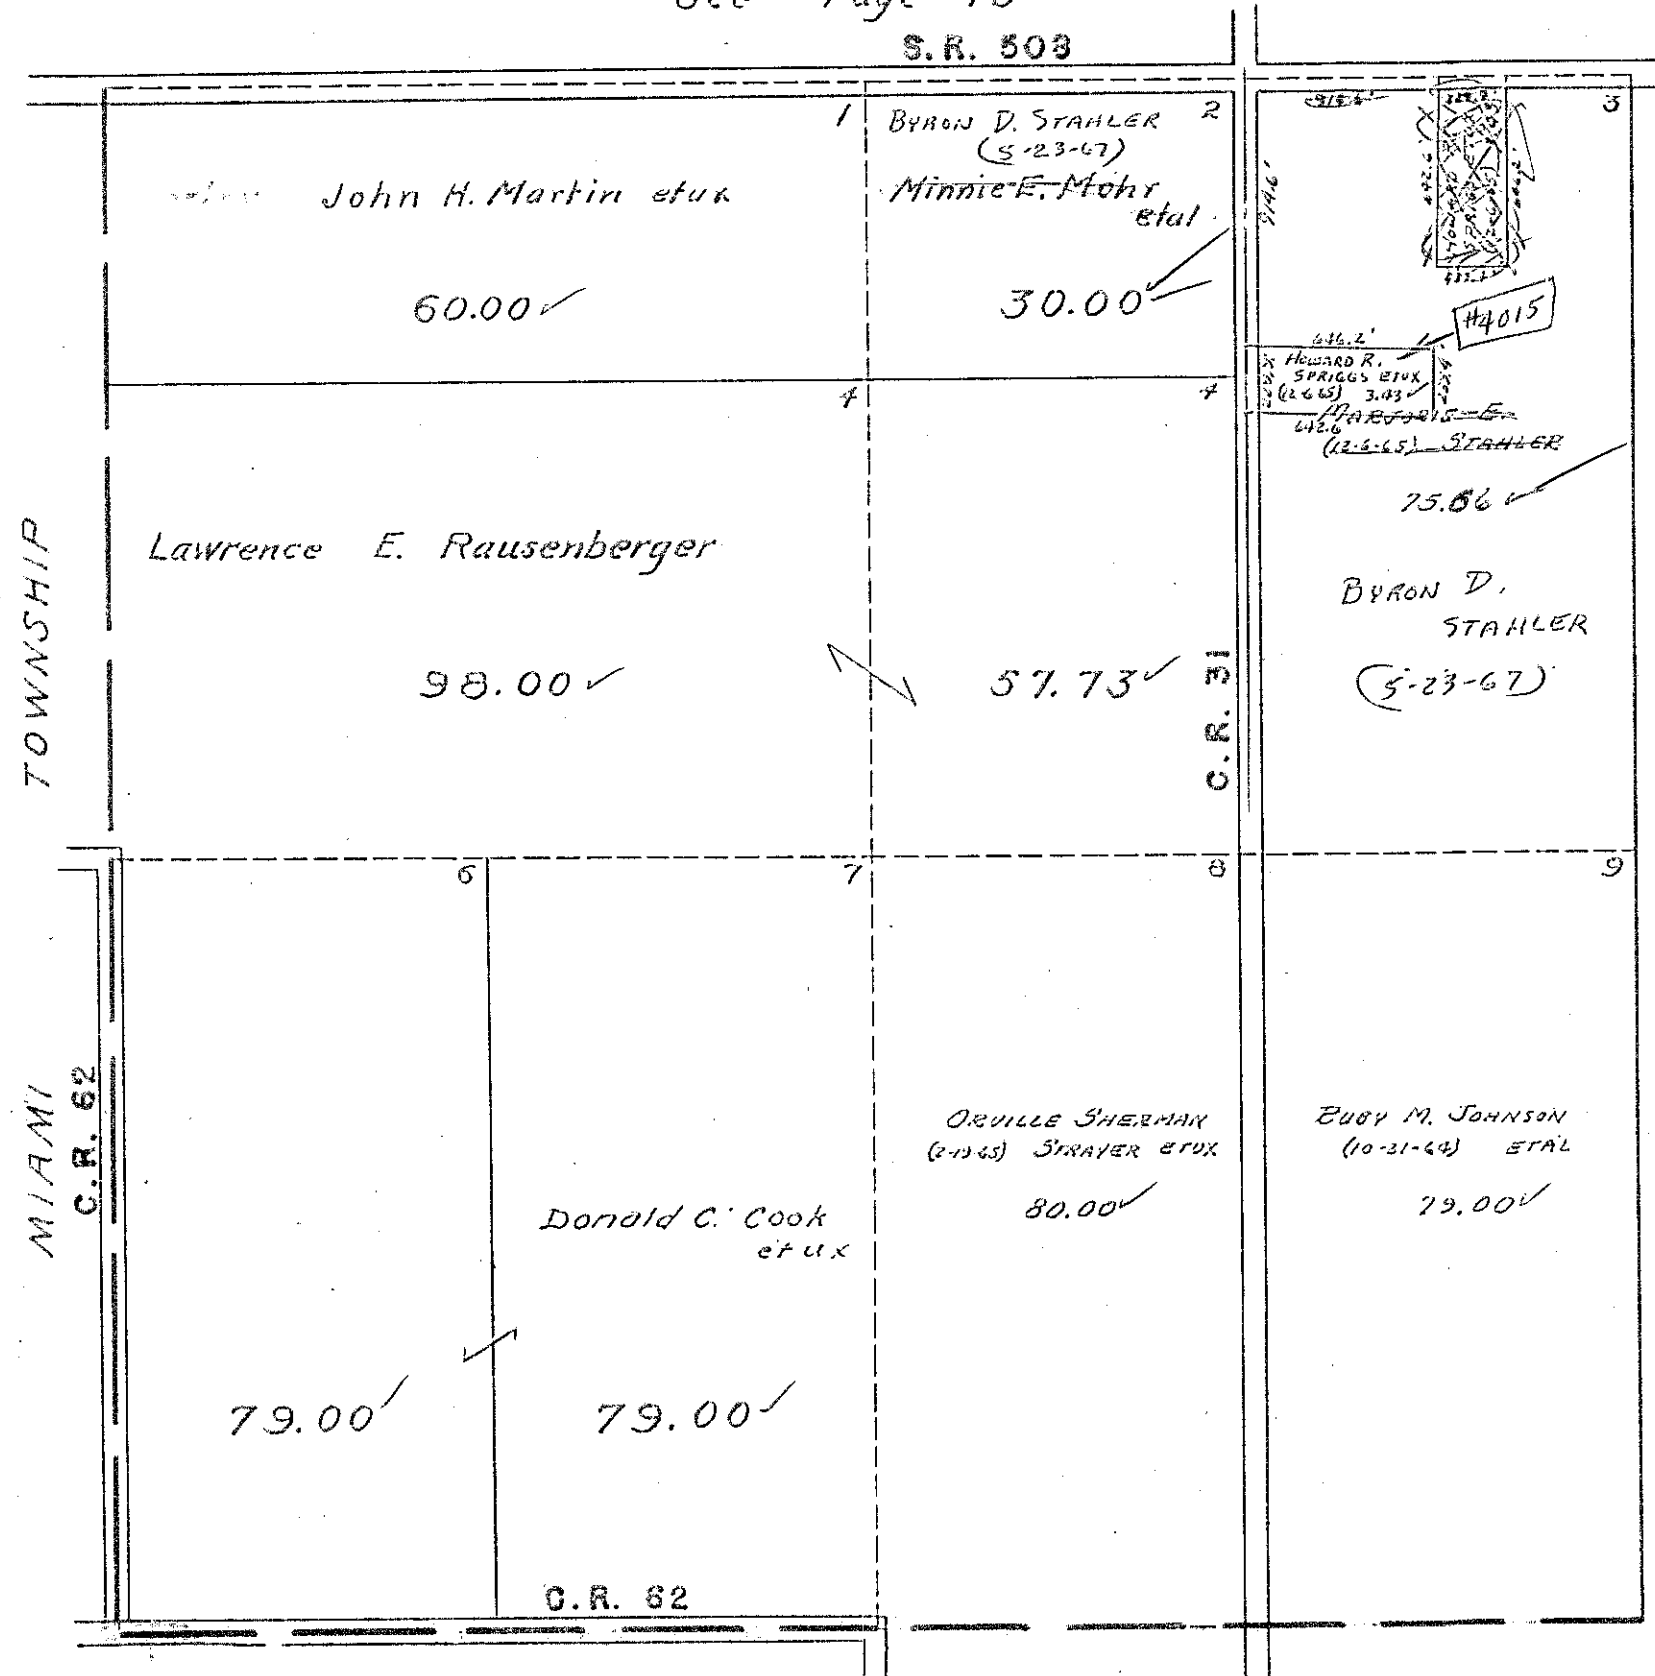


See Page 18

MIAMI TOWNSHIP  
CHAMPRIGN COUNTY

UNION TOWNSHIP  
SECTION 22 TOWN 4 RANGE 13

SCALE 10 CHAINS TO THE INCH

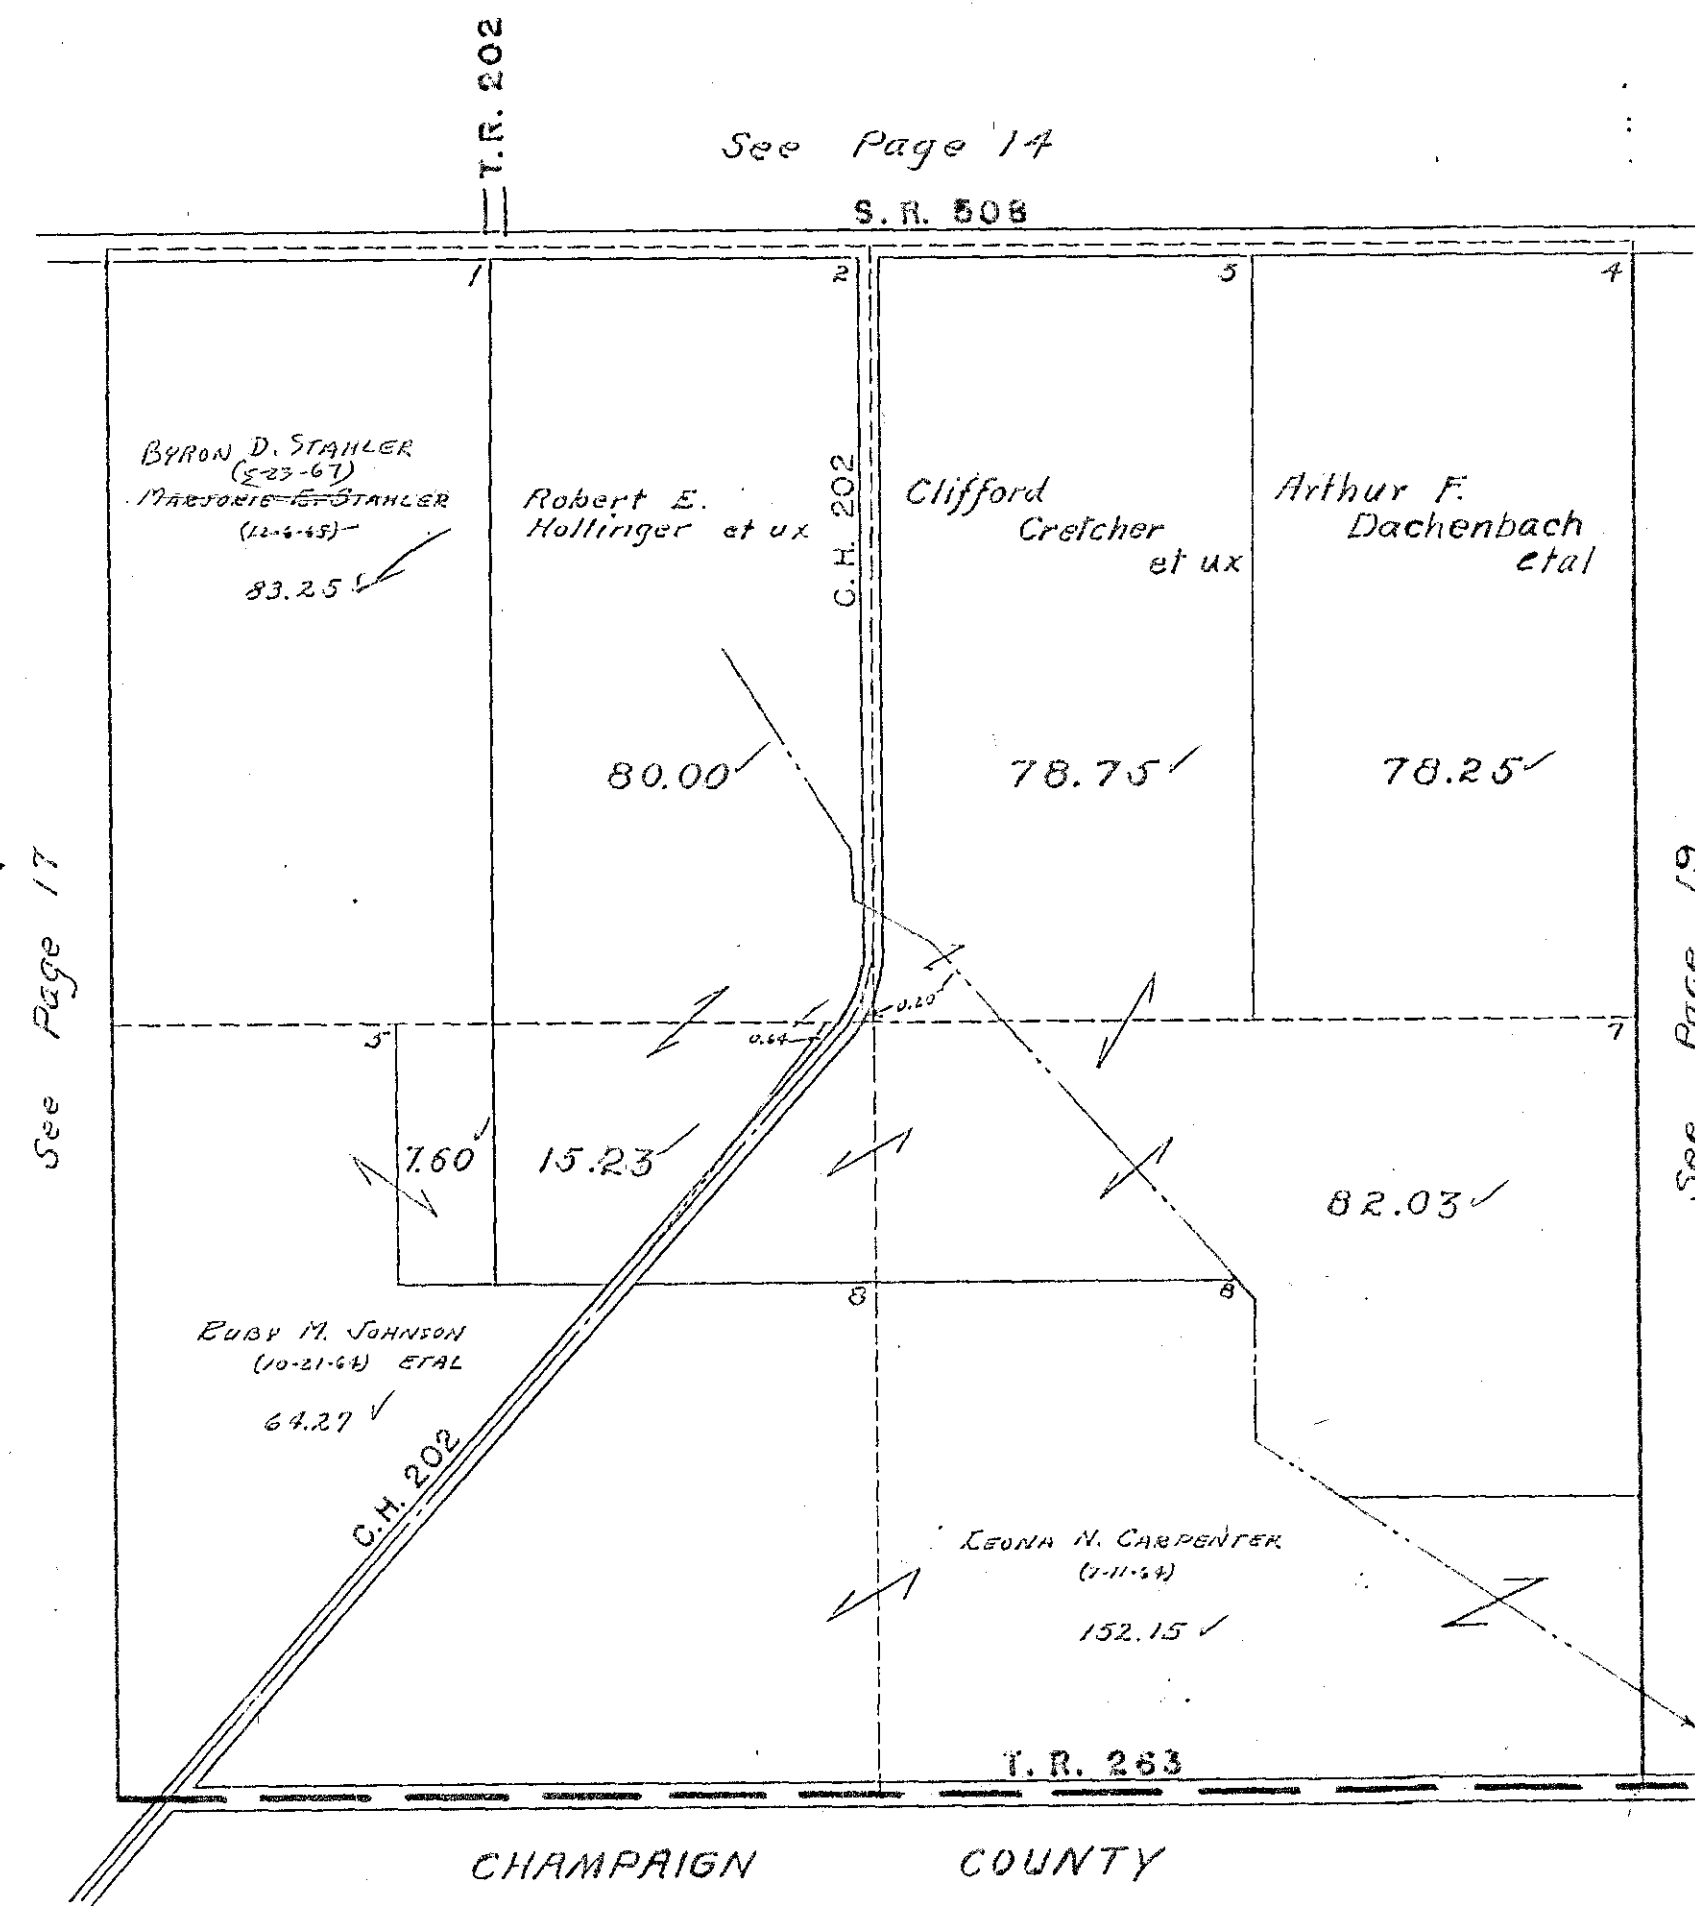


SECTION 16 TOWN 4 RANGE 13

SCALE 10 CHAINS TO THE INCH

See Page 15

S.R. 508

C.R. 18

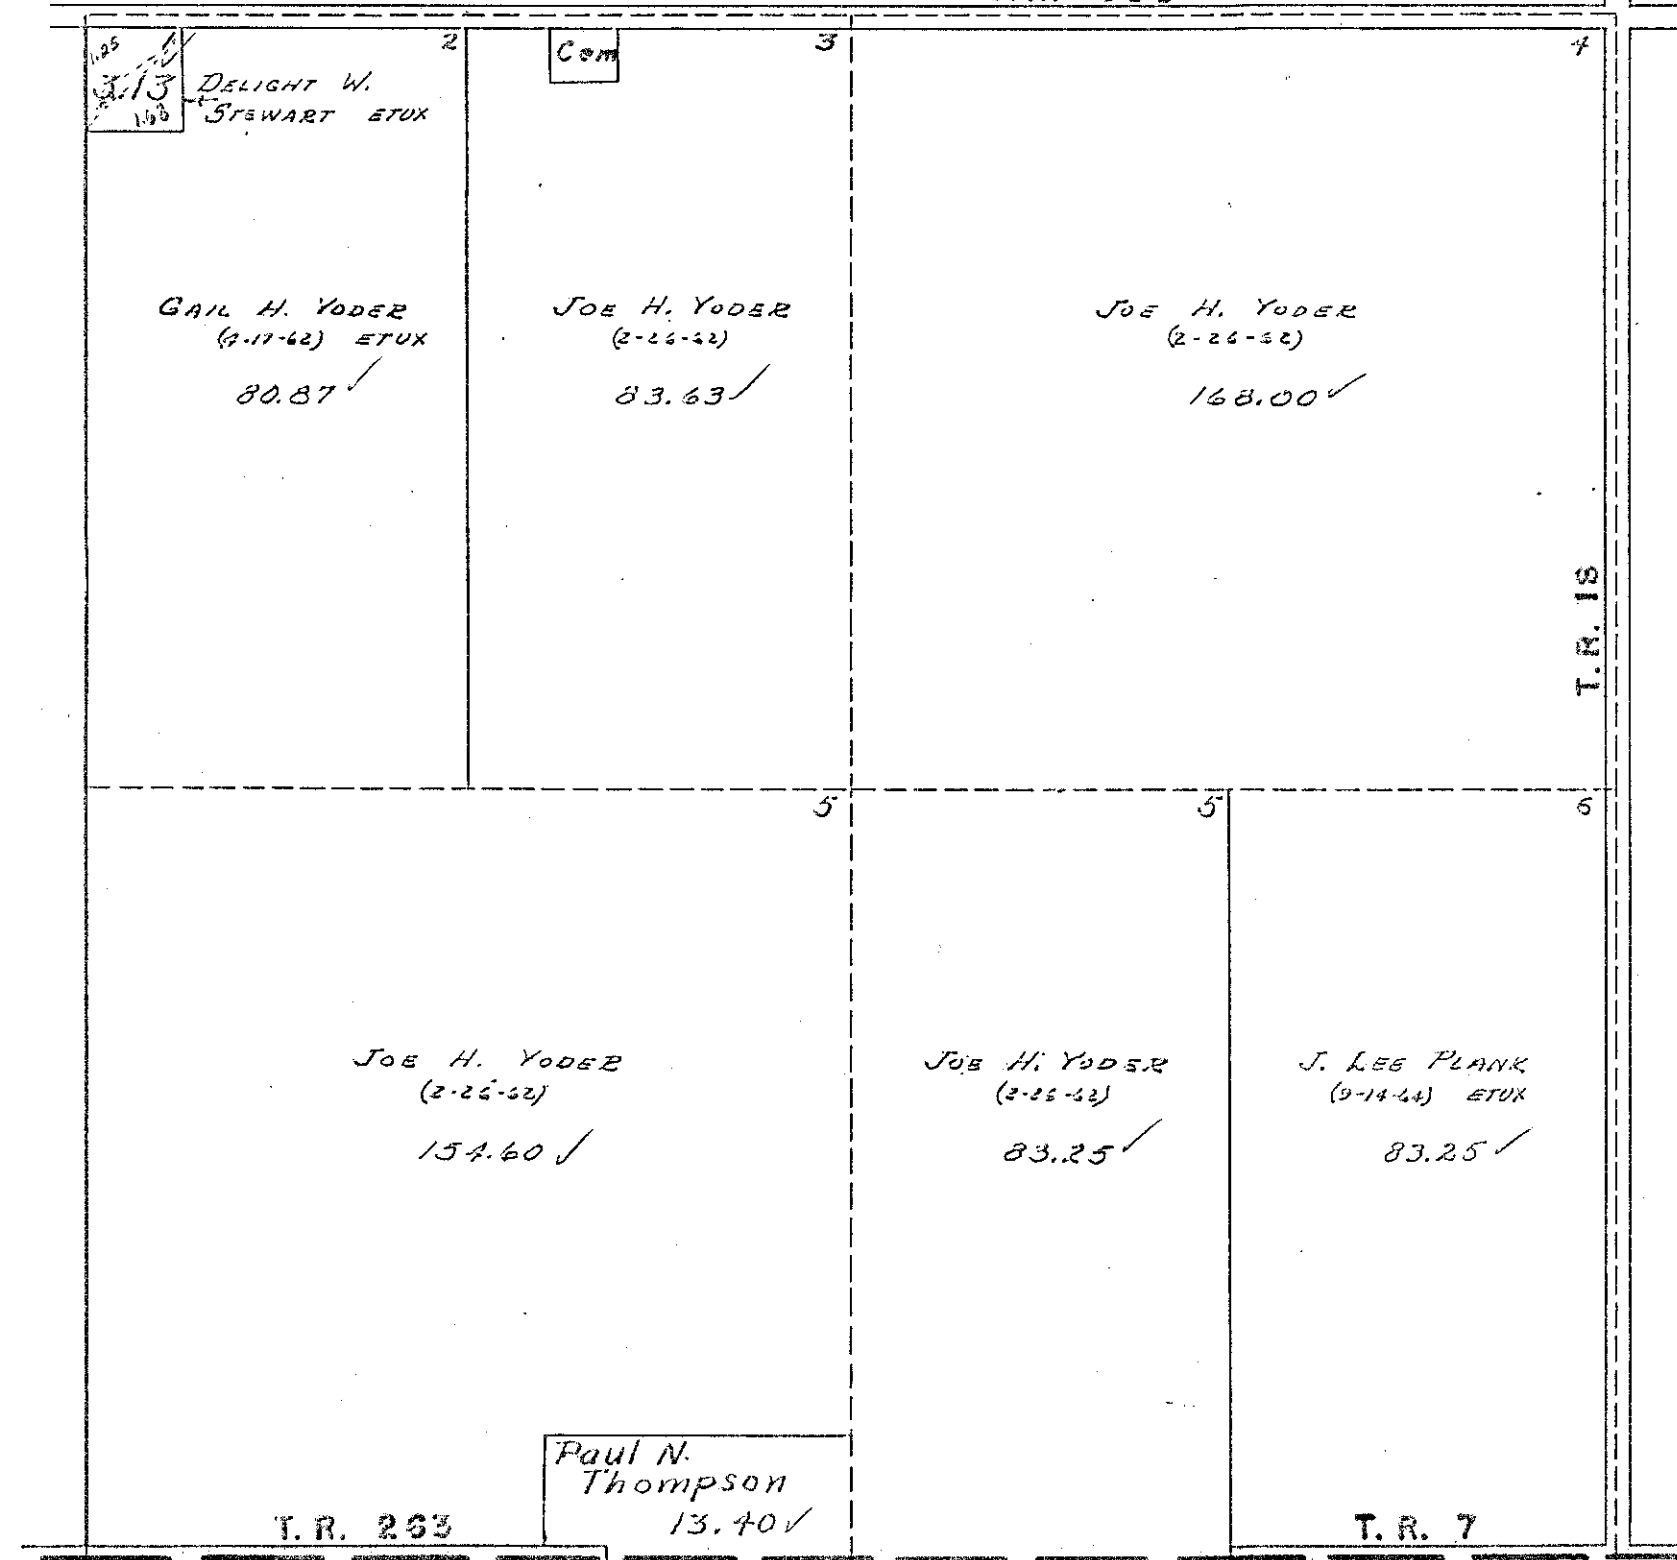

See Page 18


See Page 20

CHAMPAIGN COUNTY

SECTION 10 TOWN 4 RANGE 13

SECTION 4 TOWN 4 RANGE 13

SCALE 10 CHAINS TO THE INCH

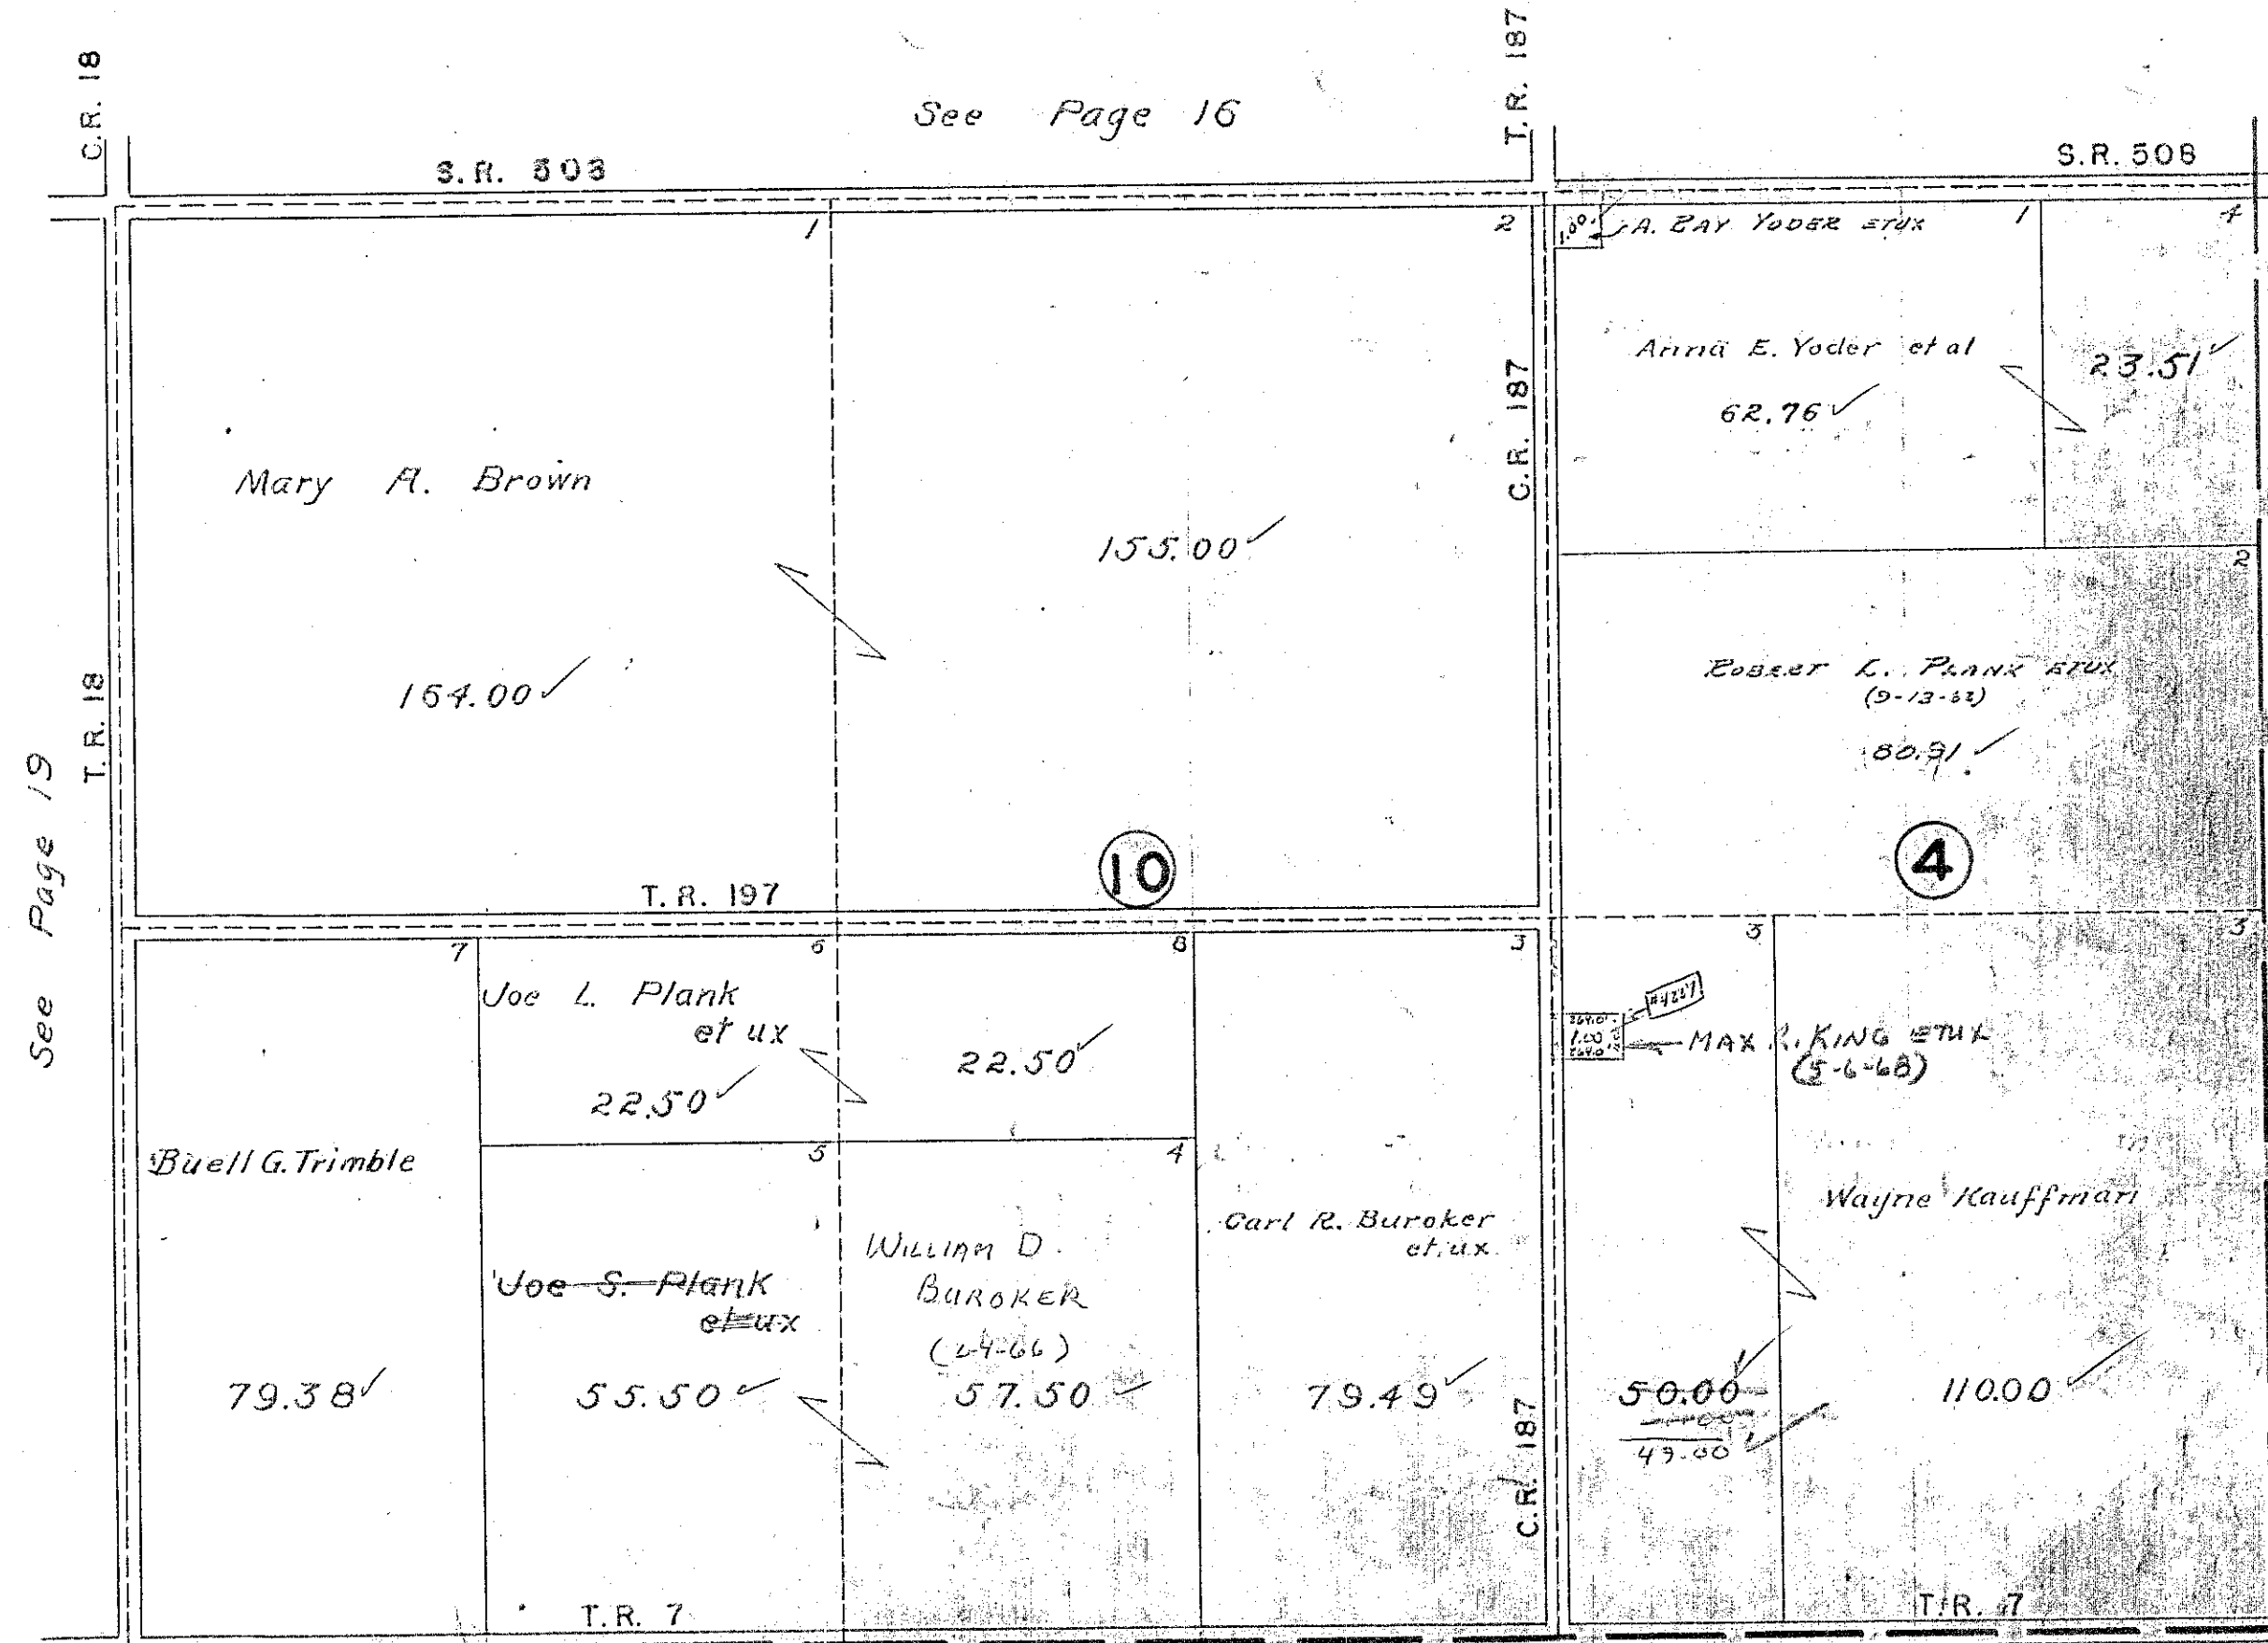

See Page 16

See Page 19

CHAMPAIGN COUNTY