

Croby Reservoir B.M.s-

B.M. 16 - 5ml Maple 300' N.E. Spencer's barn
near bank R. 53.150

B.M. 17 - Sugar 10" on E. side of fence
near bank 55.132

B.M. 18 - Walnut 30" 100' N. of fence
near bank 50.925

B.M. 19 - Locust 30" 400' N. of fence
edge of Cottonwood grove 50.978

B.M. 20 - Locust 30" 100' S. of river
bank, edge of cottonwood grove 51.099

B.M. 21 - Burr Oak 30' 200' E. of barn
on edge of ridge 51.051

Survey 1890

Lawrence - Rogers Survey

Found corner SW¹/₄ to Oliver

Fawcett's 48 acres -

Sugar 570 E 58 lks - (found stamp)

found post set for corner -

Set stone and brick bats -

with Survey line 5.46 out stake

Corrected this

May 26 - 1897 -

Line "B" with south line Lawrence
and N. line Grabel from random
stake

(581 1/2 x 45.56)

583 1/2 x 11.50 found stone and brick bat

SW²/₄ Lawrence -

4) 45.56 This line 11.40 1/2
11.39

Line "C" Lawrence's west line -

(189 x 123.01)

N 7° W 30.24 found old stone
west stone set stake under stone
with brick bat and broken tile -

Line "D"

Lawrence N. line -
(N 80 1/4 E 46.08)

N 83 1/2 E at 11.52 set random
stake also set random line
stake -

Line "E"

From Stone NW 2 9890 -
set west 12'

S 7 E

at 30.27 fence between
Rudasil and Lawrence
at 34.93 with picket fence SW 2
came out 8 east of stone set
to-day at 30.27

At 34.93 set west 2'
Continued line S 7 E

at 45.56 set stake for dist
and for line -

at 61.01 set stake for <
Lawrence and Grabil set stake
west 11 links to corner dist -
on Lawrence south line
this makes all distance
hold out O.K. came out 11'10"
too much east.

Continued line S 7 E to stone
set to-day for beginning
Came out 10'9" too much east
change this line to make it 10'10"
set & set 1 ft making Lawrence
& line 11.40 1/2

Set stone N E < Grabil & corner
to Lawrence - Roger line -
Hit: Burr oak 24" N 69 1/4 W 56 lbs.

Line "F" south line Rogers
 set north 6'
 from stone set for begin-
 N 84 E at 25.18 on stone
 Camer out 4 1/2' north-

Hit: Elin 18" S 27 1/2 W 63 lbs

Line "S"
 with Rogers east line
 set west 12' from stone set for
 corner this day -
 (S 87 1/2 E 65.34)
 N 6 1/2 W 15.50
 set stake 12' west from line as
 run in line of Grabels fence.

$$\begin{array}{r}
 4 \overline{) 65.34} \\
 \underline{16.33\frac{1}{2}} \\
 15.50 \\
 \underline{ .83\frac{1}{2}} \\
 .83\frac{1}{2}
 \end{array}
 \qquad
 \begin{array}{r}
 15.50 \\
 \underline{ 4} \\
 62.00 \\
 65.34 \\
 \underline{ 12} \\
 3.34
 \end{array}$$

Line "H"
south line Grabil land

58 3/4 ft 10.00 set stake
by fence SW. Grabil

Line "K."
Grabil's west line

A 7 3/4 ft
at 4.90 set stake for ←
to Rogers & Lawrence.

16.43 to fence line Tapp & Lawrence
Came out 1' east.

From stake set at 4.90
A 7 3/4 ft to end of line A. 90 ft

$$\begin{array}{r} 4) 42.52 \\ \underline{10.63} \\ 4.90 \\ \underline{15.53} \end{array}$$

$$\begin{array}{r} 19.60 \\ \underline{42.52} \\ 4) 62.12 \\ \underline{15.53} \end{array}$$

$$\begin{array}{r} 16.43 \\ \underline{15.53} \\ .90 \end{array}$$

Lime "M"

with Tappin south lime (52a)

S 82 1/2 W

15.01 to stone set to day

S 82 1/2 W to Tappin 52a creek

With: Red oak 15" N 31 W 54 lbs

At 45.56 of lime E -
set stone for ~~Lawrence~~
and ~~Fawcett~~

With: Sugar 12" S 16 1/2 E 44 lbs

Sugar 18" N 8 W 44 1/2 lbs

Line "A"

Random line south of 16 ams
N 82 1/2 E

Set stakes - by our measurement
through brush 15.18

Set stone for Lawrence

↳ Rogers in Gravel's line -

Ash 18" N 37 W 53 1/2 lbs

Sugar 8" S 30 1/2 W 69 1/2 lbs

On east line of Tapp from
center of road N 82
to Tapp's south line S 82
35 1/2

1

Perry 4813 Survey
Nash Banks Farm

Alex Bungy } ch -
Isaac Buffin }
Josh Dickinson Wkr -

Line A.
with east line of 18' road east
side John Outland track
N 27 1/2 W 17.43 to east gate
just Hosac's farm gate.
fence at 22' width at end of
this line.

July 30 - 1897 -

Line "B." with north line
of lane and south line 4813 -
at 7.58 stone S 82 1/2 W 4813
set south 2'

N 78 3/4 W
set stake in this line at 30.00
came out 16' 8" too far south
from stone NW 3 to H. Brown's
100 acre -
at 45.22

set stake for < to Banks at
45.14

N 78 3/4 W 20" 521 W
11 lbs dist. - (OK cor N 78 3/4 W)

$$\begin{array}{r} 16' 8'' \\ 8 \\ \hline 5' 8'' \times \frac{30}{45} = \frac{2}{3} \\ 12 \\ 96 \\ 5 \\ \hline 101 \\ 3 \overline{) 208} \\ \underline{69} \end{array}$$
$$\begin{array}{r} 45.14 \\ 7.58 \\ \hline 37.56 \\ 5' 9'' \\ 8 \\ \hline 13' 9'' \end{array}$$

Line "C"

with west line of Banks
set east 16' from stake S 112
to Banks N 11 1/4 E

set east 20'

(O.K. Cor N 11 1/4 E)

set stake in other creek
at 28.12 1/2 (112.5)

16' west of line as run —

(set this stake 15 1/2 like farther west)

16
<u>20</u>
36
16
<hr/>
20 too much west —
<u>10.23</u>
9.77 too much west
<u>4.83</u>
14.60

Line "D"

from stake in creek

S 79 E

at 9.68 pass stone supposed
to be corner to Co. acres

(Argo)

(O.K. Cor S 79 1/2 E)

set south 6'

at 27.78 came out 11.2' south of
stone corner to Argo —

	11.2
	<u>6</u>
	too much south 5.2'
27.78	<u>2.6</u>
<u>9.68</u>	7.8
18.10	4) <u>39.5</u>

(O.K. Dist 27.78 + 15 1/2 =
= 27.93 1/2)

9.87 1/2
<u>4</u>
9.83 1/2
<u>9.68</u>
.15 1/2
<u>66</u>
90
<u>90</u>
33
<u>10.23</u>

Line "E"

set west from stone 8'

N 12 1/4 E

at 1502 stone on south
bank of Mill Creek.

Came out 1' east of stone -

total crossing 9' = 13.5 lks -

(O.K. see N 11 1/4 E)

Line "F"

on south bank Mill Creek

S 77 3/4 E

495' to stone

Line "G"

N 11 1/4 E

6.53

to stone -

Line "7H"

579 1/2' E

4.73 to stone

Line "7H"

East line from

5th west from stone 6'

S 12 1/2' E

2nd east 16'

" 6'

(OK cor S 11 3/4' E)

50.38

Came out 9' west of stone

16

6

9

31

6

total writing

25'

125

375' line

Total Amount as surveyed
124.38 acres

$\frac{1}{4}$ = 33.17 acres

Length of north and south
lines of 33.17 acres =
11.79

Set stake 30' from stone Sbe
for north line of road -

on line "B"

45.14
<u>11.79</u>
33.35
<u>30</u>
3.35

Measured west from stake
set for 30 = 3.35' set stake
in line

Set stake Embury Burr Oak 20"
1.41 ch - dist

set stake N $11\frac{1}{2}$ E 30' for
N line of road -

On line "D"

$$\begin{array}{r} 9.68 \\ 15\frac{1}{2} \\ \hline 9.83\frac{1}{2} \end{array}$$

$$\begin{array}{r} 11.79 \\ 9.83\frac{1}{2} \\ \hline 1.95\frac{1}{2} \end{array}$$

Measured each from stone
1.95 $\frac{1}{2}$ 579 $\frac{1}{2}$ &
cut stone ~ line.

Mt	N&S	Embry	
Ash	16"	523 $\frac{3}{4}$ &	916 $\frac{1}{2}$
"	24"	558 $\frac{1}{4}$	108 $\frac{1}{2}$

Cross-section Survey

Line "A"

from stone in barnyard
to fence post < to front
set stakes

5 3/4 E

1.11

Line "B" with south side of corner
from post front N.E. <

N 86 1/2 W 25.50

to stone cor to front



2 1/4

1 1/2

Aug 31-1897-

Line "C"

S 1 W 9.72 set stake

set this stake west 30' E

to make correct distance to
east rail of R.R.

O.K. case (S 3 W)

Line "D"

~~N 86 1/2 W~~ N 86 1/2 W

5.30 set stake on east bay

measured 5.40 north with

R.R. from Jonas Godwin line
for this corner.

Line "E"
with East Rail set east
60 links from rail -
N $9\frac{1}{2}$ E 6.00

With R.R.
40' line from east rail west -
N $7\frac{1}{2}$ E 5.00 (11.00)
at 11.11 - $\frac{1}{4}$ sec line -

Set north from $\frac{1}{4}$ sec <
(T iron Jordan) 30'

With R.R.
set west 40 lks from east rail
N 6 E 6.00 17.00

With R.R.
N $3\frac{3}{4}$ E to Humphills fence
line 7.72 (24.72)
Set stake at end of R.R. tie -

Line "F" North Line Crivston
Center R.R. to center Pike
2816 586 1/2 E
set stake at west side of pike
grade
Came out 3' too far north
O.K. case -

Isaac Crivston Wks
Will Wright } ch.
Omar Holtz }

Line "G"
with pike -
53 1/2 E 13.81

Line "H"
from center pike to
stom in Crivston's backyard
49.82

Line "K"

with $\frac{1}{4}$ Sec line

Set north 30' from both ends

~~588 3/4 ft~~

586 ft

N&S barn 7" north of line

NW 7" south " "

at 29.67 from stone in
barnyard to east rail RR.

to center RR. 29.70

Bunker Survey

Line "A"

Start stone NW sec -

Hit: Cottonwood 8' S 28 3/4 E 36' lks

N.O. 16" N 25 1/4 W 43' lks

with pick N 88 3/4 E 48.28 to stake

Hit: Red Elm 8' N 56 W 7 1/2'

Pig hickory - 6' S 33 1/4 W 9'

Chain carrier

E. Berman

Lon Bannhart

Markus

George Bunker -

Sept 2 - 1897

Line "B" with River

S 6 1/4 W - 17.18 set stake -
south bank River creek -

Line "C." S 29 3/4 E 1.57 1/2
set stake -

Line "D"

S 10 1/2 E 836

set stake -

Line "E"

S $5\frac{3}{4}$ W

1977 = set stake

Line "F"

S $12\frac{1}{4}$ W

3.65 $\frac{1}{2}$

set stake

Line "5"

S $19\frac{1}{2}$ W

2.94

set stake -

Line H. S 35 W 6.78

To $\frac{1}{4}$ sec \angle as set by Line

Line "K"

S 37 $\frac{1}{2}$ W 2.87

Set stake - 1

Line "M" S 34 $\frac{1}{2}$ W

3.82

Set stake

Line "A"

S 26 $\frac{1}{2}$ W 3.10

Set stake

Line "O"

S 14 $\frac{1}{2}$ W 5.41

Set stake

Line "P"

S 10 N

5.44 1/2

set stake

Line "R"

S 10 N

5.35

set stake -

by old fence

5.35 -
5.44 1/2

10.79 1/2

Line "S"

S 19 N

5.52

Line "T"

S 33 1/2 N

7.53

set stake -

Line "U"

S 26 1/2° W

5.88 1/2 to SW sec -

Dist: Pigson Oak 24' S 70 1/2° W 9'

Slingshot 12" S 56 1/2° W 20' 8"

Line "V"

West -

Set south 6'

" north 15'

" " 8'

25.30 to stam

camp out 28' north of stam

O.K. case. S 89 3/4° W

pass fence at 24.63

width of lane running west to pasture
49 lbs

Line "N"

most kind of jam from stam SW sec

Sec (swamp 6') North of W -

at 14.60 N. end of jog to

Roach 46 lbs weight

set west 8'

at 40.32

came out 18' west of stam 1/4 sec

< total weighting 14'

Line "X"

set rail from 1/4 sec < stone
10'

N 1 1/2 W

set west 20'

at 50 sec - 40.32 = 40.28

came out 27' too much west.

OK cor. N 1 1/4 W

27
<u>10</u>
37
<u>20</u>
17'

Bunker Survey

Measured north from
 $1/4$ sec \angle stone at west line
 $N 1 1/4^\circ W$ 6.01 1/2 set stake
 for line between farms -
 set east 10 lks -
 set stake in line

Sept - 3 - 1897 -

On division line

$N 88 3/4^\circ E$

46.56 strikes River line
 at $85 1/2^\circ$ north of end of line "3"

This line was calculated
 46.48 and intersected
 river line at 74 lks north of
 end of line "3"

Correct to make line at intended
 as calculated 74 lks $N 19 1/2^\circ E$ from
 end of 3.

Corrected stake set at
 10 ch distances as follows:

$S 19 1/2^\circ E$ 11 1/2 lks = $S 1 1/4^\circ E$ 10.8
 (Vertical component)

$$\begin{array}{r} 46.5 \overline{) 10.50} \quad 2.3 \\ \underline{930} \\ 1500 \\ \underline{1395} \end{array}$$

Correction of line as
sum —
N 88 3/4 E

Stake 1 - 10 ch	set south	23 lks
" 2 - 20 "	" "	4.6 "
" 3 - 30 "	" "	6.9 "
" 4 - 40 "	" "	9.2 "

Set stone at River line
ditto elm 6"
N 69 1/4 W 30 lks -

Set stone west end of
divine line -
Shil stick 10" N 65 1/2 E 67 lks
White elm 30" S 65 1/4 E 45 1/2 lks

Dr Pratt's line

North Main St.

Part of lot No. 135-

East end set stake north
line lot 135-

Pratt's stable is north $4\frac{1}{2}$ "

35' south of north line
Crawford's stable is 7" north

West end at Main St.
center of wall south line
of Pratt is 35.17' from
Pratt's north line -

Reed's house is 8" south
of Pratt's ^{fence} north line -
" $10\frac{1}{2}$ " "

Mrs. Herzbergs Lot

lines Sandusky St.

Sept - 30 - 1897 -

Main to Detroit on Sandusky

528.75

Main to Detroit on Brown

528.6

528.75

528.60

528.64 at alley.

526.05

2) 2.18

4) 1.09

.27

Make lot line 75 x 86 -

110.54' from E. line Det.

Make west line Alley -

211.08 from E. line Det.

- On Sandusky.

528.6

526.5

2) 2.10

4) 1.00

.26

40

440

30

16 1/2

526 1/2

Make line lots 75 x 86 -

110.52 from E. line Detroit

Make line Alley 211.04'

from east line Detroit -

110.52

55.26

165.78

30.

195.78

Walter Roebuck's line

Lin Heffner & Roebuck

Lot is 55.26' wide -

Roebuck's stakes in back lot
are measured 27.63' from
east line of lot

Stake at grape arbor on line

" south of privy " "

" near apple tree 5' east
of line - could not drive stake
in line for fence.

Buckwalter Survey

Line A.

Start from Harrowtooth in center
Huntersville fence and in line
south fence Anderson Mrs
Lane.

N 89° E with lane fence
at 17.94 corner just in Mrs
Lane fence.

Line "B"

with fence east side Mrs Lane
N 3 1/2° E 3.75 1/2

Jan 7-1898-

Line "C"

with south line Mrs Lane
N 79 1/2° E 15.98 to stake set
on south side Mrs Lane

39 lbs dist from old \leftarrow stone
N 72° to Mrs 10 acre tract
N 16° to stake N.O. 24" N 64 1/2° 73 lbs

Line "D" with west line Mrs 100
run 8' west of line
S 4 1/4° W

12.98 1/2

to stake N 10° stump 30"

S 74° 11 lbs

N.O. stump 22" N 24 1/2° 21 lbs

produced line "D" 20.72 to stone
S 6° to Buckwalter \leftarrow corner out
27 lbs too far west.


Total writing 10' OK case S 3 1/4° W

On Buckwalter east line

Branch fence N 2 1/2 E

Old branch N 7 1/4 E

5 1/2

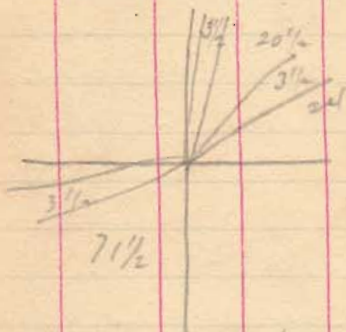

N.O. 30° S W 2 N Now S 7 1/4 W

N.O. 22° N 20° E Now N 24° E

N.O. stump 30' S 7 1/4 W 11' clear

N.O. " 22' N 24° E 21 "

Line "E" south line from
from Stone S 8°

set north 8'

N 66° W OK cor N 85° 3/4 W

set stakes at 26°

at 26, 38 set iron bar in center
fence -

came out

Line D with Huntsville fence to
Junction of Sawatow fence -

N 37° W 1.47

set iron bar -

hit South Locust N 18 3/4 W 143 clear

Line "J"
with Lewis & Clark pick
N 63 W 14.32'

Line H. with Ry.
N 11 1/2 W 14.46
set spike in tie

Line "K"
S 88 E 11.87'
to center Hunterville pick.

Line "M"
with center Hunterville pick
N 11 W 3.35'
to iron bar begin line "A."

Line "K"
with Huntsville road to end of
line "H" —

S 10 1/2° E 20.61

Jan 24 - 1898

Hit iron bar MR 2 to

Johnson

Walnut 28" N 20 1/4° W 2.43 ch -

Frank Wade Survey

Feb 18 - 1898 -

Line "A"

Start from stake set by self
S.W. 1/4 to Wade in center

Pick road S.W. 1/4 Buffington

Set west 8'

N 4 1/2 E

at 19.20 pass fence supposed to
be north line south part of
farm -

at 21 to 22 cross Mad River

at

S 6.57 1/2

stake on south side of ditch
set new stake by old one -

Line "B"

with north line of farm
set south 12'

Set stake at 1700 on east
side of ditch.

S 87 3/4 E

set stake in line -

Line "C"

with rest line from
set 12' east from stake
set for 17 ch.

S 4 1/2 W Rk Cor. 55 W

at 17.82 east end of
Brimble & Buffington fence
(line)

at 37.57 set stake in center
road on south end in line
of fence sec. line south of
Dodd line look & back

Line "D"

with road on south
R 24 1/2 W

at 16.65 1/2 begin -

36.57 1/2
87.57

87.07) 300000 (80
29656

3440

37.07
34.57

2) 7364
36.82) 300000 (818
29456

5440
36.82

17580

18410

Iron bar set at S112° E of
Track Mt:
S112° Wadi's house
N 29 1/2° E

Set S82° Wadi
at 8.15 in Great Pit road
set iron bar in line
set stakes north and
south 15 lbs from bar

8.15

16.65

Hungstetter Survey -

Line "A"

Start from stone set at SW
Corner -

Thence 54 ft 2.26
to stone set to-day 3 1/2 lines
west of stump.

Line B -

Set South 12'

488 ft O.K. Cor. 188 ft
at 6.55 684 center of Dr. Groff
Pile.

Set stake in line -

Set north 2'

at 3623 Set stake by eye - 16"
from old root -

Mark made same -

over line as sign came out

5' too far north

total northing 15' -

March 9 - 1898 -
Chas Hungstetter } ch cr -
Silas Dodd }
Line "C" with iron -

533 1/2 3.70

Set stake -

Line "D" with iron

576 1/4 2.23

Set stake.

Line "E" with iron

461 1/2 2.22

Set stake.

Line "H" with river

139 E 2.35

set stake.

This corner is about grade
south of line "B".

Line "G"

544 $\frac{1}{4}$ E 5.95

set stake.

Line "F"

532 $\frac{3}{4}$ E 4.60

set stake

Line "E" with river

57 E 4.53

set stake.

Line "D" with river

529 $\frac{1}{2}$ E 4.02 $\frac{1}{2}$

set stake.

Line "C" with river

588 $\frac{1}{4}$ E 2.20

set stake.

Line "M" with river.

S 19 1/2 E 3.74

Line "N" with river

S 14 1/2 E 8.40

Line "O" with river

S 47 1/2 E 1.93

Set stake for \angle Houghton
& Higginson N.W.:

Old Hick stump N 39 1/2 W 12 1/2 W

Low oak stump S 10 E 28 1/2 W

Line "P"

S 87 1/2 E 23.04 ab to stake

center of pipe -

set north 6'

came out 5' north - southing 1'

Line "Q"

with pipe - N 29 1/2 W

11.01 set stake -

Line "R"

Set south 18'

S 85 1/2 E O.K. Cor S 85 1/2 E

came out 15 1/2' south of stake

set for corner at - 18.32

Line "S" with $\frac{1}{2}$ sec line
from stake to stone SW $\frac{1}{2}$ to
40 acre track.

N $4\frac{3}{4}$ E 2.17

Line "T"
with south line 40 acres.

S $85\frac{3}{4}$ E 20.13 $\frac{1}{2}$

Set stake at turning in fence
southing S'

Line "U"

N $3\frac{3}{4}$ E set west. 6

20.07

to stone NW $\frac{1}{4}$ 40 a -

came out $8\frac{1}{2}$ ' west

total westing $2\frac{1}{2}$ '

Line "V"

with north line 40 acres

set south 12'

N $84\frac{1}{2}$ W

came out 12' south of stone

at 20.27

Line "H"

Set south 6'

on north line

A 85 3/4 W

24.80

came out 14' south.

total southing 8'

O.K. Cor. A 85 1/2 W

On road - north line
Set to line - changed stake
Set south 2' 10"

$$\frac{6.85}{36.23} \times \frac{15}{1}$$

$$\begin{array}{r} 6.85 \\ 15 \\ \hline 3425 \\ 685 \end{array}$$

$$\begin{array}{r} 3623 \overline{) 10270} \quad | 2.8 \\ \underline{7246} \\ 30240 \\ \underline{29987} \end{array}$$

Frangstiller

With road from stake
in north line

S 30° E 24.07 to stake
in line to line from east

Monuments, N. Main St.
(from City Eng record, p. 83)

N. line Corporation - Iron bar.

Wit: Telephone pole E, 21' 55"

Maple, 15", S of W 29' 90"

997.7' south of Corp. line, Ang. R. 9° 46'
Iron bar. S.E. < house, 42.75' N.E. < house, 50.8'

1242.2' S. of Corp. line (Ang. R. 1° 58') Iron bar.

Wit: S.W. < house foundation, 41.9'

N.W. < " " 44.6'

1367.7' S. of Corp. line (Ang. L. 23° 32') Iron bar

Wit: Crooked W.O. N 59° W, 32' 4"

Leaning R.O. S 72° W, 74' 2"

M. C. Boals N. Main

St. Property

April 13-1898

Line A. with west line from
stake between two large stones
south corner to post at
Ludlow line

N $4\frac{1}{2}^{\circ}$ E 662' 661.5

Length to intersect west
line Main St. 606.2.

Line B. from iron bar
set for center of Main St -
measured west at right angles
30' N 28 E

intersected said line at south
end with Boals west line
set stake

N 11.0. S curb 20" 572' 4" 6.2'

at $5\frac{1}{2}^{\circ}$ stake opp iron bar
angle of road

Line C.

N 26 1/2 E on west line street
225.7' to stake set in
Boyle dr. line.

5.6' west from stake set for

254

5.6

248.4 length of north line

Bringing north line
N 82 1/4 W

Wit 562 No. 5-

Maple 10" N 82 3/4 W 3.8'

" 6" N 23 1/2 E 11.0'

Wit: 562 No. 6-

Ash 10" N 26 1/2 E 22.2'

Dr J. H. Wilson's tract west of his addition
south of Auburn St. Dec. 27-1898.

From stake set 16' north of old
stake south side of alley north of
Aurora Add to ~~1813~~ stake NW
to Wilson ~~1846~~ 1813
Bearing $N44\frac{1}{2}^{\circ}E$

Bearing Auburn $N85\frac{1}{2}^{\circ}W$
Center Evansville to center
Plum Valley on Auburn 754.9

30	954.9
<u>246.5</u>	<u>276.5</u>
276.5	678.4

East line of lot $174\frac{1}{2}'$
from old stake $N6^{\circ}W$ to
new stake set by plat
 $N63\frac{1}{2}^{\circ}E$

Evansville & Auburn
Elec. Light pole NW. $25^{\circ}2'$
SW corner found. Main post house $N66^{\circ}7'$

Plum Valley & Auburn
SW corner Rankins house $38'$
NW corner $33^{\circ}8''$

South line from stakes
set this day. $671'$
Bearing of south line $S56^{\circ}E$