

APPROVED E. K. Rose  
DATE JUNE 19, 1951 COUNTY ENGINEER

APPROVED F. M. Hostetler  
DATE June 19, 1951  
Hugh R. Schuck  
COUNTY COMMISSIONERS

TRANSFERED Phyllis J. Blair  
DATE June 20, 1951 COUNTY AUDITOR

RECEIVED FOR RECORD June 20, 1951 at 10:40 A.M.  
RECORDED IN PLAT BOOK 3-C PAGE 73  
Harvey W. Bateh  
COUNTY RECORDER  
Phyllis J. Blair, Deputy

STATE OF OHIO  
COUNTY OF LOGAN SS:-

Be it remembered that on this 20 day of June  
in the year of our Lord One Thousand  
Nine Hundred and Fifty One before me  
a Notary Public in and for said County  
came William M. Thomas  
grantor in forgoing dedication and  
acknowledged the signing thereof to  
be his voluntary act.



My Term expires \_\_\_\_\_  
Agnes M. Montrose  
Notary Public  
Logan County Ohio  
AGNES M. MONTROSE  
NOTARY PUBLIC, LOGAN COUNTY, OHIO  
MY COMMISSION EXPIRES MAY, 19, 1953

DEDICATION


Know all men by these presents  
that William M. Thomas  
proprietor of the land indicated on the  
accompanying plat has authorized  
the laying out of THOMAS ADDITION  
#4. The drives are dedicated to the  
public.

Robert Smith Witness  
William M. Thomas

SURVEYORS CERTIFICATE

The accompanying plat represents a  
subdivision of land in the Township of  
Stokes, County of Logan, State of Ohio,  
and is part of Virginia Military Survey  
12276. The tract has an area of 1.52  
Acre in Drives, 2.46 Acres in lots,  
making a total of 3.98 Acres. I  
hereby certify that the accompanying  
plat is a correct representation of  
THOMAS ADDITION #4.

F. F. Wright  
Civil Engineer

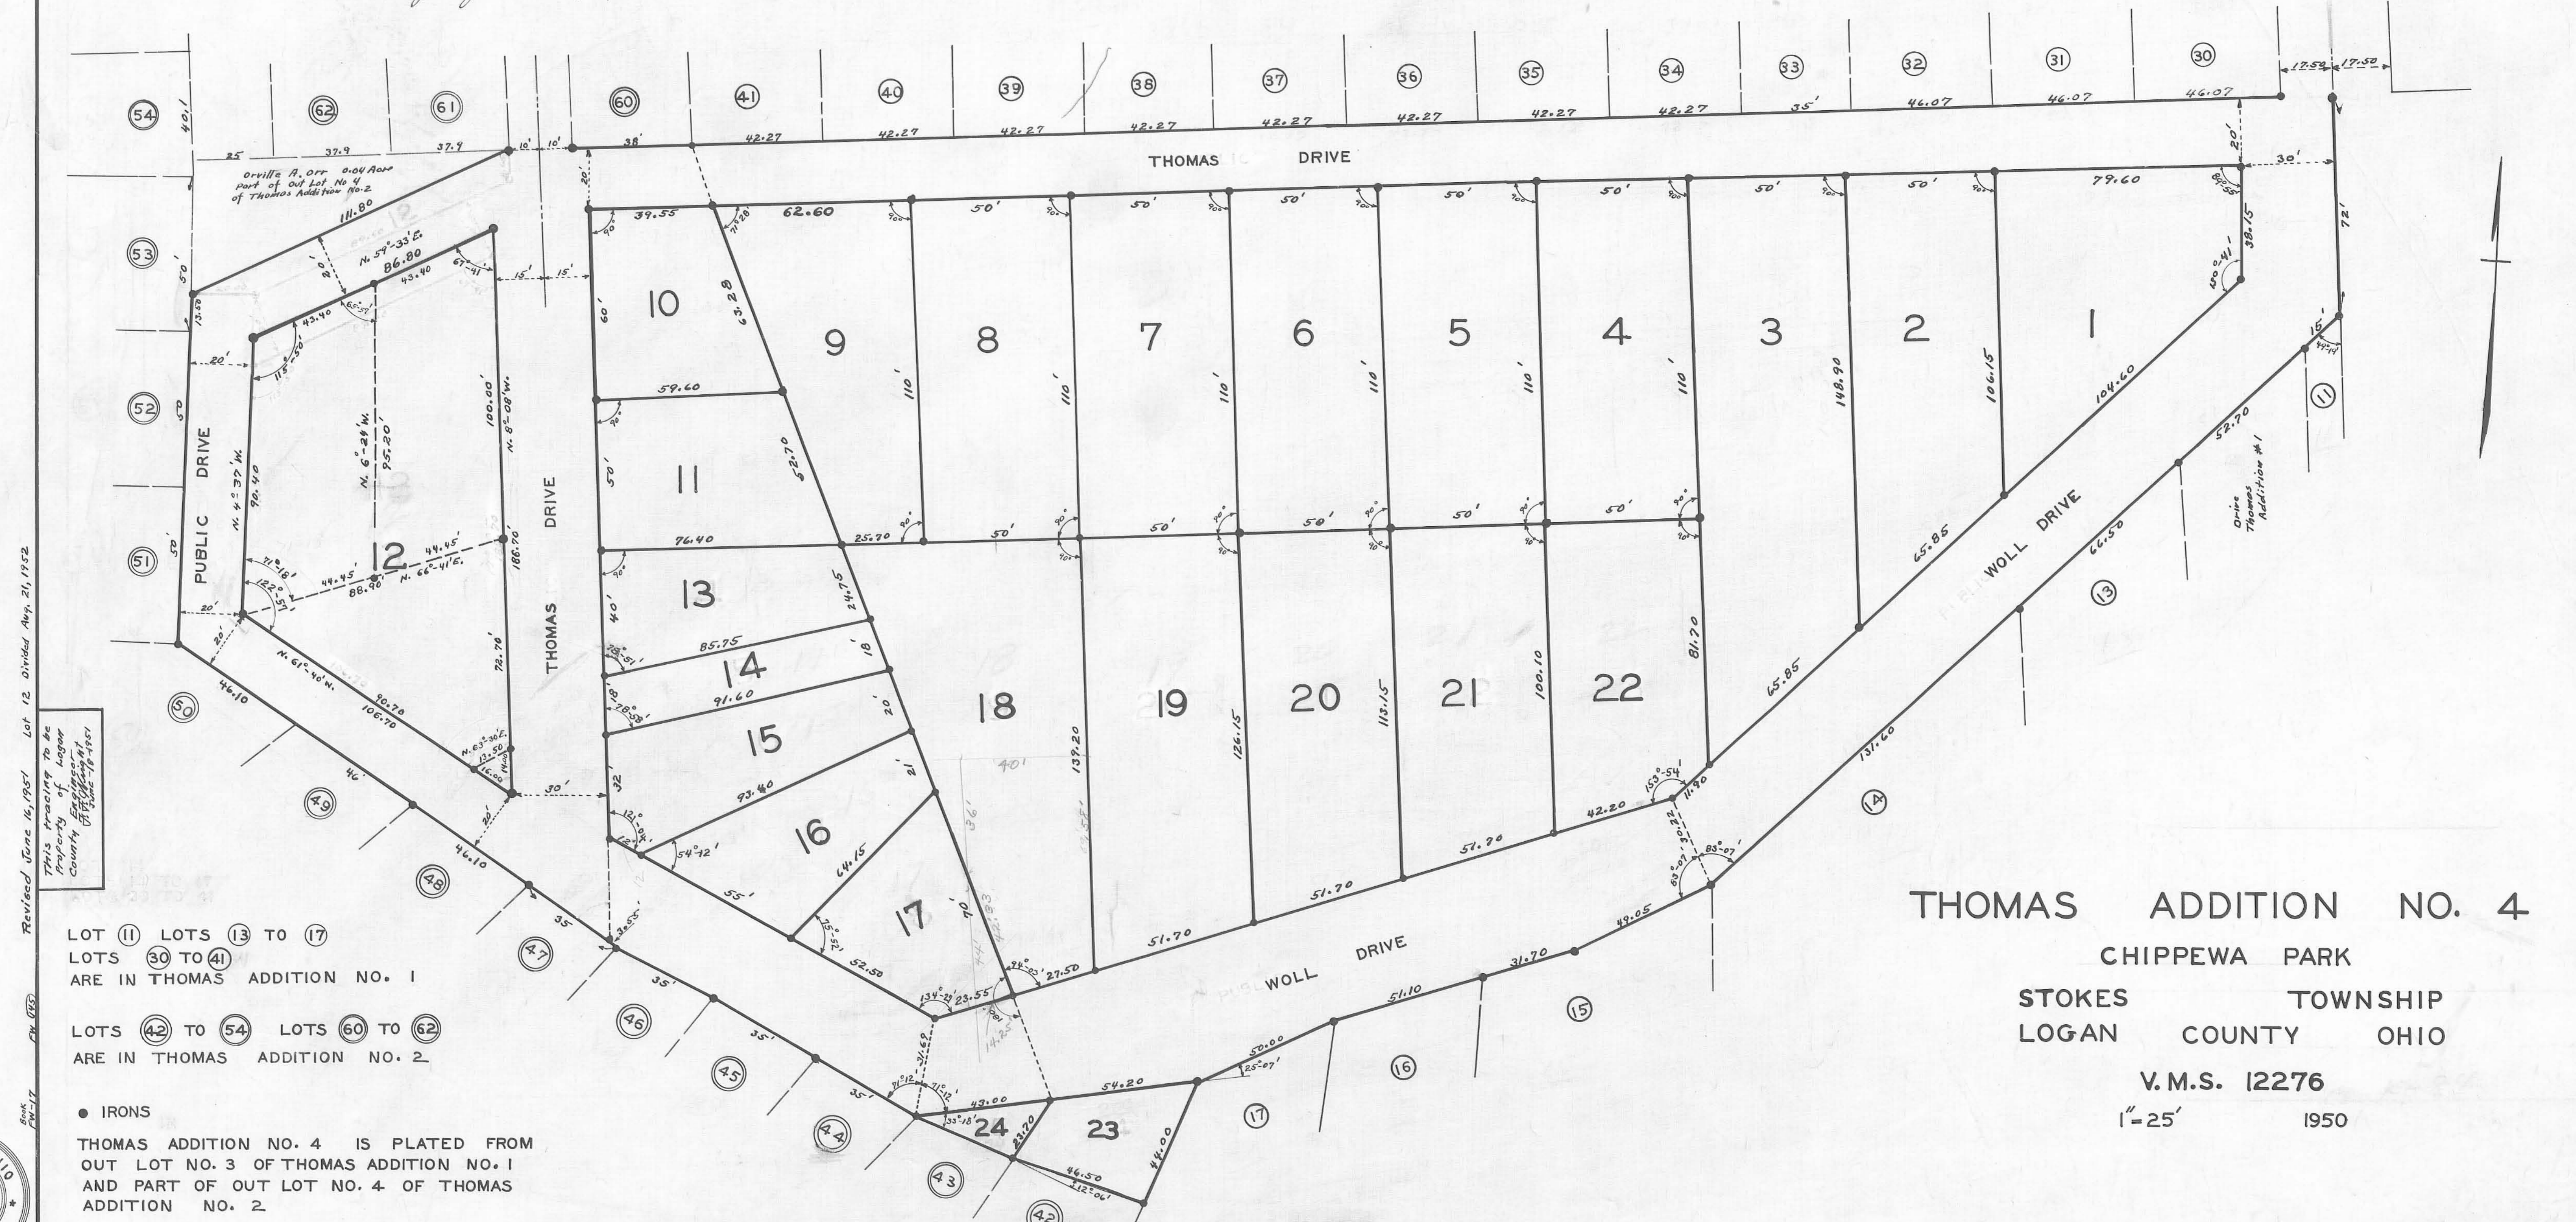

THOMAS ADDITION NO. 4

CHIPPEWA PARK  
STOKES TOWNSHIP  
LOGAN COUNTY OHIO

V.M.S. 12276  
1"=25' 1950

LOT 11 LOTS 13 TO 17  
LOTS 30 TO 41  
ARE IN THOMAS ADDITION NO. 1  
  
LOTS 42 TO 54 LOTS 60 TO 62  
ARE IN THOMAS ADDITION NO. 2

● IRONS  
THOMAS ADDITION NO. 4 IS PLATED FROM  
OUT LOT NO. 3 OF THOMAS ADDITION NO. 1  
AND PART OF OUT LOT NO. 4 OF THOMAS  
ADDITION NO. 2

