




VIRGINIA DRIVE

U.S.R. 68
N. 5° 28' E.
619.08'
231.05'

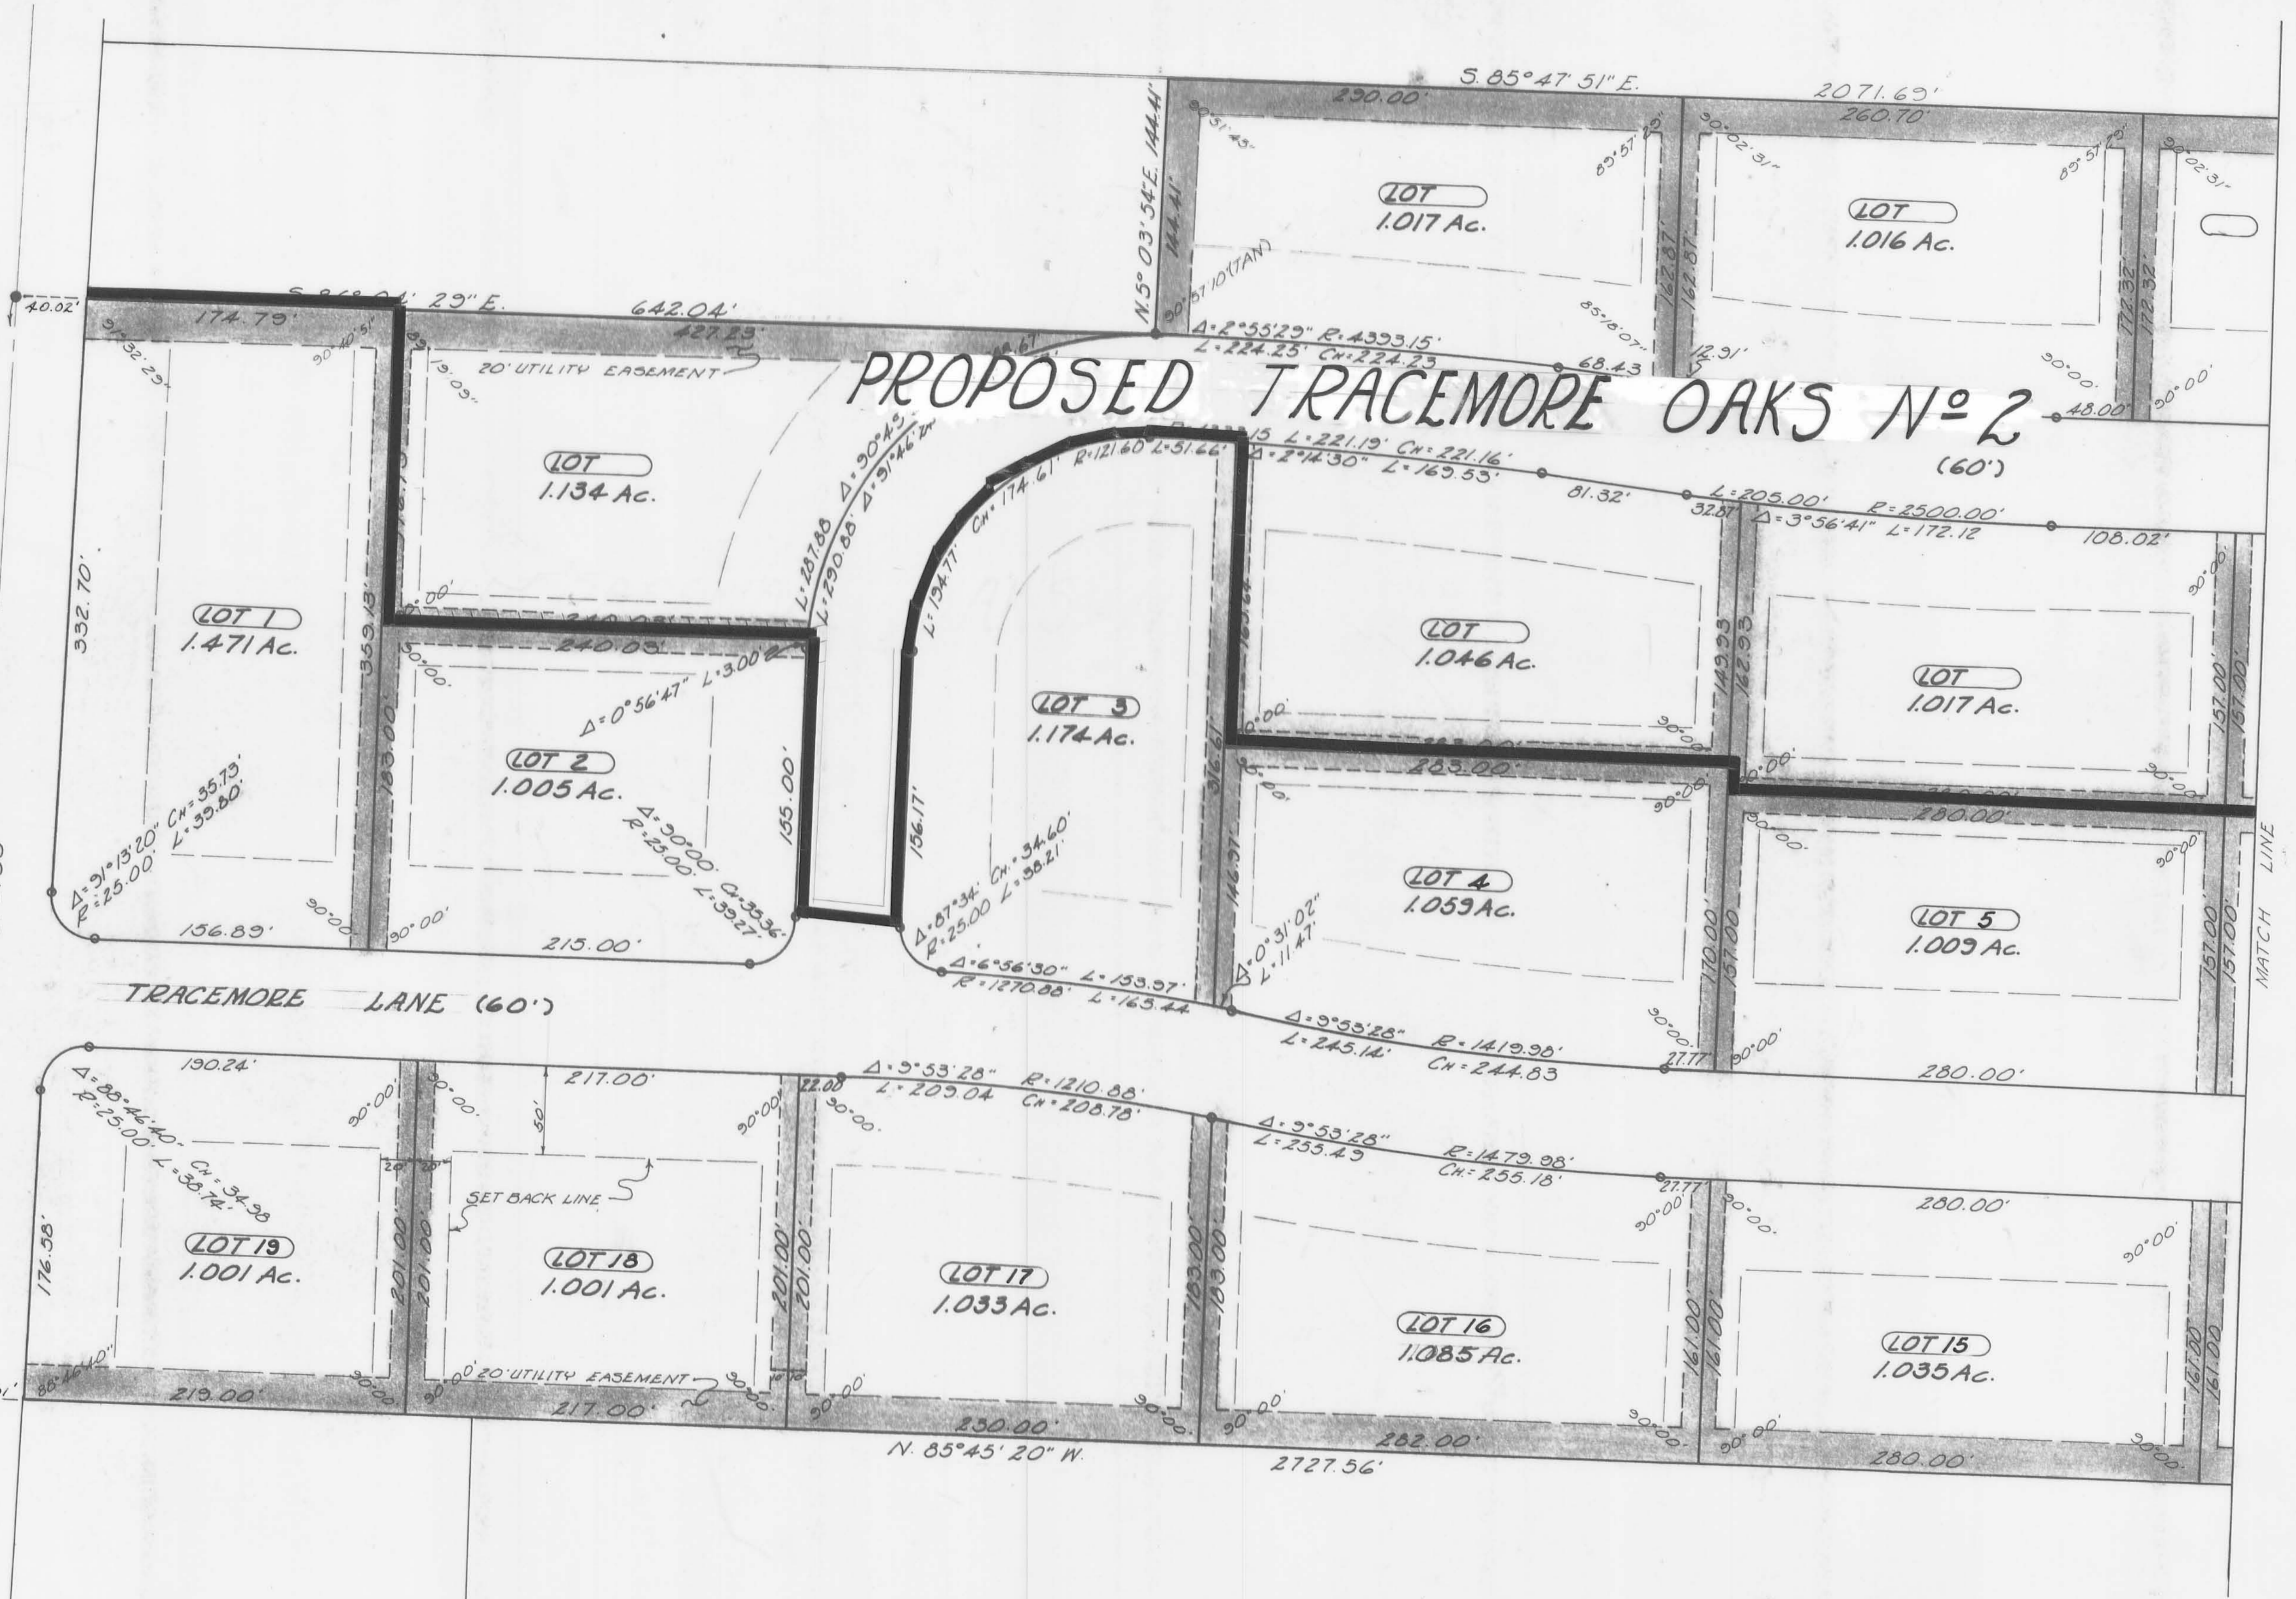

SURVEYOR NOTES:
• 3/8" IRON BARS SET ON ALL LOT CORNERS.
• RAILROAD SPIKE
• CONCRETE MONUMENT

DEDICATION
KNOW ALL MEN BY THESE PRESENTS THAT TRACY HUMBLE AND DOROTHY E. HUMBLE PROPRIETORS OF THE LAND INDICATED ON THE ACCOMPANYING PLAT HAVE AUTHORIZED THE PLATTING THEREOF AND DO HEREBY DEDICATE TRACEMORE LANE AND U.S.R. 68 TO THE PUBLIC USE FOREVER.
Tracy Humble
Dorothy E. Humble
PROPRIETORS
Joni Ropp
Reuben Hermann
WITNESSES
STATE OF OHIO
COUNTY OF LOGAN
BEFORE ME A NOTARY PUBLIC IN AND FOR SAID COUNTY PERSONALLY CAME Tracy and Dorothy E. Humble who acknowledged the signing of the foregoing instrument to be their voluntary act and deed for the uses and purposes therein expressed.
IN WITNESS WHEREOF I HAVE HERETO SET MY HAND AND AFFIXED MY OFFICIAL SEAL THIS 18th DAY OF SEPT, 1978
Doreen Hines
NOTARY PUBLIC

TRACEMORE OAKS ALLOTMENT
SEC. 30, T. 5 S., R. 13 E. - S.M.R.S.
LIBERTY TOWNSHIP
LOGAN COUNTY, OHIO
SCALE = 1" = 50'

SURVEYOR'S CERTIFICATE
THE ACCOMPANYING PLAT REPRESENTS A SUBDIVISION OF LAND IN SECTION 30, TOWN 5 S., RANGE 13 E., BETWEEN THE MIAMI RIVERS SURVEY, LIBERTY TOWNSHIP, LOGAN COUNTY, OHIO. THE TRACT HAS AN AREA OF 0.57 AC. IN U.S.R. 68, 3.50 AC. IN TRACEMORE LANE AND 21.24 AC. IN LOTS, MAKING A TOTAL OF 25.31 ACRES.
ALL MEASUREMENTS ARE IN FEET AND DECIMALS OF A FOOT. ALL CURVE ARC DISTANCES ARE SHOWN.
I HEREBY CERTIFY THAT THE ACCOMPANYING PLAT IS A CORRECT REPRESENTATION OF TRACEMORE OAKS ALLOTMENT AS SURVEYED
SEPTEMBER 18, 1978
Ledie H. Healdin
REGISTERED SURVEYOR 5248

REVIEWED THIS 14th DAY OF September, 1978, John A. Coe
CHAIRMAN, TWP. TRUSTEES
APPROVED THIS 14th DAY OF September, 1978, Chester R. Kutz, P.E. & P.S.
LOGAN COUNTY ENGINEER
APPROVED THIS 14th DAY OF September, 1978, George W. Hunt, M.D.
LOGAN COUNTY HEALTH DEPT.
REVIEWED THIS 19 DAY OF September, 1978, Doris Whitworth
LOGAN COUNTY SOIL AND WATER CONSERVATION DISTRICT
APPROVED THIS 19th DAY OF September, 1978, Charles H. Day, II
CHAIRMAN, BELLEFONTAINE CITY PLANNING COMMISSION
TRANSFERRED THIS 20th DAY OF SEPTEMBER, 1978, Mary J. Slator
LOGAN COUNTY AUDITOR
FILED FOR RECORD THIS 20th DAY OF September, 1978 AT 2:04 P.M.
RECORDED THIS 20th DAY OF September, 1978, IN PLAT BOOK 6-F PAGE NO. 106-107
Carolyn Collins
LOGAN COUNTY RECORDER