

Sec E, Quinn

6


indicates Ry monuments

RIGHT OF WAY DEPT. DIVISION OF HIGHWAYS
STATE OF OHIO

LOGAN COUNTY I.C.H. 27 SEC. E.

61-7

61-7

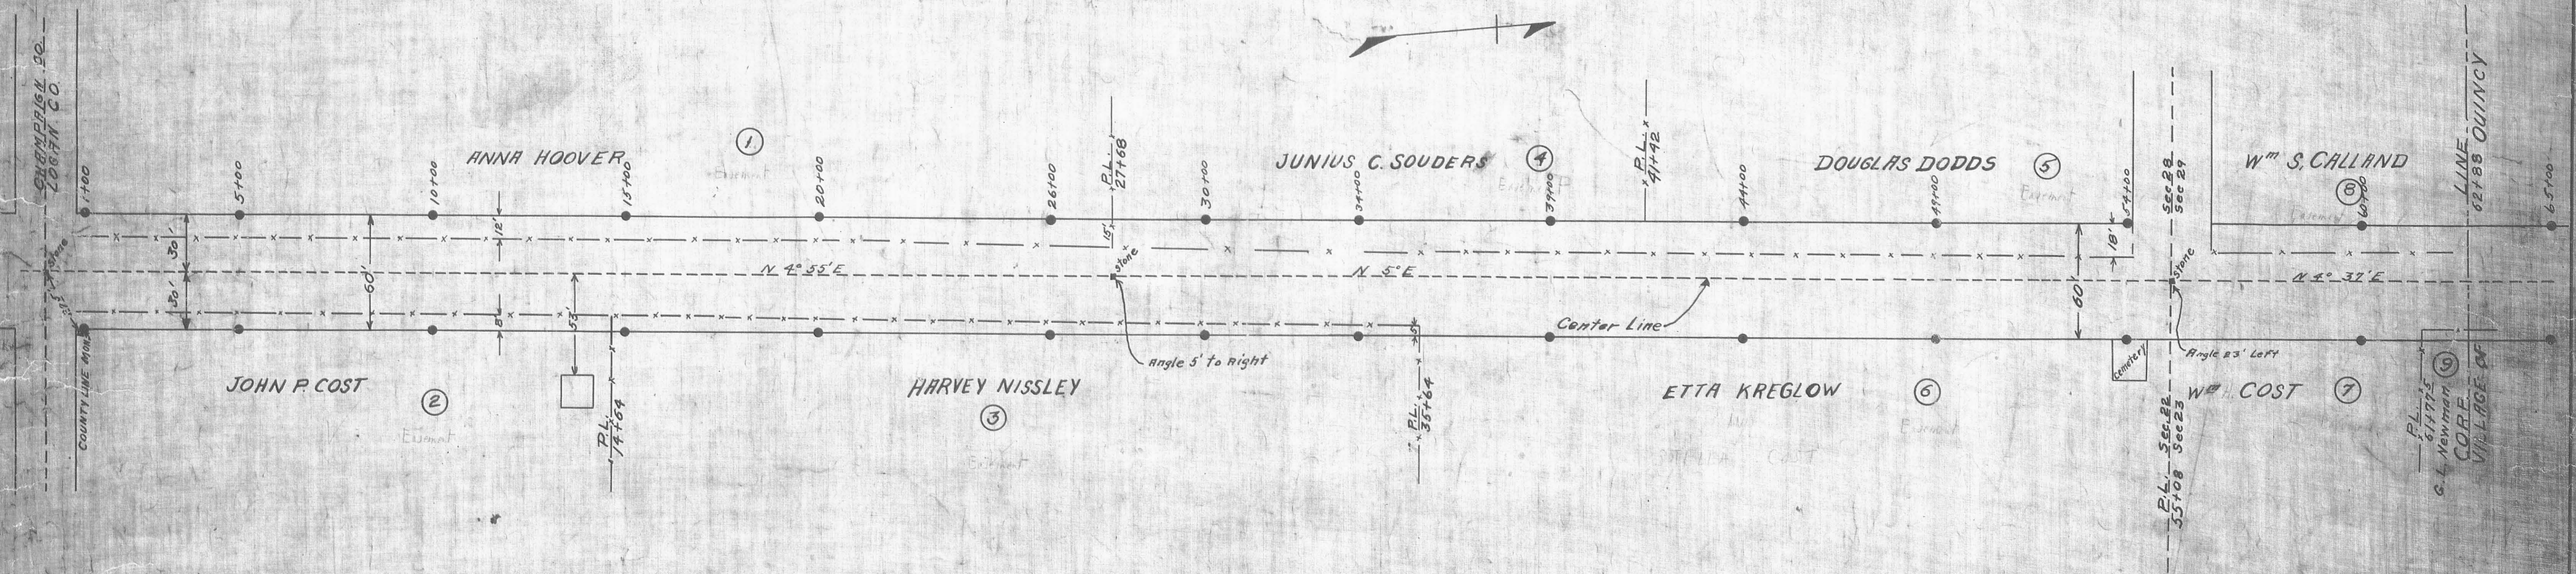


Notes in Book Logan Co. Field Book #415
Road established 40' wide Logan Co. Pike Record Vol. #1, P.P. 6, 1867

Scale 200' = 1"

RIGHT OF WAY DEPT. DIVISION OF HIGHWAYS

STATE OF OHIO


LOGAN COUNTY ICH 27 SEC. Quincy

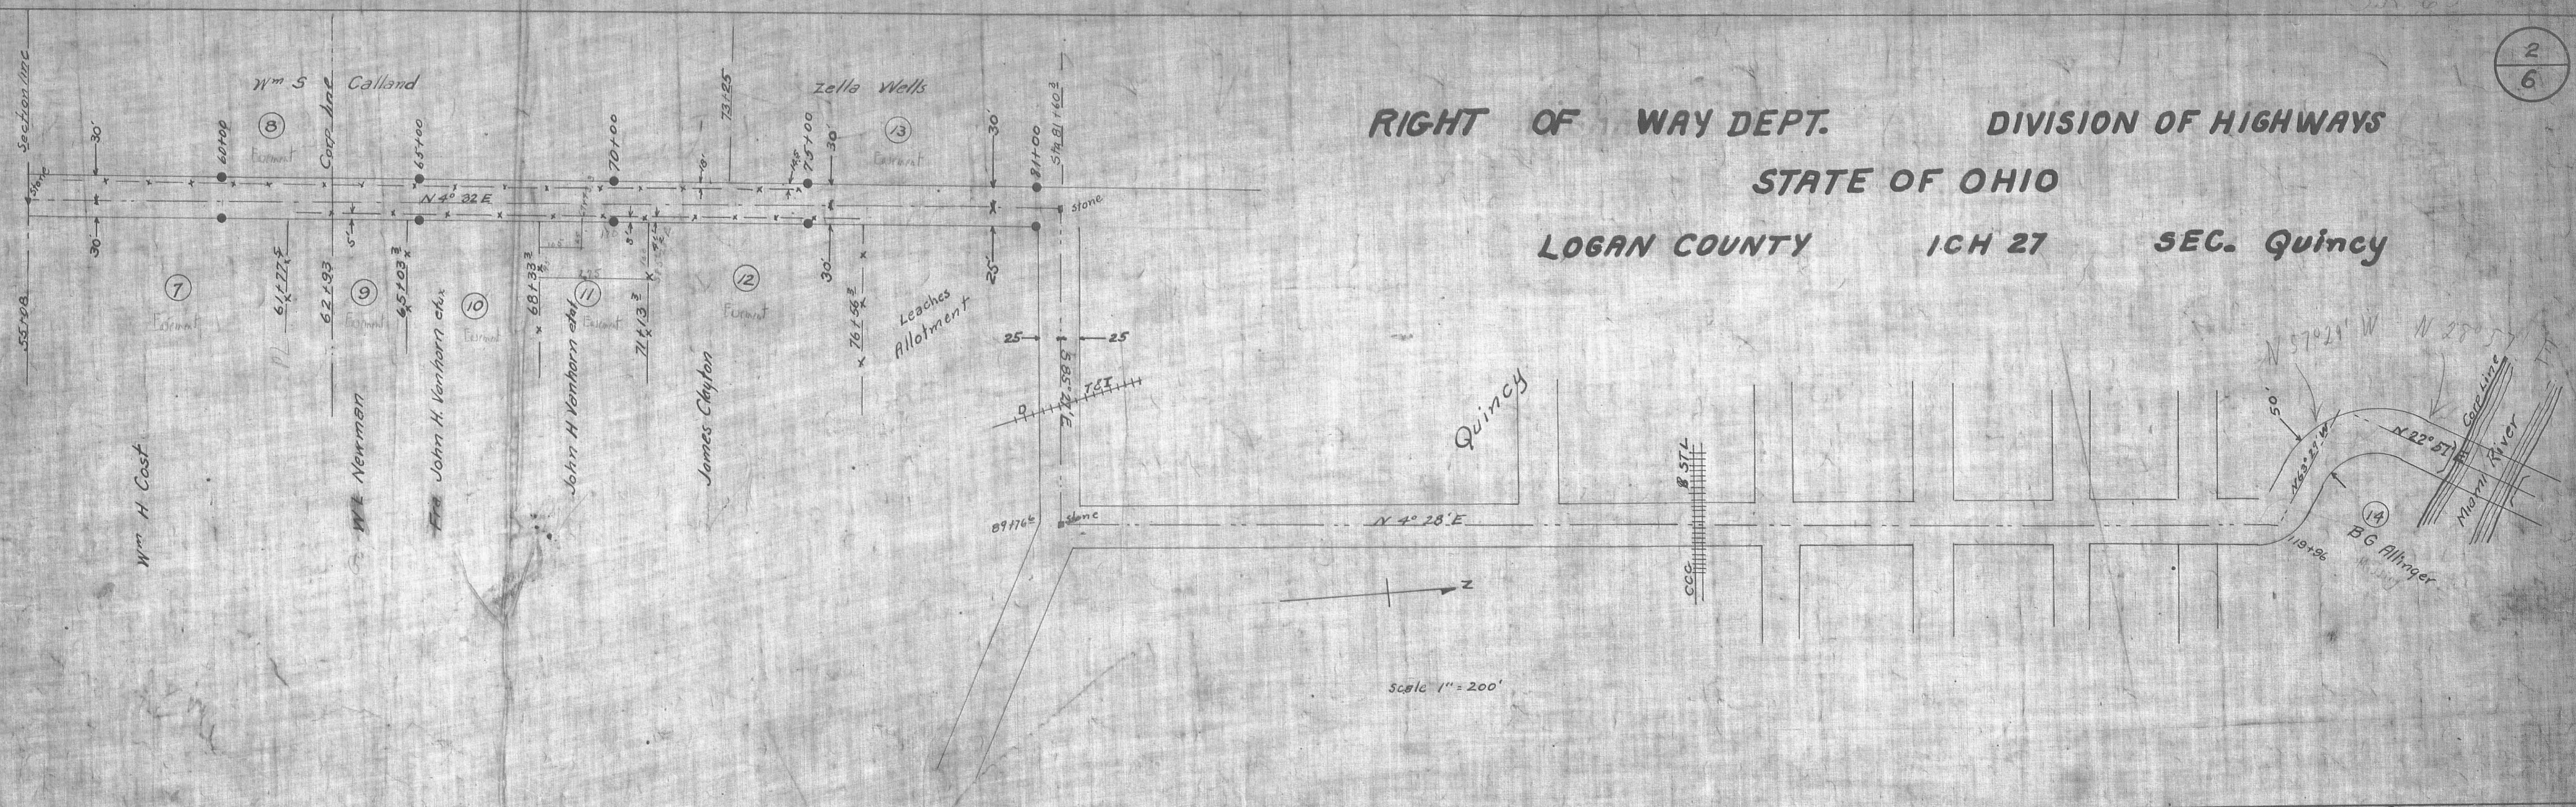

INDICATES R/W MONUMENTS

Field Notes in Logan County Field Book No 415


New road 1287' shorter than old road
Sta. 168+68 = 181+54 ±

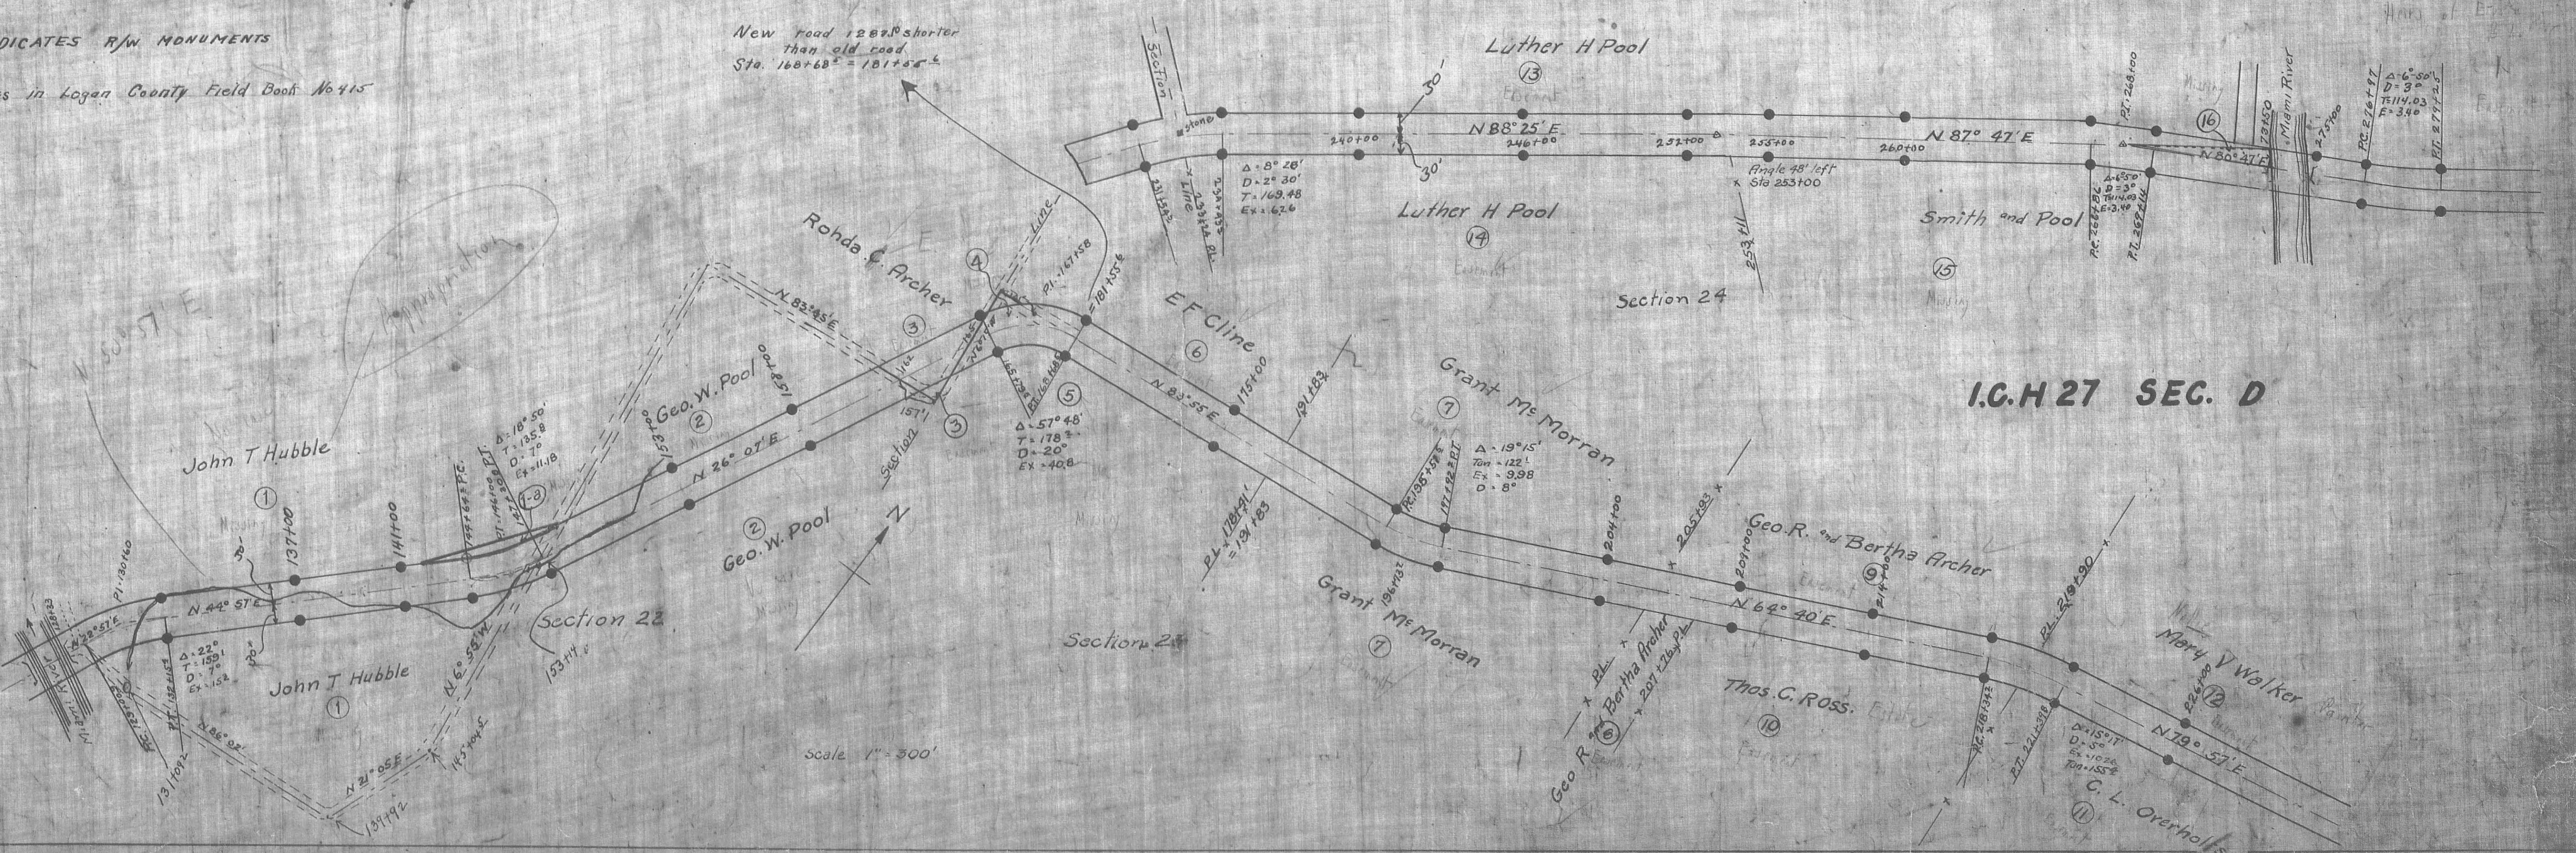

I.C.H 27 SEC. D

Scale 1" = 300'

INDICATES R/W MONUMENTS

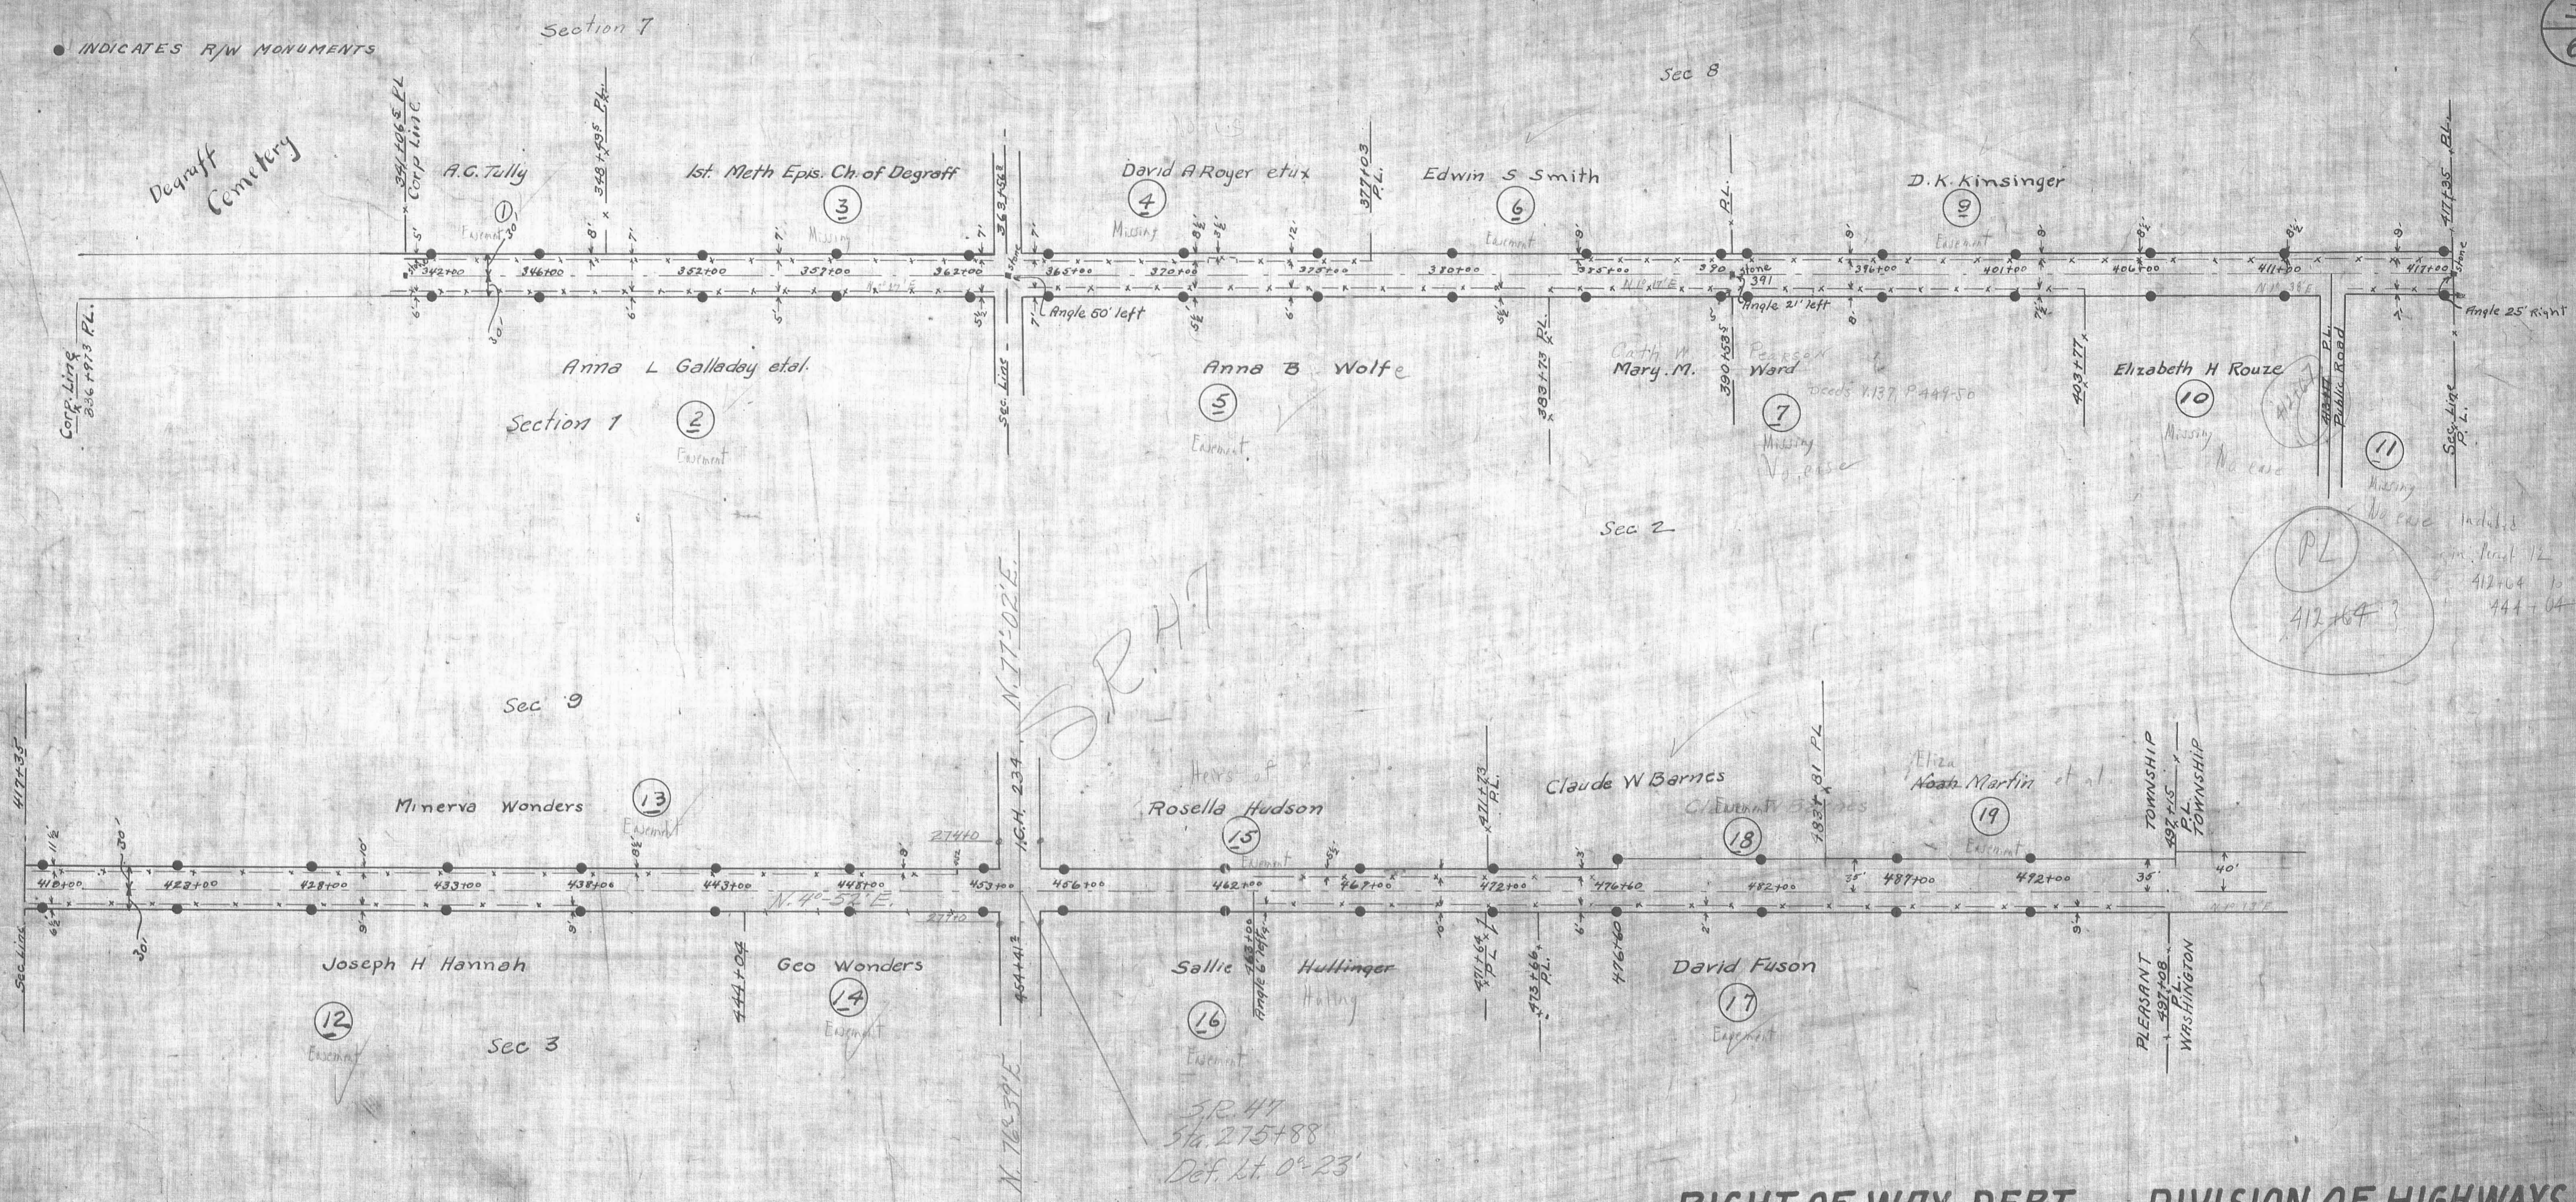

FOR HT

PL
412.64?

RIGHT OF WAY DEPT. DIVISION OF HIGHWAYS
 STATE OF OHIO
 LOGAN COUNTY I.C.H. 27 SEC C

Field Notes in Logan County Field Book No 415
 Pike Record Vol 5 pages 370, 371, 372 Marquis and Swanger pike 1880

Scale 300' = 1"

RIGHT OF WAY DEPT. DIVISION OF HIGHWAYS
 STATE OF OHIO
 LOGAN COUNTY I.C.H. 27 SEC. B.


4
6

● INDICATES R/W MONUMENTS

Easy cuts extra width at 550+00


Field Notes Book 416

*610+198
 612+118
 608+48.35*

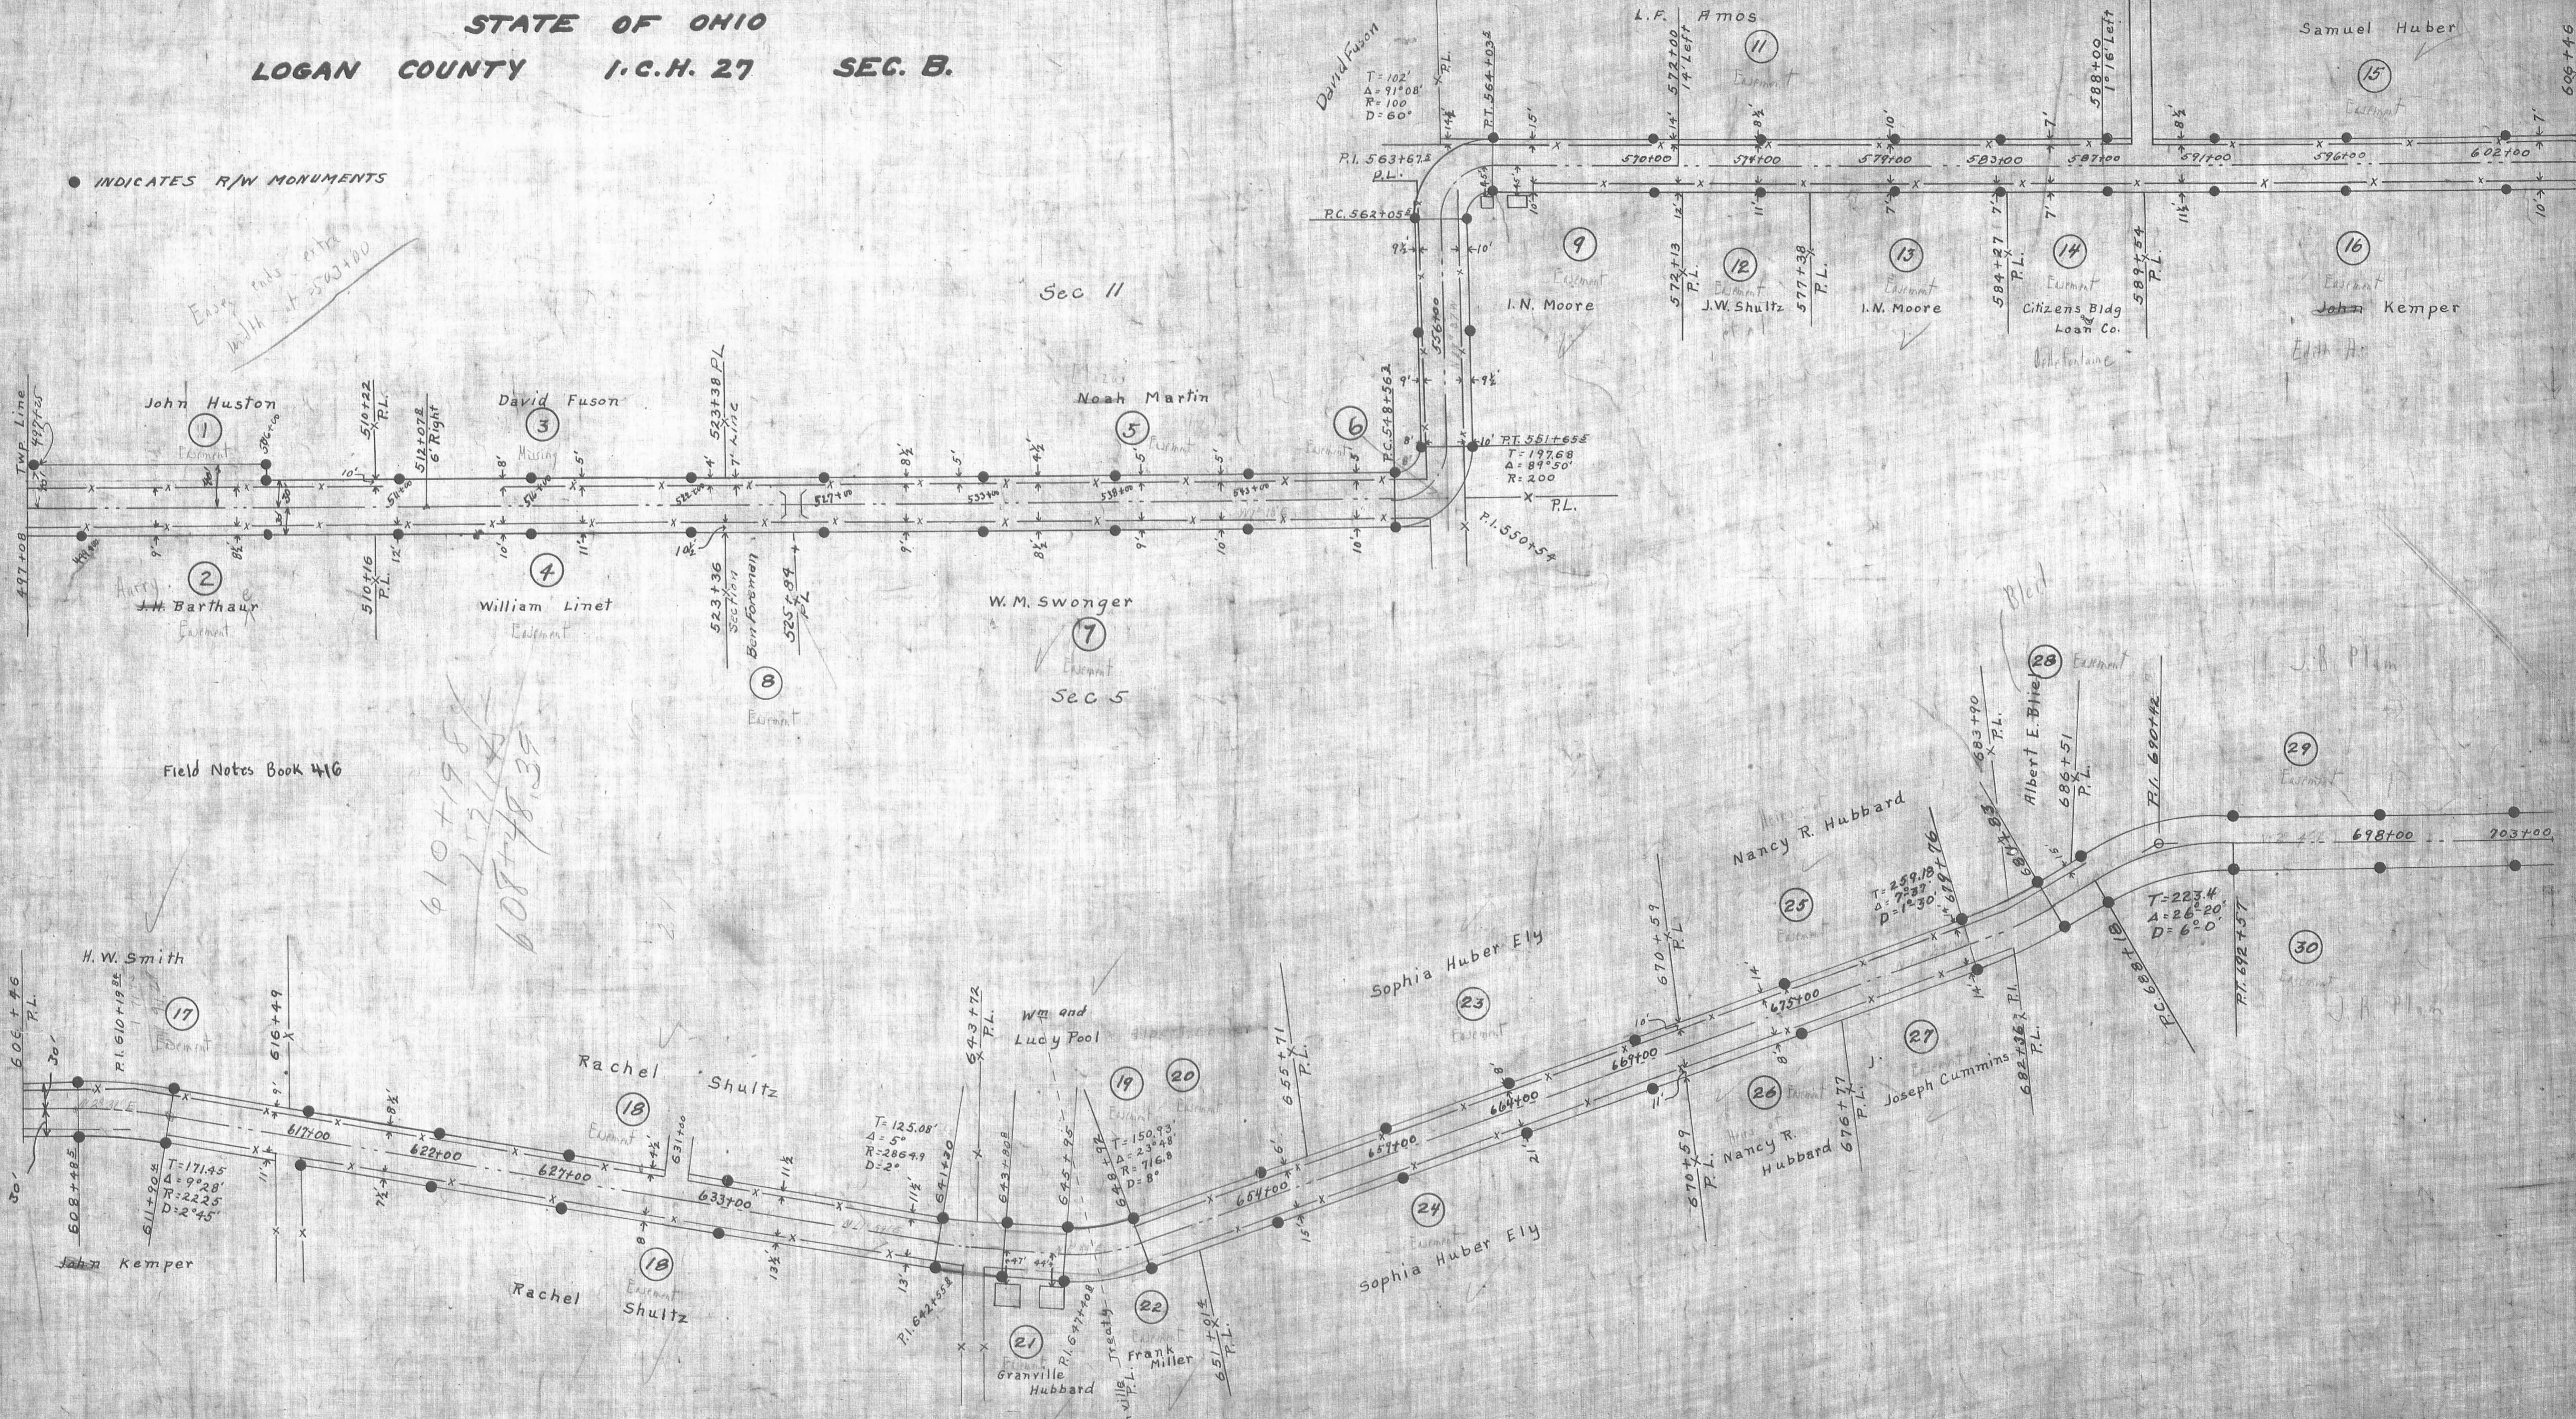


Scale 300' = 1"

● INDICATES R/W MONUMENTS

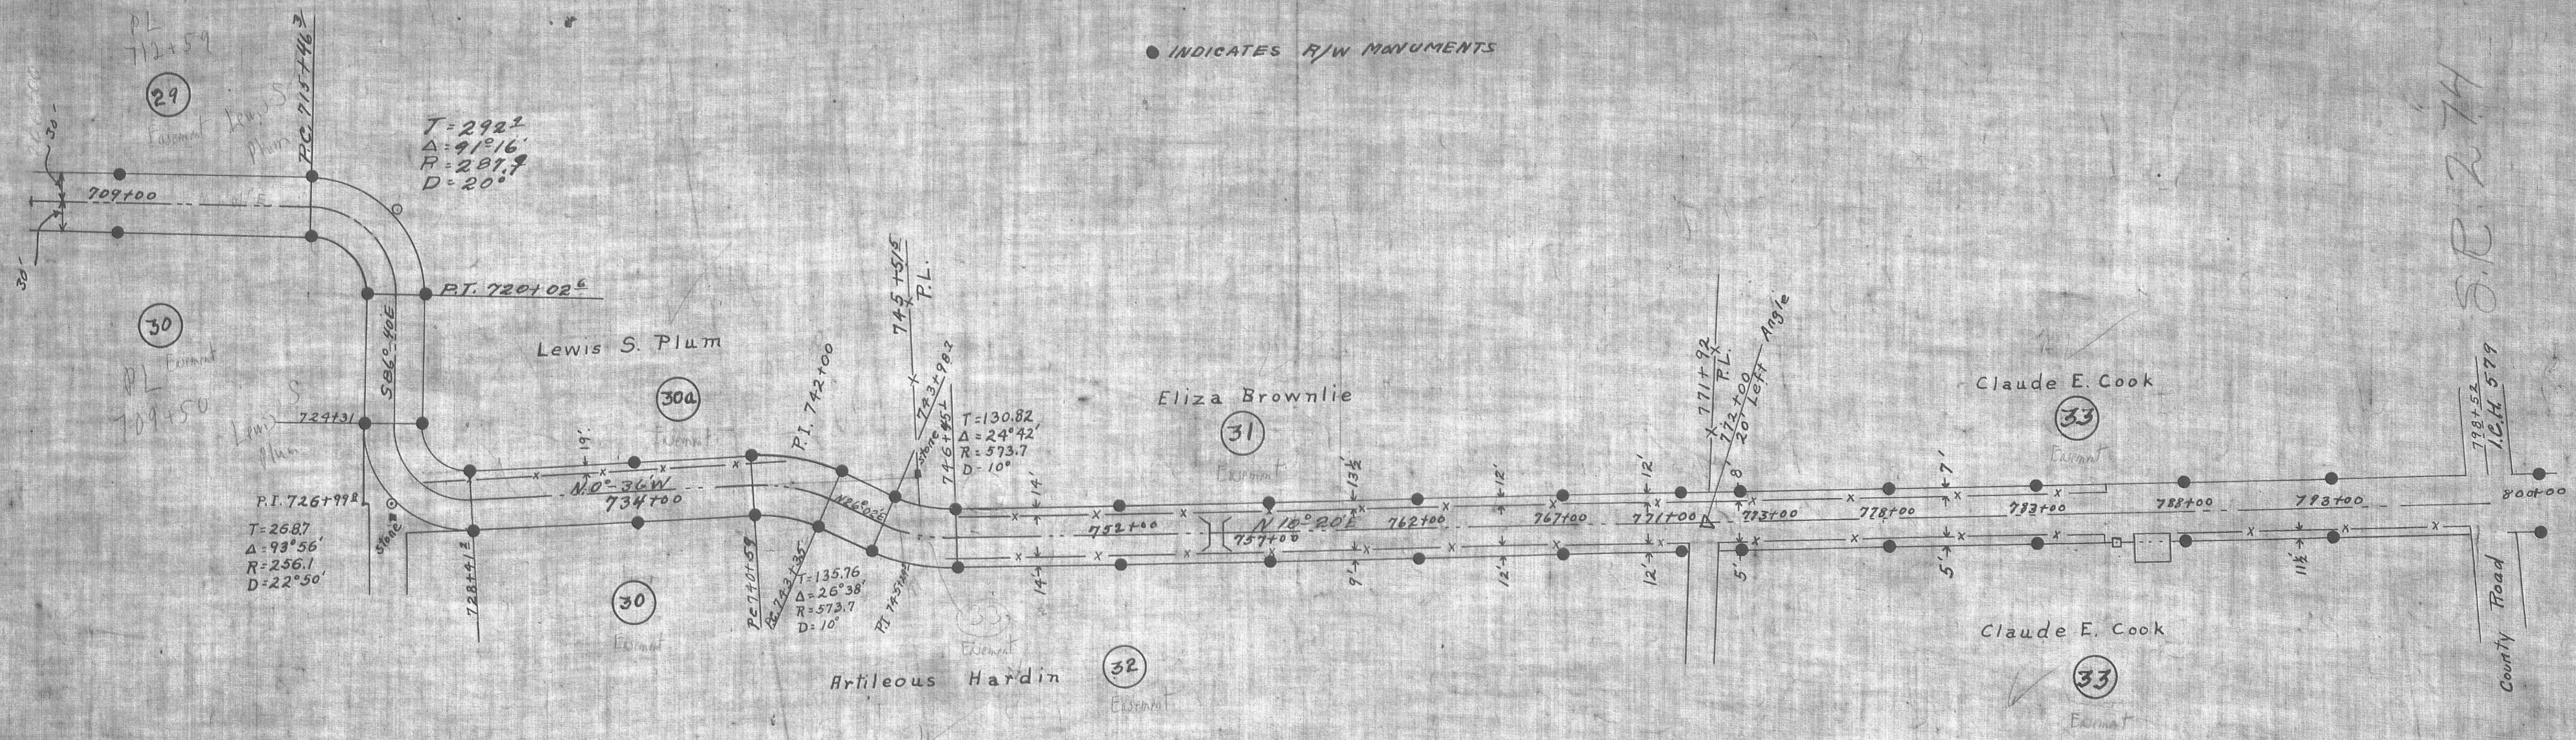

Field Notes Book 416

RIGHT OF WAY DEPT. DIVISION OF HIGHWAYS
 STATE OF OHIO
 LOGAN COUNTY I.C.H 27 SEC B

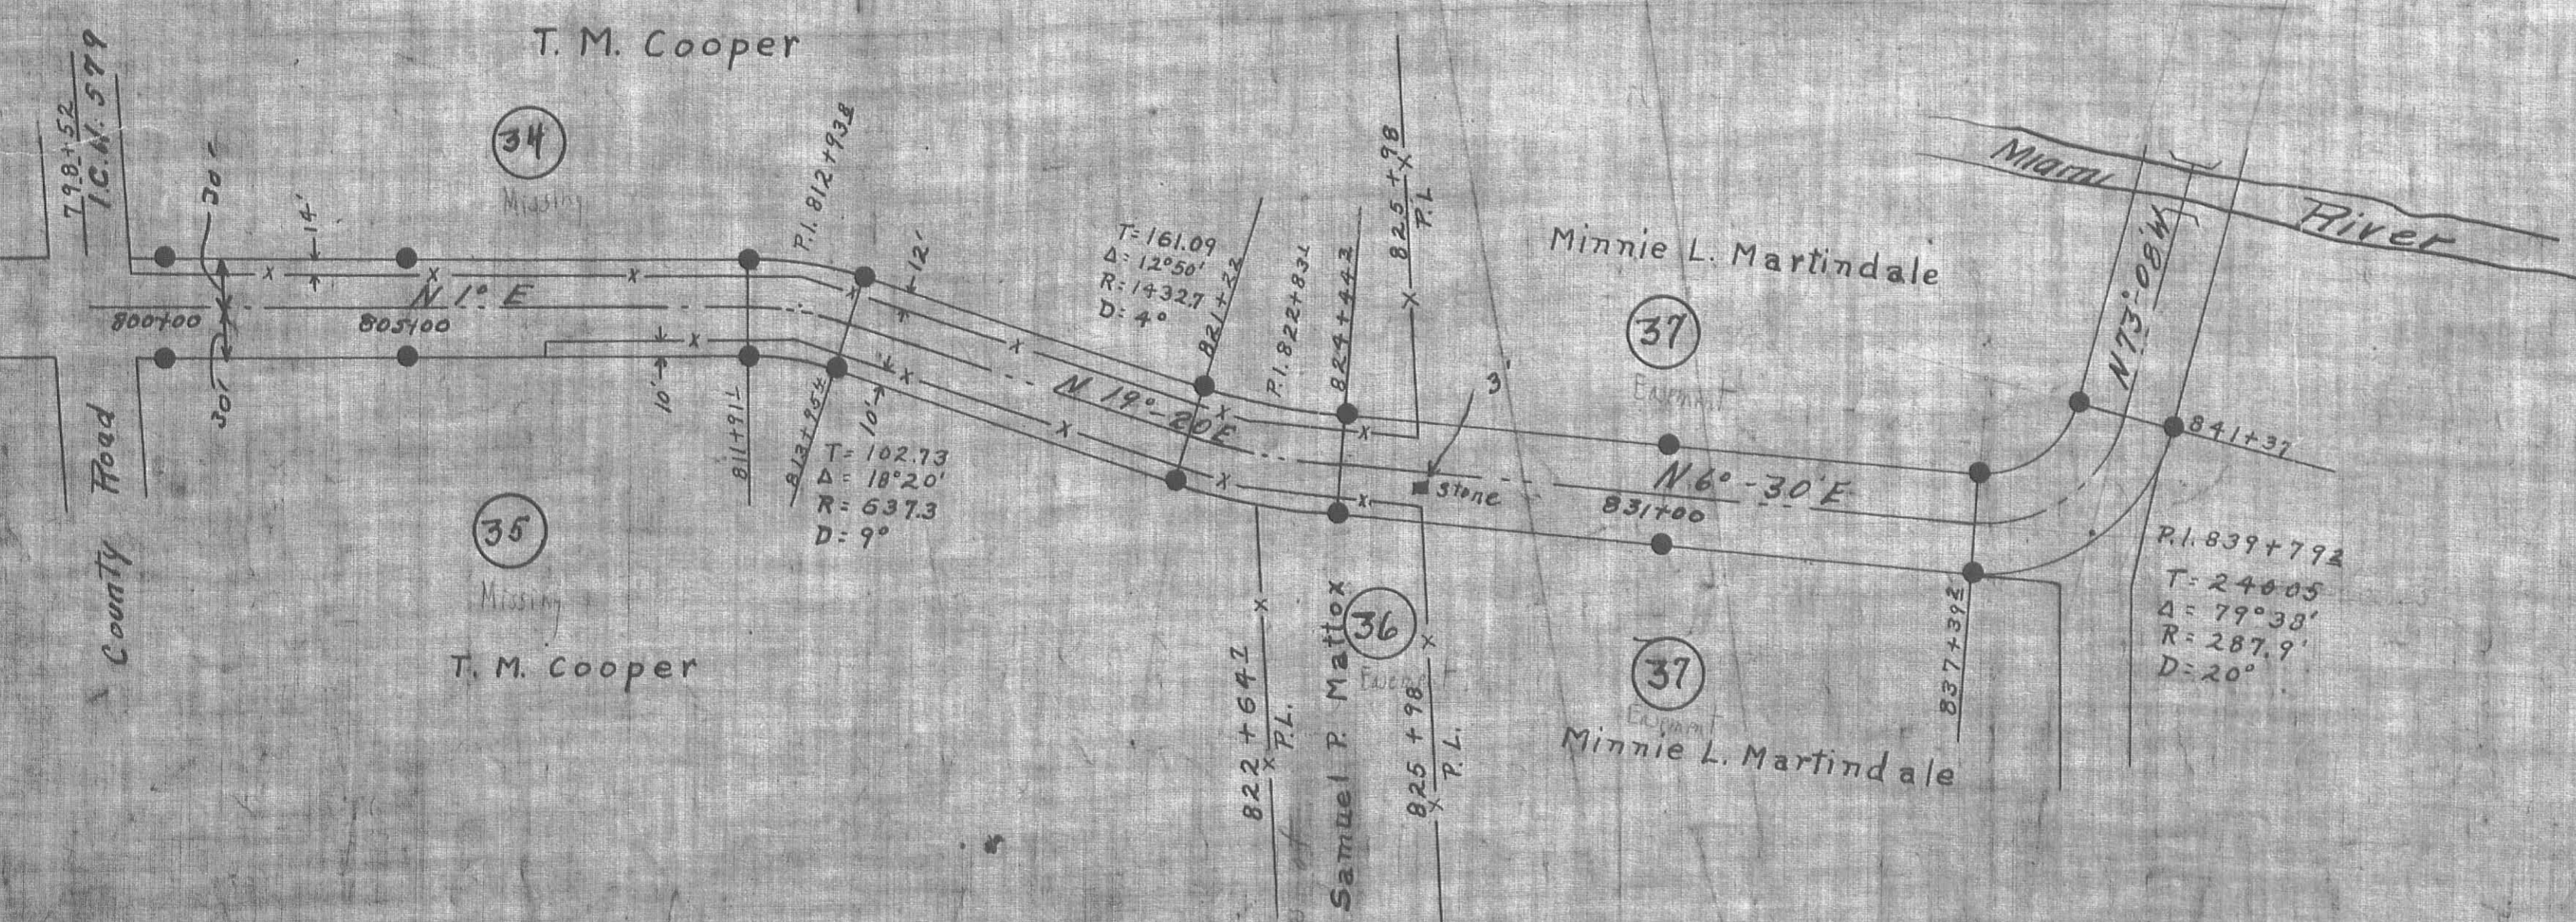


Scale 300' = 1"


● INDICATES R/W MONUMENTS

RIGHT OF WAY DEPT. DIVISION OF HIGHWAY
STATE OF OHIO
LOGAN COUNTY I.C.H. 27 SEC. A

Handwritten notes:
23 June 1882
Clyde Harris & Emma Harris
304 The of w. of Lake View
was sold to road way
Vol. 1143 Pa. 253
Recorded 2-27-30

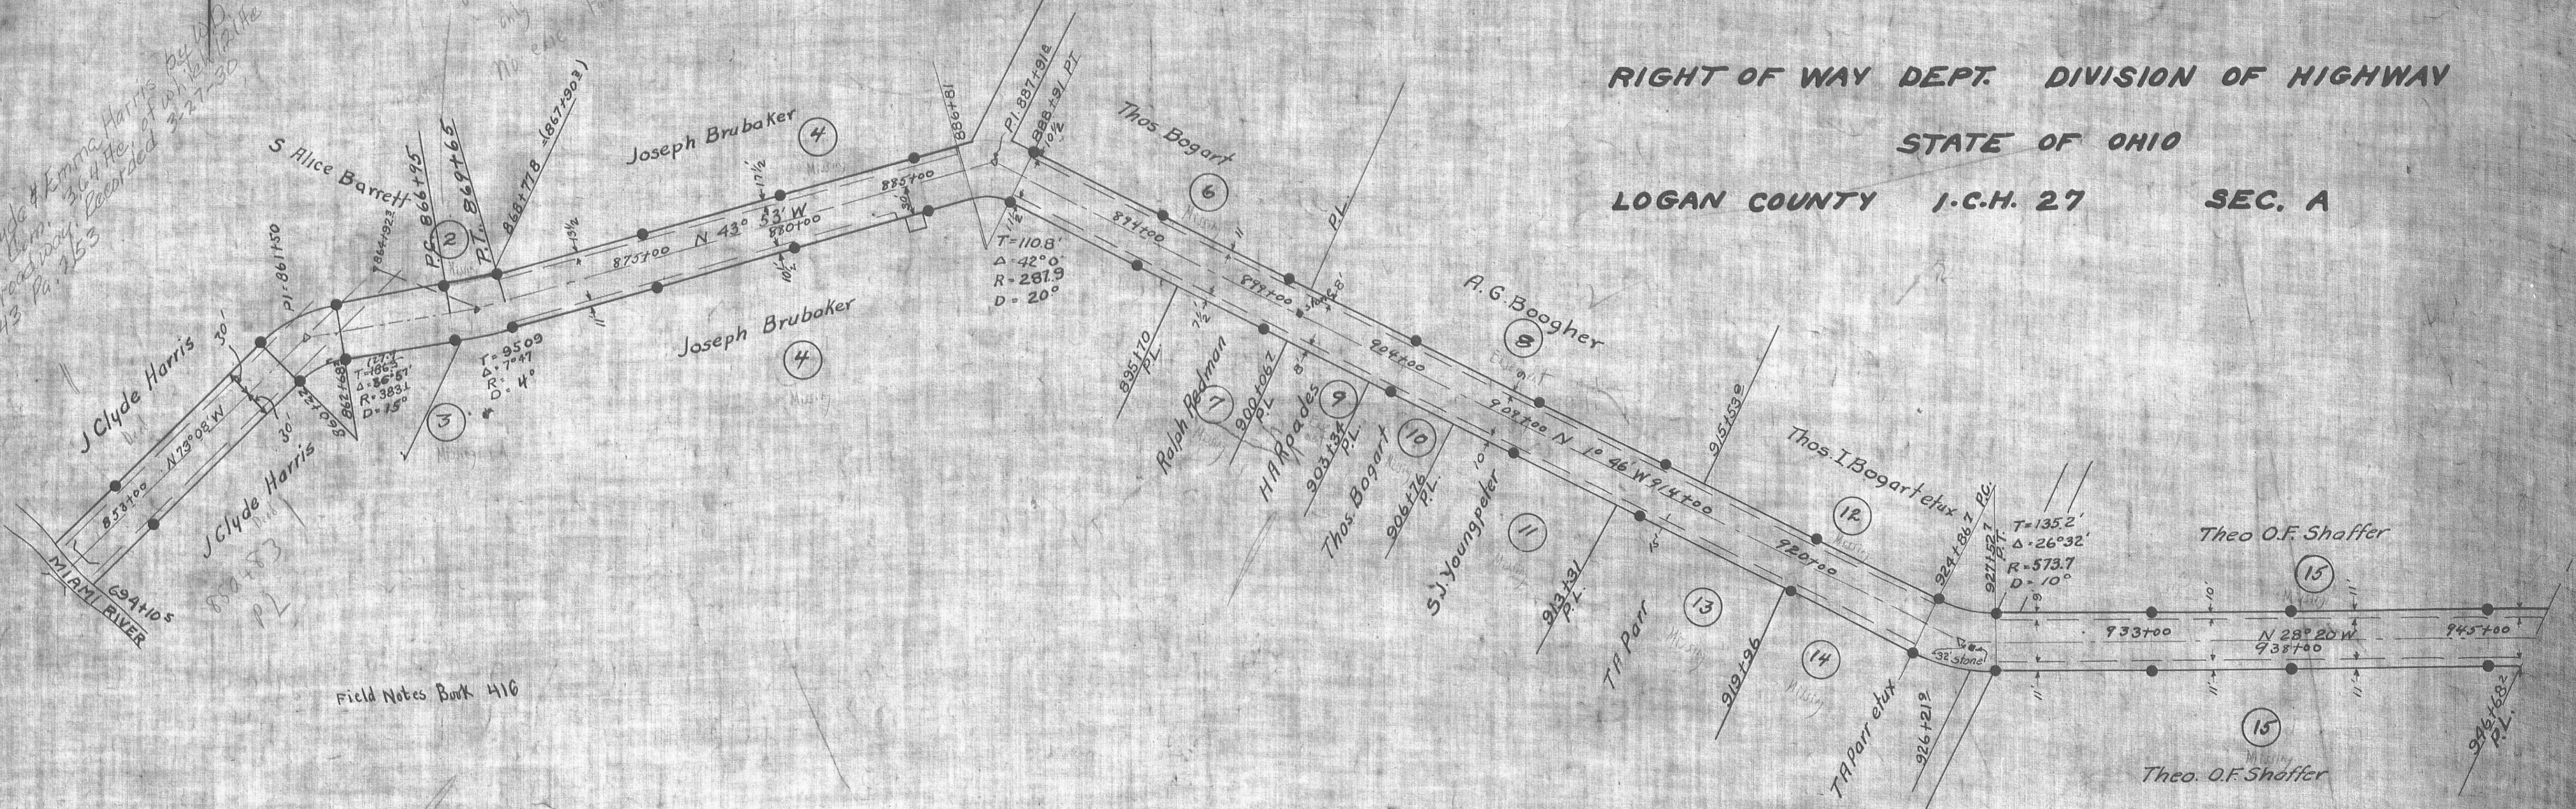


Field Notes Book 416

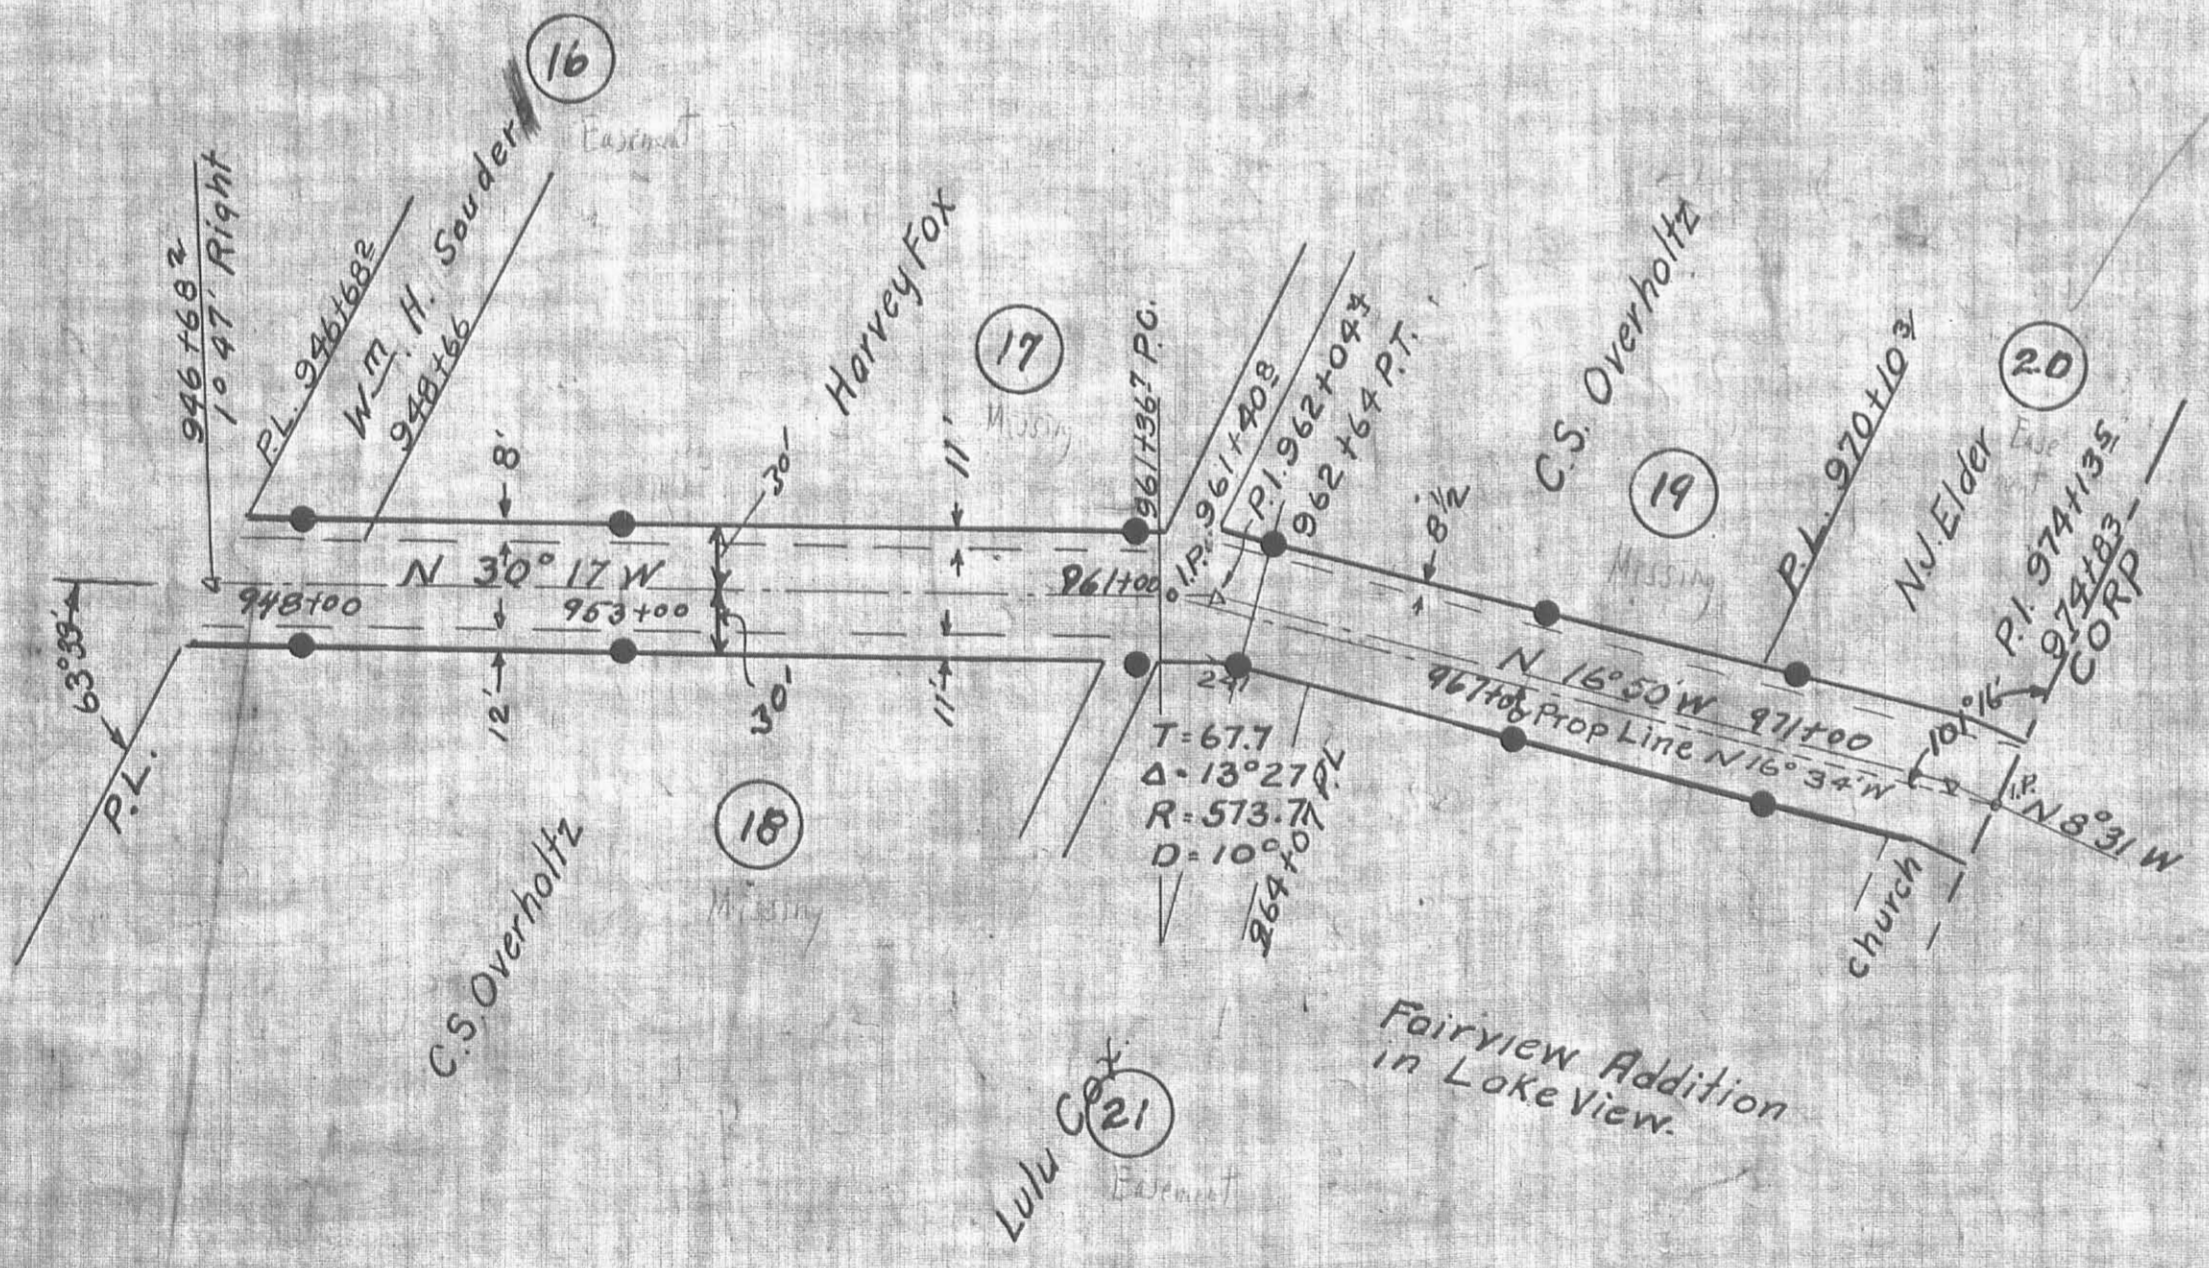

Fairview Addition
in Lake View.


FED. RD. DIST. NO.	STATE	FEDERAL AID PROJECT	FISCAL YEAR
10	OHIO		1934

LOGAN COUNTY
 SH. 27 SEC. QUINCY & D (PARTS)
 BRIDGE NO. LO. 69-22

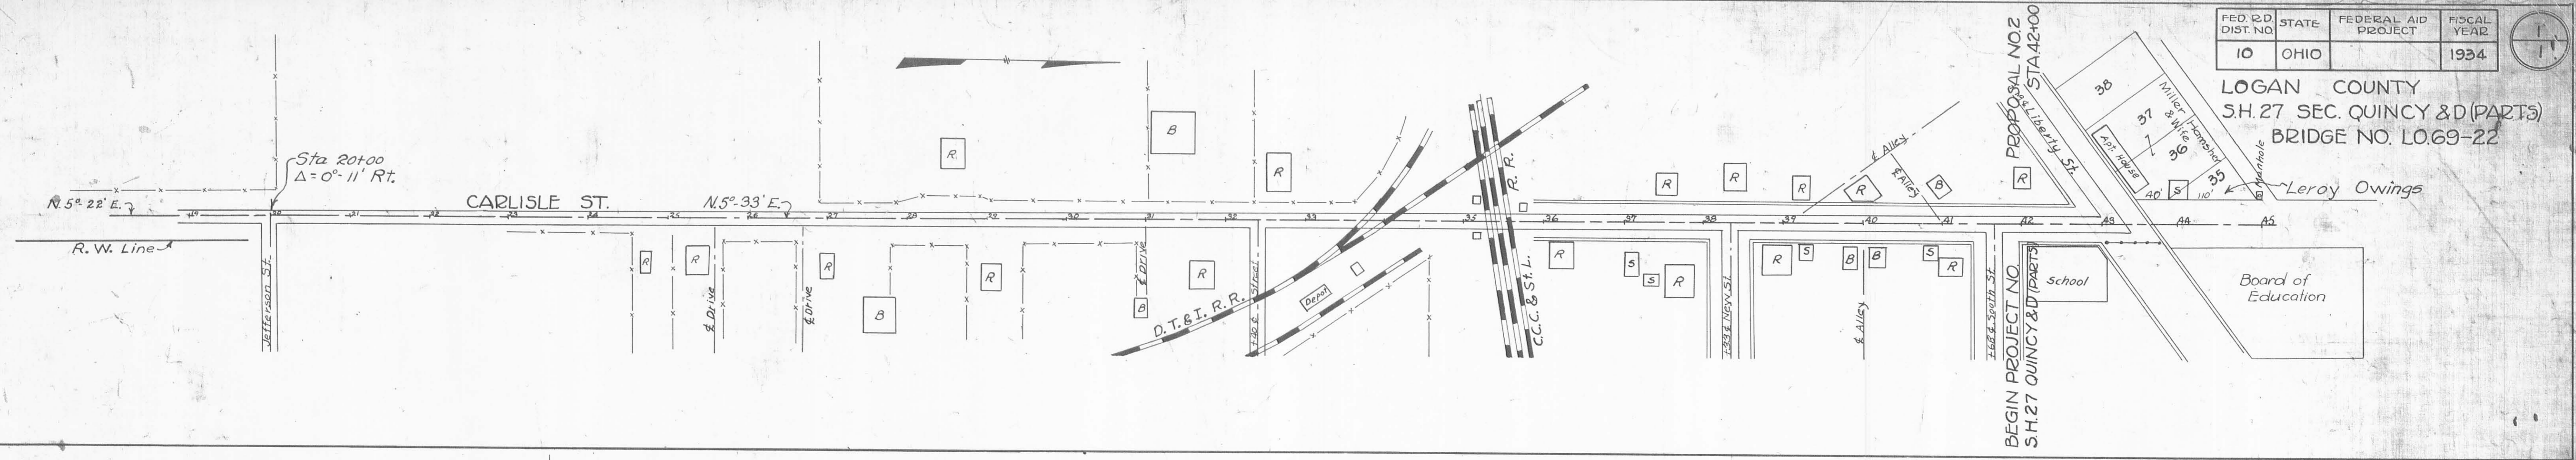

Dan,
 The only points we used to set
 & for bridge was the mon's. We didn't
 use anything south of P.C.

The centerline plat for S.R. 117 is
 not complete. Will send it to you as
 soon as possible. Dick

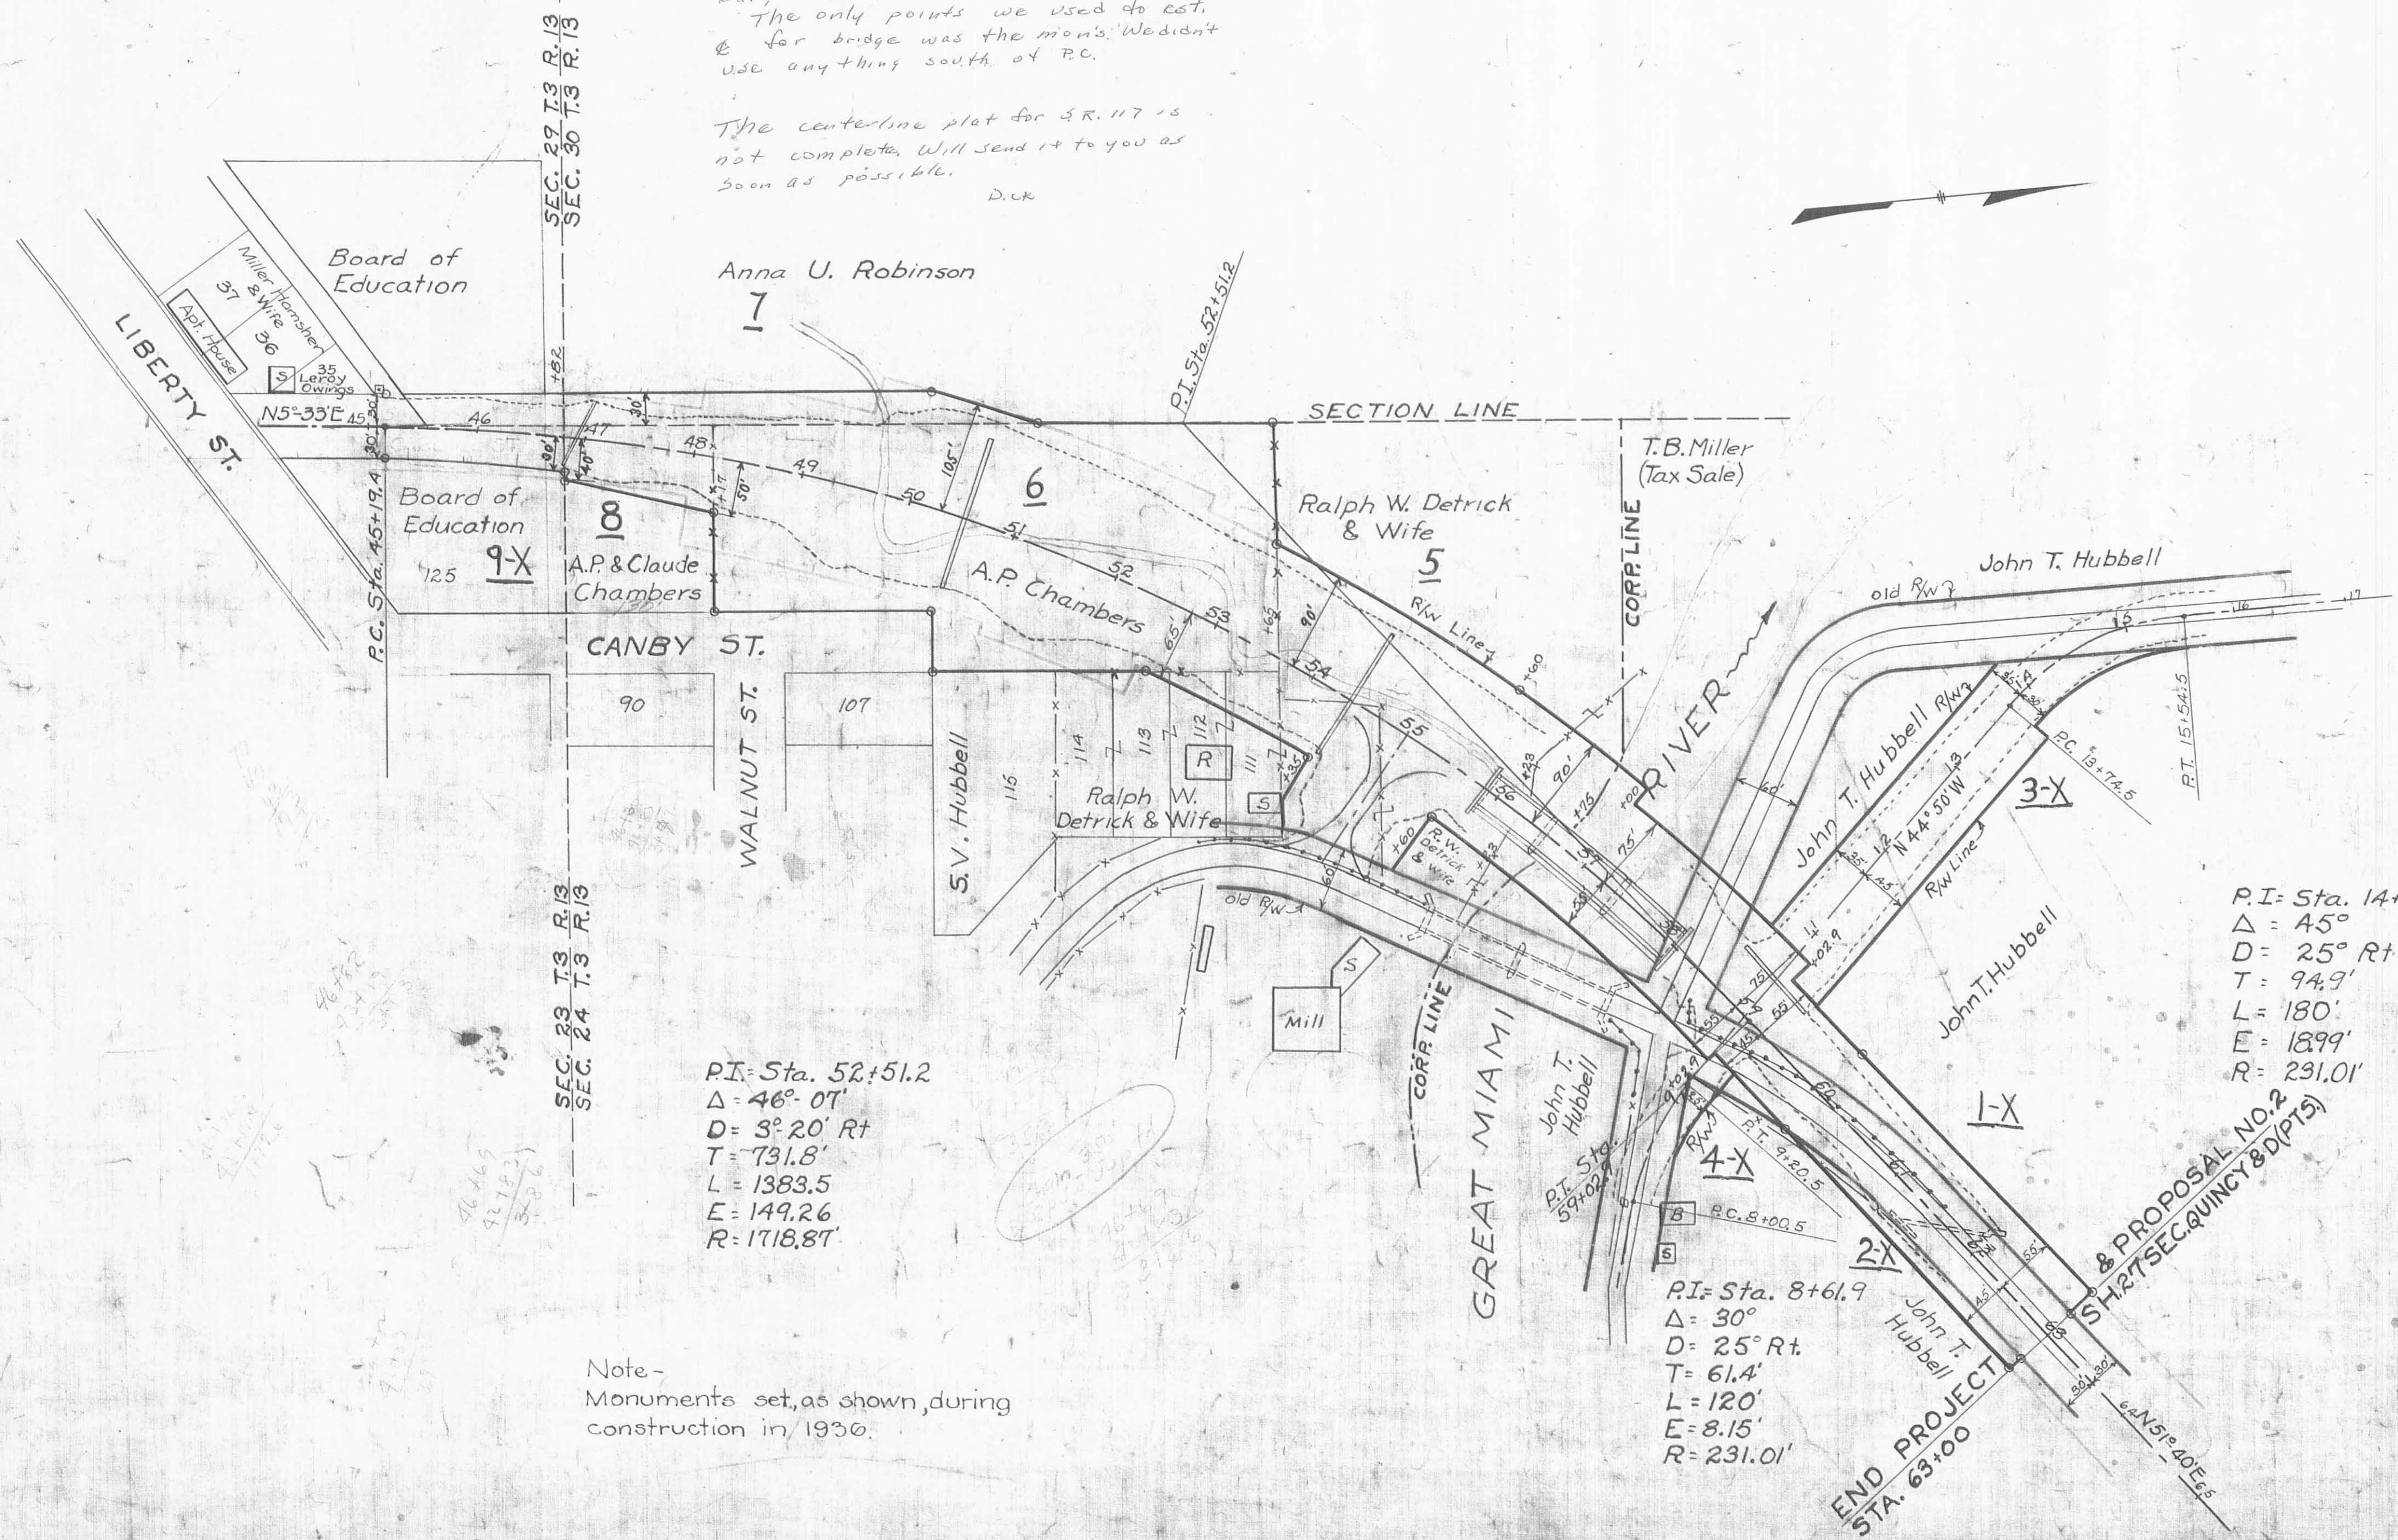

SEC. 27 T. 13 R. 13
 SEC. 30 T. 13 R. 13

SEC. 23 T. 13 R. 13
 SEC. 24 T. 13 R. 13

P.I. = Sta. 52+51.2
 $\Delta = 46^{\circ} 07'$
 $D = 3^{\circ} 20' Rt$
 $T = 731.8'$
 $L = 1383.5$
 $E = 149.26$
 $R = 1718.81'$

P.I. = Sta. 14+69.4
 $\Delta = 45^{\circ}$
 $D = 25^{\circ} Rt$
 $T = 94.9'$
 $L = 180'$
 $E = 18.99'$
 $R = 231.01'$

P.I. = Sta. 8+61.9
 $\Delta = 30^{\circ}$
 $D = 25^{\circ} Rt$
 $T = 61.4'$
 $L = 120'$
 $E = 8.15'$
 $R = 231.01'$

Note -
 Monuments set, as shown, during
 construction in 1930.

RIGHT OF
 F
 SH. 27, SEC. Q
 PROJECT
 LOG
 BRIDGE

11-16-34
 12-18-34
 2-1-35
 2-21-35
 3-28-35

10-11-2021



EXHIBIT A

Page 1 of 2

RX 270 SH

Rev. 06/09

Ver. Date 11/06/2020

PID 110472

**PARCEL 1-SH
LOG-47/235-5.23/8.18
PERPETUAL EASEMENT FOR HIGHWAY PURPOSES
WITHOUT LIMITATION OF EXISTING ACCESS RIGHTS**

An exclusive perpetual easement for public highway and road purposes, including, but not limited to any utility construction, relocation and/or utility maintenance work deemed appropriate by the State of Ohio, Department of Transportation, its successors and assigns forever.

Grantor/Owner, for himself and his heirs, executors, administrators, successors and assigns, reserves all existing rights of ingress and egress to and from any residual area (as used herein, the expression "Grantor/Owner" includes the plural, and words in the masculine include the feminine or neuter).

[Surveyor's description of the premises follows]

Situated in Section 9, Town 2, Range 14, B.T.R.S. Pleasant Township, County of Logan, State of Ohio, being part of a tract containing 1.060 acres conveyed to Tracy Robinson and Daron L. Fugate recorded in O.R. 1226 Pg. 247 (all references to deeds, microfiche, plats surveys, etc. refer to the records of Logan County, Ohio Recorder's Office, unless otherwise noted.)

Being a parcel of land lying on the left side of the existing centerline of State Route 47 found in the highway plan L-20 recorded in the office of the Logan County Map Room, and being more particularly described as follows:

Commencing at a found rail road spike in the intersection of the centerlines of State Route 47 and State Route 235 at State Route 47 station 275+88 and thence with the centerline of State Route 47 **S 77° 11' 10" W** for a distance of **313.50 feet** to a point at the grantors southeast corner;

Thence with the grantors east line **N 4° 56' 00" E** for a distance of **31.50 feet** to the north right of way line of State Route 47 to a 5/8" iron pin found 30.00 feet left of station 272+83.73 said point being **THE TRUE POINT OF BEGINNING** of this description;

Thence with the said north right of way line of State Route 47 **S 77° 11' 10" W** for a distance of **202.64 feet** to a 5/8" iron pin set in the grantors west line 30.00 feet left of station 270+81.08;



EXHIBIT A

RX 270 SH

Thence on a new division line thru the grantors tract leaving said north right of way line of State Route 47 N **67° 08' 11"** E for a distance of **143.06 feet** to a set 5/8" rebar at 54.97 feet left of station 272+21.95;

Thence continuing on a new division line thru the grantors tract N **75° 44' 42"** E for a distance of **37.00 feet** to a set 5/8" rebar at 55.90 feet left of station 272+58.94;


Thence continuing on a new division line thru the grantors tract N **80° 10' 44"** E for a distance of **32.57 feet** to a set 5/8" rebar at in the grantors east line at 54.20 feet left of station 272+91.47;

Thence with the grantors east line S **4° 56' 00"** W for a distance of **25.40 feet** to the said **TRUE POINT OF BEGINNING** of this description;

The above described area contains 0.079 acres of land more or less being a part of Logan County Auditors parcel 34-087-00-00-041-003.

The bearings of this description are based upon GPS observations using ODOT VRS network, NAD 83, Ohio North 3401, Geoid 12A (Conus).

This description was prepared under the direction of Dennis M. Blevins Ohio Registered Surveyor No. 6804 based on a field survey performed in October 2019 by TEC Engineering Inc. under the direction of Dennis M. Blevins.

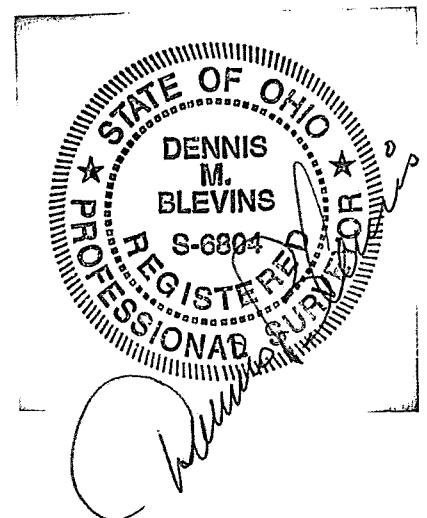

INDEXED ON MAP
9/4/20

10-11-2021



EXHIBIT A

Page 1 of 2

RX 286 T

Rev. 12/16

Ver. Date 11/06/2020

PID 110472

**PARCEL 1-T
LOG-47/235-5.23/8.18
TEMPORARY EASEMENT FOR THE PURPOSE OF
PERFORMING THE WORK NECESSARY TO
PURPOSE OF TEMPORARY
FOR 24 MONTHS FROM DATE OF ENTRY BY THE
STATE OF OHIO, DEPARTMENT OF TRANSPORTATION**

[Surveyor's description of the premises follows]

Situated in Section 9, Town 2, Range 14, B.T.R.S. Pleasant Township, County of Logan, State of Ohio being part of a tract containing 1.060 acres conveyed to Tracy Robinson and Daron L. Fugate recorded in O.R. 1226 Pg. 247 (all references to deeds, microfiche, plats surveys, etc. refer to the records of Logan County, Ohio Recorder's Office, unless otherwise noted.)

Being a parcel of land lying on the left side of the existing centerline of State Route 47 found in the highway plan L-20 recorded in the office of the Logan County Map Room, and being more particularly described as follows:

Commencing at a found rail road spike in the intersection of the centerlines of State Route 47 and State Route 235 at State Route 47 station 275+88.00 and thence with the centerline of State Route 47 **S 77° 11' 10" W** for a distance of **313.50 feet** to a point at the grantors southeast corner;

Thence with the grantors east line **N 4° 56' 00" E** for a distance of **56.90 feet** to a 5/8" iron pin set 54.20 feet left of station 272+91.47;

Thence on a new division line thru the grantors tract **S 80° 10' 44" W** for a distance of **32.57 feet** to a 5/8" iron pin set at 55.90 feet left of station 272+58.94 said point being **THE TRUE POINT OF BEGINNING** of this description;

Thence on a new division line thru the grantors tract **S 75° 44' 42" W** for a distance of **37.00 feet** to a 5/8" iron pin set at 54.97 feet left of station 272+21.95;

Thence continuing on a new division line thru the grantors tract **N 17° 47' 58" W** for a distance of **13.18 feet** to a point at 68.10 feet left of station 272+20.81;

Thence continuing on a new division line thru the grantors tract **N 75° 44' 42" E** for a distance of **37.00 feet** to a point at 69.03 feet left of station 272+57.80;

INDEXED ON MAP
9466

EXHIBIT A

RX 286 T

Page 2 of 2


Rev. 12/16

Thence continuing on a new division line thru the grantors tract **S 17° 47' 58" E** for a distance of **13.18 feet** to the said **TRUE POINT OF BEGINNING** of this description;

The above described area contains 0.011 acres of land more or less being a part of Logan County Auditors parcel 34-087-00-00-041-003.

The bearings of this description are based upon GPS observations using ODOT VRS network, NAD 83, Ohio North 3401, Geoid 12A (Conus).

This description was prepared under the direction of Dennis M. Blevins Ohio Registered Surveyor No. 6804 based on a field survey performed in October 2019 by TEC Engineering Inc. under the direction of Dennis M. Blevins.

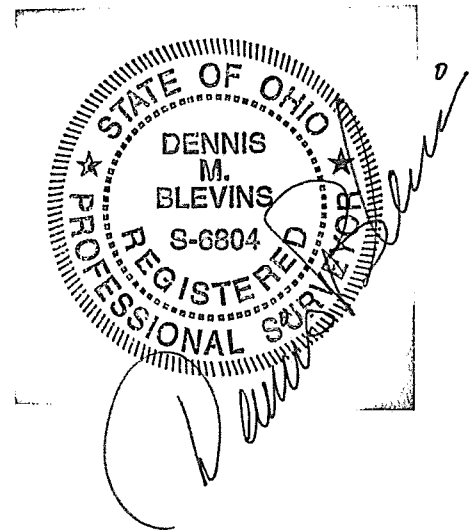

INDEXED ON MAP
9/4/16

10-11-2021



EXHIBIT A

Page 1 of 2

RX 270 SH

Rev. 06/09

Ver. Date 11/06/2020

PID 110472

**PARCEL 2-SH
LOG-47/235-5.23/8.18
PERPETUAL EASEMENT FOR HIGHWAY PURPOSES
WITHOUT LIMITATION OF EXISTING ACCESS RIGHTS**

An exclusive perpetual easement for public highway and road purposes, including, but not limited to any utility construction, relocation and/or utility maintenance work deemed appropriate by the State of Ohio, Department of Transportation, its successors and assigns forever.

Grantor/Owner, for himself and his heirs, executors, administrators, successors and assigns, reserves all existing rights of ingress and egress to and from any residual area (as used herein, the expression "Grantor/Owner" includes the plural, and words in the masculine include the feminine or neuter).

[Surveyor's description of the premises follows]

Situated in Section 9, Town 2, Range 14, B.T.R.S. Pleasant Township, County of Logan, State of Ohio being part of a tract containing 0.479 acres conveyed to Walter A. Bortree recorded in O.R. 264 Pg. 579 (all references to deeds, microfiche, plats surveys, etc. refer to the records of Logan County, Ohio Recorder's Office, unless otherwise noted.)

Being a parcel of land lying on the left side of the existing centerline of State Route 47 found in the highway plan L-20 recorded in the office of the Logan County Map Room, and being more particularly described as follows:

Commencing at a found rail road spike in the intersection of the centerlines of State Route 47 and State Route 235 at State Route 47 station 275+88.00 and thence with the centerline of State Route 47 **S 77° 11' 10" W** for a distance of **208.50 feet** to a point at the grantors southeast corner;

Thence with the grantors east line **N 4° 56' 00" E** for a distance of **31.50 feet** to the north right of way line of State Route 47 to a point 30.00 feet left of station 273+88.73 said point being **THE TRUE POINT OF BEGINNING** of this description;

INDEXED ON MAP
9466

EXHIBIT A

RX 270 SH

Thence with the said north right of way line of State Route 47 **S 77° 11' 10" W** for a distance of **105.00 feet** to a 5/8" iron pin found in the grantors west line at 30.00 feet left of station 272+83.73;

Thence with the grantors west line **N 4° 56' 00" E** for a distance of **25.40 feet** to a set 5/8" rebar at 54.20 feet left of station 272+91.47;


Thence on a new division line thru the grantors tract **N 79° 25' 10" E** for a distance of **103.79 feet** to a set 5/8" rebar in the grantors east line at 50.15 feet left of station 273+95.18;

Thence with the grantors east line **S 4° 56' 00" W** for a distance of **21.16 feet** to the said **TRUE POINT OF BEGINNING** of this description;

The above described area contains 0.053 acres of land more or less being a part of Logan County Auditors parcel 34-087-00-00-041-002.

The bearings of this description are based upon GPS observations using ODOT VRS network, NAD 83, Ohio North 3401, Geoid 12A (Conus).

This description was prepared under the direction of Dennis M. Blevins Ohio Registered Surveyor No. 6804 based on a field survey performed in October 2019 by TEC Engineering Inc. under the direction of Dennis M. Blevins.

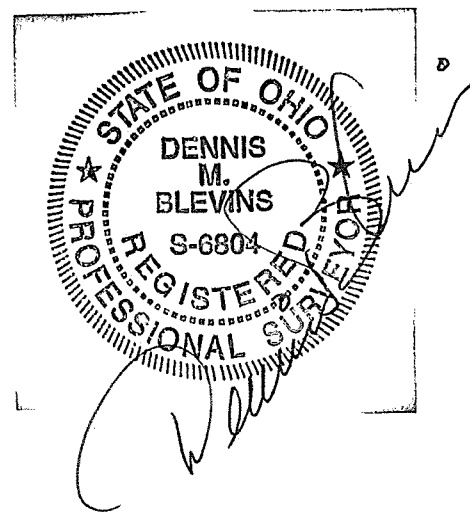

INDEXED ON MAP
gthel

10-11-2021

APPROVED

EXHIBIT A

RX 270 SH

Page 1 of 2

Rev. 06/09

Ver. Date 11/09/2020

PID 110472

**PARCEL 3-SH
LOG-47/235-5.23/8.18
PERPETUAL EASEMENT FOR HIGHWAY PURPOSES
WITHOUT LIMITATION OF EXISTING ACCESS RIGHTS**

An exclusive perpetual easement for public highway and road purposes, including, but not limited to any utility construction, relocation and/or utility maintenance work deemed appropriate by the State of Ohio, Department of Transportation, its successors and assigns forever.

Grantor/Owner, for himself and his heirs, executors, administrators, successors and assigns, reserves all existing rights of ingress and egress to and from any residual area (as used herein, the expression "Grantor/Owner" includes the plural, and words in the masculine include the feminine or neuter).

[Surveyor's description of the premises follows]

Situated in Section 9, Town 2, Range 14, B.T.R.S. Pleasant Township, County of Logan, State of Ohio being part of a tract containing 163.434 acres conveyed to Robert D. Cook and Robert G. Cook recorded in D.B. 390 Pg. 434 (all references to deeds, microfiche, plats surveys, etc. refer to the records of Logan County, Ohio Recorder's Office, unless otherwise noted.)

Being a parcel of land lying on the left side of the existing centerline of State Route 235 found in the highway plan L-20 recorded in the office of the Logan County Map Room, and being more particularly described as follows:

Commencing at a found rail road spike in the intersection of the centerlines of State Route 47 and State Route 235 at State Route 47 station 275+88.00 and thence **S 77° 11' 10" W** for a distance of **0.73 feet** to the east line of said section 9;

Thence with east line of said section 9 and near the centerline of State Route 47 **S 4° 57' 50" W** for a distance of **324.58 feet** to a point in the grantors east line;

Thence with the grantors line **N 86° 40' 52" W** for a distance of **30.04 feet** to the west right of way line of State Route 235 to a point 30.00 feet left of station 451+16.89 said point being **THE TRUE POINT OF BEGINNING** of this description;

INDEXED ON MAP
9/4/20

EXHIBIT A

RX 270 SH

Page 2 of 2

Rev. 06/09

Thence with the said west right of way line of State Route 235 **S 5° 01' 56" W** for a distance of **809.26 feet** to a set 5/8" rebar in at 30.00 feet left of station 443+07.63;

Thence on a new division line thru the grantors tract leaving the said west right of way line of State Route 235 **N 3° 59' 57" E** for a distance of **725.03 feet** to a set 5/8" rebar at 43.07 feet left of station 450+32.55;


Thence continuing on a new division line thru the grantors tract **N 5° 42' 31" E** for a distance of **83.98 feet** to a set 5/8" rebar at 42.08 feet left of station 451+16.53 in the grantor's north line;

Thence continuing on the grantors north line **S 86° 40' 52" E** for a distance of **12.09 feet** to the said **TRUE POINT OF BEGINNING** of this description;

The above described area contains 0.134 acres of land more or less being a part of Logan County Auditors parcel 34-087-00-00-047-000.

The bearings of this description are based upon GPS observations using ODOT VRS network, NAD 83, Ohio North 3401, Geoid 12A (Conus).

This description was prepared under the direction of Dennis M. Blevins Ohio Registered Surveyor No. 6804 based on a field survey performed in October 2019 by TEC Engineering Inc. under the direction of Dennis M. Blevins.

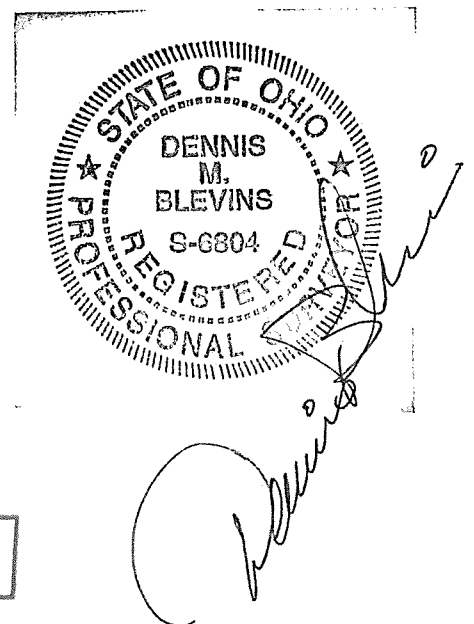

INDEXED ON MAP
9/4/20

10-12-2021



EXHIBIT A

Page 1 of 2

RX 270 SH

Rev. 06/09

Ver. Date 11/09/2020

PID 110472

**PARCEL 3-SH2
LOG-47/235-5.23/8.18
PERPETUAL EASEMENT FOR HIGHWAY PURPOSES
WITHOUT LIMITATION OF EXISTING ACCESS RIGHTS**

An exclusive perpetual easement for public highway and road purposes, including, but not limited to any utility construction, relocation and/or utility maintenance work deemed appropriate by the State of Ohio, Department of Transportation, its successors and assigns forever.

Grantor/Owner, for himself and his heirs, executors, administrators, successors and assigns, reserves all existing rights of ingress and egress to and from any residual area (as used herein, the expression "Grantor/Owner" includes the plural, and words in the masculine include the feminine or neuter).

[Surveyor's description of the premises follows]

Situated in Section 9, Town 2, Range 14, B.T.R.S. Pleasant Township, County of Logan, State of Ohio being part of a tract containing 163.434 acres conveyed to Robert D. Cook and Robert G. Cook recorded in D.B. 390 Pg. 434 (all references to deeds, microfiche, plats surveys, etc. refer to the records of Logan County, Ohio Recorder's Office, unless otherwise noted.)

Being a parcel of land lying on the right side of the existing centerline of State Route 47 found in the highway plan L-20 recorded in the office of the Logan County Map Room, and being more particularly described as follows:

Commencing at a found rail road spike in the intersection of the centerlines of State Route 47 and State Route 235 at State Route 47 station 275+88.00 and thence with the centerline of State Route 47 **S 77° 11' 10" W** for a distance of **171.62 feet** to a point at the grantors northeast corner;

Thence with the grantors east line **S 3° 05' 14" W** for a distance of **31.19 feet** to the south right of way line of State Route 47 to a point 30.00 feet right of station 274+07.46 said point being **THE TRUE POINT OF BEGINNING** of this description;



EXHIBIT A

RX 270 SH

Rev. 06/09

Thence with the grantors east line and said south right of way line of State Route 47 **S 3° 05' 14" W** for a distance of **10.40 feet** to a set 5/8" rebar in the grantors east line at 40.00 feet right of station 274+04.61;

Thence on a new division line thru the grantors tract leaving the said south right of way line of State Route 47 **S 71° 27' 05" W** for a distance of **50.62 feet** to a set 5/8" rebar at 45.06 feet right of station 273+54.25;

Thence continuing on a new division line thru the grantors tract **S 75° 54' 52" W** for a distance of **50.19 feet** to a set 5/8" rebar at 46.17 feet right of station 273+04.07;

Thence continuing on a new division line thru the grantors tract **S 81° 19' 37" W** for a distance of **100.45 feet** to a set 5/8" rebar at 38.92 feet right of station 272+03.88;

Thence continuing on a new division line thru the grantors tract **S 87° 35' 14" W** for a distance of **49.27 feet** to a set 5/8" rebar at 30.00 feet right of station 271+55.30 in the said south right of way line of State Route 47;


Thence with the south right of way line of State Route 47 **N 77° 11' 10" E** for a distance of **252.17 feet** to the said **TRUE POINT OF BEGINNING** of this description;

The above described area contains 0.067 acres of land more or less being a part of Logan County Auditors parcel 34-087-00-00-047-000.

The bearings of this description are based upon GPS observations using ODOT VRS network, NAD 83, Ohio North 3401, Geoid 12A (Conus).

This description was prepared under the direction of Dennis M. Blevins Ohio Registered Surveyor No. 6804 based on a field survey performed in October 2019 by TEC Engineering Inc. under the direction of Dennis M. Blevins.

INDEXED ON MAP
9/1/19

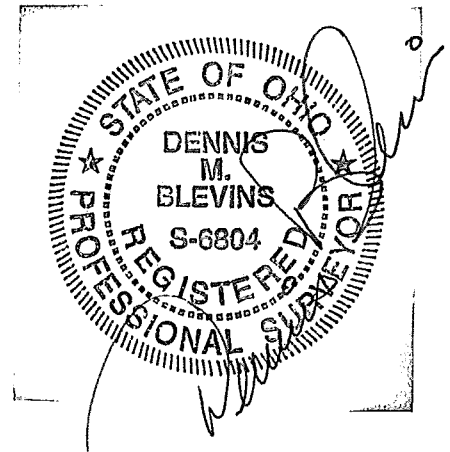

10-11-2021



EXHIBIT A

Page 1 of 2

RX 270 SH

Rev. 06/09

Ver. Date 11/09/20

PID 110472

**PARCEL 4-SH
LOG-47/235-5.23/8.18
PERPETUAL EASEMENT FOR HIGHWAY PURPOSES
WITHOUT LIMITATION OF EXISTING ACCESS RIGHTS**

An exclusive perpetual easement for public highway and road purposes, including, but not limited to any utility construction, relocation and/or utility maintenance work deemed appropriate by the State of Ohio, Department of Transportation, its successors and assigns forever.

Grantor/Owner, for himself and his heirs, executors, administrators, successors and assigns, reserves all existing rights of ingress and egress to and from any residual area (as used herein, the expression "Grantor/Owner" includes the plural, and words in the masculine include the feminine or neuter).

[Surveyor's description of the premises follows]

Situated in Section 9, Town 2, Range 14 B.T.M.R.S., Township of Pleasant, State of Ohio County of Logan, being part of a tract containing 53.375 acres conveyed to Menno Wagler, Et. Al. being recorded in O.R. 1345 Pg. 287 (all references to deeds, microfiche, plats surveys, etc. refer to the records of Logan County, Ohio Recorder's Office, unless otherwise noted.)

Being a parcel of land lying on the left side of the existing centerline of State Route 235 found in the highway plan L-20 recorded in the office of the Logan County Map Room, and being more particularly described as follows:

Commencing at a found rail road spike in the intersection of the centerlines of State Route 47 and State Route 235 at State Route 47 275+88.00 and thence **S 77° 11' 10" W** for a distance of **0.73 feet** to the east line of said section 9;

Thence with the east line of said section 9 and near the centerline of State Route 235 **N 4° 56' 00" E** for a distance of **208.50 feet** to a point in the grantors east line;

Thence with the grantors line **S 77° 11' 13" W** for a distance of **30.56 feet** to the west right of way line of State Route 235 to a point 30.00 feet left of station 456+41.42 said point being **THE TRUE POINT OF BEGINNING** of this description;

INDEXED ON MAP
9/4/21

EXHIBIT A

RX 270 SH

Thence leaving the east right of way of State Route 235 and with the grantors line to a set 5/8" rebar **S 77° 11' 13" W** for a distance of **21.55 feet** at 50.31 feet right of station 456+34.89;


Thence on a new division line thru the grantors tract for the following 8 courses:

- 1) **N 4° 16' 53" E** for a distance of **295.56 feet** to a set 5/8" rebar at 54.19 feet left of station 459+30.43;
- 2) **N 5° 08' 18" E** for a distance of **150.27 feet** to a set 5/8" rebar at 53.91 feet left of station 460+80.70;
- 3) **N 6° 53' 37" E** for a distance of **100.05 feet** to a set 5/8" rebar at 50.66 feet left of station 461+80.70;
- 4) **N 1° 04' 57" E** for a distance of **150.51 feet** to a set 5/8" rebar at 60.91 feet left of station 463+31.09;
- 5) **N 12° 18' 29" E** for a distance of **150.58 feet** to a set 5/8" rebar at 41.28 feet left of station 464+80.38;
- 6) **N 18° 31' 55" E** for a distance of **47.56 feet** to a set 5/8" rebar at 30.00 feet left of station 465+26.59;
- 7) **S 4° 49' 02" W** for a distance of **227.56 feet** with the east right of way of State Route 235 to a point at 30.00 feet left of station 462+98.97;
- 8) **S 5° 00' 54" W** for a distance of **657.41 feet** to the **TRUE POINT OF BEGINNING** of this description

The above described area contains 0.452 acres of land more or less being a part of Logan County Auditor's Permanent Parcel Number 34-087-00-00-041-000.

The bearings of this description are based upon GPS observations using ODOT VRS network, NAD 83, Ohio North 3401, Geoid 12A (Conus).

This description was prepared by Dennis M. Blevins Ohio Registered Surveyor No. 6804 based on a field survey performed in May 2020 by TEC Engineering Inc.

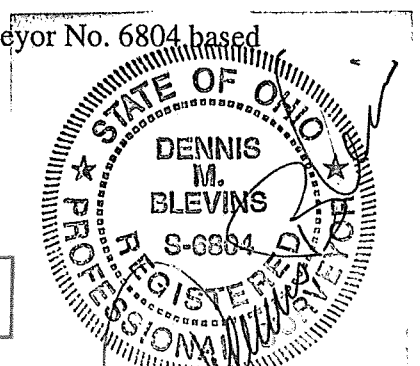

10-11-2021

APPROVED

EXHIBIT A

Page 1 of 2

RX 270 SH

Rev. 06/09

Ver. Date 10/01/20

PID 110472

**PARCEL 5-SH
LOG-47/235-5.23/8.18
PERPETUAL EASEMENT FOR HIGHWAY PURPOSES
WITHOUT LIMITATION OF EXISTING ACCESS RIGHTS**

An exclusive perpetual easement for public highway and road purposes, including, but not limited to any utility construction, relocation and/or utility maintenance work deemed appropriate by the State of Ohio, Department of Transportation, its successors and assigns forever.

Grantor/Owner, for himself and his heirs, executors, administrators, successors and assigns, reserves all existing rights of ingress and egress to and from any residual area (as used herein, the expression "Grantor/Owner" includes the plural, and words in the masculine include the feminine or neuter).

[Surveyor's description of the premises follows]

Situated in Section 9, Town 2, Range 14 B.T.M.R.S., Township of Pleasant, County of Logan, State of Ohio being part of a tract containing 1.00 acres conveyed to Walter Alan Bortree recorded in O.R. 276 Pg. 450 (all references to deeds, microfiche, plats surveys, etc. refer to the records of Logan County, Ohio Recorder's Office, unless otherwise noted.)

Being a parcel of land lying on the left side of the existing centerline of State Route 47 found in the highway plan L-20 recorded in the office of the Logan County Map Room, and being more particularly described as follows:

Commencing at a found railroad spike in the intersection of the centerlines of State Route 47 and State Route 235 at State Route station 47 275+88.00 and thence with the centerline of State Route 47 **S 77° 11' 10" W** for a distance of **208.50 feet** to a point;

Thence leaving the centerline of State Route 47 **N 4° 56' 00" E** for a distance of **31.50 feet** to a point in the north right of way line of State Route 47 at 30.00 feet left of station 273+88.73 being the **TRUE POINT OF BEGINNING**;

Thence leaving the north right of way line of State Route 47 with the grantors west line to a set 5/8" rebar **N 4° 56' 00" E** for a distance of **21.16 feet** at 50.15 feet left of station 273+95.18;

INDEXED ON MAP
9466

EXHIBIT A

RX 270 SH



Thence on a new division line thru the grantors tract for the following 7 courses:

- 1) **N 58° 55' 56" E** for a distance of **27.46 feet** to a set 5/8" rebar at 58.75 feet left of station 274+21.26;
- 2) **N 75° 54' 57" E** for a distance of **111.73 feet** to a set 5/8" rebar at 61.23 feet left of station 275+32.97;
- 3) **N 47° 39' 56" E** for a distance of **27.23 feet** to a set 5/8" rebar at 74.65 feet left of station 275+56.66 S.R. 47 and 52.71 feet left of station 455+03.93 S.R. 235;
- 4) **N 6° 04' 50" E** for a distance of **130.99 feet** to a set 5/8" rebar at 198.49 feet left of station 276+00.40 S.R. 47 and 50.31 feet left of station 456+34.89 S.R. 235 in the grantors north line;
- 5) **N 77° 11' 13" E** for a distance of **21.55 feet** to a point in the existing west right of way line of State Route 235 at 30.00 feet left of station 456+41.21 and 198.34 feet left of station 276+21.74 S.R.47;
- 6) **S 5° 05' 45" W** for a distance of **177.16 feet** to a point at the intersection of the west right of way line of State Route 235 and the north right of way of State Route 47 at 30.00 feet right of station 275+66.14;
- 7) **S 77° 11' 10" W** with the north right of way of State Route 47 for a distance of **177.42 feet** to the **TRUE POINT OF BEGINNING** of this description

The above described area contains 0.196 acres of land more or less being a part of Logan County Auditor's Permanent Parcel Number 34-087-00-00-042-00.

The bearings of this description are based upon GPS observations using ODOT VRS network, NAD 83, Ohio North 3401, Geoid 12A (Conus).

This description was prepared by Dennis M. Blevins Ohio Registered Surveyor No. 6804 based on a field survey performed in May 2020 by TEC Engineering Inc.

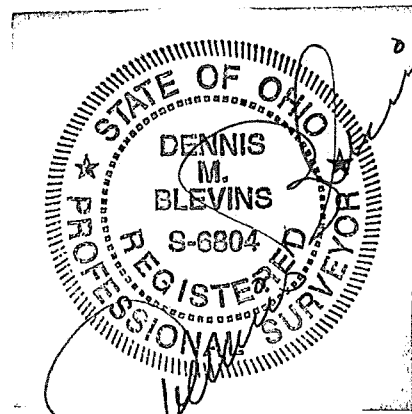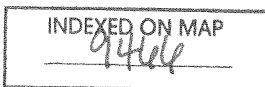

10-11-2021



EXHIBIT A

Page 1 of 2

RX 270 SH

Rev. 06/09

Ver. Date 10/01/20

PID 110472

**PARCEL 7-SH
LOG-47/235-5.23/8.18
PERPETUAL EASEMENT FOR HIGHWAY PURPOSES
WITHOUT LIMITATION OF EXISTING ACCESS RIGHTS**

An exclusive perpetual easement for public highway and road purposes, including, but not limited to any utility construction, relocation and/or utility maintenance work deemed appropriate by the State of Ohio, Department of Transportation, its successors and assigns forever.

Grantor/Owner, for himself and his heirs, executors, administrators, successors and assigns, reserves all existing rights of ingress and egress to and from any residual area (as used herein, the expression "Grantor/Owner" includes the plural, and words in the masculine include the feminine or neuter).

[Surveyor's description of the premises follows]

Situated in Section 3, Town 2, Range 14 B.T.M.R.S., Township of Pleasant, County of Logan, State of Ohio, and being part of a tract containing originally 44 acres conveyed to Alan Joseph Winner, Trustee recorded in O.R. 1280 Pg. 205 Tract III, Parcel 3 (all references to deeds, microfiche, plats surveys, etc. refer to the records of Logan County, Ohio Recorder's Office, unless otherwise noted.)

Commencing at a found Rail Road Spike at the grantors southwest corner and station 275+88.00 centerline of State Route 47. Thence with the grantors south line **N 76° 39' 54" E** for a distance of **45.09 feet** to a point at 0.14 feet left of station 276+45.33;

Thence leaving the grantor's south line **N 13° 20' 06" W** for a distance of **29.86 feet** to the point of intersection of north right of way line of State Route 47 and the east right of way of State Route 235 at 30.00 feet left of station 276+45.26 being the **TRUE POINT OF BEGINNING**;

Thence leaving the north right of way line of State Route 47 with the east right of way of State Route 235 to a set 5/8" rebar **N 5° 01' 56" E** for a distance of **161.21 feet** at 45.00 feet right of station 456+50.09;

Thence on a new division line thru the grantors tract for the following 4 courses:

1) **S 17° 03' 46" E** for a distance of **135.27 feet** to a set 5/8" rebar at 48.20 feet left of station 277+05.63 State Route 47;

INDEXED ON MAP
9/4/21

EXHIBIT A

RX 270 SH

2) **N 76° 48' 10" E** for a distance of **281.83 feet** to a set 5/8" rebar at 48.20 feet left of station 279+87.46;


3) **S 86° 58' 08" E** for a distance of **65.14 feet** to a set 5/8" rebar at 30.00 feet left of station 280+50.00 in the existing north right of way line of State Route 47;

4) **S 76° 48' 10" W** for a distance of **404.74 feet** to the **TRUE POINT OF BEGINNING** of this description

The above described area contains 0.239 acres of land more or less being a part of Logan County Auditor's Permanent Parcel Number 34-087-00-00-043-00.

The bearings of this description are based upon GPS observations using ODOT VRS network, NAD 83, Ohio North 3401, Geoid 12A (Conus).

This description was prepared by Dennis M. Blevins Ohio Registered Surveyor No. 6804 based on a field survey performed in May 2020 by TEC Engineering Inc.

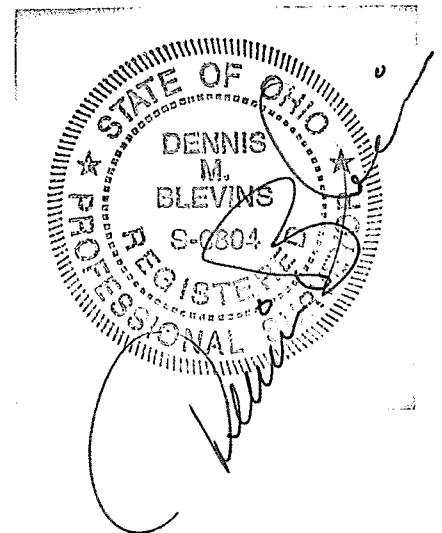

INDEXED ON MAP
9466

10-11-2021



EXHIBIT A

Page 1 of 2

RX 270 SH

Rev. 06/09

Ver. Date 10/01/20

PID 110472

**PARCEL 8-SH
LOG-47/235-5.23/8.18
PERPETUAL EASEMENT FOR HIGHWAY PURPOSES
WITHOUT LIMITATION OF EXISTING ACCESS RIGHTS**

An exclusive perpetual easement for public highway and road purposes, including, but not limited to any utility construction, relocation and/or utility maintenance work deemed appropriate by the State of Ohio, Department of Transportation, its successors and assigns forever.

Grantor/Owner, for himself and his heirs, executors, administrators, successors and assigns, reserves all existing rights of ingress and egress to and from any residual area (as used herein, the expression "Grantor/Owner" includes the plural, and words in the masculine include the feminine or neuter).

[Surveyor's description of the premises follows]

Situated in Section 3, Town 2, Range 14 B.T.M.R.S., Township of Pleasant, County of Logan, State of Ohio, and being part of a tract containing 219.329 acres conveyed to Larry G. Culp and Doris Ann Culp recorded in O.R. 1128 Pg. 662 Tract II (all references to deeds, microfiche, plats surveys, etc. refer to the records of Logan County, Ohio Recorder's Office, unless otherwise noted.)

Commencing at a found Rail Road Spike at the grantors northwest corner and station 275+88.00 centerline of State Route 47. Thence with the grantors north line N 76° 39' 54" E for a distance of 355.64 feet to a point at 0.86 feet left of station 279+43.64;

Thence leaving the grantor's north line **S 13° 20' 06" E** for a distance of **30.86 feet** to a point in the south right of way line of State Route 47 at 30.00 feet right of station 279+43.71 being the **TRUE POINT OF BEGINNING;**

Thence continuing on a new division line thru the grantors tract for the following 9 courses:

- 1) **S 72° 27' 18" W** for a distance of **38.11 feet** to a set 5/8" rebar at 32.89 feet right of station 279+05.71;



EXHIBIT A

RX 270 SH


- 2) **S 67° 54' 48" W** for a distance of **151.82 feet** to a set 5/8" rebar at 56.35 feet right of station 277+55.71;
- 3) **S 60° 55' 17" W** for a distance of **72.80 feet** to a set 5/8" rebar at 76.27 feet right of station 276+85.69;
- 4) **S 23° 01' 13" W** for a distance of **231.18 feet** to a set 5/8" rebar at 45.25 feet right of station 451+80.72 State Route 235;
- 5) **S 16° 03' 52" W** for a distance of **50.72 feet** to a set 5/8" rebar at 35.55 feet right of station 451+30.94 State Route 235;
- 6) **S 3° 44' 20" W** for a distance of **126.58 feet** to a set 5/8" rebar at 38.41 feet right of station 450+04.39 State Route 235;
- 7) **S 5° 59' 13" W** for a distance of **504.46 feet** to a set 5/8" rebar at 30.00 feet right of station 445+00.00 State Route 235;
- 8) **N 5° 01' 56" E** for a distance of **920.78 feet** to a set 5/8" rebar in the south right of way line of State Route 47 at 30.00 feet right of station 276+09.70;
- 9) **N 76° 48' 10" E** with the south right of way line of State Route 47 for a distance of **334.01 feet** to **TRUE POINT OF BEGINNING** of this description

The above described area contains 0.508 acres of land more or less being a part of Logan County Auditor's Permanent Parcel Number 34-087-00-00-045-000.

The bearings of this description are based upon GPS observations using ODOT VRS network, NAD 83, Ohio North 3401, Geoid 12A (Conus).

This description was prepared by Dennis M. Blevins Ohio Registered Surveyor No. 6804 based on a field survey performed in May 2020 by TEC Engineering Inc.

INDEXED ON MAP
9466

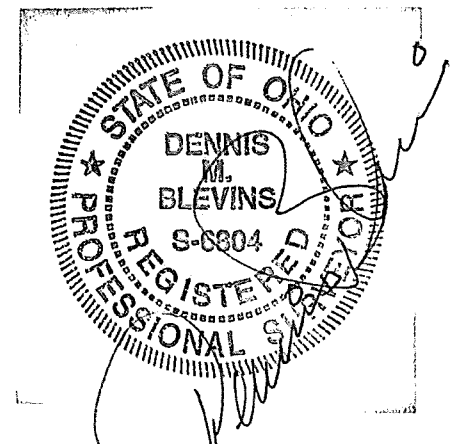

LOG-47/235-5.23/8.18

MODEL: RC001 PAPER: 17x11 (in.) DATE: 10/7/2021 TIME: 11:01:07 AM USER: ygoldfeder
 \\10.1.1.projects\work\sets\110472_LOGAN\403-Engineering\RW\RW-Sheets\Sheet 2 - 110472_RC001.dgn



- MONUMENT LEGEND**
- ☒ EXISTING RW MONUMENT BOX
 - ☒ PROPOSED RW MONUMENT BOX
 - ⊙ EXISTING CONCRETE MONUMENT
 - PROPOSED CONCRETE MONUMENT
 - ✂ RAILROAD SPIKE FOUND
 - ✂ RAILROAD SPIKE SET
 - I.P.F. 5/8" IRON PIN FOUND
 - ⊙ I.P.F. 5/8" IRON PIN FOUND W/ ID CAP
 - I.P.S. 5/8" IRON PIN SET W/ ID CAP
 - ⊙ I.P.F. 1" IRON PIPE FOUND
 - I.P.S. 1" IRON PIPE SET
 - P.K.F. P.K. NAIL FOUND
 - P.K.S. P.K. NAIL SET

SETTING OF ALL MONUMENTS SHALL BE PERFORMED BY A SURVEYOR REGISTERED IN THE STATE OF OHIO. THE MONUMENT ASSEMBLIES AND REFERENCE MONUMENTS WILL BE INSTALLED BY THE CONTRACTOR AT THE TIME OF CONSTRUCTION. THE IRON PIN AND CAP (WHEN REQUIRED) ARE TO BE INSTALLED BY THE CONTRACTOR'S SURVEYOR.


NOTE: THE EXISTING RW WIDTH AND LOCATION WERE DETERMINED USING LOG-235-8.19 and LOG-47 S.H. 234 SEC I-J RW Plans.

CHANGES OR ALTERATIONS TO THE LOCATION OF ANY MONUMENTS SHOWN IN THIS TABLE, REQUIRE PRIOR APPROVAL FROM THE DISTRICT REAL ESTATE ADMINISTRATOR OF THE OHIO DEPARTMENT OF TRANSPORTATION. IN THE EVENT THAT CHANGES OR ALTERATIONS ARE APPROVED, A REVISED CENTERLINE PLAT WITH THE NEW LOCATIONS SHALL BE RECORDED IN THE APPLICABLE COUNTY RECORDS AND THE OHIO DEPARTMENT OF TRANSPORTATION. SPECIFICATIONS FOR MONUMENT ASSEMBLIES, REFERENCE MONUMENTS AND RIGHT OF WAY MONUMENTS ARE SHOWN ON STANDARD CONSTRUCTION DRAWING RM-1.1.

LOGAN COUNTY
 PLEASANT TOWNSHIP
 SEC. 3 & 9, T. 2, R. 14 B.T.M.R.S.

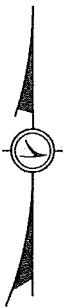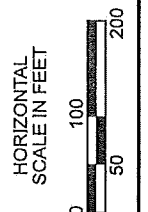

CENTERLINE PLAT

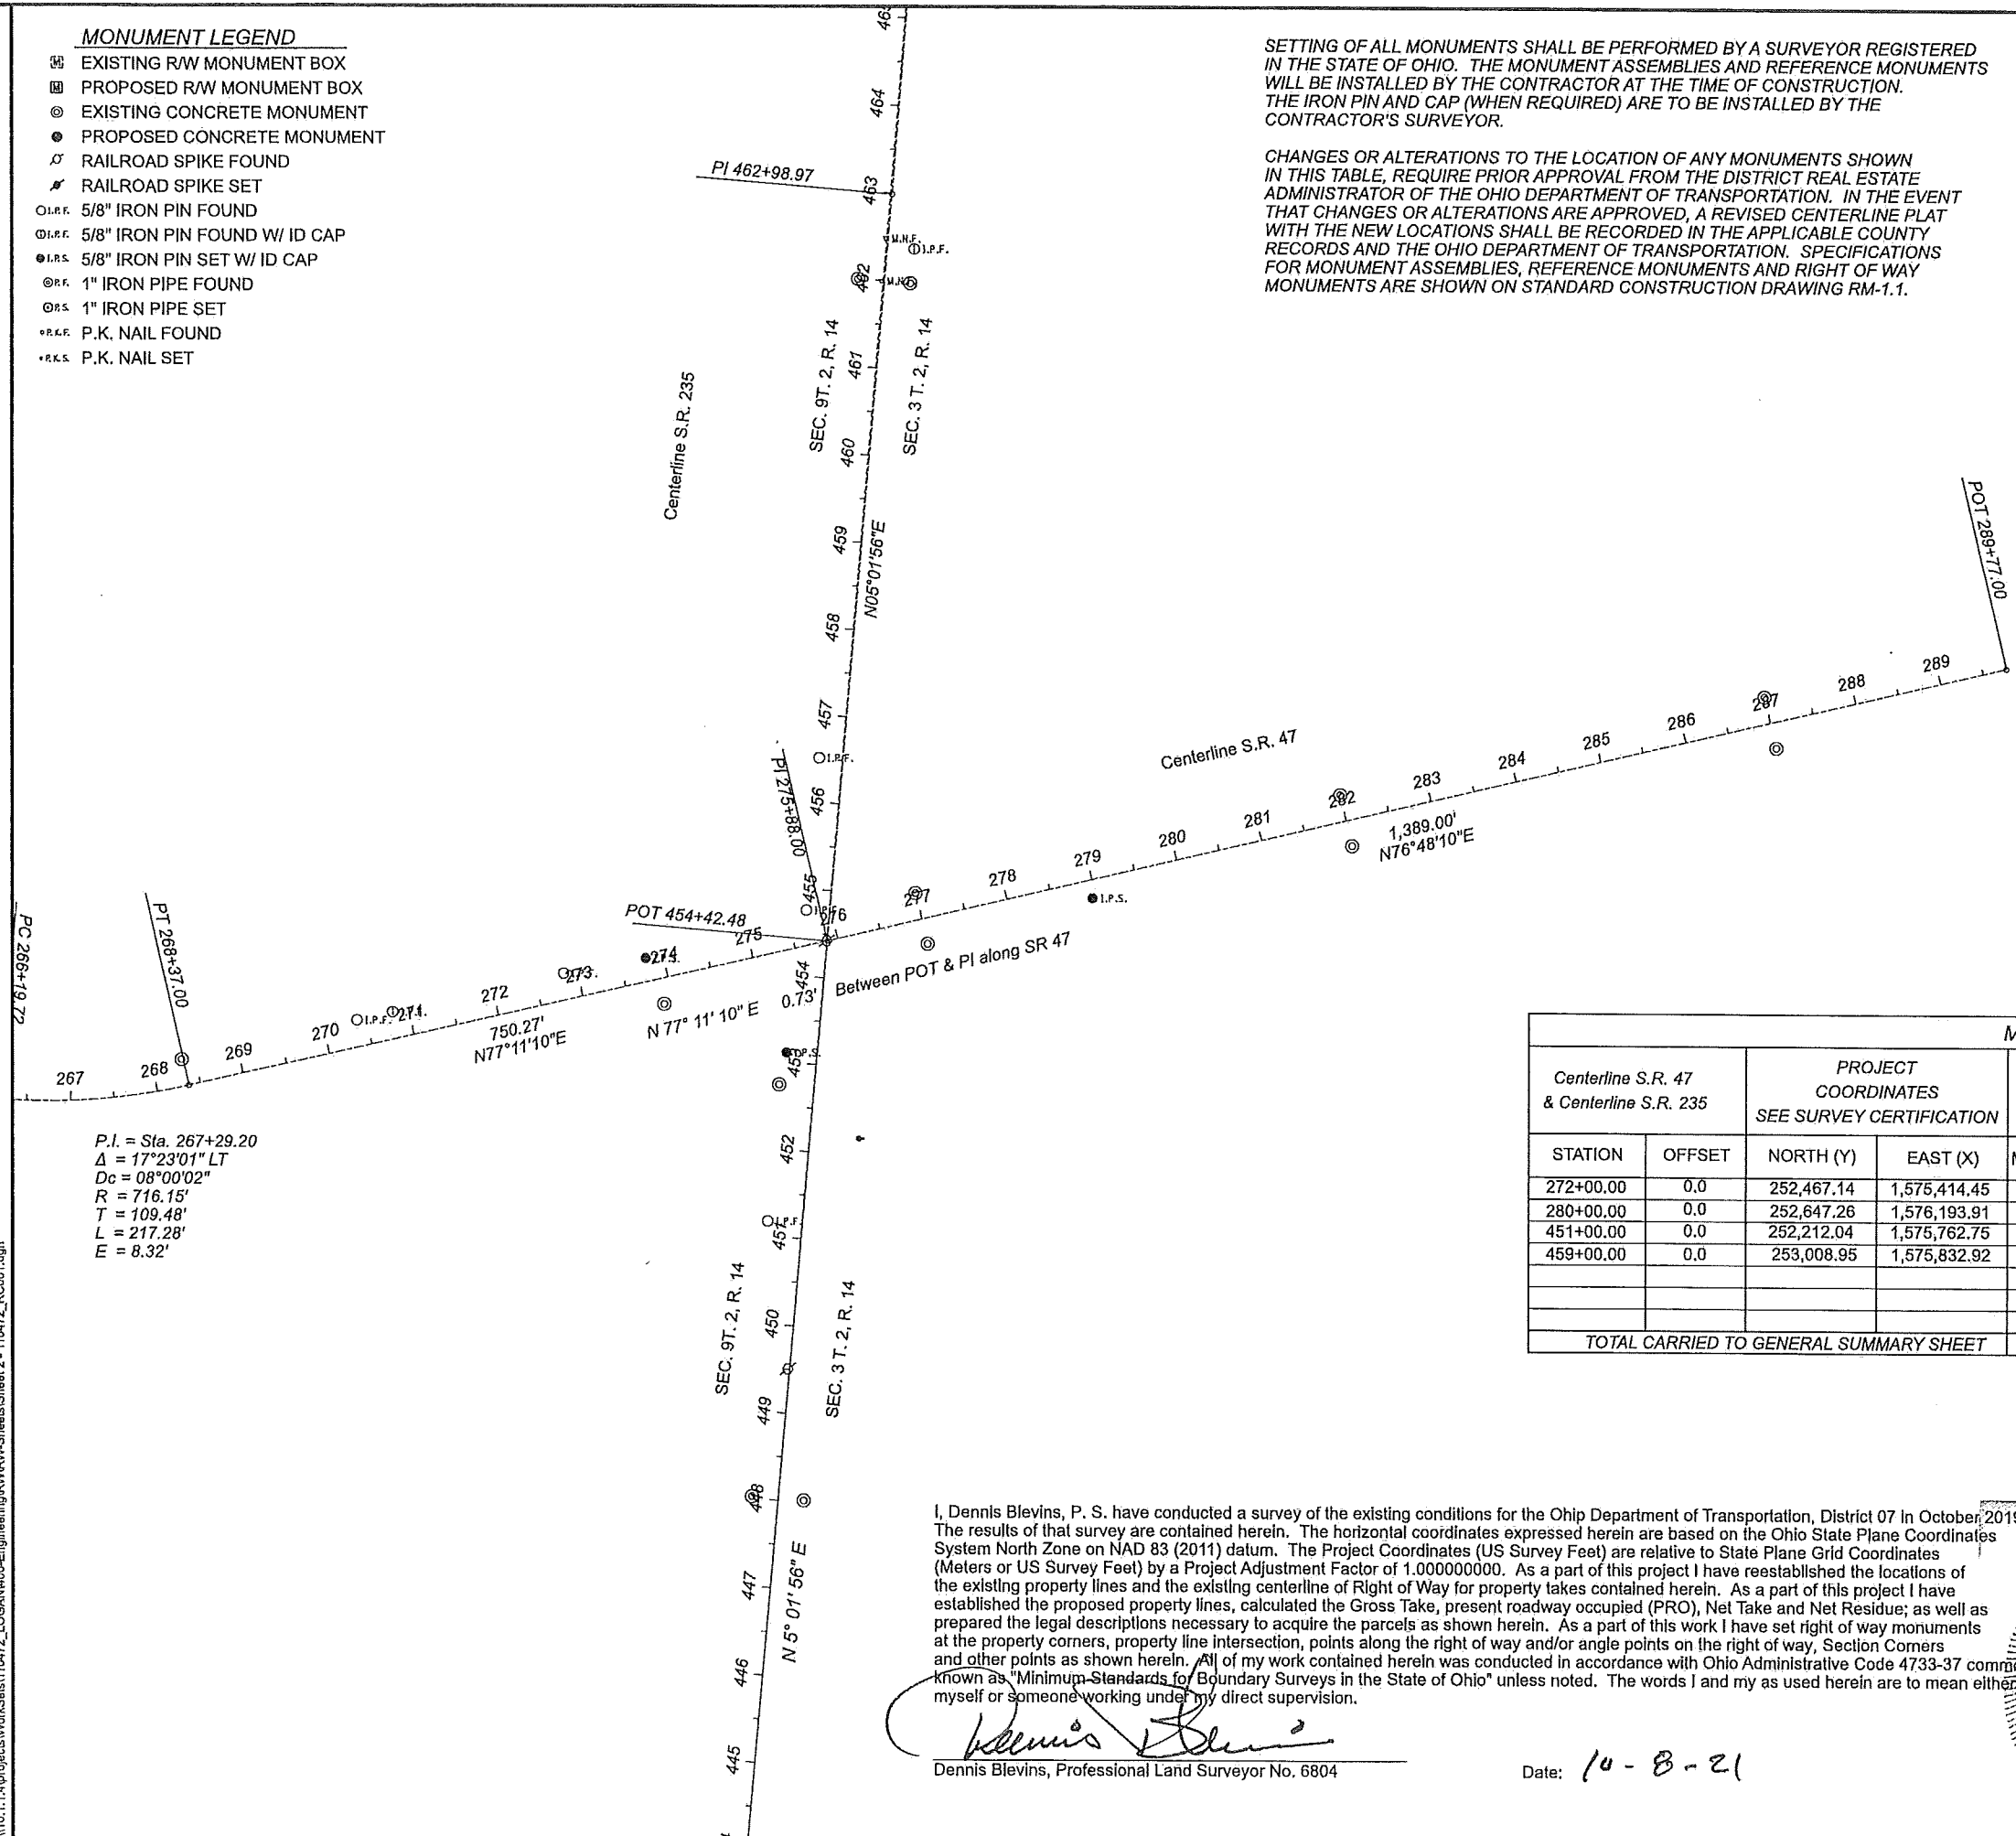

P.I. = Sta. 267+29.20
 $\Delta = 17^{\circ}23'01''$ LT
 $Dc = 08^{\circ}00'02''$
 $R = 716.15'$
 $T = 109.48'$
 $L = 217.28'$
 $E = 8.32'$

MONUMENT TABLE							
Centerline S.R. 47 & Centerline S.R. 235		PROJECT COORDINATES SEE SURVEY CERTIFICATION		MONUMENTS TO BE SET DURING CONSTRUCTION		RW MON. EXPECTED TO BE DISTURBED	
STATION	OFFSET	NORTH (Y)	EAST (X)	MON. ASSY.	REF. MON.	RW MON.	DESCRIPTION
272+00.00	0.0	252,467.14	1,575,414.45	1			
280+00.00	0.0	252,647.26	1,576,193.91	1			
451+00.00	0.0	252,212.04	1,575,762.75	1			
459+00.00	0.0	253,008.95	1,575,832.92	1			
TOTAL CARRIED TO GENERAL SUMMARY SHEET				4			


BASIS FOR BEARINGS:

ALL BEARINGS SHOWN ARE FOR PROJECT USE ONLY. Bearings shown hereon are based on GPS observations. O.D.O.T VRS system used for grid coordinates. Elevations are NAVD, 88, using Geoid 20 12B

I, Dennis Blevins, P. S. have conducted a survey of the existing conditions for the Ohio Department of Transportation, District 07 in October, 2019. The results of that survey are contained herein. The horizontal coordinates expressed herein are based on the Ohio State Plane Coordinates System North Zone on NAD 83 (2011) datum. The Project Coordinates (US Survey Feet) are relative to State Plane Grid Coordinates (Meters or US Survey Feet) by a Project Adjustment Factor of 1.000000000. As a part of this project I have reestablished the locations of the existing property lines and the existing centerline of Right of Way for property takes contained herein. As a part of this project I have established the proposed property lines, calculated the Gross Take, present roadway occupied (PRO), Net Take and Net Residue; as well as prepared the legal descriptions necessary to acquire the parcels as shown herein. As a part of this work I have set right of way monuments at the property corners, property line intersection, points along the right of way and/or angle points on the right of way, Section Corners and other points as shown herein. All of my work contained herein was conducted in accordance with Ohio Administrative Code 4733-37 commonly known as "Minimum Standards for Boundary Surveys in the State of Ohio" unless noted. The words I and my as used herein are to mean either myself or someone working under my direct supervision.

Dennis Blevins
 Dennis Blevins, Professional Land Surveyor No. 6804

Date: 10-8-21

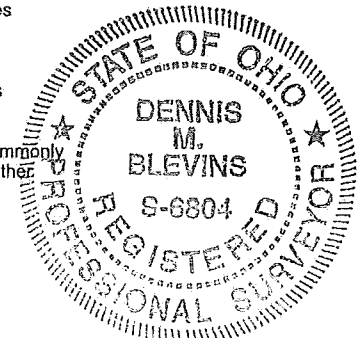

RECEIVED _____, 20__	
RECORDED _____, 20__	
BOOK _____ PAGE _____	
COUNTY RECORDER	

DESIGN AGENCY
TEL Engineering Inc.
 TEC Engineering, Inc.
 1101 S. State St.,
 Columbus, OH 43260

DESIGNER
 DMB

REVIEWER
 SGB 12-02-20

PROJECT ID
 110472

SUBSET	TOTAL
2	12
SHEET	TOTAL
100	114

TOTAL NUMBER OF :

5 OWNERSHIPS 0 TOTAL TAKES
8 PARCELS 0 OWNERSHIPS W/ STRUCTURES INVOLVED

NET RESIDUE = RECORD AREA - TOTAL PRO - NET TAKE

NET TAKE = GROSS TAKE - PRO IN TAKE

GRANTEE:

ALL RIGHT OF WAY ACQUIRED IN THE NAME OF
DEPARTMENT OF TRANSPORTATION
UNLESS OTHERWISE SHOWN.

ALL AREAS IN ACRES

PARCEL NO.	OWNER	SHEET NO.	OWNERS RECORD	AUDITOR'S PARCEL	RECORD AREA	TOTAL P.R.O.	GROSS TAKE	P.R.O. IN TAKE	NET TAKE	STRUC-TURE	NET RESIDUE		TYPE FUND	REMARKS	AS ACQUIRED	
											LEFT	RIGHT			BOOK	PAGE
1-SH	TRACY ROBINSON & DARON L. FUGATE		O.R. 1226, Pg. 247	34-087-00-00-041-003	1.060	0.000	0.079	0.000	0.079		0.981					
1-T						0.000	0.011	0.000	0.011							
2-SH	WALTER A. BORTREE		O.R. 264, Pg. 579	34-087-00-00-041-002	0.479	0.000	0.053	0.000	0.053		0.426					
3-SH1	ROBERT D. COOK & ROBERT G. COOK		D.B. 390, Pg. 434	34-087-00-00-047-000	163.434	0.000	0.134	0.000	0.134			163.229				
3-SH2						0.000	0.067	0.000	0.067							
4-SH	MENNO WAGLER, ET AL		O.R. 1345, Pg. 287	34-087-00-00-041-000	53.375	0.000	0.452	0.000	0.452		52.923					
5-SH	WALTER ALAN BORTREE		O.R. 276, Pg. 450	34-087-00-00-042-000	1	0.000	0.200	0.000	0.200		0.800					
6	ROBERT D. COOK & ROBERT G. COOK		O.R. 51, Pg. 322	34-087-00-00-046-000	1.10	0.000	0.000	0.000	0.000			1.10		NO TAKE		
7-SH	ALAN JOSEPH WINNER, TRUSTEE ET AL		O.R. 1280, Pg. 205	34-087-00-00-043-000	44	0.000	0.190	0.000	0.190		107.964					
8-SH	LARRY G. CULP AND DORIS ANN CULP		O.R. 1128, Pg. 662	34-087-00-00-045-000	219.329	0.000	0.508	0.000	0.508			218.821				

RIGHT OF WAY PLAN
SUMMARY OF ADDITIONAL RIGHT OF WAY

LOG-47/235-5.23/8.18

MODEL: R5001 PAPER SIZE: 17x11 (in.) DATE: 10/7/2021 TIME: 11:01:10 AM USER: vgcldfeder
\\10.11.4\projects\Worksets\110472\LOGAN\400-Engineer\log\RW\RW-Sheets\Sheet 4 - 110472-R5001.dgn

NOTE: UNDER NO CIRCUMSTANCES ARE TEMPORARY EASEMENTS TO BE USED FOR STORAGE OF MATERIAL OR EQUIPMENT BY THE CONTRACTOR UNLESS NOTED OTHERWISE.


NOTE: ALL TEMPORARY PARCELS TO BE OF 24 MONTH DURATION.

TYPES OF TITLE LEGEND:
WL = FEE SIMPLE WITH LIMITATION OF ACCESS
WD = WARRANTY DEED
PRW = PROPERTY RIGHT FEE SIMPLE
SH = STANDARD HIGHWAY EASEMENT
LA = LIMITED ACCESS EASEMENT
T = TEMPORARY EASEMENT
CH = CHANNEL EASEMENT
A = AERIAL EASEMENT
SL = SLOPE EASEMENT
PRE = PROPERTY RIGHT EASEMENT

(c) = CALCULATED AREA

* DENOTES RIGHT OF WAY ENCROACHMENT

DESIGNER	DMB	
REVIEWER	SGB 12-02-20	
PROJECT ID	110472	
SUBSET	4	
TOTAL	12	
SHEET	102	
TOTAL	114	
REV. BY	DATE	DESCRIPTION
FIELD REVIEW BY	DATE:	
OWNERSHIP VERIFIED BY	DATE:	
DATE COMPLETED		

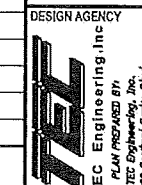


DESIGN AGENCY
TEC Engineering Inc.
PLM PROVIDED BY
TEC Engineering, Inc.
727
Mason, OH 45040

LOG-47/235-5.23/8.18

MODEL: R0004 PAPER: SIZE: 17x11 (in.) DATE: 10/12/2021 TIME: 7:01:36 AM USER: dblevins
\\D:\Projects\Worksets\110472\LOGAN\100-Engineering\RW-Sheets\Sheet 8 - 110472_R0004.dgn

LOGAN COUNTY
PLEASANT TOWNSHIP
SECTION 9, TOWN 2, RANGE 14

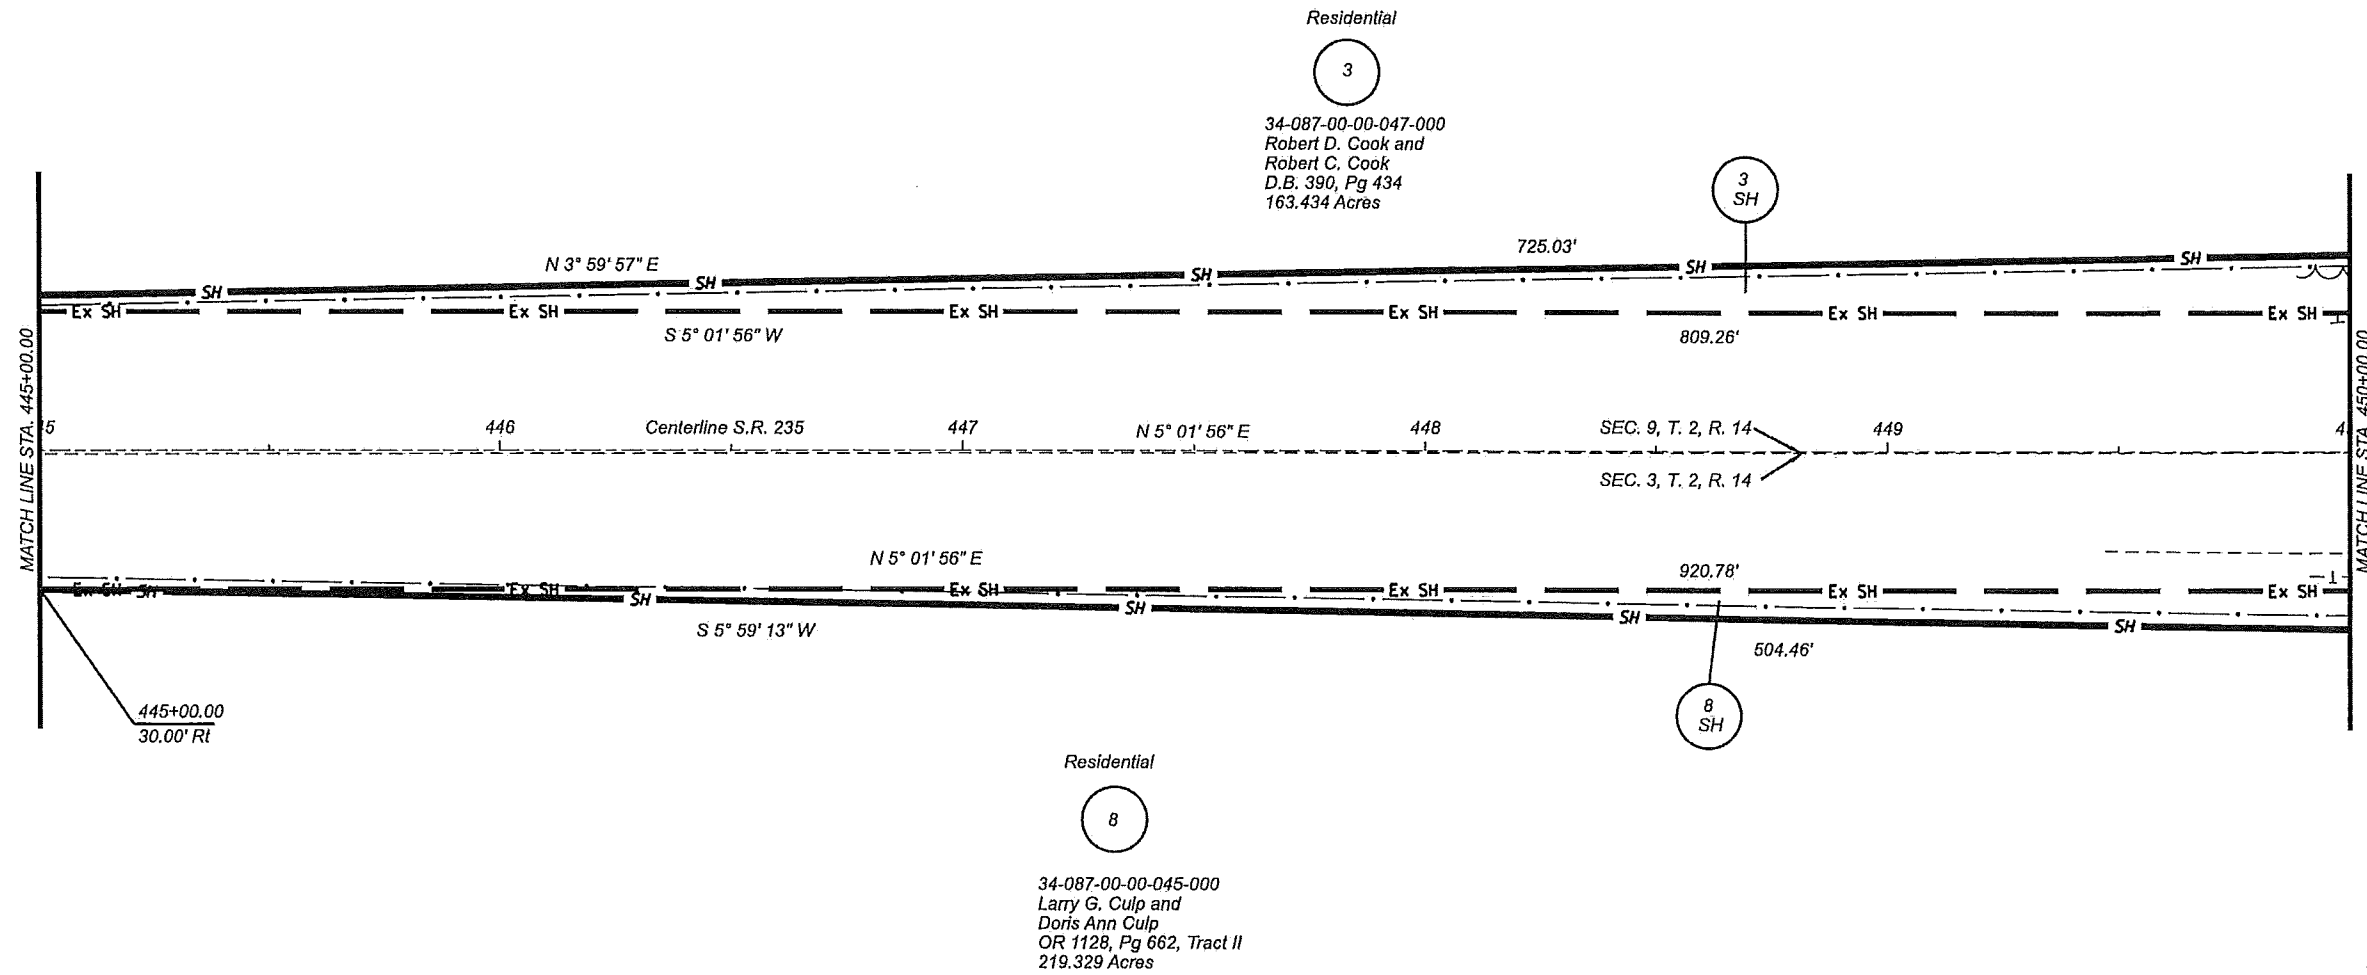


RIGHT OF WAY PLAN
STA. 445+00.00 TO 450+00.00

LOGAN COUNTY, OHIO
PLEASANT TOWNSHIP
SECTION 3, TOWN 2, RANGE 14


DESIGN AGENCY	
DESIGNER	DMB
REVIEWER	SGB
PROJECT ID	110472
SUBSET	TOTAL
8	12
SHEET	TOTAL
106	114

LOGAN COUNTY
PLEASANT TOWNSHIP
SECTION 9, TOWN 2, RANGE 14

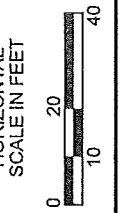

Residential
4

34-087-00-00-041-000
Menno Wagler, ET. AL.
OR 1345, Pg 287
53.375 Acres

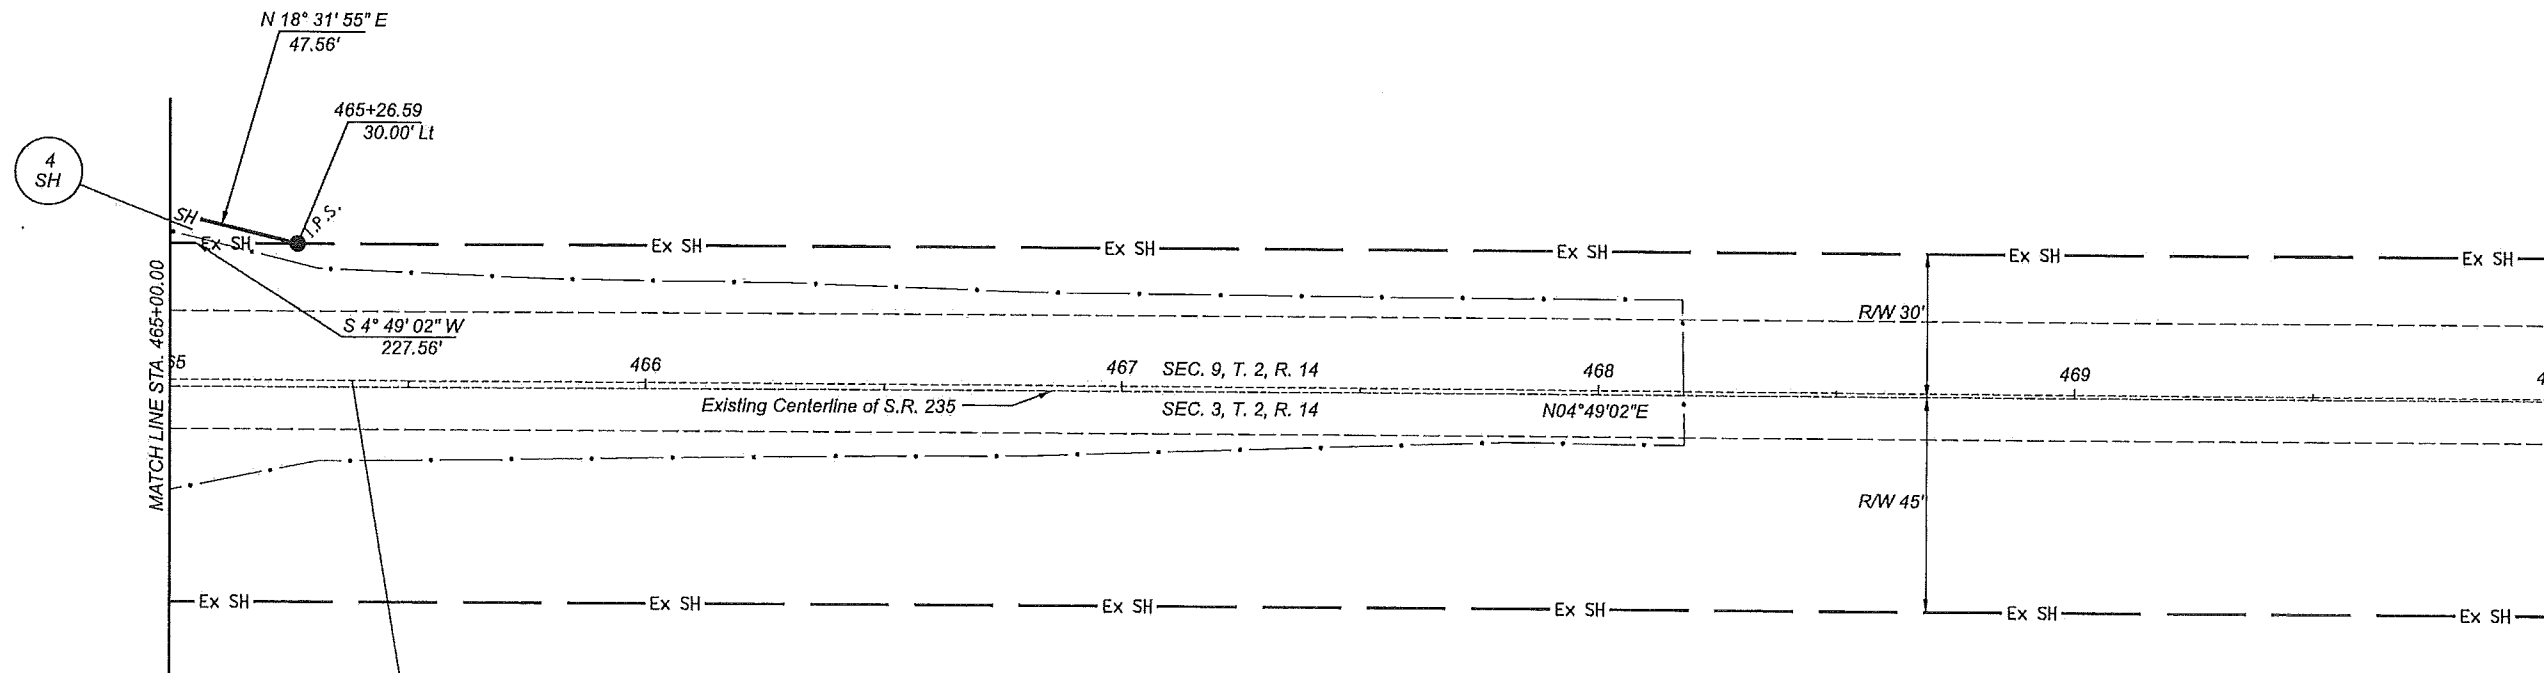

34-087-00-00-043-001
Shawn Eric Holycross ET AL
OR 1130, Pg 135, Tract I
2.00 Acres

34-087-00-00-043-002
Shawn Eric Holycross ET AL
OR 1130, Pg 135, Tract II
9.846 Acres

RIGHT OF WAY PLAN
STA. 465+00.00 TO 470+00.00 S.R. 235

LOGAN COUNTY
PLEASANT TOWNSHIP
SECTION 3, TOWN 2, RANGE 14

REV. BY	DATE	DESCRIPTION	SHEET	TOTAL
DATE COMPLETED			110	114

DESIGN AGENCY	TEC Engineering, Inc. 7234 Highway 100, West Mason, OH 45540
DESIGNER	DMB
REVIEWER	SGB 12-02-20
PROJECT ID	110472
SUBSET	TOTAL
12	12

LOG-47235-5.23/8.18

MODEL: R0007 PAPER SIZE: ITXII (in.) DATE: 10/17/2021 TIME: 11:01:17 AM USER: vgoldfeder
\\NOJL14\projects\worksets\110472\LOGAN\400-Engineering\RW\RW-Sheets\Sheet 12 - 110472_R0007.dgn