Surveyed for W. J. Coen
8/27/25
W. A. Montgomery
Wm Downing

(145)
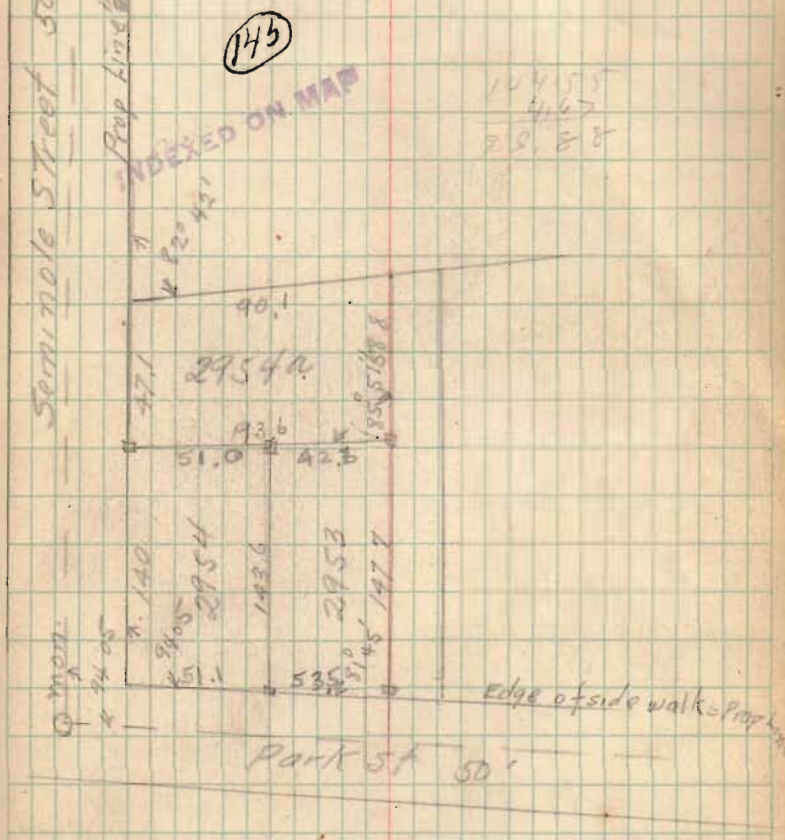
INDEXED ON MAP