Survey of Lot
for F. N. Johnson.
Apr. 11, 1906.

Bellefontaine
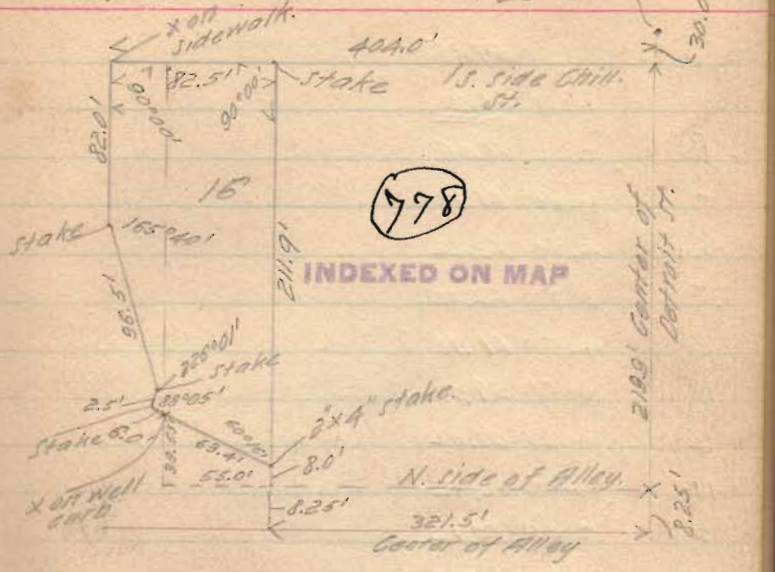
Mon. at int. Chillicothe + Detroit.