measured on Park 501.8
43.5
545.3
544.95
.45 decrease on park by deed

501.8
501.35
0.3 long by city measurement

51
51
48.75
48.75
50
52
60
124.85
30
5163.5
28.6
541.85
58.5
486.35

decrease = 1.0 to Hundred

110° 2'

160.75 +.015 = 150.90 N. side of lot
199.5 +.02 = 199.7 S. " "

Oct. 29 1921
W.A. Montgomery
Avery Hains

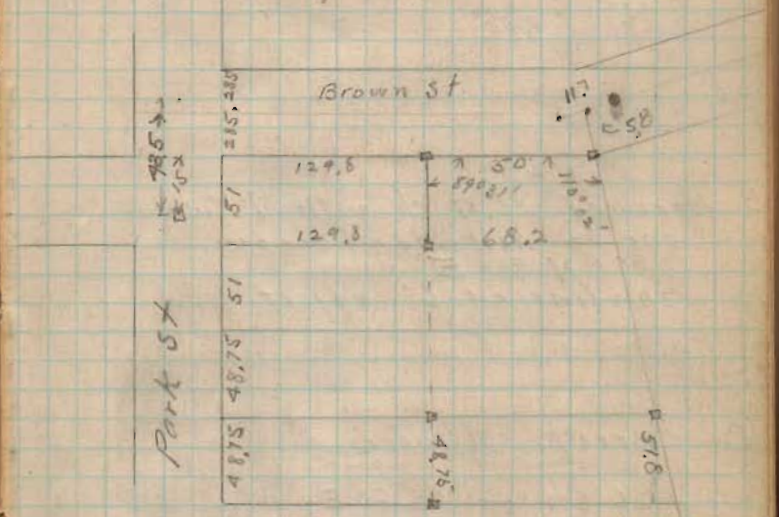

from Brown
" "

1071

INDEXED ON MAP