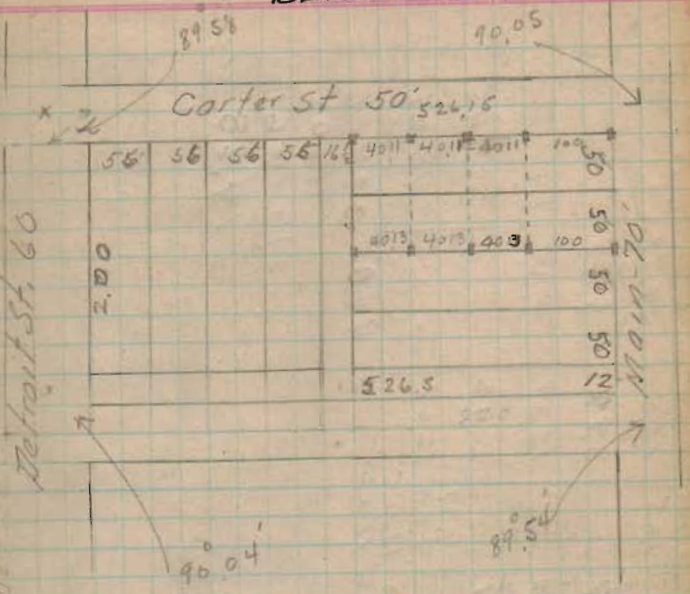

	Plat.		
Meas Carter	525.5	526.15	+.66
Alley	525.5	526.5	+1.00

(1087)

INDEXED ON MAP