CLAIR A. INSKEEP
Civil Engineer
BELLEFONTAINE, OHIO.

(1414) IP

DESKED ON MAP

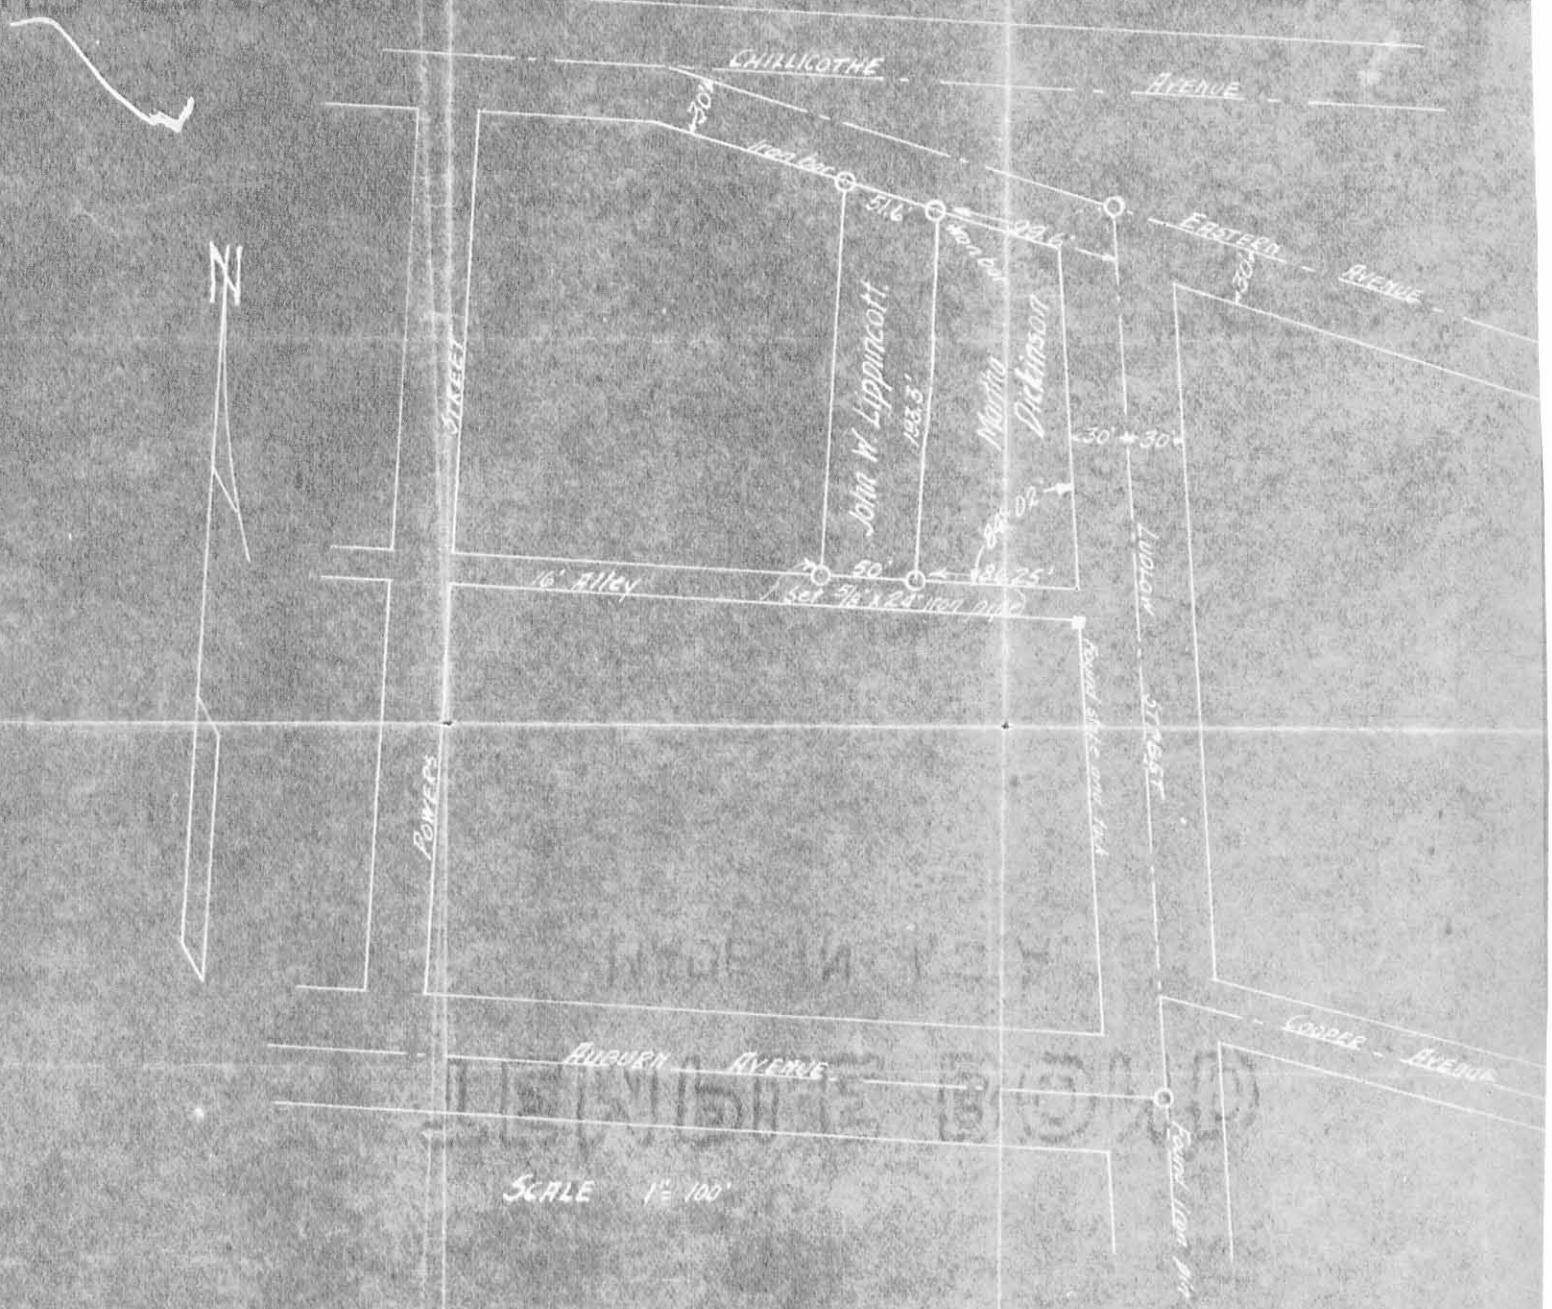

Surveyed as shown for John W. Lippincott
Sept. 19, 1923.

Clair A. Inskeep
Civil Engineer