Survey for Frank Moots
on N. Mad River St.
Part of 35-4-14 and
Survey 4990

Measure 23' east of stone at + Mad River and Palmer west stone at + Mad River and Irving.

From point 23' east of ℄ of Mad River and on ℄ between curbs at Palmer east measure south 30 + 48.5 + 48.5 = 127' for S. line Irving Place add.

Measured east 7' at 90° and set stake.

Set 3' north of stone as shown on plat of Irving Place Add near S.W. corner lot 2464 with flag at stone on N line of alley and ℄ Park St as shown on same Add. Intersected line 23' east of ℄ of Mad River of his line falls 2.15' north of Stone in Moots' yard on Ludlow line

67.40

2) 113.3
56.65

84
10.3

CHI.
O.C. Richey
March 18, 1913.

℄ Mad River Street

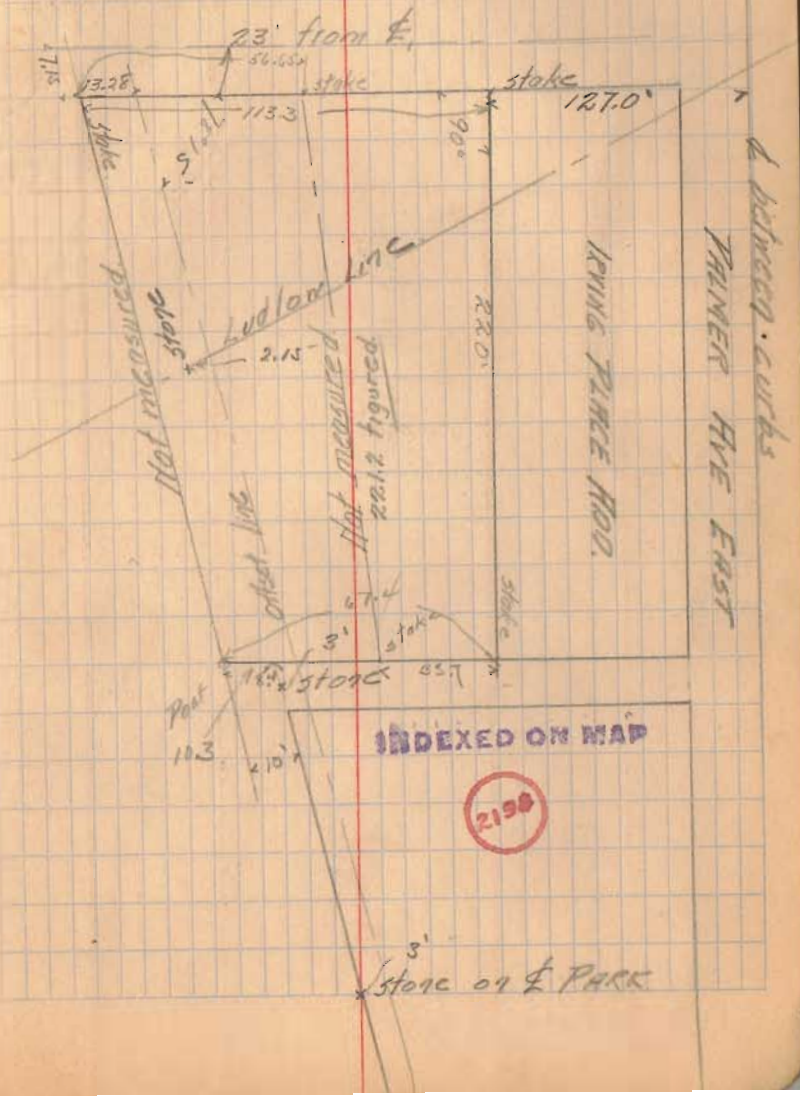

INDEXED ON MAP
2198