C. A. Inskeep
J. H. Inskeep
G. C. Inskeep

8/24/38
8/24/38

Survey of Lots 1770, 1771, 1772
in Belletontaine for
Peoples Federal Savings
& Loan Co. Sidney, Ohio
Judy & Arthur, Belletontaine
Agents.

Set stakes at points
marked □

All SE angles 90°-32'

54

℄ Cooke Street
Found nothing
at ℄ Cooke
Used angle off
℄ Jay - see
page

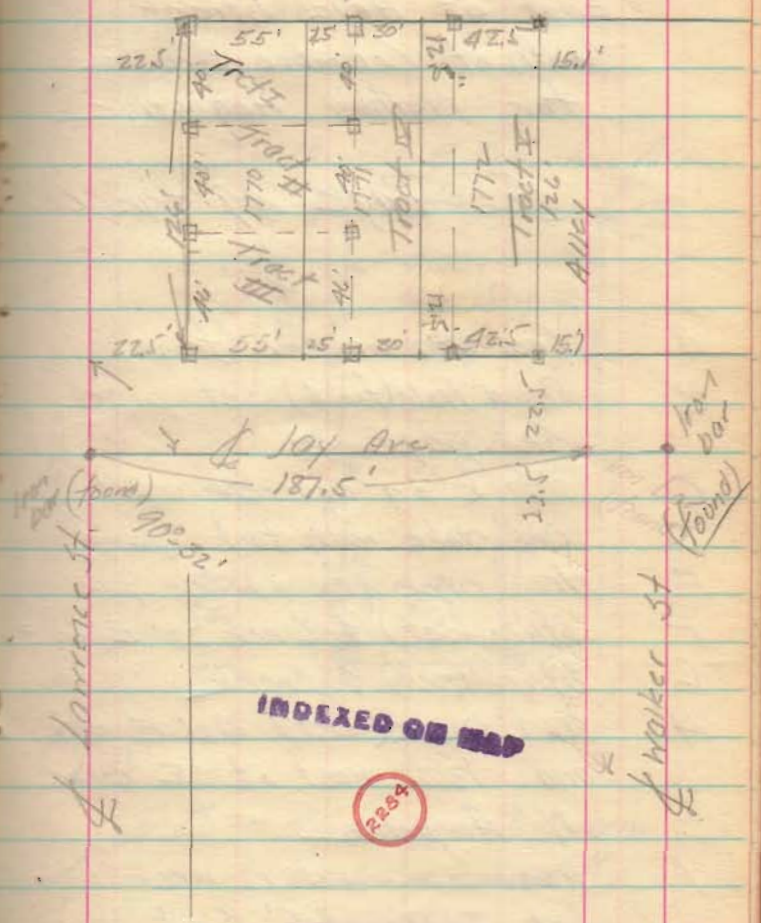

INDEXED ON MAP
2284