Survey for Harrisdliff
Bellefontaine, Ohio
Lake Twp.
V.M.S. 4478

See Field Book 512 p 30 Logan Co.
Engineer's Office

July 19, 1946
Hot!

J.H. Instreep
C.A. Miller
J.C. Wheeler

70

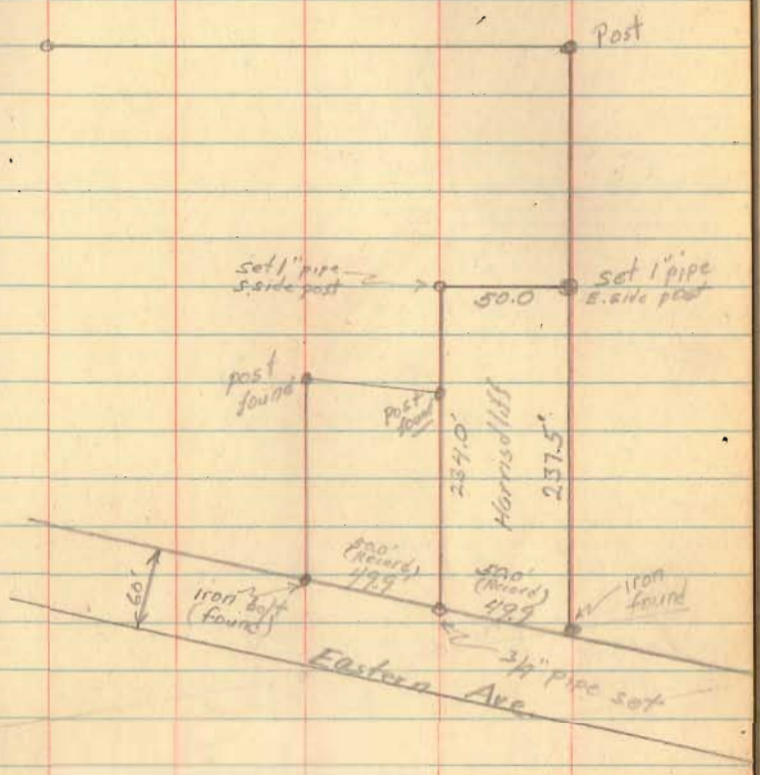

INDEXED ON MAP

2338