Sandusky St. Under

(See Book 506 for notes by Sykes).

INDEXED ON MAP

4434
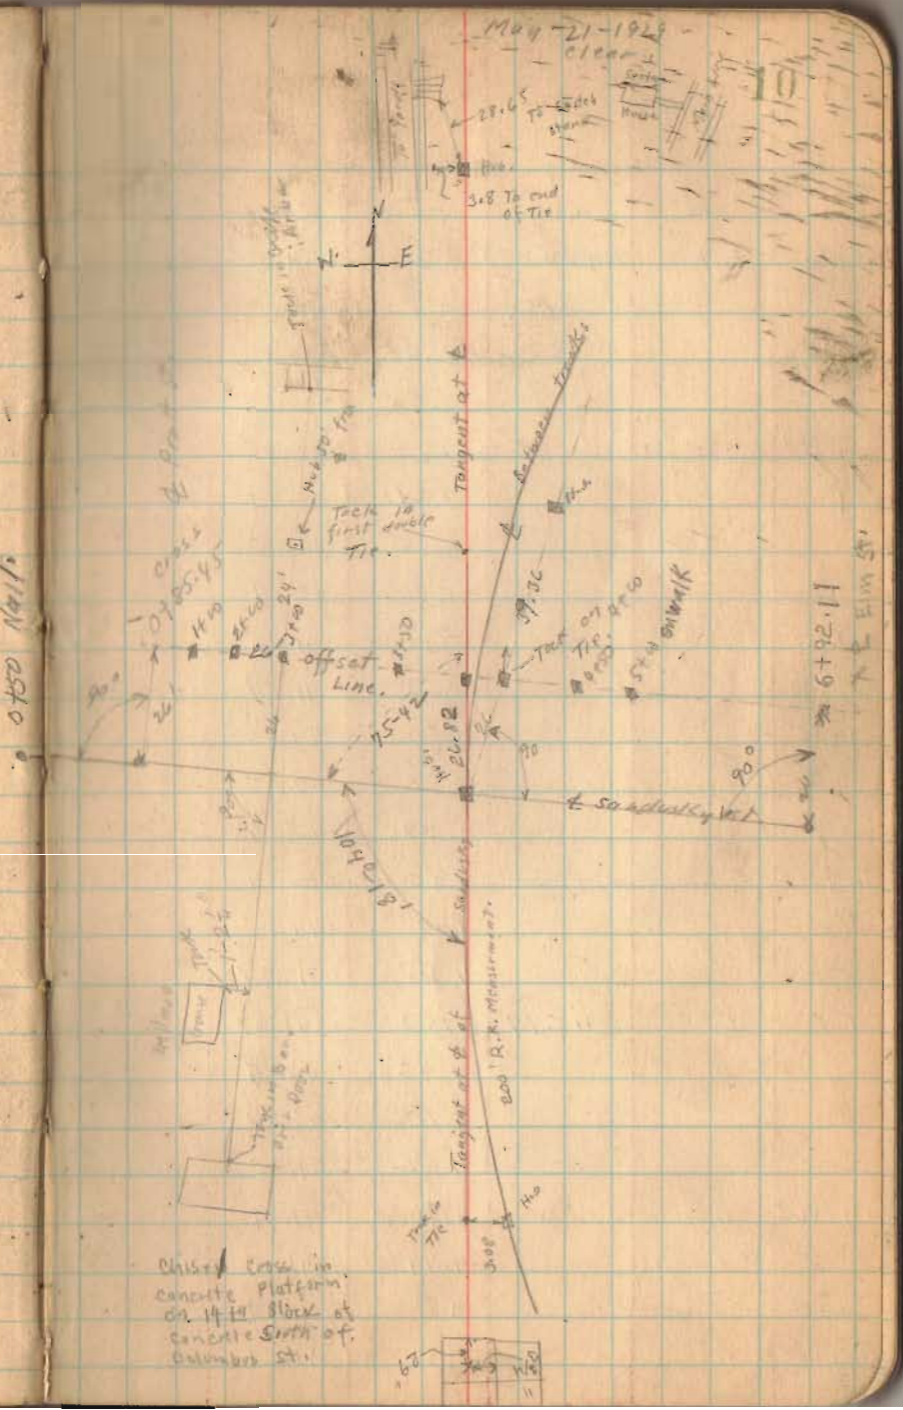
May 21-1929
clear