


# BELLEFONTAINE

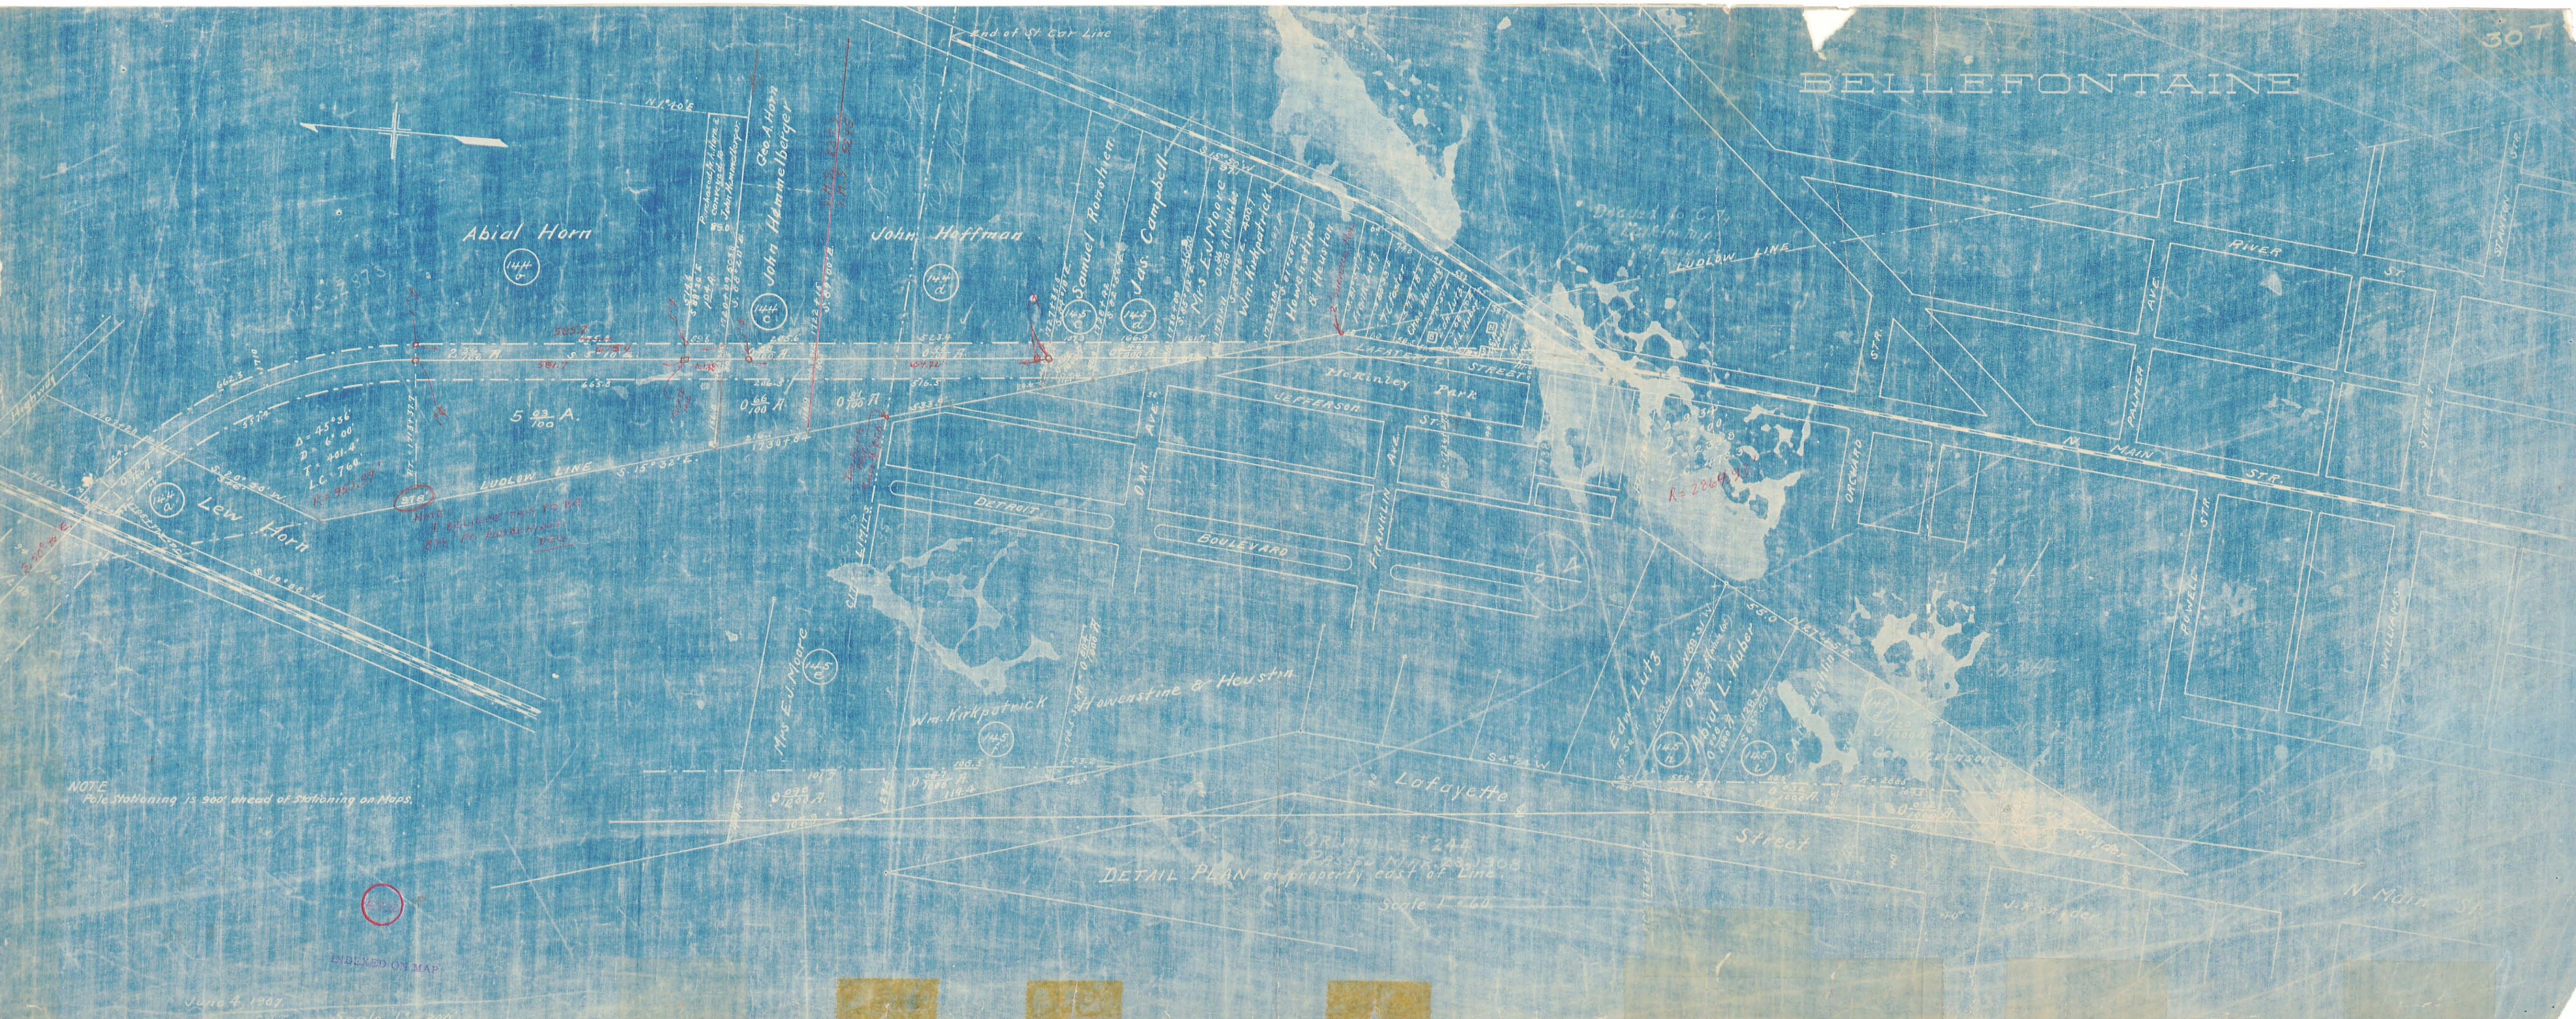

NOTE  
Pole Stationing is 500' ahead of Stationing on Maps.

ORIGNALE + 244  
Passed March 23, 1908  
DETAIL PLAN of property east of Line.  
Scale 1" = 60'

INDEXED ON MAP

June 4, 1907  
Scale 1" = 200'