APPROVED

SURVEY OF THE SOUTH 48 FEET OF LOTS 1121 AND 1122 OF I.S. GARDNERS ADDITION TO BELLEFONTAINE (PLAT CAB. A , SLIDE 17) AND ALSO A 1.5 FOOT STRIP SOUTH OF LOTS 1121 AND 1122 VACATED BY ORDINANCE # 94-94 , IN SECTION 35 , LAKE TOWNSHIP , TOWN 4 , RANGE 14 , LOGAN COUNTY , OHIO .

JULY 27 , 2020

SCALE 1" = 60'

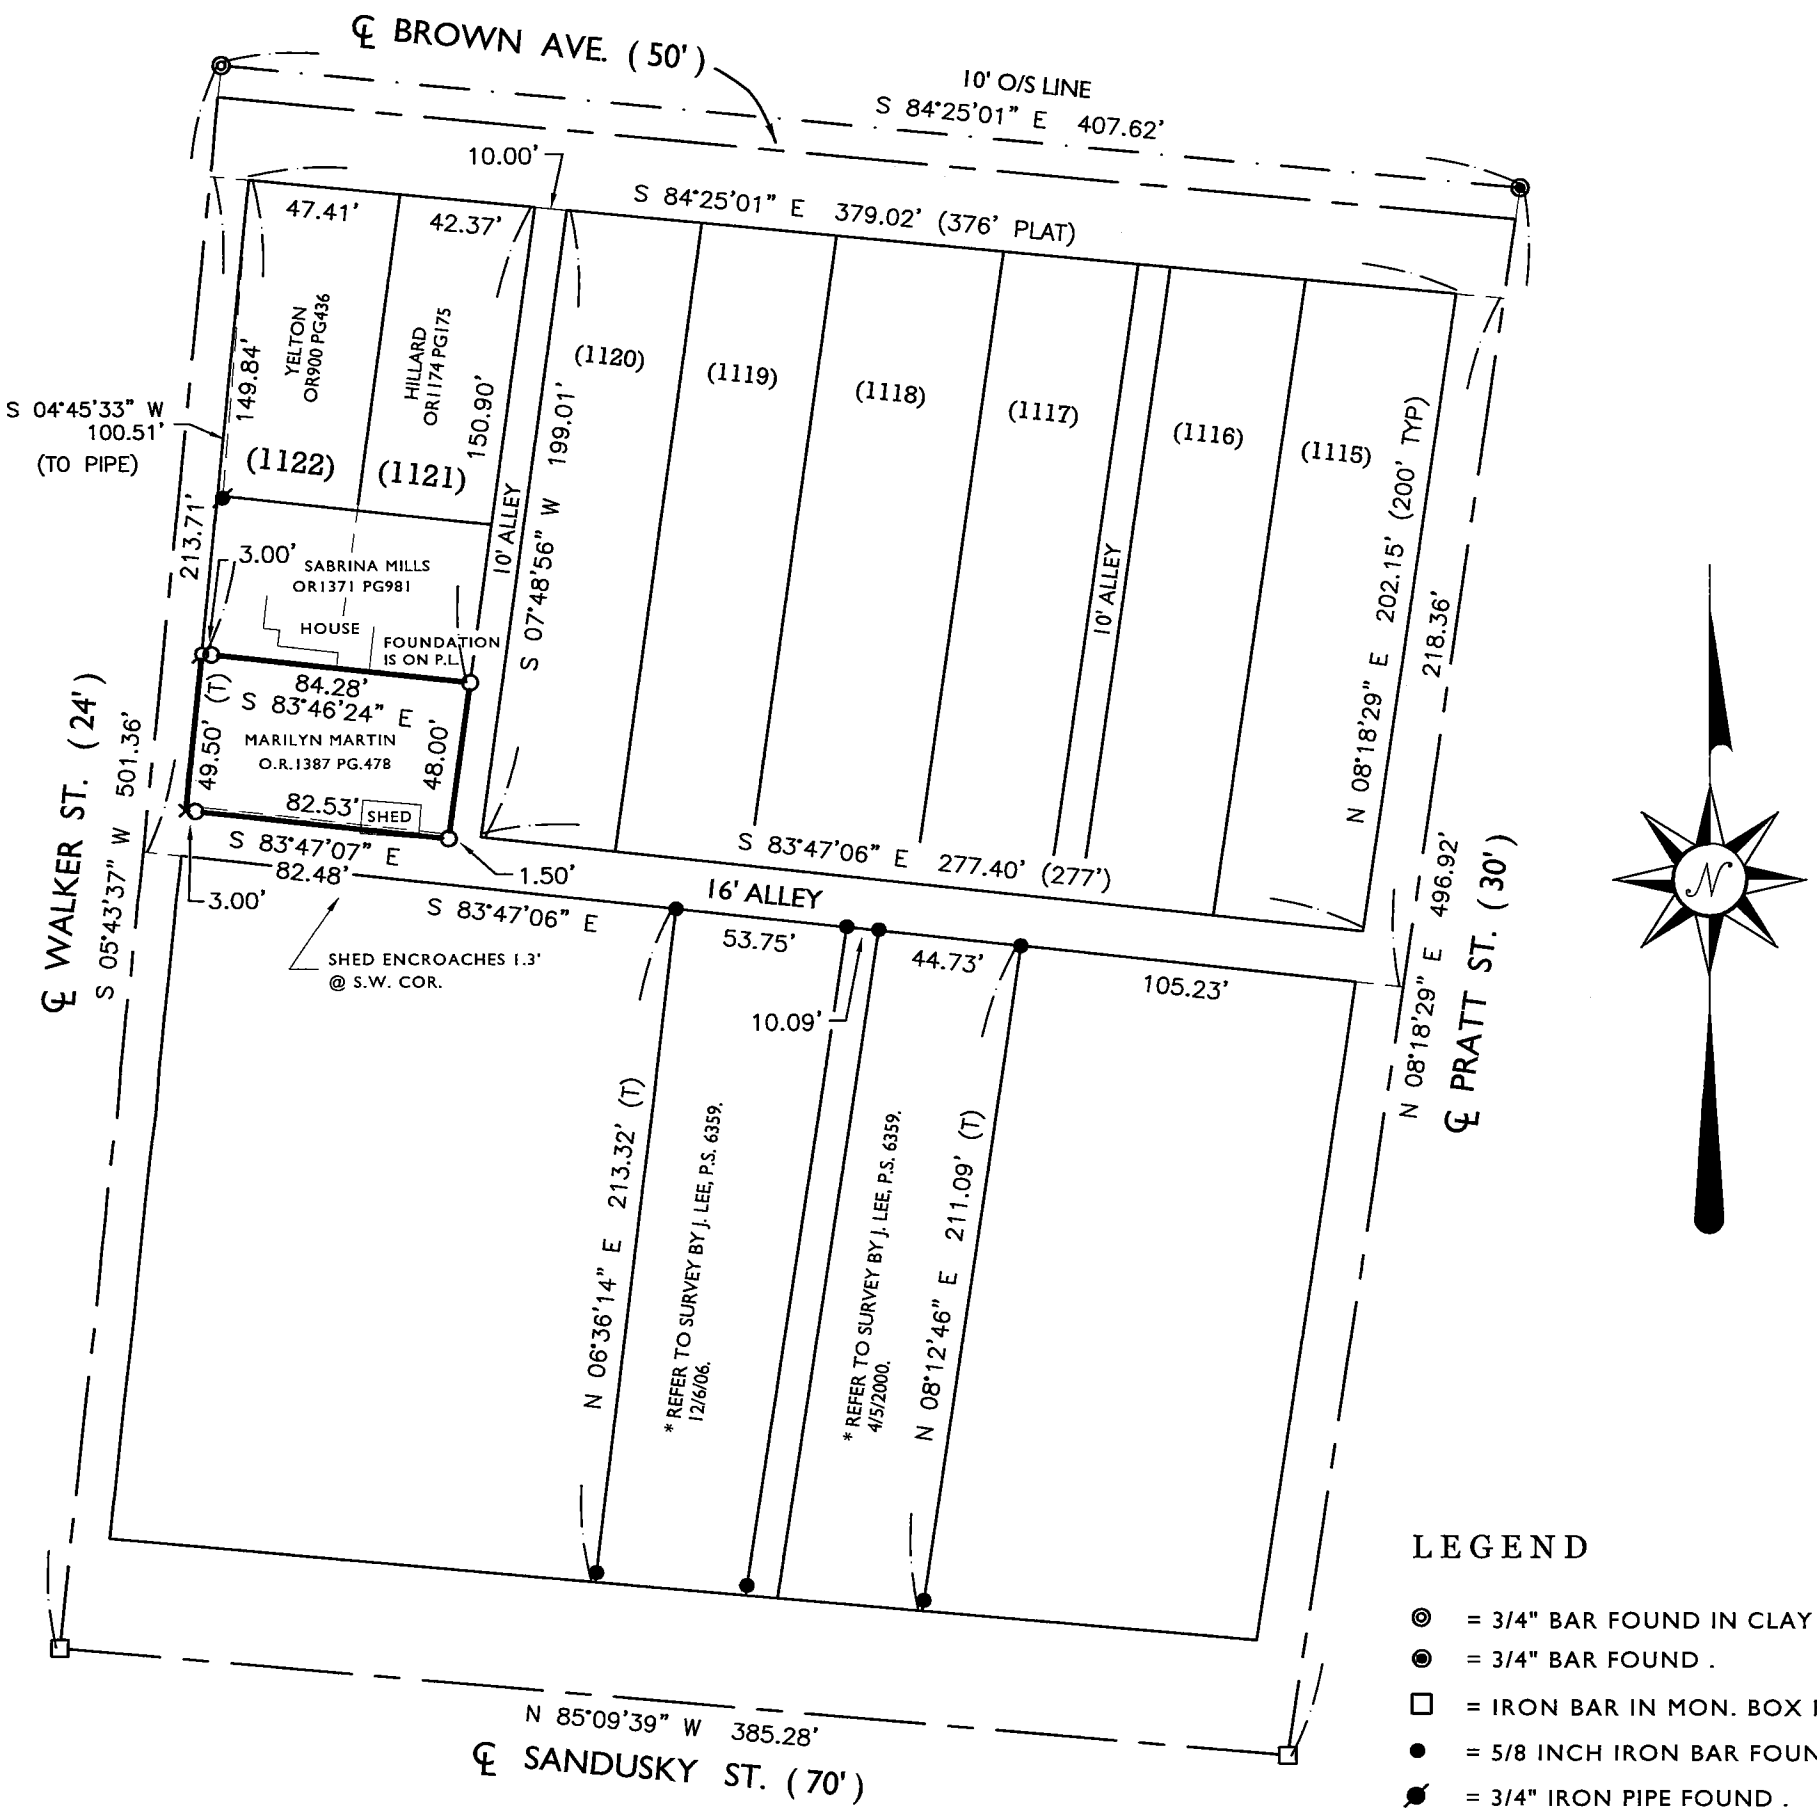

LEGEND

- ◎ = 3/4" BAR FOUND IN CLAY TILE .
- ◉ = 3/4" BAR FOUND .
- □ = IRON BAR IN MON. BOX FOUND.
- ● = 5/8 INCH IRON BAR FOUND .
- = 3/4" IRON PIPE FOUND .
- = MAG NAIL SET .
- O = 5/8 INCH IRON BAR SET .
- × = DRILL HOLE SET .

THIS PLAT REPRESENTS AN ACTUAL FIELD SURVEY PERFORMED UNDER MY SUPERVISION, AS DATED HEREIN.

James W. Geeslin

ATTEST: JAMES W. GEESLIN
PROFESSIONAL SURVEYOR 7764

INDEXED ON MAP
8961

NOTE: THE BEARINGS CONTAINED HEREIN ARE BASED ON GPS OBSERVATIONS USING O.D.O.T. CORS NETWORK STATIONS, CONVERTED TO THE OHIO STATE PLANE SOUTH ZONE, HORIZONTAL DATUM NAD83 (2011).

GEESLIN SURVEYING

525 S . SECOND ST.
COLDWATER , OHIO 45828

Phone : (419) 678 - 7233
Email : geeslinsurveying@gmail.com

STATE OF OHIO
JAMES W. GEESLIN 7764
REGISTERED PROFESSIONAL SURVEYOR

PERMANENT PARCEL No. _____ - _____ - _____ - _____ - _____ - _____

Part of : _____ Sec. ____ T. ____ R. ____ _____ Township

Grantor : _____ Area Retained _____ Acres

Grantee : _____ Area Retained _____ Acres

Deed Reference : _____

APPROVALS :
AGENCY : _____ _____ _____
DATE : Board of Health | Township Zoning Officer | Mercer County Engineer