April 8th 1924
Friday

Wright
Smoker
Mr. J.E. Smith
Smith boy.

Survey for J.E. Smith. (Sec. 18 T. 7 Range 8 Bloomfield Twp.)

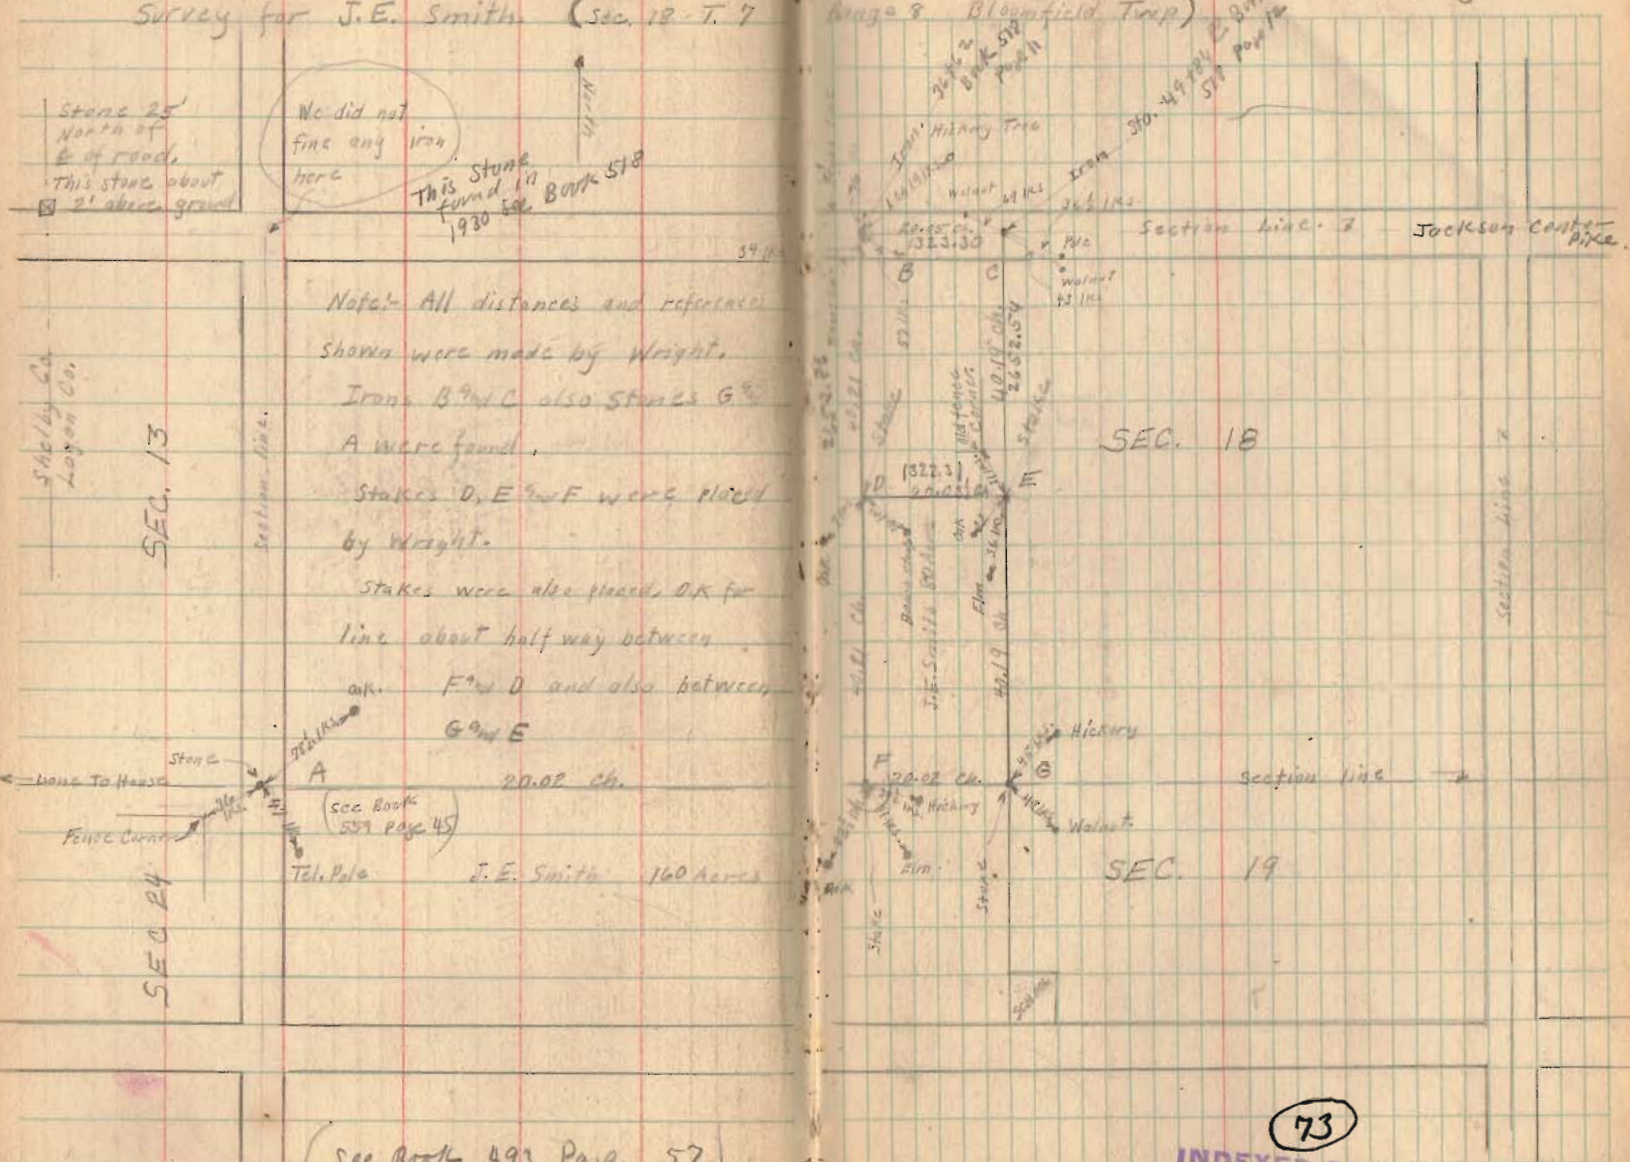

(See Book 493 Page 57 for Jenkens Survey)

(73)

INDEXED ON MAP