Received 8-13-99 OK JCH

MAP ROOM

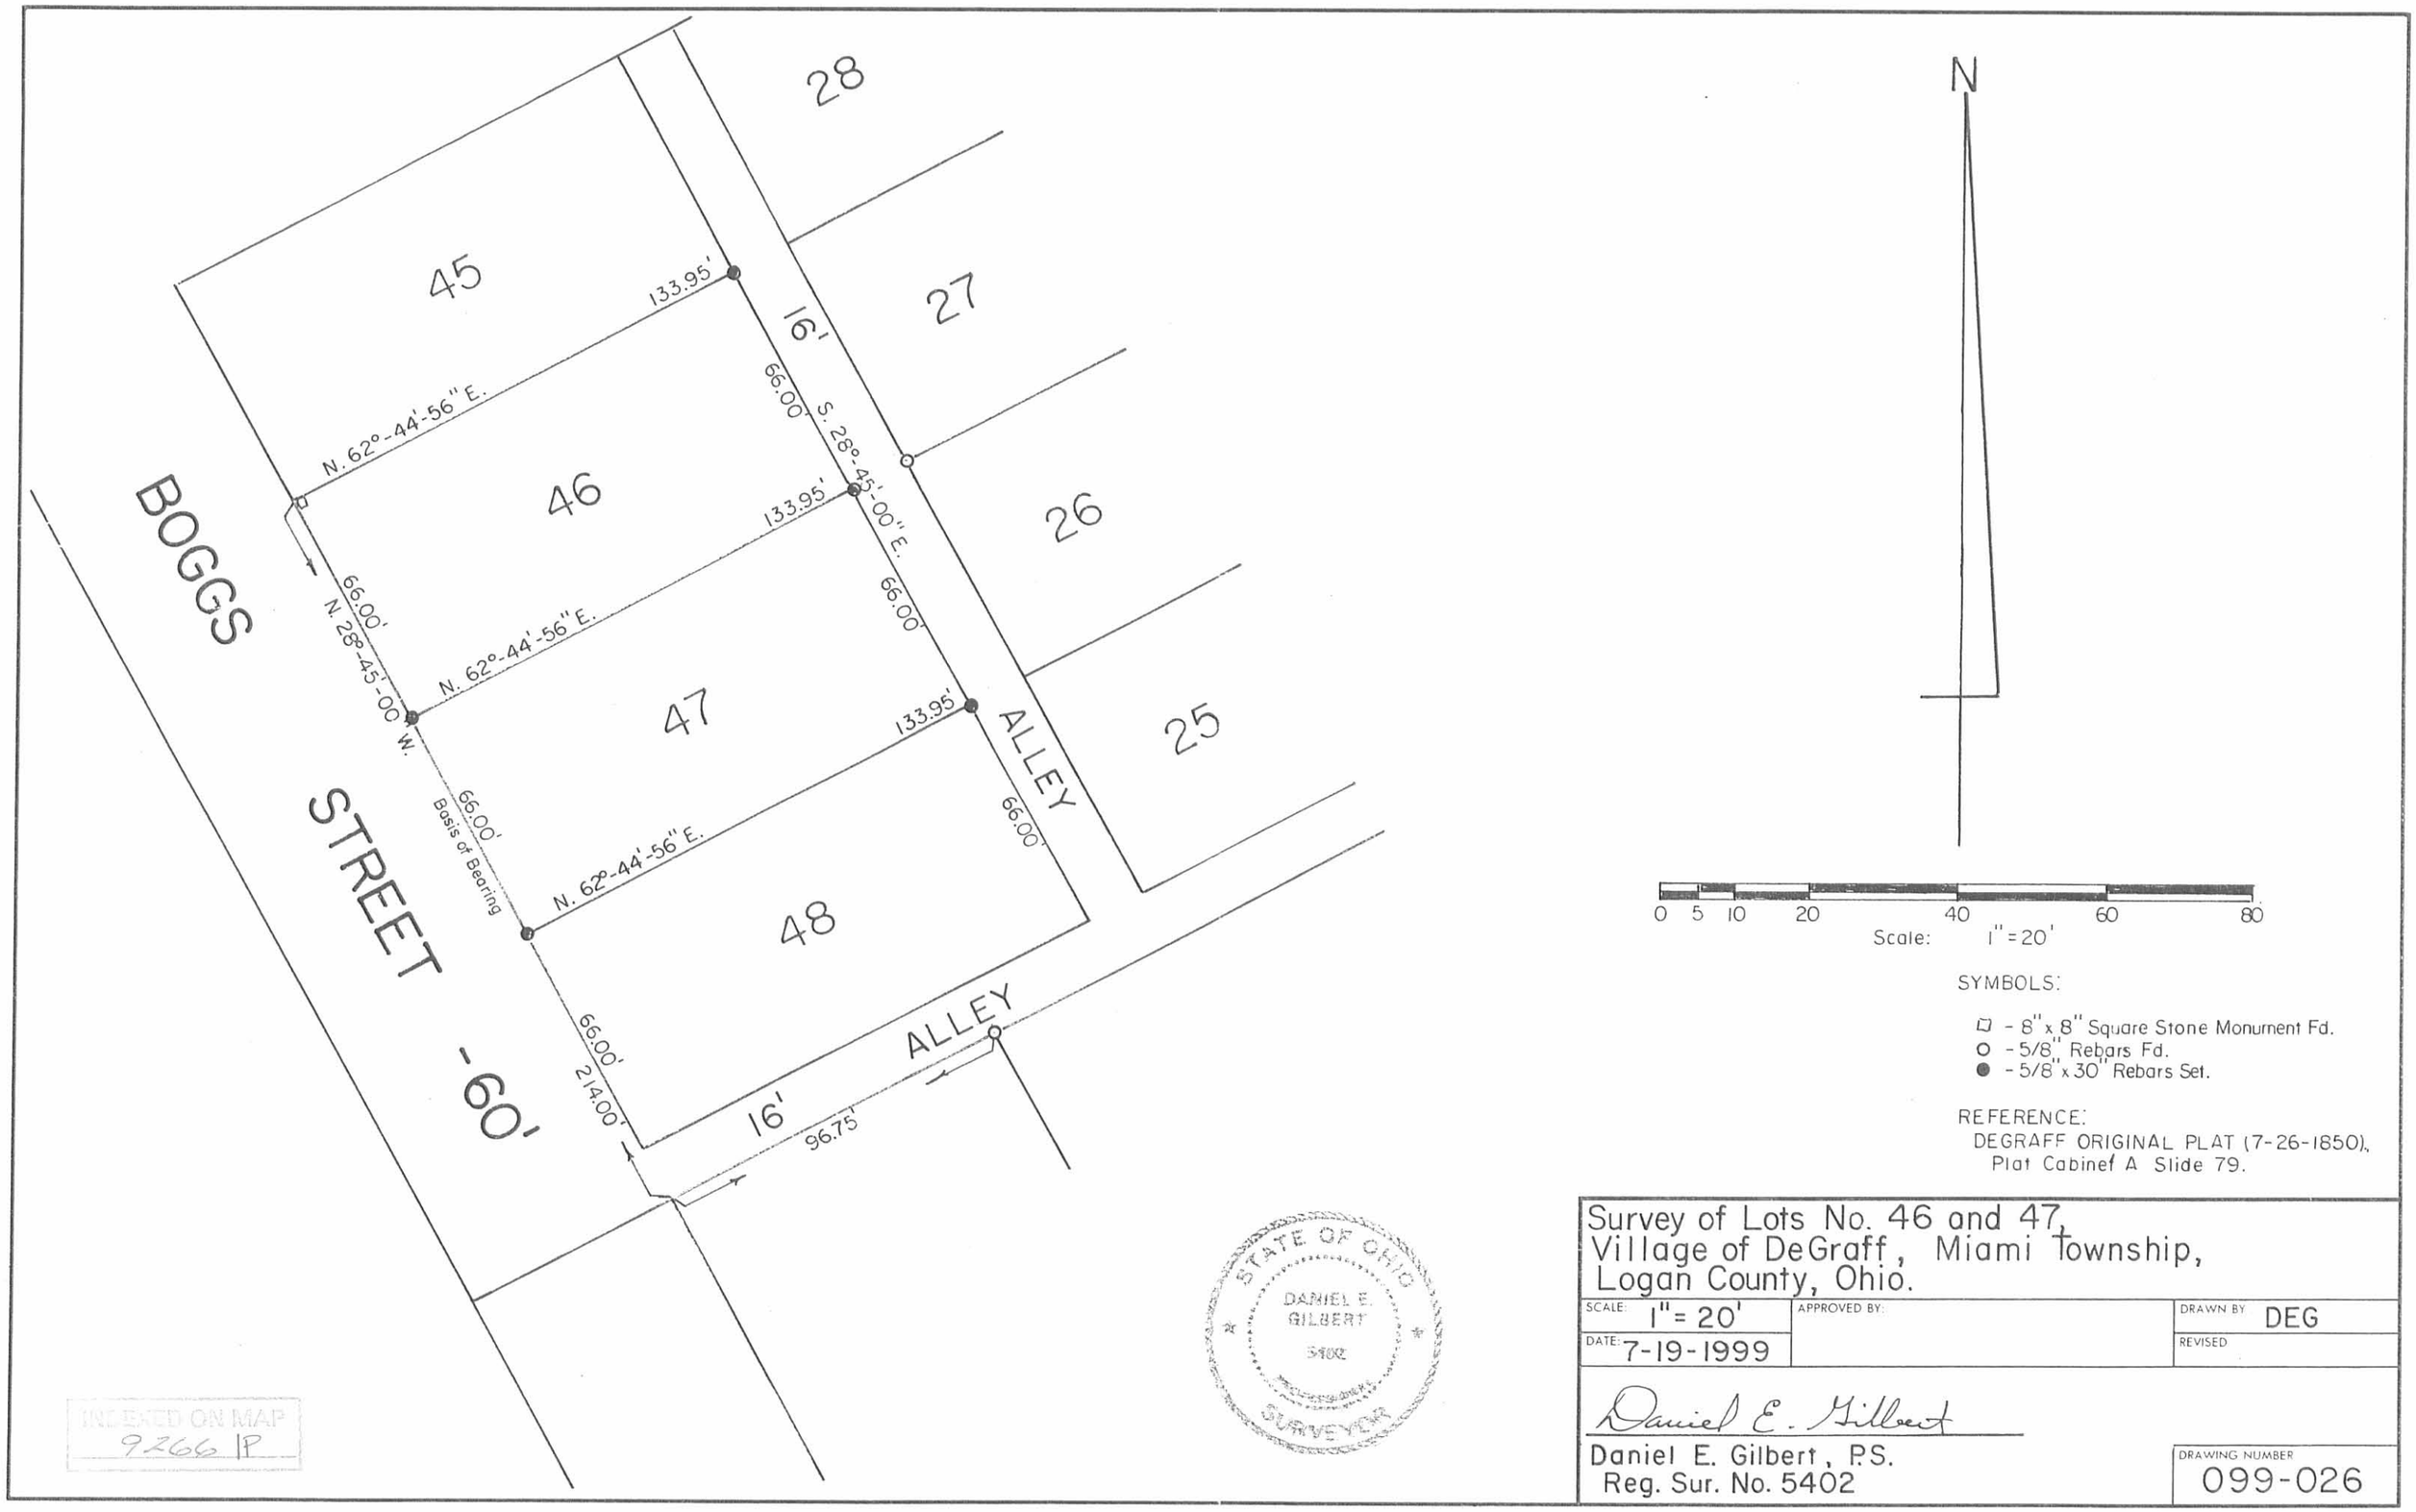

Survey of Lots No. 46 and 47,
Village of DeGraff, Miami Township,
Logan County, Ohio.

SCALE: 1" = 20'	APPROVED BY:	DRAWN BY: DEG
DATE: 7-19-1999		REVISED

Daniel E. Gilbert

Daniel E. Gilbert, P.S.
Reg. Sur. No. 5402

DRAWING NUMBER
099-026