Paul H. Strayer Survey. April 1914
Part S E 1/4 Sec 3. Town 3. Range 14

STATION.	ALIGNMENT.	DEFLECTION.	REMARKS

(1) Start at iron pin in public road S W < S E 1/4 Sec.
Thence with road and Sec line S 85 3/4 E
at 1336 1/2 line of old fence row on N.
" 2647 S E < Sec 3.
" 13331 set iron pin S E < 15 a & S W < John Horn
Note this < on Sec line & 3' north of Random line
and Okcs & Dist = S 85 E 1331.
(2) Start on S line Sec at 1300 of (1)
Thence N 5 E. Random line
at 1320 set stake for distance N line 15 a
" 2660 fence N line 1/4 Sec & N line Strayer 23 1/2 W of cor. wire fence
" 1320 pass wire fence. east 20 1/2 feet.
" 1350 pass 20 1/4 W. of cor post N. W. cor John Horn
{ Measure N line D. H. Strayer land being W 1/2 S E 1/4 Sec 3 = 1331 }
at N E < 15 a set stake at W. side wire fence.
" " Wit Elm 15" di S 4 W 38 1/2
" " Corner post N W < John Horn N 4 1/2 E 30
(3) Start at 1331 iron pin in Sec line of (1)
Thence with Sec line N 85 3/4 W 495 to S W < 15 a. and
S E < D. H. Strayers remaining land near corner

4 Start at 495 of (3) Thence on W line 15 a N 4 E.
at 1320 set stake in prairie N W < 15 a.

The corner at a is 1 1/2 feet N. of the iron pin set on Feb 13th 1914 (see page 14 this book) for S E cor B. F. Snyder.

Plat Paul H. Strayer Sur.
S. E. 1/4 Sec. 3. Town 3. Range 14

Stationers, St. Louis, Mo.

TOPOGRAPHY.

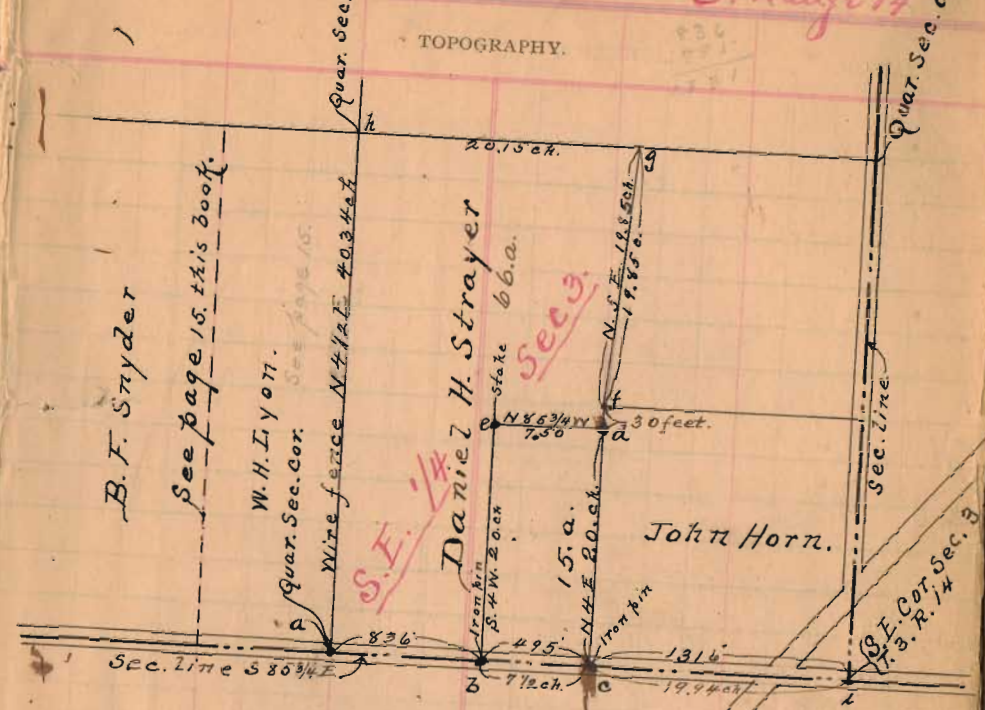

Field Notes.

a = iron pin, 18" S. of Sec. line. See page 15. this book.
b = " " on Sec. line. S. W. cor. 15 a.
c = " " " " " S. E. " " "
d = stake. N. E. cor. 15 a. on W. side wire fence.
" = Wit. Elm 15" di. S. 4 W. 38 1/2 feet.
f = Wood cor. post N. W. cor. John Horn.
e = Stake in black prairie. N. W. cor. 15 a.
g = Wood cor. post. in wire fence.
h = " " " " " "
= S. E. cor. Sec. 3. Stone. not found. N. of cent. road.

Distances		
a to b.	S 85 3/4 E.	836 = 12.66 c.
b " c	"	7.50 ch.
c " i	"	19.94 "
c " d	N. 4 E.	20. c.
d " f	"	30 feet.
d " e	N 85 3/4 W	7.50 ch.
e " b	S 4 W.	20. ch.
f " g	N 5 E.	19.85 "

The corner c fixed by agreement between John Horn and Dan. H. Strayer and is 7 1/2 feet east of the S. W. cor. of the E. 1/2 of S. E 1/4 Sec. 3. Town 3. Range 14.

INDEXED ON M