Surrey Al Fulton

A = fence post drove Iron pin
B = " "
C = " "
D = Cross on curb
E = " " "
F = Iron pin
G = Iron pin
H = Iron pin
K = fence post - former Cor to Coulter + Richards
L = " " -
R = " " Corner to Jones + Bailey
N = " " Corner to Myres Jones

49.5
48.3
97.8

115.5
97.8
17.7
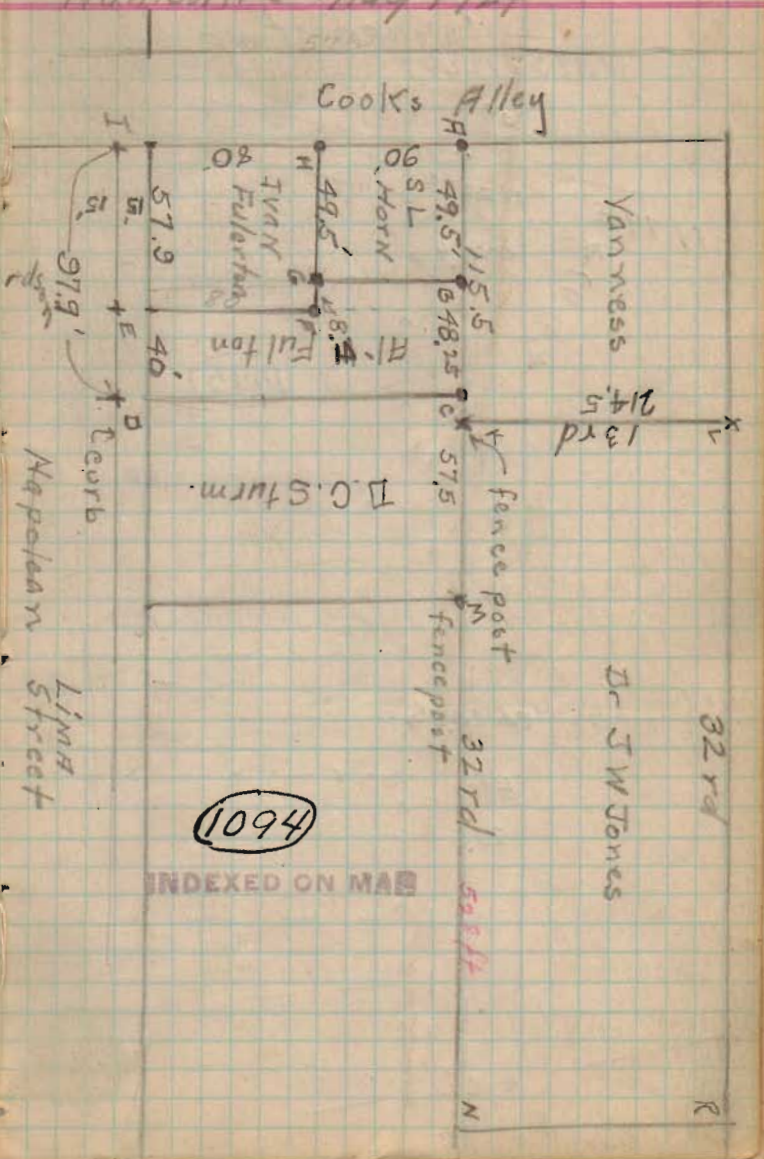
Huntsville Aug 1924