FB 699

Wishart St.
Huntsville, O.

D. Dodson
T. Richardson
F. Sweeney
C. Gebby

July 3, 1952

25

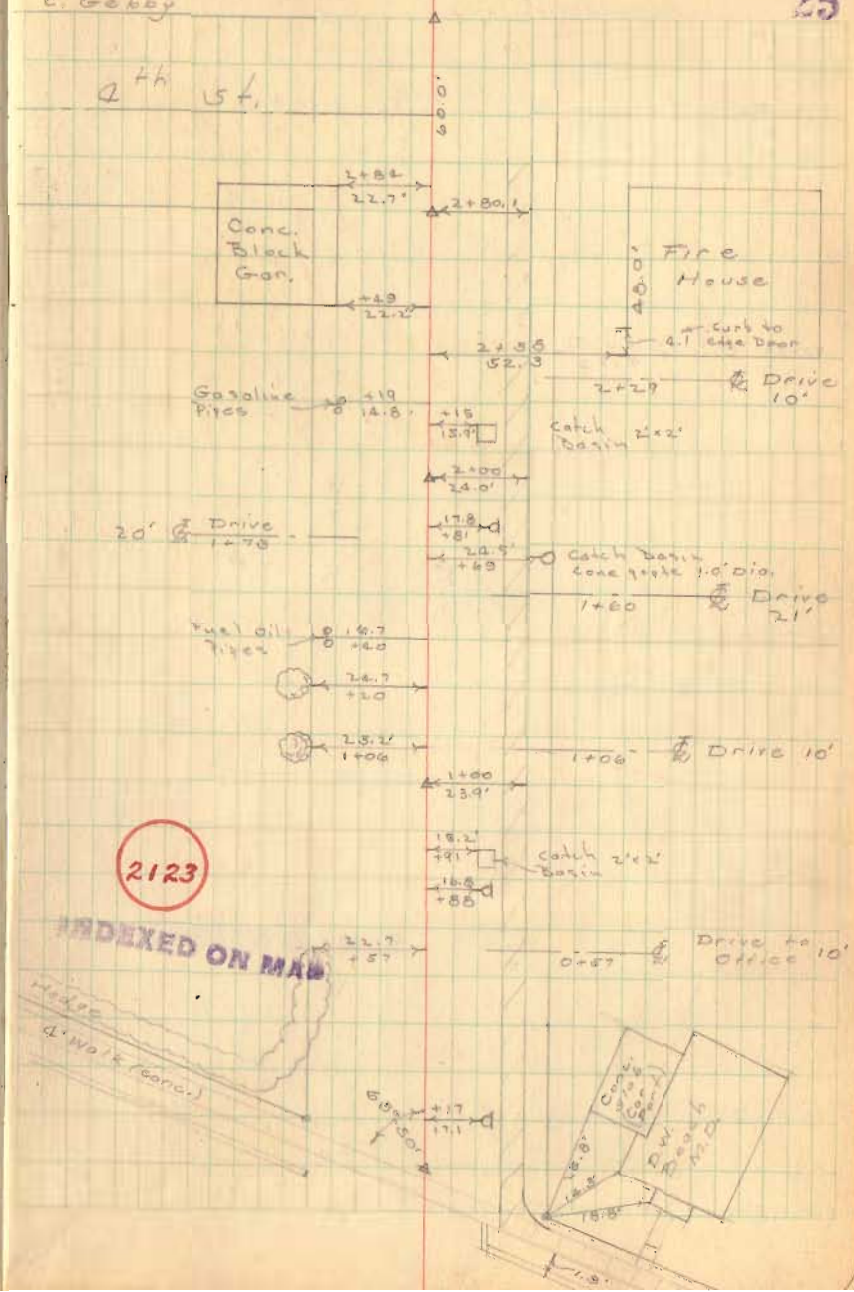

2123
INDEXED ON MAP