

MAP ROOM RECEIVED 6-27-94 SMY (OP)

LIMA STREET - 60'

N. 7°-20'-00" W.
Basis of Bearing

S. R. No. 117

N. 7°-20'-00" W.
44.90'

N. 7°-20'-00" W.
59.00'

138.00'

64.00'

R-500'
T-500'

R-1000'
T-1000'

N. 82°-30'-00" E.

S. 82°-30'-00" W.

128.00'

138.00'

138.00'

133.00'

Alley (Not Open)

138.00'

S. 7°-20'-00" E.

69.00'

138.00'

69.00'


151

152

153

CHRISTINE DRIVE - 70'

N

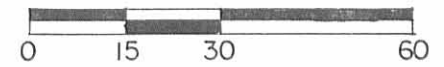


Scale: 1" = 30'

Reference:
Monteith Allotment - Huntsville.
Plat Cab. A - Slide No. 373.

Symbols:
○ - 5/8" Rebar Fd.
● - 5/8" x 30 Rebars Set (Capped).

Resurvey of Lots No. 151 - 152, Monteith Allotment, Village of Huntsville, McArthur Township, Logan County, Ohio.

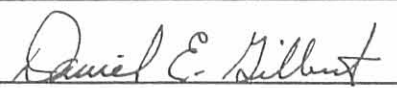SCALE: 1" = 30'	APPROVED BY:	DRAWN BY DEG
DATE: 6-17-1994		REVISED
 Daniel E. Gilbert, P.S. Reg. Sur. No. 5402		DRAWING NUMBER 094-024



INDEXED ON MAP
8922 IP

Concrete R/W Mon's Fd.

30'

30'