Surveyed for Crook
in Survey 3441 3439 Jefferson Tp

Jefferson Twp

C I.P Driven
D I.P Driven
E I.P Driven
F I.P Driven
G I.P Driven
H stone found.
I ½" iron pipe driven
J Fence post

(702)

INDEXED ON MAP

Rain.

Oct. 14, 1927

36

W A Montgomery
Ed Core
— Crook
— Reed
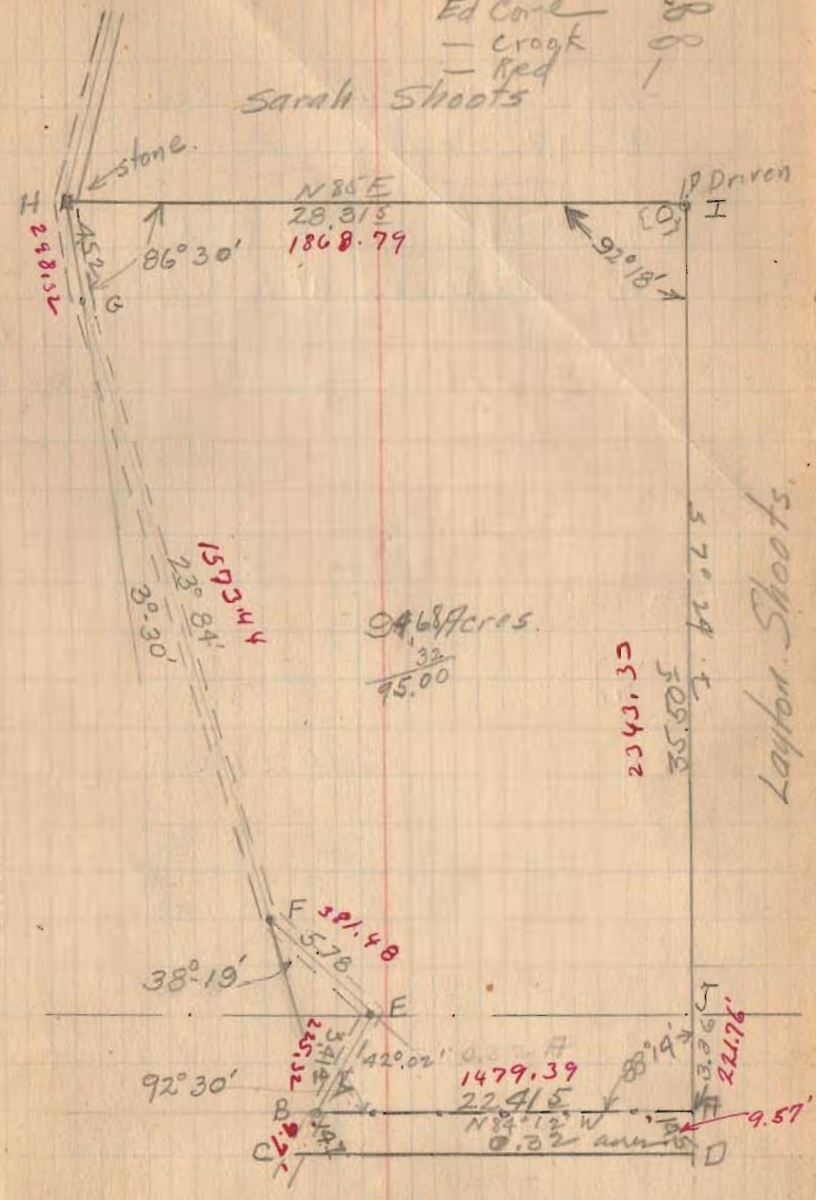
Sarah Shoots