Vanoca Survey (Lake Tn. 0)
(Buller To Vanoca) 10 Acres
See Survey (220) Book D page 65
survey By Dailey 1913

A - Iron found see Book D Page 65 Found 9/20/56
B Hub " " Found 9/20/56 D.E.D"
C Hub Placed. Found Hub & Iron 9/20/56 replaced Hub with 5/8" Iron D.E.D.
D Hub
E Hub. 1" pipe found 9/20/56 D.E.D.

Rood No 183

Figures in Red Taken from Book D Page 65
Set Rood Stakes 20' South of ℄ ABC
for Rood fence.

Set Stakes on line AE and CD.

(220)
INDEXED ON MAP

S.H. 235
Route 32

June-30-1937
F. Wright
G. Wilgus
W. R. Wright.
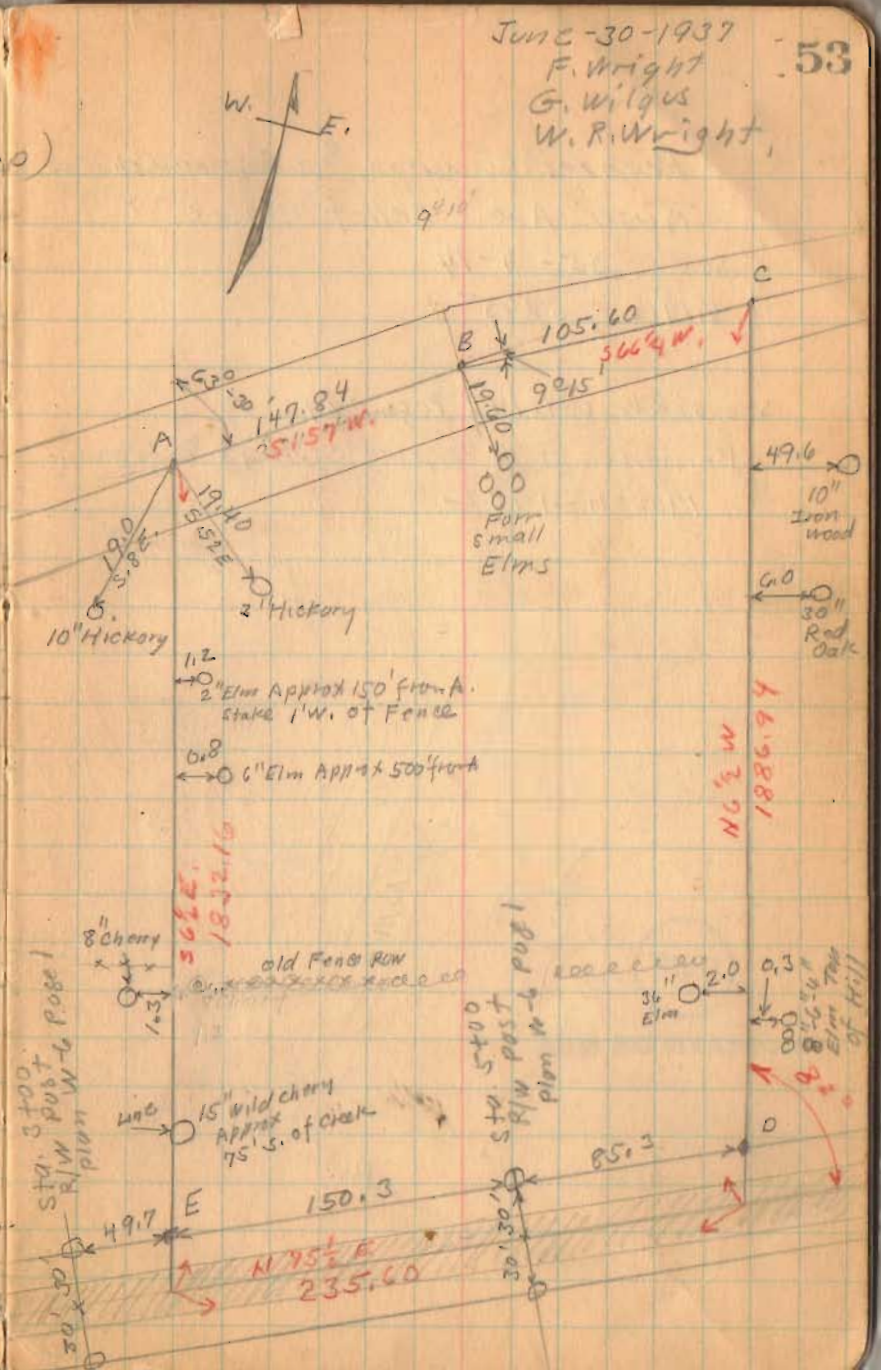
53