

Road. 181.

To road at T & O C RR

Sta 0 at N. side RR right  
of way Center Ludlow Pub.

Line 1 N.  $14\frac{3}{4}$  W. 505'

Line 2 S. 55 E. 365'

Line 3 N.  $85\frac{1}{2}$  W. 67'

Line 4 N. 55 W. 269'


// //

42

Out off. Lake Tup.

33' wide N of RR fence

Cse N. line S.  $55\frac{3}{4}$  E.

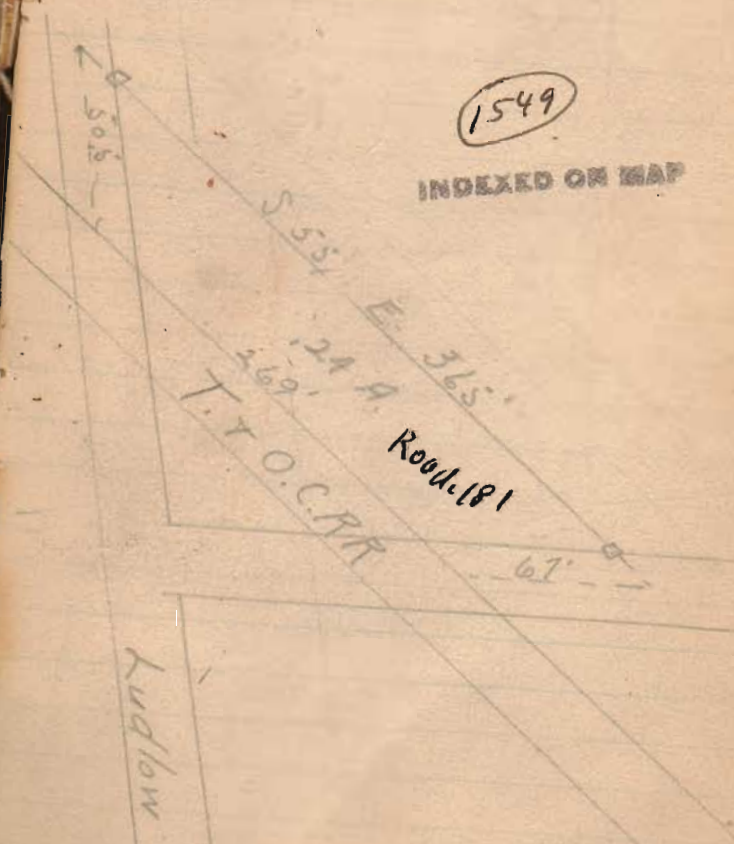

1549

INDEXED ON MAP

Ludlow

T. & O. C. RR  
Road. 181

S. 55 E. 365'

24 A. 365'

269'

67'

305'

505'