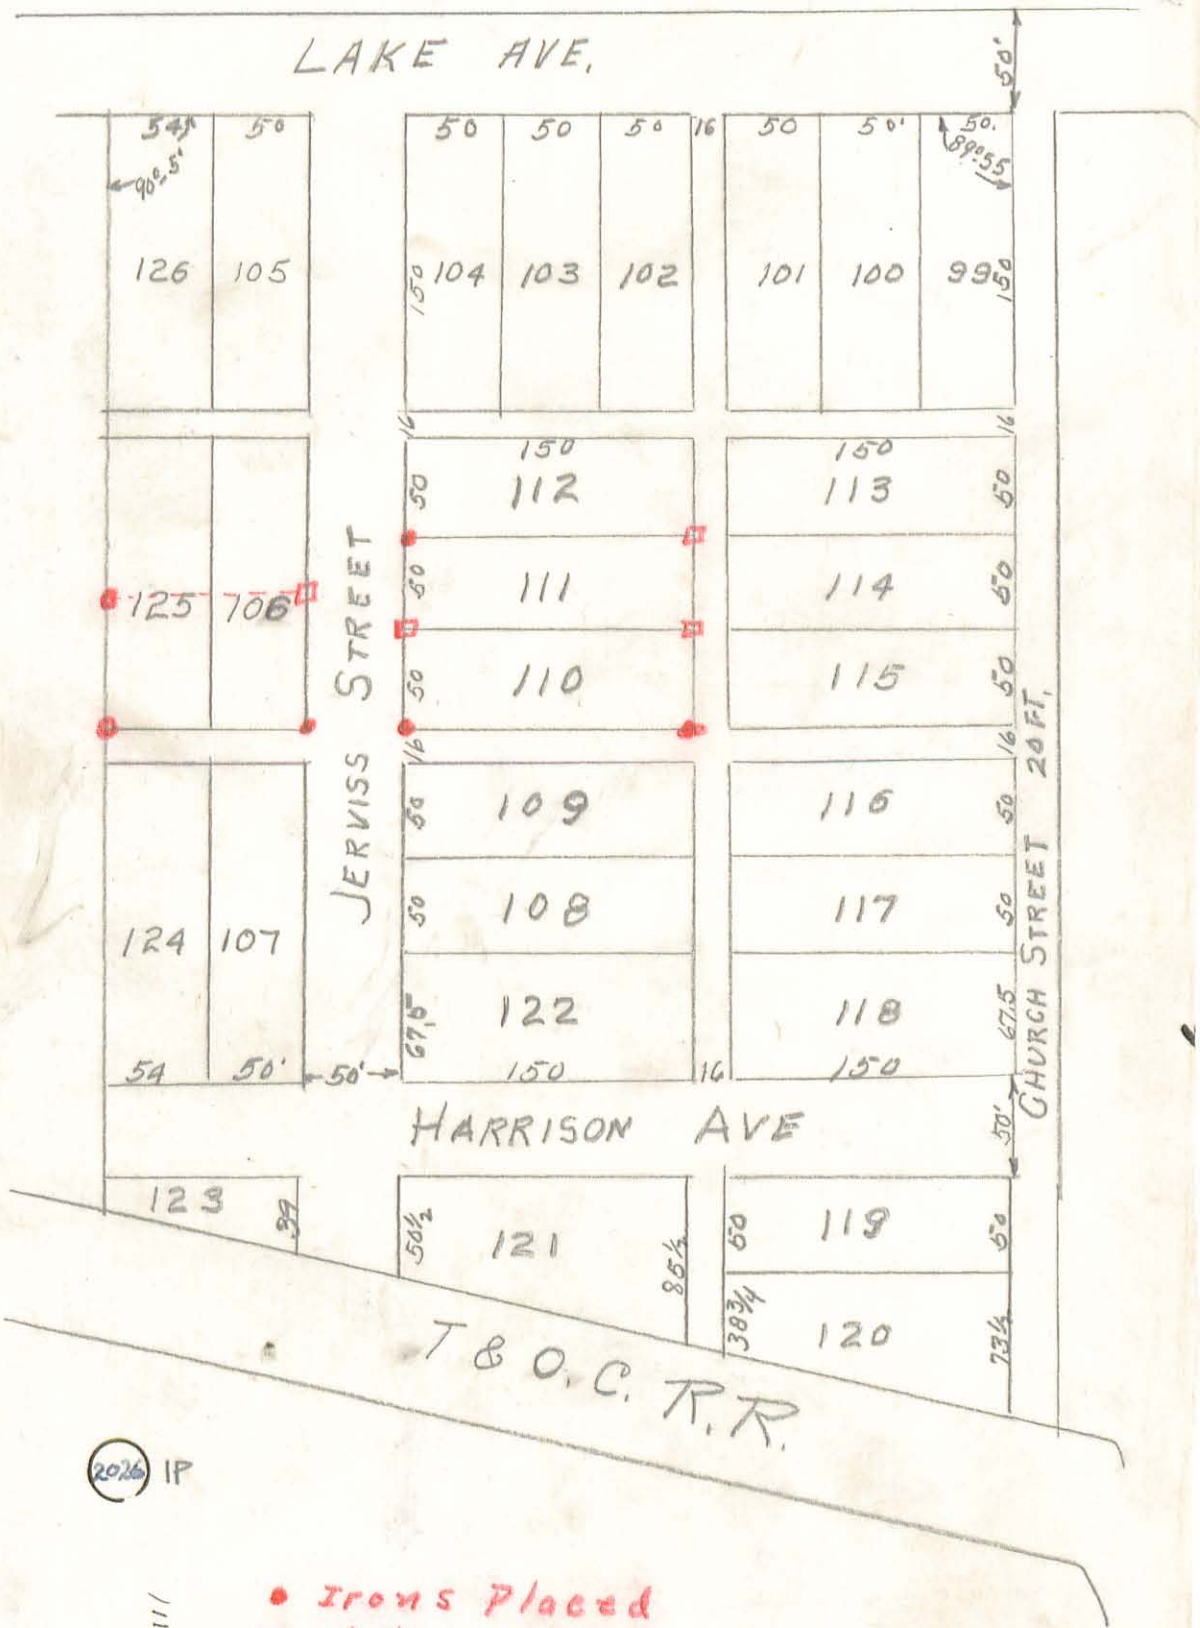JERVIS ADDITION
LAKEVIEW