D. W. Koch 17/ Survey June 20/12

Sect. 6 T. 3 R. 13 Miami Tp.

Lewis Startzman Flag
Robt Startzman Ch
"

Found stone at C. and L.
Large Anchor Post at M.
Ran Line "C M" Wit stone at L.

Chained N. from M. 19.36 chs. from H.C. Moores Survey 1892.

Found stone at E. "E" is 2.5 lks north and 2.4 lks East. "CE" = S. 43½ W 19.8 chs

1.65'
2.24

"K" = Anchor Post. Place of stake set by H.C. Moore 1892.
"E.N" = N. 86½ W 25.5 chs.

"D" = Stone
Produced "CD" = H. "CH" = S. 85° E 25.5 chs

Set Iron Bar at "H." Wit "70" Burr Oak N 18 W 27½ lks

"HN" = N. 4 E. 20.12 chs

7/2/12
Moved Line "H.N." 16' 5" East so as to make 60 Acres in tract.

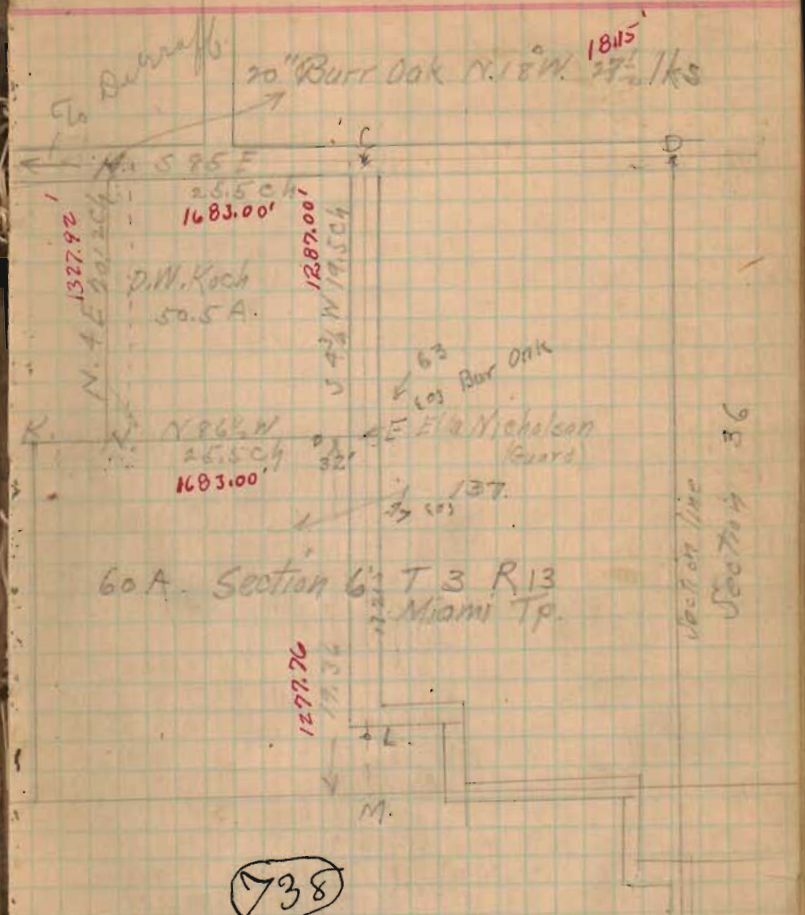

INDEXED ON MAP