4

Surveyed for ——
Heirs of Robert Smith

Pt. surveys 6516 and 4479

Monroe Township

Mch. 15 and 23. 1907

(155)

INDEXED ON MAP

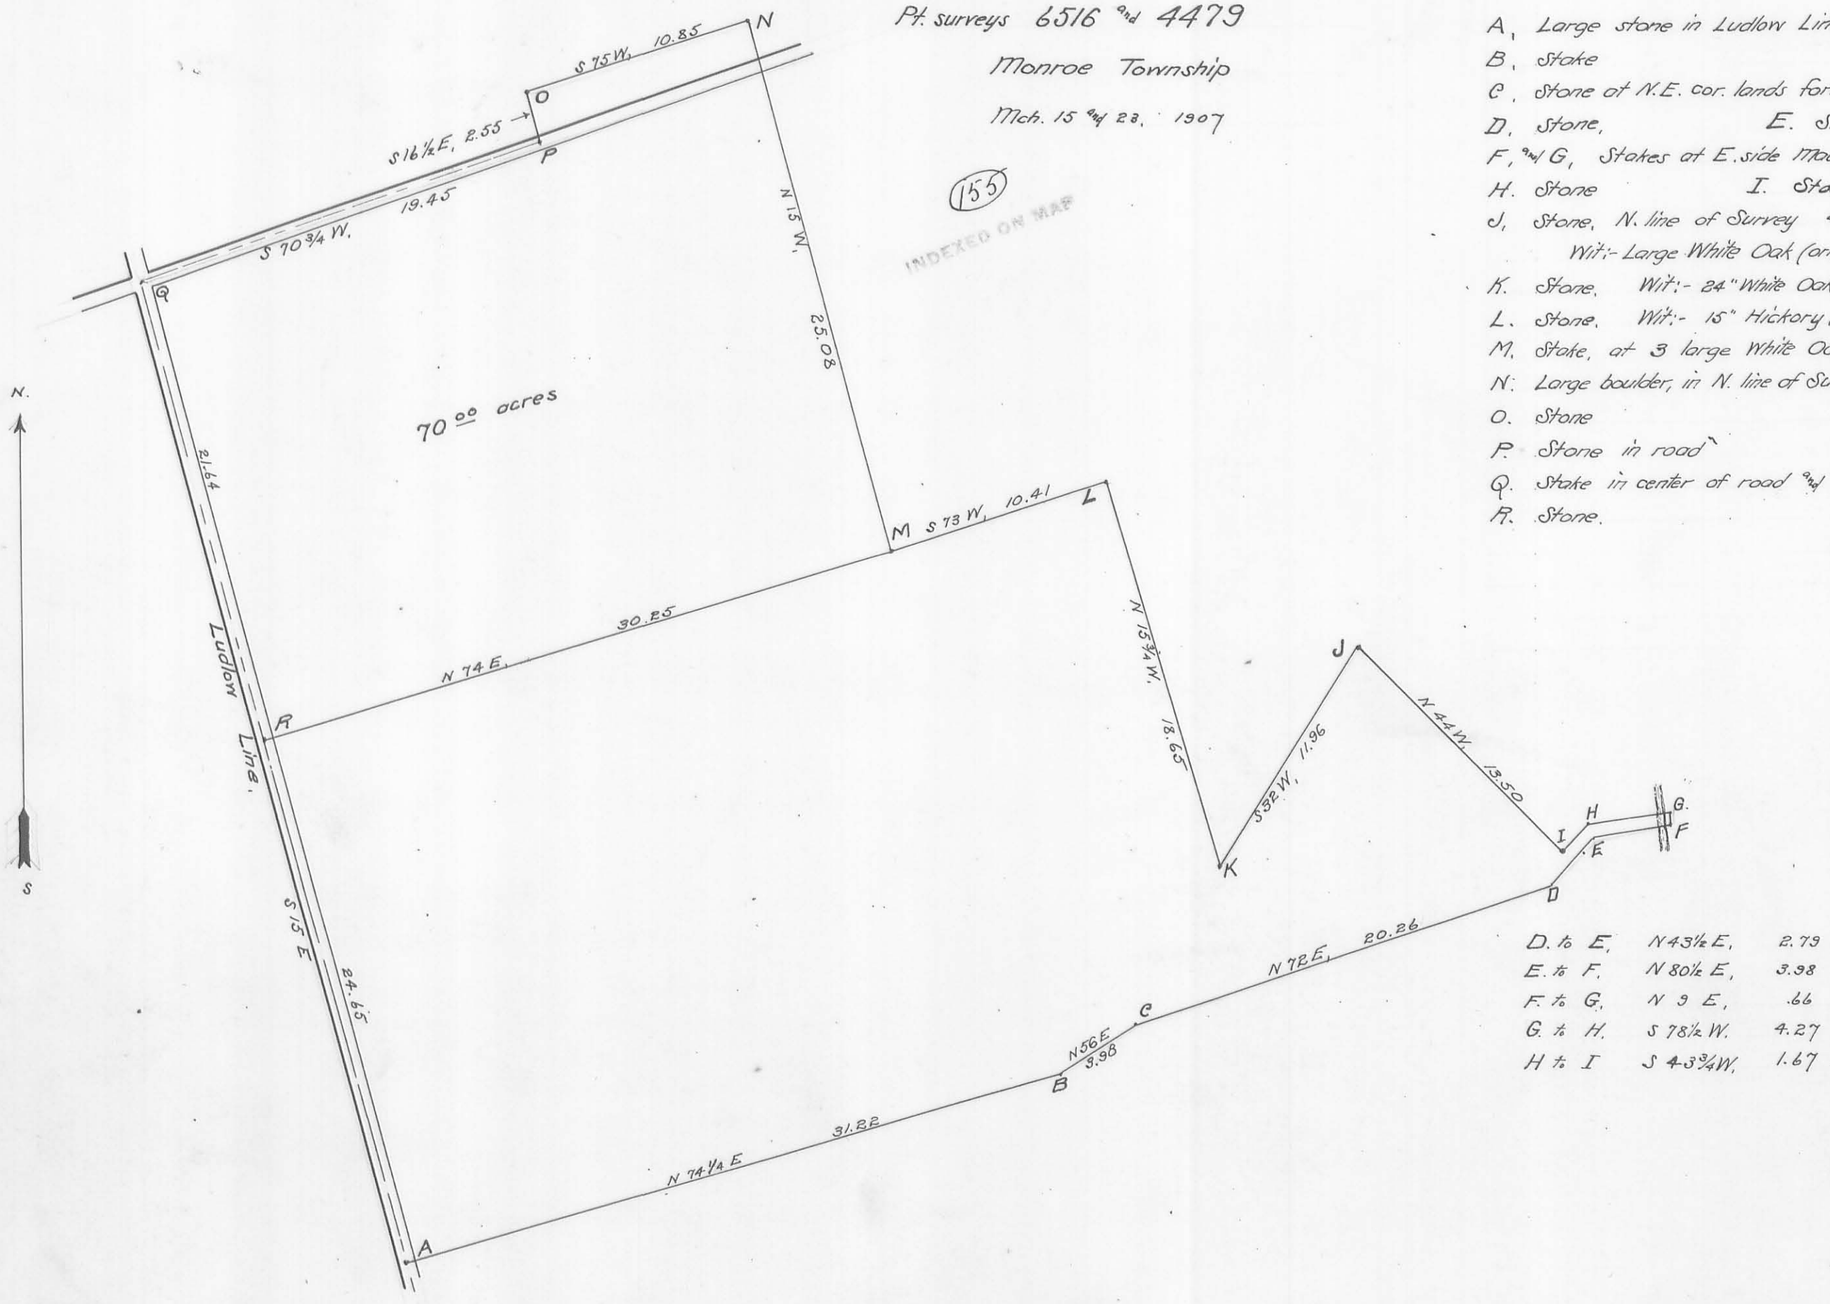

— Description of Corners —

A, Large stone in Ludlow Line, S.W. cor. Surv. 6516
B, Stake
C, Stone at N.E. cor. lands formerly owned by Donn Piatt.
D, Stone, E. Stone
F, and G, Stakes at E. side Mockochee Creek
H. Stone I. Stone
J, Stone, N. line of Survey 4479
Wit:- Large White Oak (orig. line tree) S 32 W, 117 links
K. Stone. Wit:- 24" White Oak, S 9 W, 5 links
L. Stone. Wit:- 15" Hickory, S 27 E, 4½ links
M. Stake, at 3 large White Oaks
N. Large boulder, in N. line of Survey, planted in decayed stump, orig. cor. tree
O. Stone
P. Stone in road
Q. Stake in center of road and Ludlow Line
R. Stone.

D. to E,	N 43½ E,	2.79
E. to F.	N 80½ E,	3.98
F. to G.	N 9 E,	.66
G. to H.	S 78½ W.	4.27
H to I	S 4-3¾ W,	1.67