8/17/38 C.A. Inskeep
G. Wilgus
8/18/38 R.J. Kinnard
Murray Jones

Pike Record Vol 5 Page 158
Surveyed Dec. 1880

"A" Found old decayed post 2' below surface. Set 2" I bar 4' long.

"B" Found nothing. AB in center of grade. Record N. 39 E 808' Declination 1880 1°-40' E; 1938 1°-20' W. Computed bearing N. 42° E. Bearing N. 41¾ E. Set 5/8" x 30" Eye bolt at 808'

"C" Hub set by Wright See Page 45 (found)

"D" Intersection of S. line VMS 3223 with ℄ Rd 28. Set ½" x 24' iron bar (threaded)

"E" Intersection ℄ Rd 28 with ℄ Rd 164 (by S.W.D.) set ½" bolt - not on top 1.9' W of spike

"F" 308' N intersection Rd 164 (Record) set hub in apparent center (Dug here, found nothing).

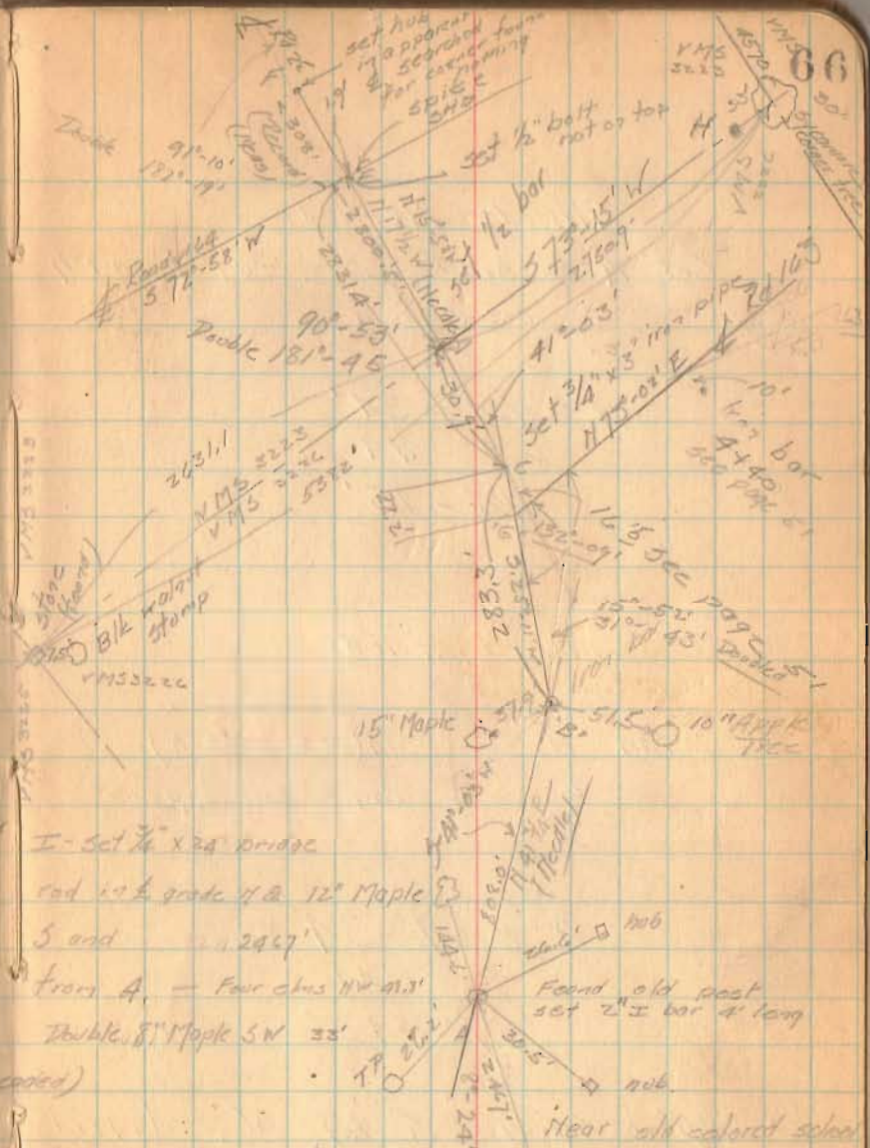

I - Set ¾" x 24 bridge rod in ℄ grade N & 12" Maple S and 2467' from A. — Four elms NW 41.3' Double 8" Maple SW 33'

"G" Intersection ℄ Rd 28 and Rd 163

H Set W.C. S 73°-15' W 33'

9/23/38 Concrete "M" 6" diameter 3' long. — This is 6' N. of fence

4195

INDEXED ON MAP