372

N. 0.

Stake

Beginning

2 W. Oak Grub. Surv. Corner.

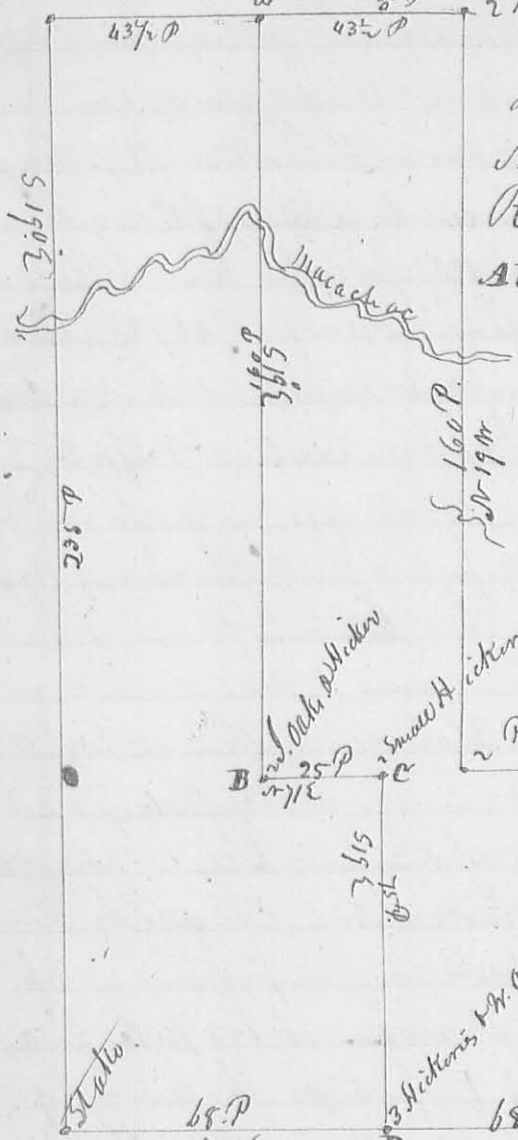

No. 384

(8395)

This Plat represents a part of Metes Surv. No. 4679. Sub-divided by Mrs Peter Randle & Elliott Randle by the Lines A B. C D. Beginning at A. thence S 19 E 166 poles. for the Plat.

June 10. 1837

J. Hopkins Co. S. & C. D

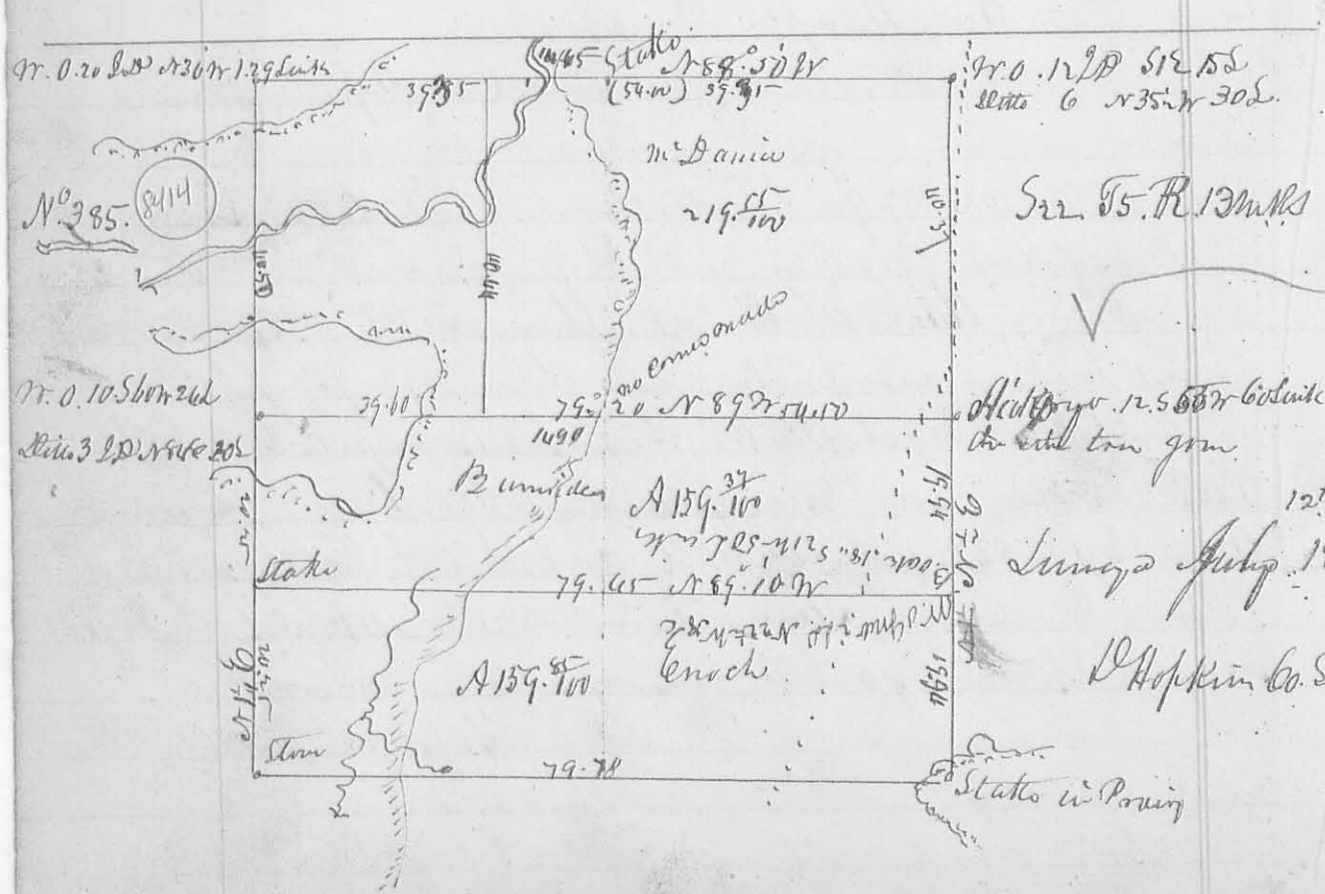

12th

June 1837

J. Hopkins Co. Surv. & C