FB 701

Survey of East Liberty Cemetery for Perry Township Trustees

D. Dodson
V. Detrick
D. Gilbert

April 15 & 16, 1958

68

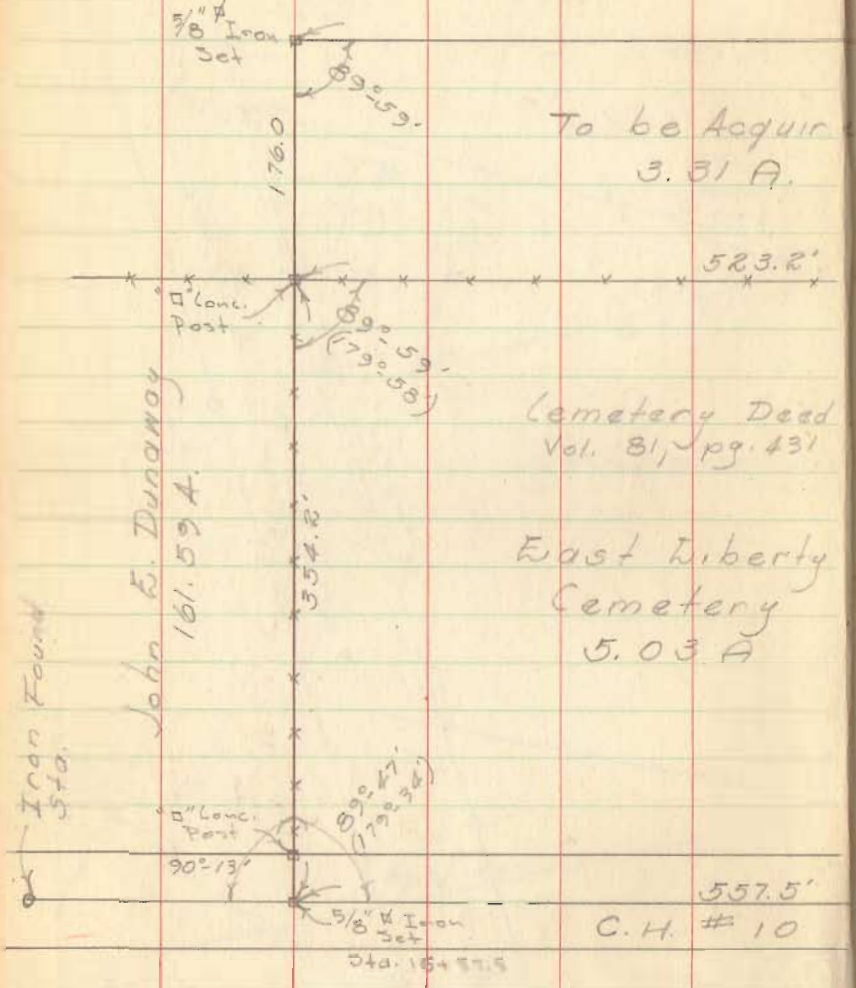

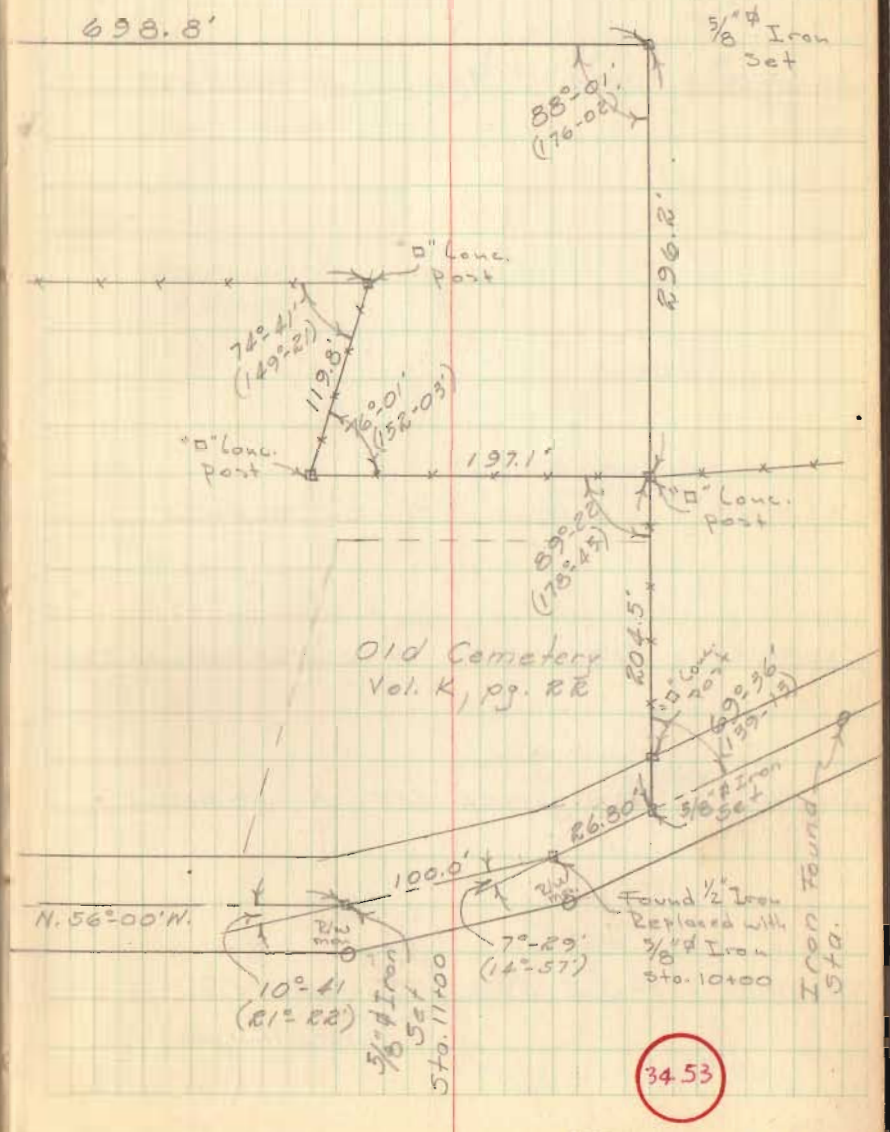

34.53

INDEXED ON MAP