Edgar L. Terry. Excavator. estate Hiram Huber. Sec 2

Thursday Dec 2nd 1915. Snow & sunshine.

STATION.	ALIGNMENT.	DEFLECTION.	REMARKS

(1) Start at a - NE¼ Emanuel Huber & NW¼ H. Huber 8 o a on ¼ sec line

Thence with ¼ sec line N 87¼ W.

at 693' = East line of Huber cemetery. = b

" " N 5¾ E 85½ to NE¼ Cemetery. Cornel = post = c

" " S 5¾ W 102½ " SE¼ " = d

" 809' N 5¾ E 85½ = point in N line cem at 115 N of NE¼

" " S 8¾ W 102½ " " " S " = a

" 997' Original east line Huber farm = e

" " S 5¾ W 102½ to S line cemetery = f

" " 12½ to post & side 25' drive way = g

" " N 5¾ E 85½ = point in N line cem = h

" 1170' West line of tract on N 72 × 173. = 80 a

" " S 8¾ W 12½ to S side of 25' drive & Said cemetery = j

" " N 5¾ E 85 to NE¼ tract = 72 × 173. = i

" 1309' enter cem gate

" " N 5¾ E 39' to cement post NW¼ cem on E side pike

" 1400' enter De Graff & Bellefontaine Pike = S NE¼ Cemetery = l

(2) Start at cement cor post NE¼ old cemetery = N 5¾ E 85' from NE¼

Thence with N line of cemetery N 87¼ W

at 304' old NW¼ cem & NE¼ tract 72 × 173

" 477' NW¼ cem post NW¼ " "

" 599' center De Graff & Bellefontaine Pike = k

(3) Start cent De G & Bellefontaine Pike 599 of (2)

Thence with pike S 5 8¾ W

at 140' point = 1400 of (1) = l

Wm B. Huber. Redonan 504

John M. Detrick ch a 75

Donald M. Detrick " " 75

Part of Sec 1 Town 2. Range 14 E.

" " 21 " 3. " "

Stationers, St. Louis, Mo.

TOPOGRAPHY. (Pleasant Twp.)

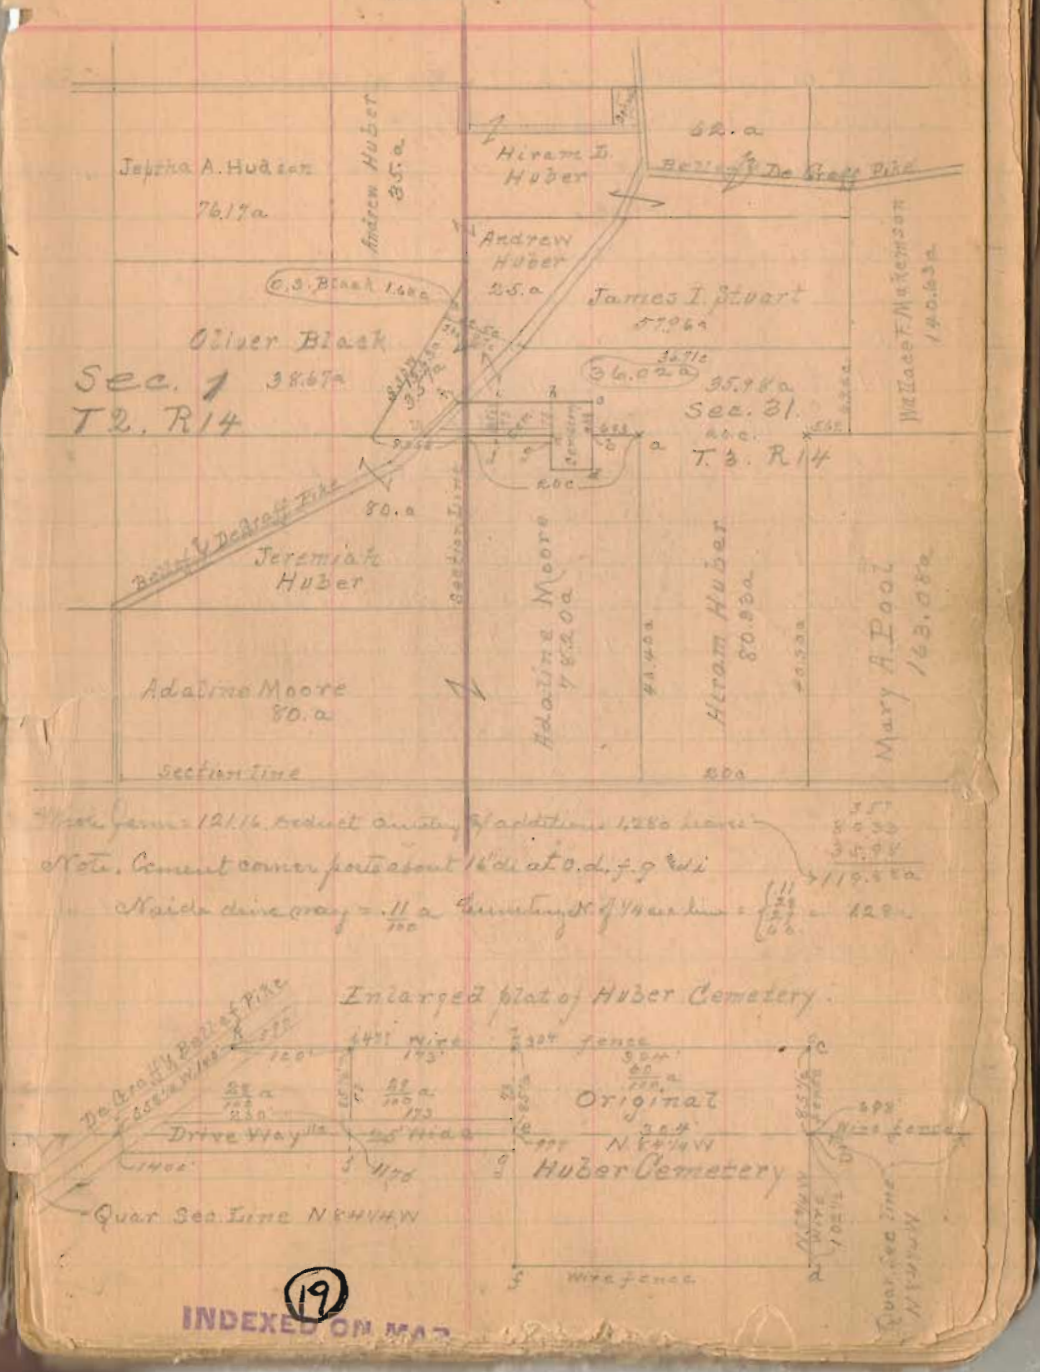

(19)

INDEXED ON MAP