Road No. 209
Pleasant Twp.

30' Road. Road Record No. 2 Page 267
July 1878

Stakes Placed 20' from ℄
for 40' Road. Trustees to
get extra Land

See Survey for Milroy
Book 549 Page 62

(1692)

INDEXED ON MAP

Oct. 24, 1935
F. Wright
E. Cote
clear - Windy

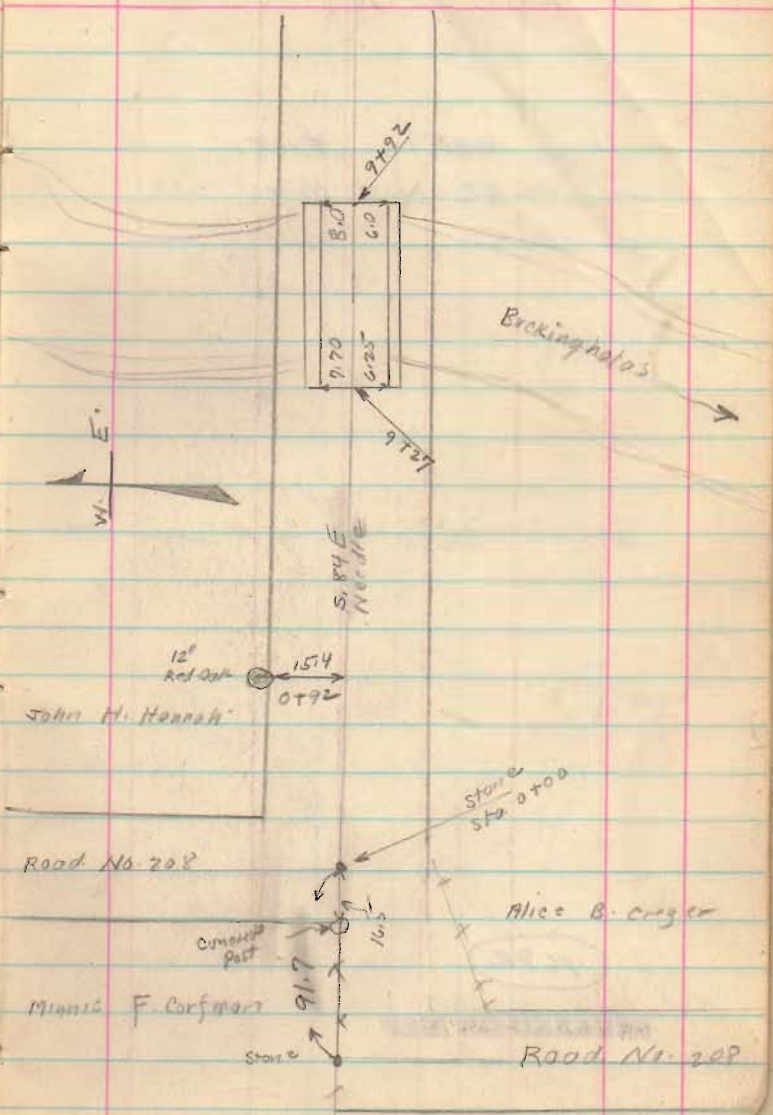

Road. No. 209

Length 4859 Feet
Length 0.920265 Miles
Length 0.92 Miles.

1692

INDEXED ON MAP
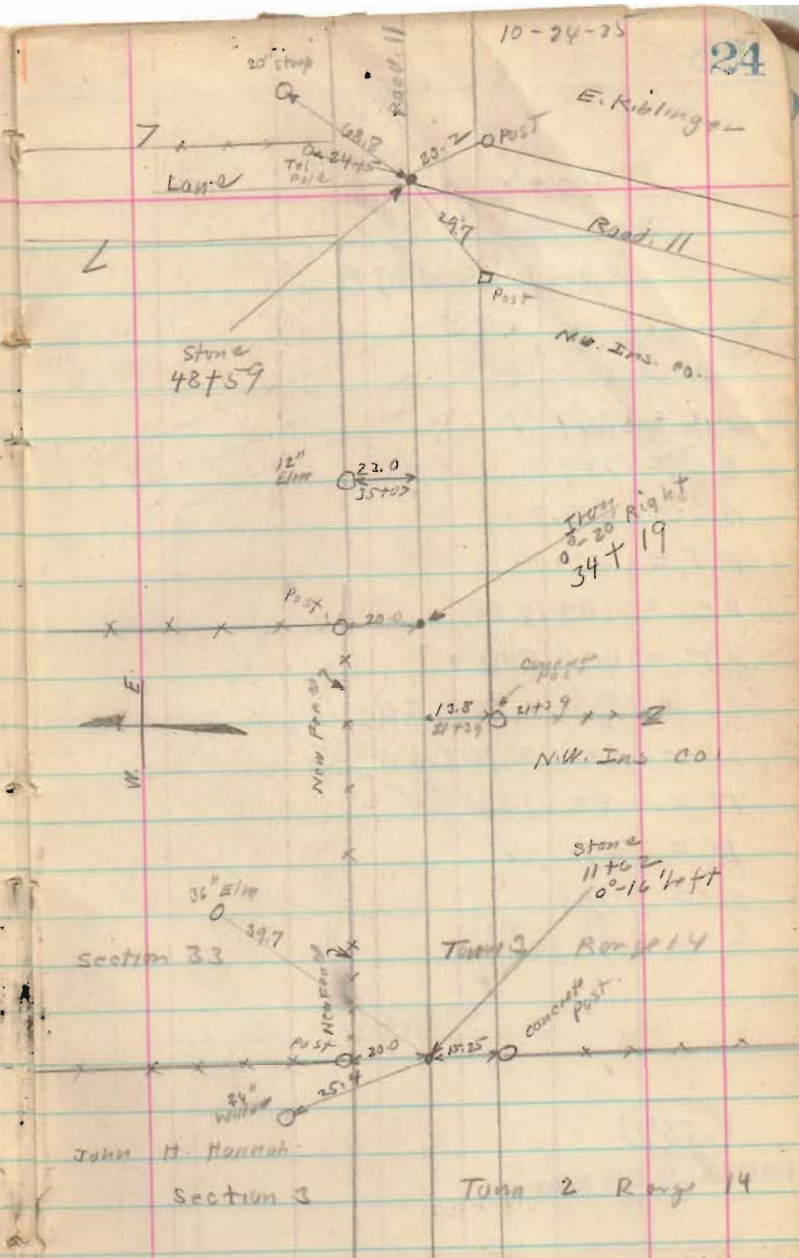
10-24-25