

SURVEY FOR VERNA NOTESTINE

SEPTEMBER 1977

The following described tract of land is situated in the State of Ohio, County of Logan, Township of Pleasant, being a part of the northwest quarter of the southeast quarter of Section 14, Town 1, Range 8, being more particularly described as follows:

Commencing at a stone found at the northeast corner of the northwest quarter of the southeast quarter of Section 14, Town 1, Range 8, being on the centerline of Pleasant Township Rd. No. 75 (40 feet wide), referenced in Logan County Engineer's survey field book 589, page 47, as Station 57+65, no angle; thence following the centerline of T.R. No. 75 and the east-west one-half section line of said Section, an assumed bearing of North 85°00' West 671.92 feet to a railroad spike set and marking the principal place of beginning;

thence South 4°16' West 524.14 feet, passing through an iron pipe at 20.00 feet marking the southerly right-of-way line of T.R. No. 75, to a concrete corner post;

thence North 85°00' West 258.13 feet to an iron pipe set;

thence North 4°09' East 278.23 feet to an iron pipe set;

thence North 85°16' West 15.65 feet to a concrete corner post;

thence North 4°22' East 245.96 feet, passing through an iron pipe set at 225.96 feet marking the southerly right-of-way line of T.R. No. 75, to a railroad spike set on the centerline of said road;

thence following the centerline of T.R. No. 75, South 85°00' East to the principal place of beginning.

The above described tract of land contains 3.20 acres of which 0.12 acre is dedicated for highway purposes.


The above described tract is part of Verna Notestine's 80 acre tract as described in Warranty Deed Volume 306, Page 27, Logan County Records.

The above description is the result of a survey completed in September of 1977 by Paul R. Clapsaddle, R.S. #6140.

ATTEST:

Paul R. Clapsaddle R.S. #6140

P.O. Box 184
East Liberty, Ohio 43319
Tel. 513/666-4802

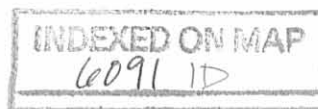

LAND SURVEYING AND PLANNING



PAUL R. CLAPSADDLE & ASSOCIATES
PROFESSIONAL LAND SURVEYORS
PROFESSIONAL ENGINEERS

PAUL R. CLAPSADDLE

RES: (513) 666-4802

P. O. Box 184
EAST LIBERTY, OHIO
OFFICE: (614) 460-2601

Fragments of Hub Found
 under high point of
 Stone Found Ref. F.B. 589, Pg. 48
 Sta. 70+99 $\Delta = 0^{\circ}23'14''$

E-W 1/2 Sec. Line Sec. 14
 T. 1, R. 8

T.R. No. 175 (40')

S 85° 00' E
 274.00

N 85° 00' W
 671.92

C.R. No. 15

Center of
 S14, T1, R8

NE corner of
 the NW quarter
 of the SE
 quarter of
 S14, T1, R8

Ref.
 F.B. 589
 Pg. 47
 Sta. 57+65
 No Angle

N 4° 22' E
 245.96

Vera M.
 Notestine
 80.0

Manford C.
 Barga
 Etal

3.20 Acres

- 3.2
 76.8 Acres
 Remaining

N 85° 16' W
 15.65

S 4° 16' W
 524.14

Vera M.
 Notestine

N 4° 9' E
 278.23

N 85° 00' W
 258.13

Legend:

- R.R. Spike Set
- ◁ Stone Found
- ⊙ Concrete Corner Post
- Iron Pipe Set

Scale: 1" = 100'
 Date: Sept. 30, 1977
 Ref.: D.B. 306, Pg. 27

6091 IP

INDEXED ON MAP

SURVEY FOR VERNA NOTESTINE
 State of Ohio
 County of Logan
 Township of Pleasant
 Sec. 14, Town 1, Range 8
 Part of NW Qtr. of the SE. Qtr.

LAND SURVEYING AND PLANNING



PAUL R. CLAPSADDLE & ASSOCIATES
 PROFESSIONAL LAND SURVEYORS
 PROFESSIONAL ENGINEERS

PAUL R. CLAPSADDLE
 RES. (513) 666-4802

P. O. Box 184
 EAST LIBERTY, OHIO
 OFFICE: (614) 460-2601

