302. S26. T3. R 14 M. R.S.

445 (8285)

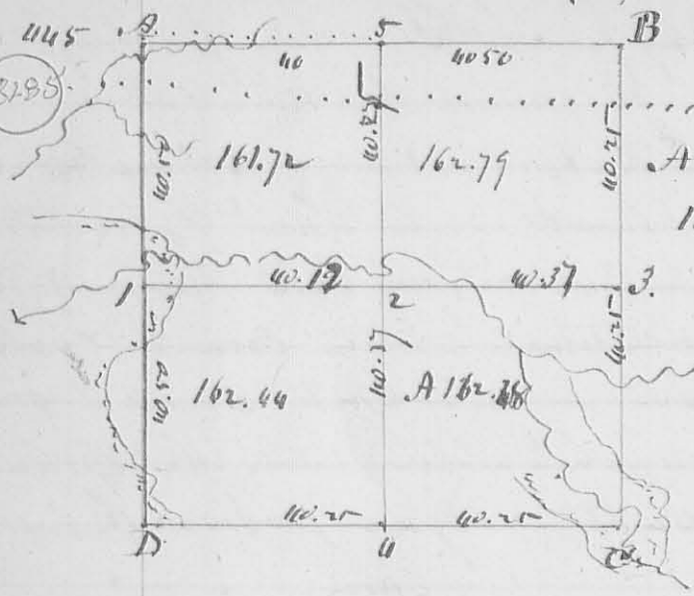

Course. Magnetic Mer. Var. 30 ½

Description of Corners—

A B C D. Stones at Sect. Corners—

1. 2. Stakes in Prairie—No timber near

3 Stone & Bur. O. 22 L Dr. S 10 W 170 L.

4. Stone. ditto - 22 „ N 22 W 50 L

Walnut 15 „ S 18 W 60 L.

5 Stone. Wh. O 18. West—12 Links—

the other two down—

March 13. 1839.

D Hopkins Co. Sur. L C O

Surveyed for Saml. Moore & others.

No 446. (8451) Surveyed March 28th. 1839 for Sam. Jameson. Beginning S.E Corner to William Brooks, thence S 10½ E 162 poles to a Sugar. cut down: thence S 78½ W 99 6/10 poles to a Hickory & Sugar in a County Road: thence N 11½ W 162 p to a Stone in another County Road, crossing the former & S W Corner to said Brooks: thence with said County Road N 78 E 102 2/10 poles to the beginning—

pt. No 9952. Cont. 102 14/100 D Hopkins Co. Sur.

---

447 (8451) March 29. 1839 for Robert Lowry. pt. Survey 9952, Beginning at 2 Beech. S.E L to Wilmuth's Mill Lot: thence N 12 W 160 poles to a Beech: trees wd. down; thence N 80 E 104 poles to a Lyn & Sugar. about 1 pole N. Easterly: thence ~~N 78 E 100 3/10 p~~ S 12 E 162 poles to 2 Beech & Sugar; thence S 78 W 100 3/10 poles to the beginning.

D Hopkins Co. Sur. L C. O.

Same Survey Beginning as before, planted Stone: thence N 42 E 37 poles to a Stake; thence N 25 W 50 poles to a Beech; thence S 80 W 17 poles to a Beech & Dogwood: thence S 11½ E 71 poles to the begining Containing 10 acres—