30

Survey No 548

(8512)

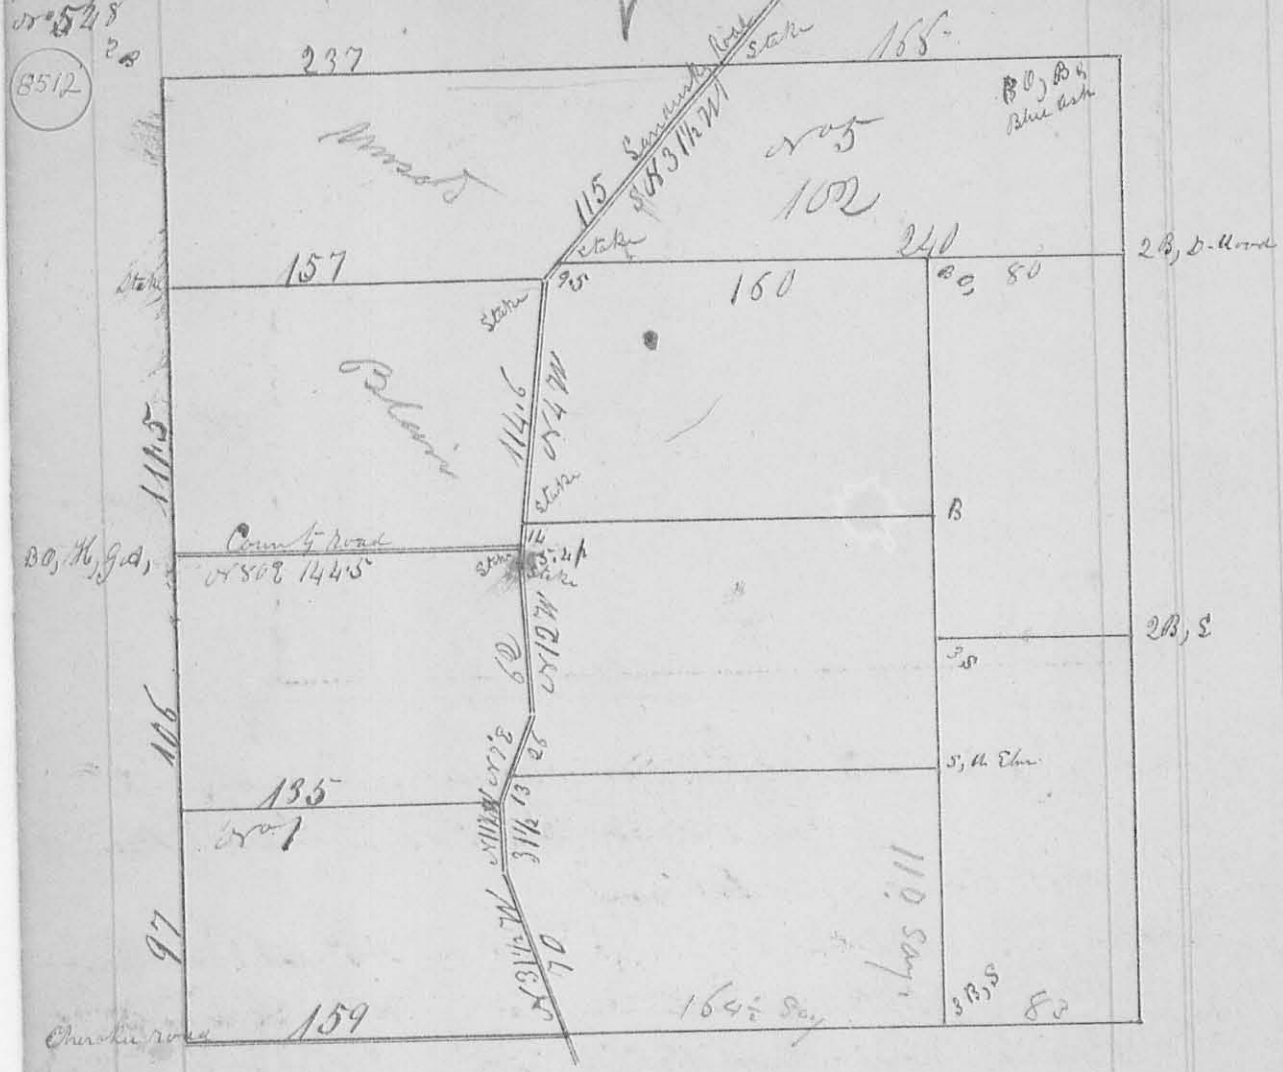

The above diagram represents the Survey & Subdivisions of Survey No 9977 Made for C P Mancure Nov 7, 8, & 12. 1845, The Boundry lines run N 79½ E & N 10½ W The Sandusky road runs as follows Beginning where said road crosses the south line of said Survey & run N 31½ W 70 poles to a Large White Oak then N 11¾ W 31½ poles to a Stake then N 7 E 39 poles to a Stake then N 12 W 62 poles to a Stake then N 4° W 5½ poles to the Centre of County road 119.5 poles to Stake then N 31½ E 115 to Stake in the North line of said Survey

97
06
111.5