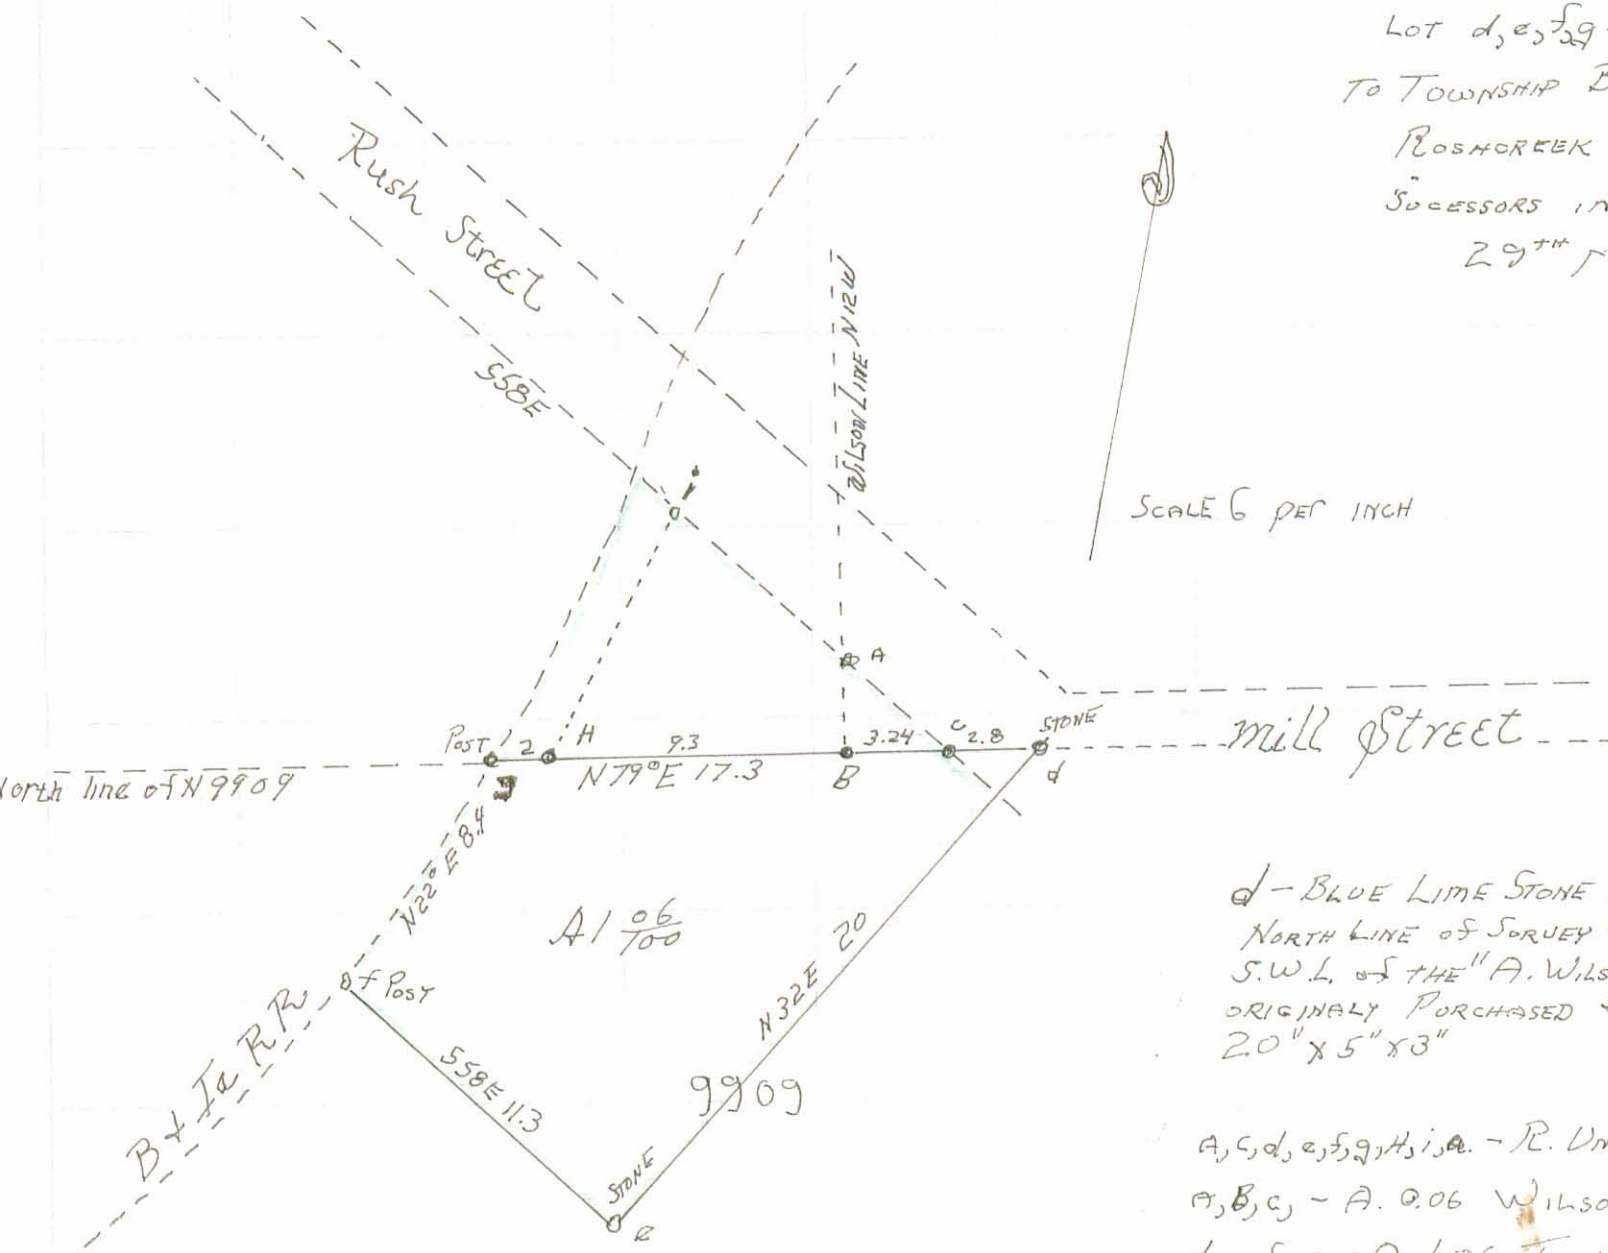

Lot d, e, f, g. of A 1 06/100 Deeded to Township Board of Education Roshoreek Twp. and there Successors in Office on 29th May 1858

Scale 6 per inch

d - Blue Lime Stone 24"x6"x3" in North Line of Survey +6 poles East of S.W.L. of the "A. Wilson Land" as originaly Purchased + Blue Limestone 20"x5"x3"

A, C, d, e, f, g, H, i, a. - R. Union School Lot
A, B, C, - A. 0.06 Wilson
d, e, f, g, - A 1.06 Taylor
A, B, H, i, - A 0.24 Wallace

Surveyed on April 8, 1858
Mc Laughlin

INDEXED C... MAP
814 IP