


Mrs. Sabethal Prater

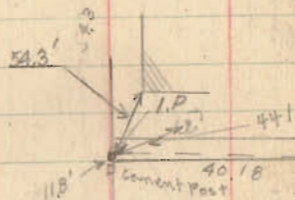


30.44 state Ditch

Section 34

4733'



80.515 ch

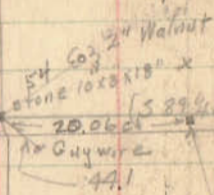

See Book 5D Page 60

See Book 5D Page 58


1/2 Cor Lot 142
11' 3"

11' I.P. Cor Lot 6+7

Post 10'-6"

598

INDEXED ON MAP

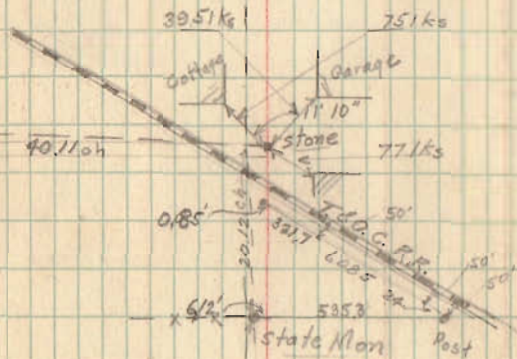

Sec 35

slough

80.477 ch

Ditch 40.93'

See Book 5D Page 30

See Page 8+9 for further notes