ROAD #239

STOKES AND WASHINGTON TOWNSHIPS

SEC. 35 T. 6. R. 8

(253)

INDEXED ON MAP

Mr. Combs claimed ℄ of road should Be AD
Mr. Anderson. " " " " " " CD
After some discussion Mr. Combs and Mr Anderson agreed To have ℄ of road BD.
E. IRON PIPE S.E. Cor. of Midway place.
D. POINT IN ROAD 20.00' from E.
A. IRON (SAME AS "C" BOOK 403 PAGE 8.) (same as "A" BOOK 418 Page 16)
C. POINT IN OLD FENCE LINE
B. POINT 10.65' from C 10.65 from A. Hub at. B.
Note carfully Iron Is at "A"
ROAD To BE 40' WIDE.
AC = 21.3'

See Book 480 Page 51
see Book 403 Page 8
See Book 418 Page 15 & 16
} For survey Notes.

Men Present when agreement was made
Clay Harmon.
John Anderson
Arnold Combs
R.O. Prior
Steve Prion.
John Mariar
Le Paild.
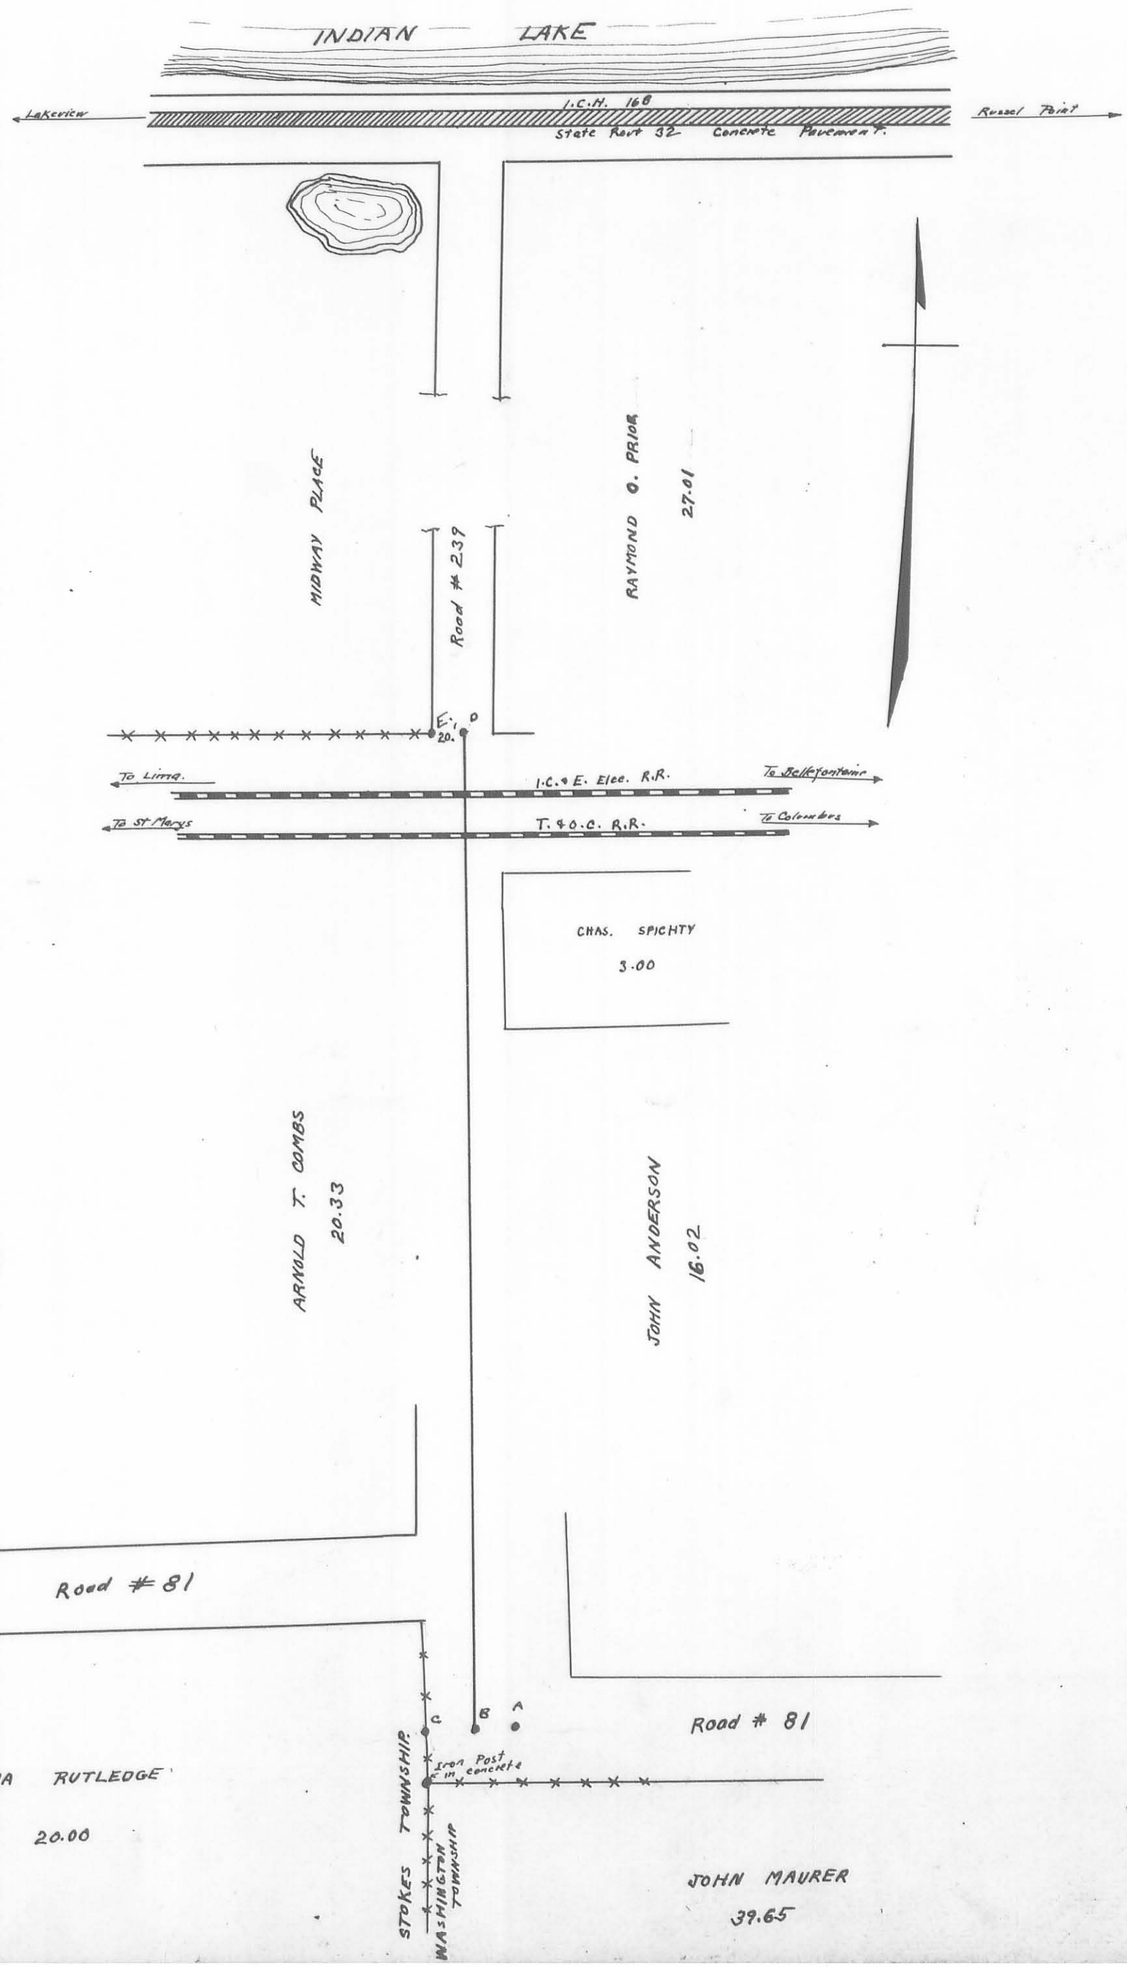
Surveyed By F. A. Wright Deputy County Surveyor.