Sec 27 T6 R8

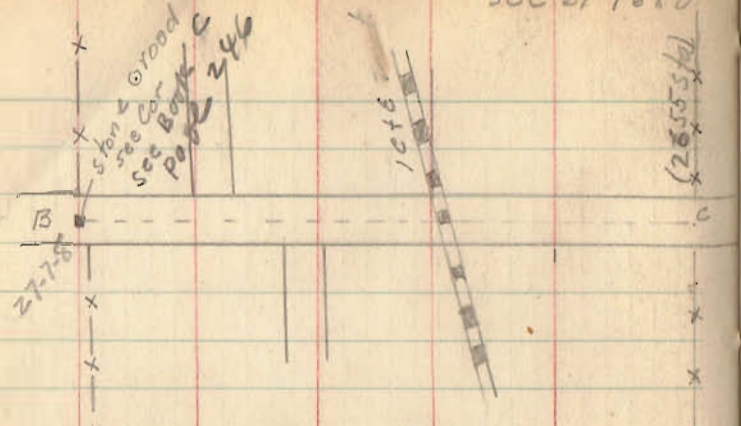

A = I.P. in Driven by Montg

B = stone found.

A-C+D established by measurement from E and F and are 20' feet North of fence's

Road width = 40'

Small Angle at "C"

(586)

INDEXED ON MAP

Continued on page 34 + 53
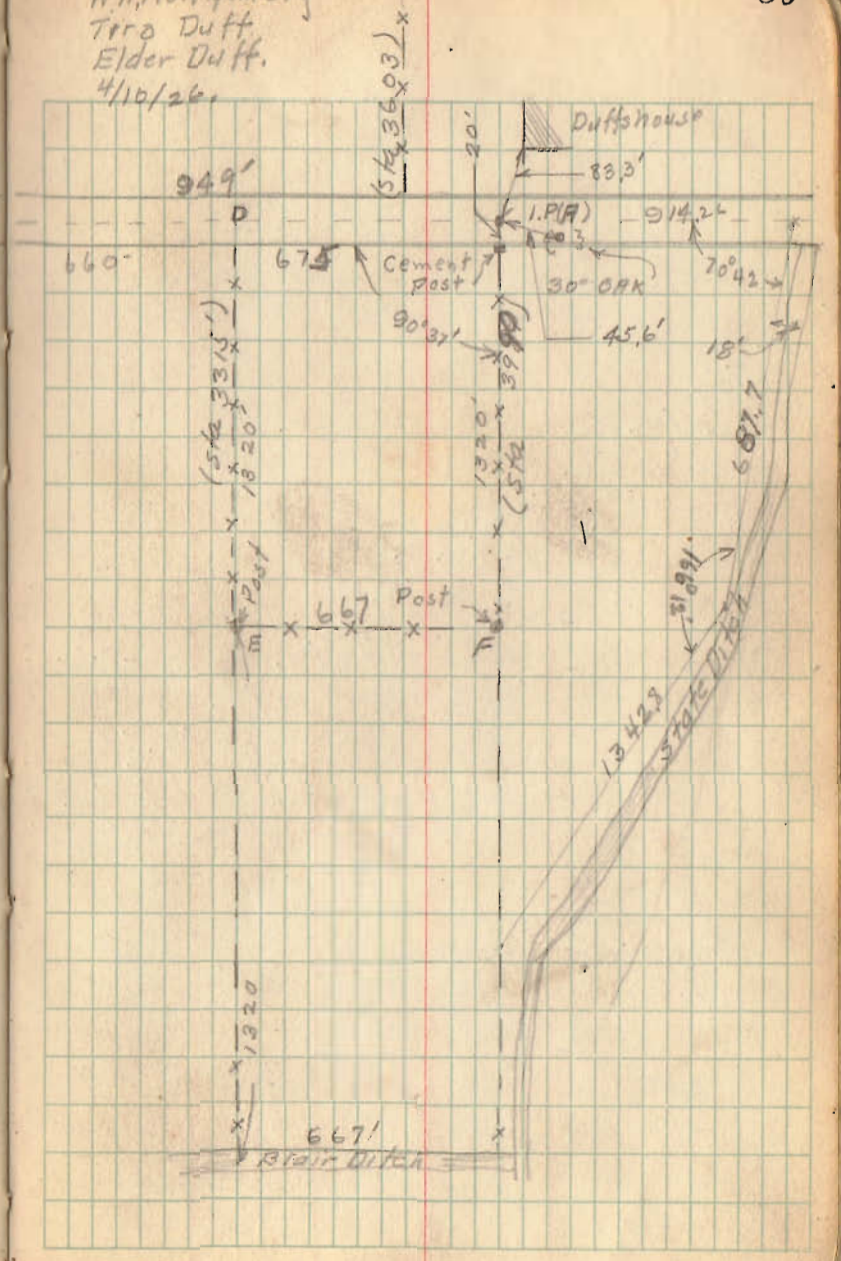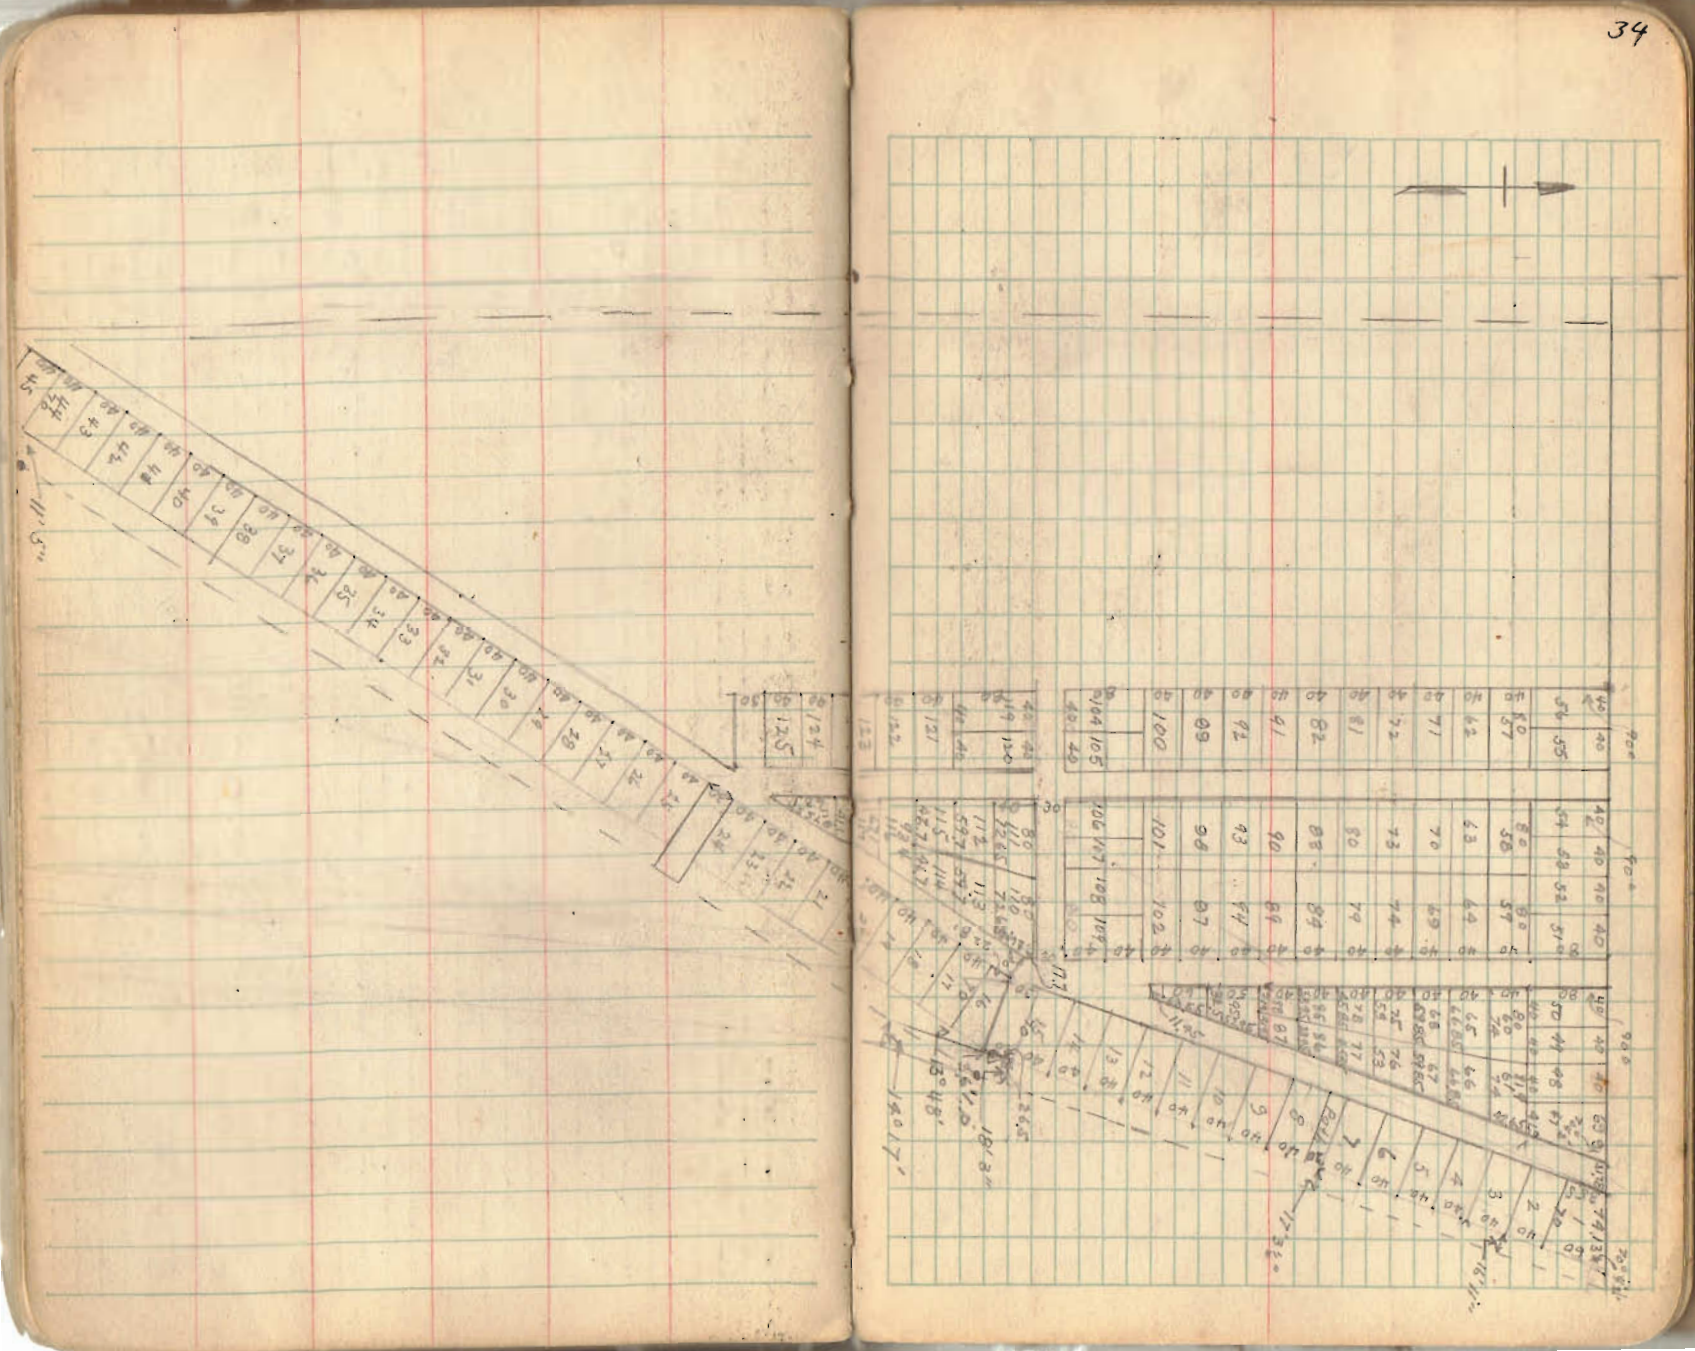
W.A. Montgomery
Tirra Duff
Elder Duff.
4/10/26.