Hull Survey

G + D found

A B C E F driven oak stakes

(1568)

5/3/34 Ed Core
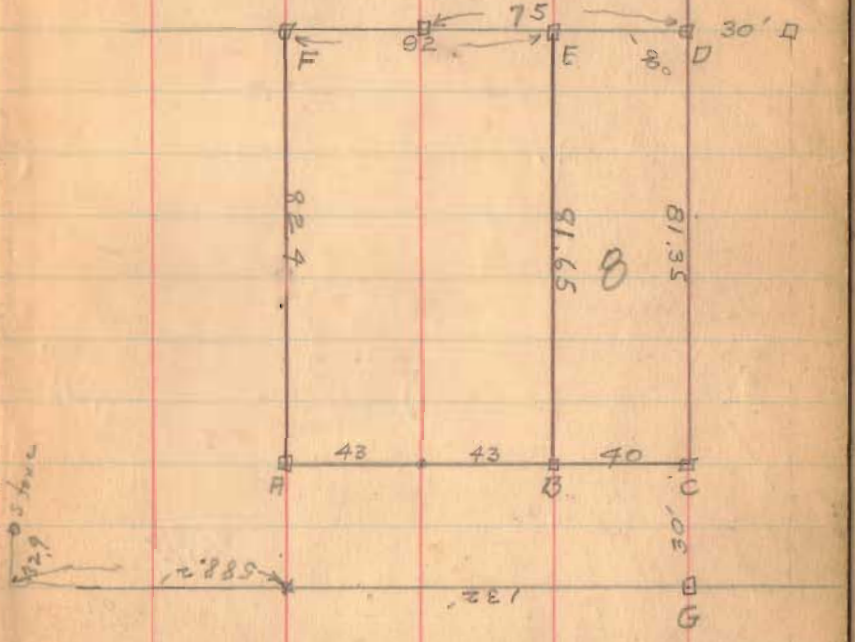
W A Montgomery